

646.402 DURABLE 4 INCH WHITE LINE, THERMOPLASTIC
(ALL LINES WILL INCLUDE EDGE LINE BREAKS AND RADIUS FOR TOWN HIGHWAYS)

WILMINGTON:
STA. 188+00.00 - STA. 204+00.00 EDGE LINE LT & RT

646.412 DURABLE 4 INCH YELLOW LINE, THERMOPLASTIC
(ALL LINES WILL INCLUDE C/L BREAKS FOR TOWN HIGHWAYS) S=SOLID, D=DASHED

WILMINGTON:
STA. 188+00.00 - STA. 204+00.00 S LT S RT
STA. 199+58.40 DOUBLE SOLID LT, TH-23

646.602 TEMPORARY 4 INCH WHITE LINE, PAINT
(ALL LINES WILL INCLUDE EDGE LINE BREAKS AND RADIUS FOR TOWN HIGHWAYS)

WILMINGTON:
STA. 188+00.00 - STA. 204+00.00 EDGE LINE LT & RT

646.612 TEMPORARY 4 INCH YELLOW LINE, PAINT
(ALL LINES WILL INCLUDE C/L BREAKS FOR TOWN HIGHWAYS) S=SOLID, D=DASHED

WILMINGTON:
STA. 188+00.00 - STA. 204+00.00 S LT S RT

646.482 DURABLE 24 INCH STOP BAR, THERMOPLASTIC

WILMINGTON:
STA. 199+58.40 LT, TH-23

646.682 TEMPORARY 24 INCH STOP BAR, PAINT

WILMINGTON:
STA. 199+58.40 LT, TH-23

646.492 DURABLE LETTER OR SYMBOL, THERMOPLASTIC


WILMINGTON:
STA. 199+58.40 LT, TH-23 'S,T,O,P' (4 EA)

675.50 REMOVING SIGNS

AS SHOWN - 11

675.60 ERECTING SALVAGED SIGNS

AS SHOWN - 3

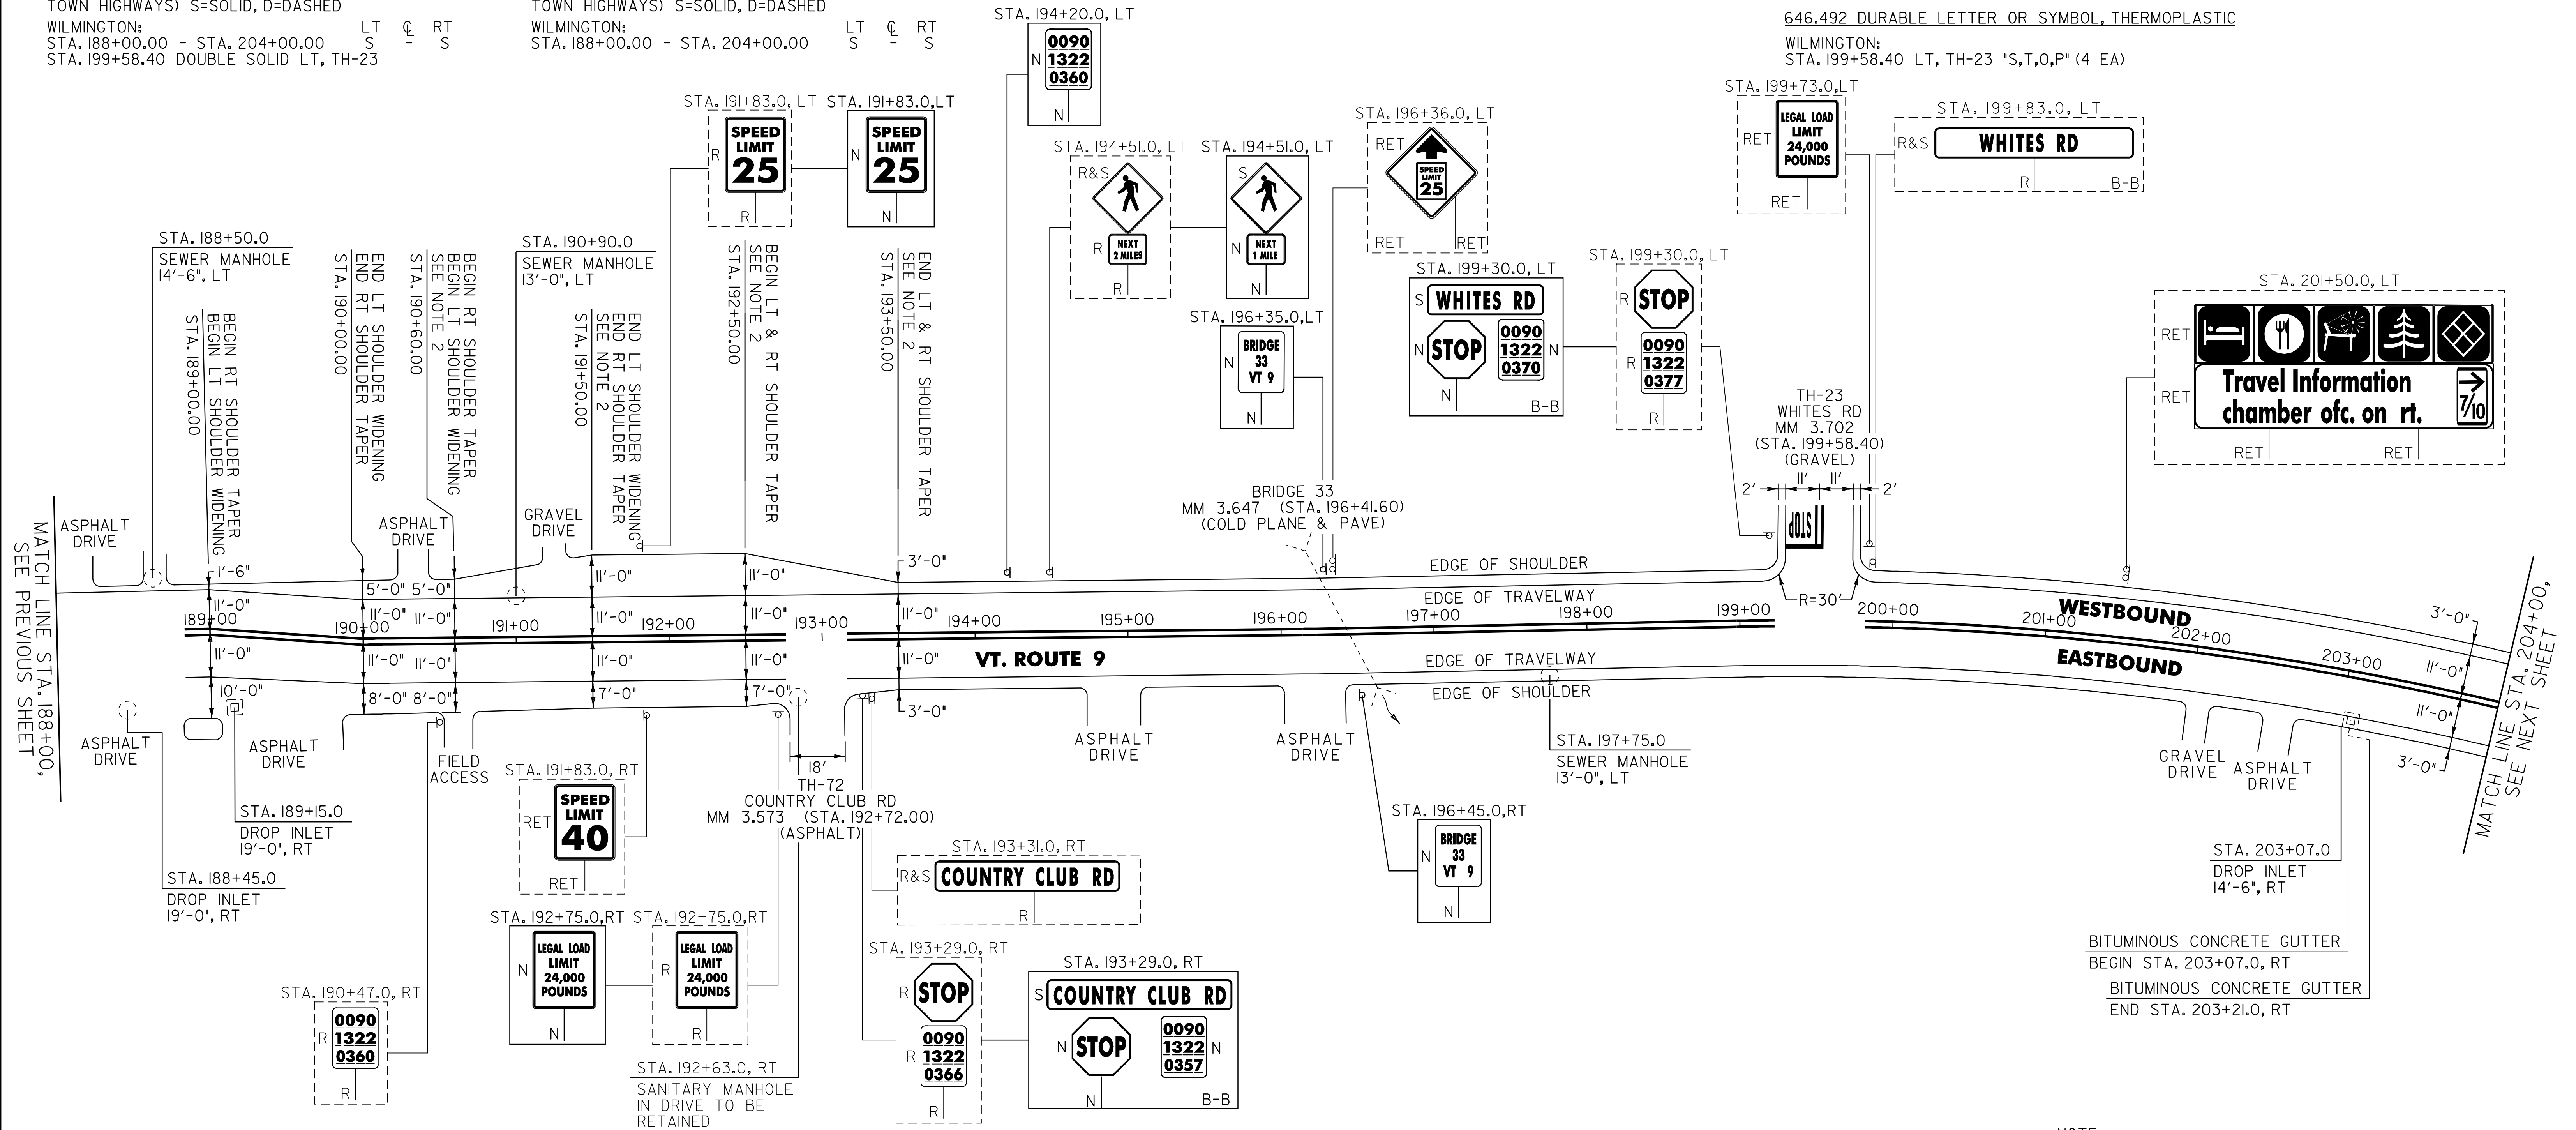

604.412 REHAB. DROP INLETS, CATCH BASINS, OR MANHOLES, CLASS I

WILMINGTON:
~~STA. 188+45.0 RT~~
~~STA. 189+15.0 RT~~
~~STA. 203+07.0 RT~~

604.42 CHANGING ELEVATION OF SEWER MANHOLES

WILMINGTON:
~~STA. 188+50.0 LT~~
~~STA. 190+90.0 LT~~
~~STA. 197+75.0 RT~~

616.47 BITUMINOUS CONCRETE GUTTERS AND TRAFFIC ISLANDS

WILMINGTON:
STA. 203+07.0 - STA. 203+21.0 RT (0.5 TON)

- NOTE:
- PAVING LIMIT ON ALL TOWN HIGHWAYS SHALL BE MEASURED 25 FT BACK FROM VT. ROUTE 9 EDGE OF SHOULDER UNLESS DENOTED OTHERWISE ON THE PLANS OR AS DIRECTED BY THE RESIDENT ENGINEER.
 - THE CONTRACTOR SHALL COORDINATE ALL PAVING OPERATIONS WITH THE PROPOSED RITE AID (STORE #02481-05) PROJECT AS DIRECTED BY THE RESIDENT ENGINEER.

SIGN LEGEND

R	= REMOVE
S	= SALVAGE
N	= NEW
RET	= RETAIN
B-B	= BACK TO BACK
EXISTING	= - - - - -
NEW	= _____

NOT TO SCALE

PROJECT LAYOUT SHEET #9

PROJECT NAME: WILMINGTON	PLOT DATE: 23-AUG-2010 14
PROJECT NUMBER: AC_NH_2504(1)S	DRAWN BY: C.A.K.
FILE NAME: p05b044.dgn	CHECKED BY: D.W.E.
DESIGNED BY: M.J.M.	SHEET 28 OF 125
IPARM FILE: p05b044L09.i	