

646.402 DURABLE 4 INCH WHITE LINE, THERMOPLASTIC
(ALL LINES WILL INCLUDE EDGE LINE BREAKS AND RADIUS FOR TOWN HIGHWAYS)

WILMINGTON:
STA. 300+00.00 - STA. 316+00.00 EDGE LINE LT & RT
STA. 300+00.00 - STA. 316+00.00 DASHED LANE LINE RT

646.412 DURABLE 4 INCH YELLOW LINE, THERMOPLASTIC
(ALL LINES WILL INCLUDE C/L BREAKS FOR TOWN HIGHWAYS) S=SOLID, D=DASHED

WILMINGTON:
STA. 300+00.00 - STA. 316+00.00 LT @ RT S - S
STA. 315+74.40 DOUBLE SOLID LT, TH-4

646.602 TEMPORARY 4 INCH WHITE LINE, PAINT
(ALL LINES WILL INCLUDE EDGE LINE BREAKS AND RADIUS FOR TOWN HIGHWAYS)

WILMINGTON:
STA. 300+00.00 - STA. 316+00.00 EDGE LINE LT & RT
STA. 300+00.00 - STA. 316+00.00 DASHED LANE LINE RT

646.612 TEMPORARY 4 INCH YELLOW LINE, PAINT
(ALL LINES WILL INCLUDE C/L BREAKS FOR TOWN HIGHWAYS) S=SOLID, D=DASHED

WILMINGTON:
STA. 300+00.00 - STA. 316+00.00 LT @ RT S - S
STA. 315+74.40 DOUBLE SOLID LT, TH-4

646.482 DURABLE 24 INCH STOP BAR, THERMOPLASTIC

WILMINGTON:
STA. 315+74.40, LT, TH-4

646.682 TEMPORARY 24 INCH STOP BAR, PAINT

WILMINGTON:
STA. 315+74.40, LT, TH-4

646.492 DURABLE LETTER OR SYMBOL, THERMOPLASTIC

WILMINGTON:
STA. 315+74.40, LT, TH-4 *S,T,O,P* (4 EA)

646.692 TEMPORARY LETTER OR SYMBOL, PAINT


WILMINGTON:
STA. 315+74.40, LT, TH-4 *S,T,O,P* (4 EA)

675.50 REMOVING SIGNS

AS SHOWN - 10

675.60 ERECTING SALVAGED SIGNS

AS SHOWN - 1

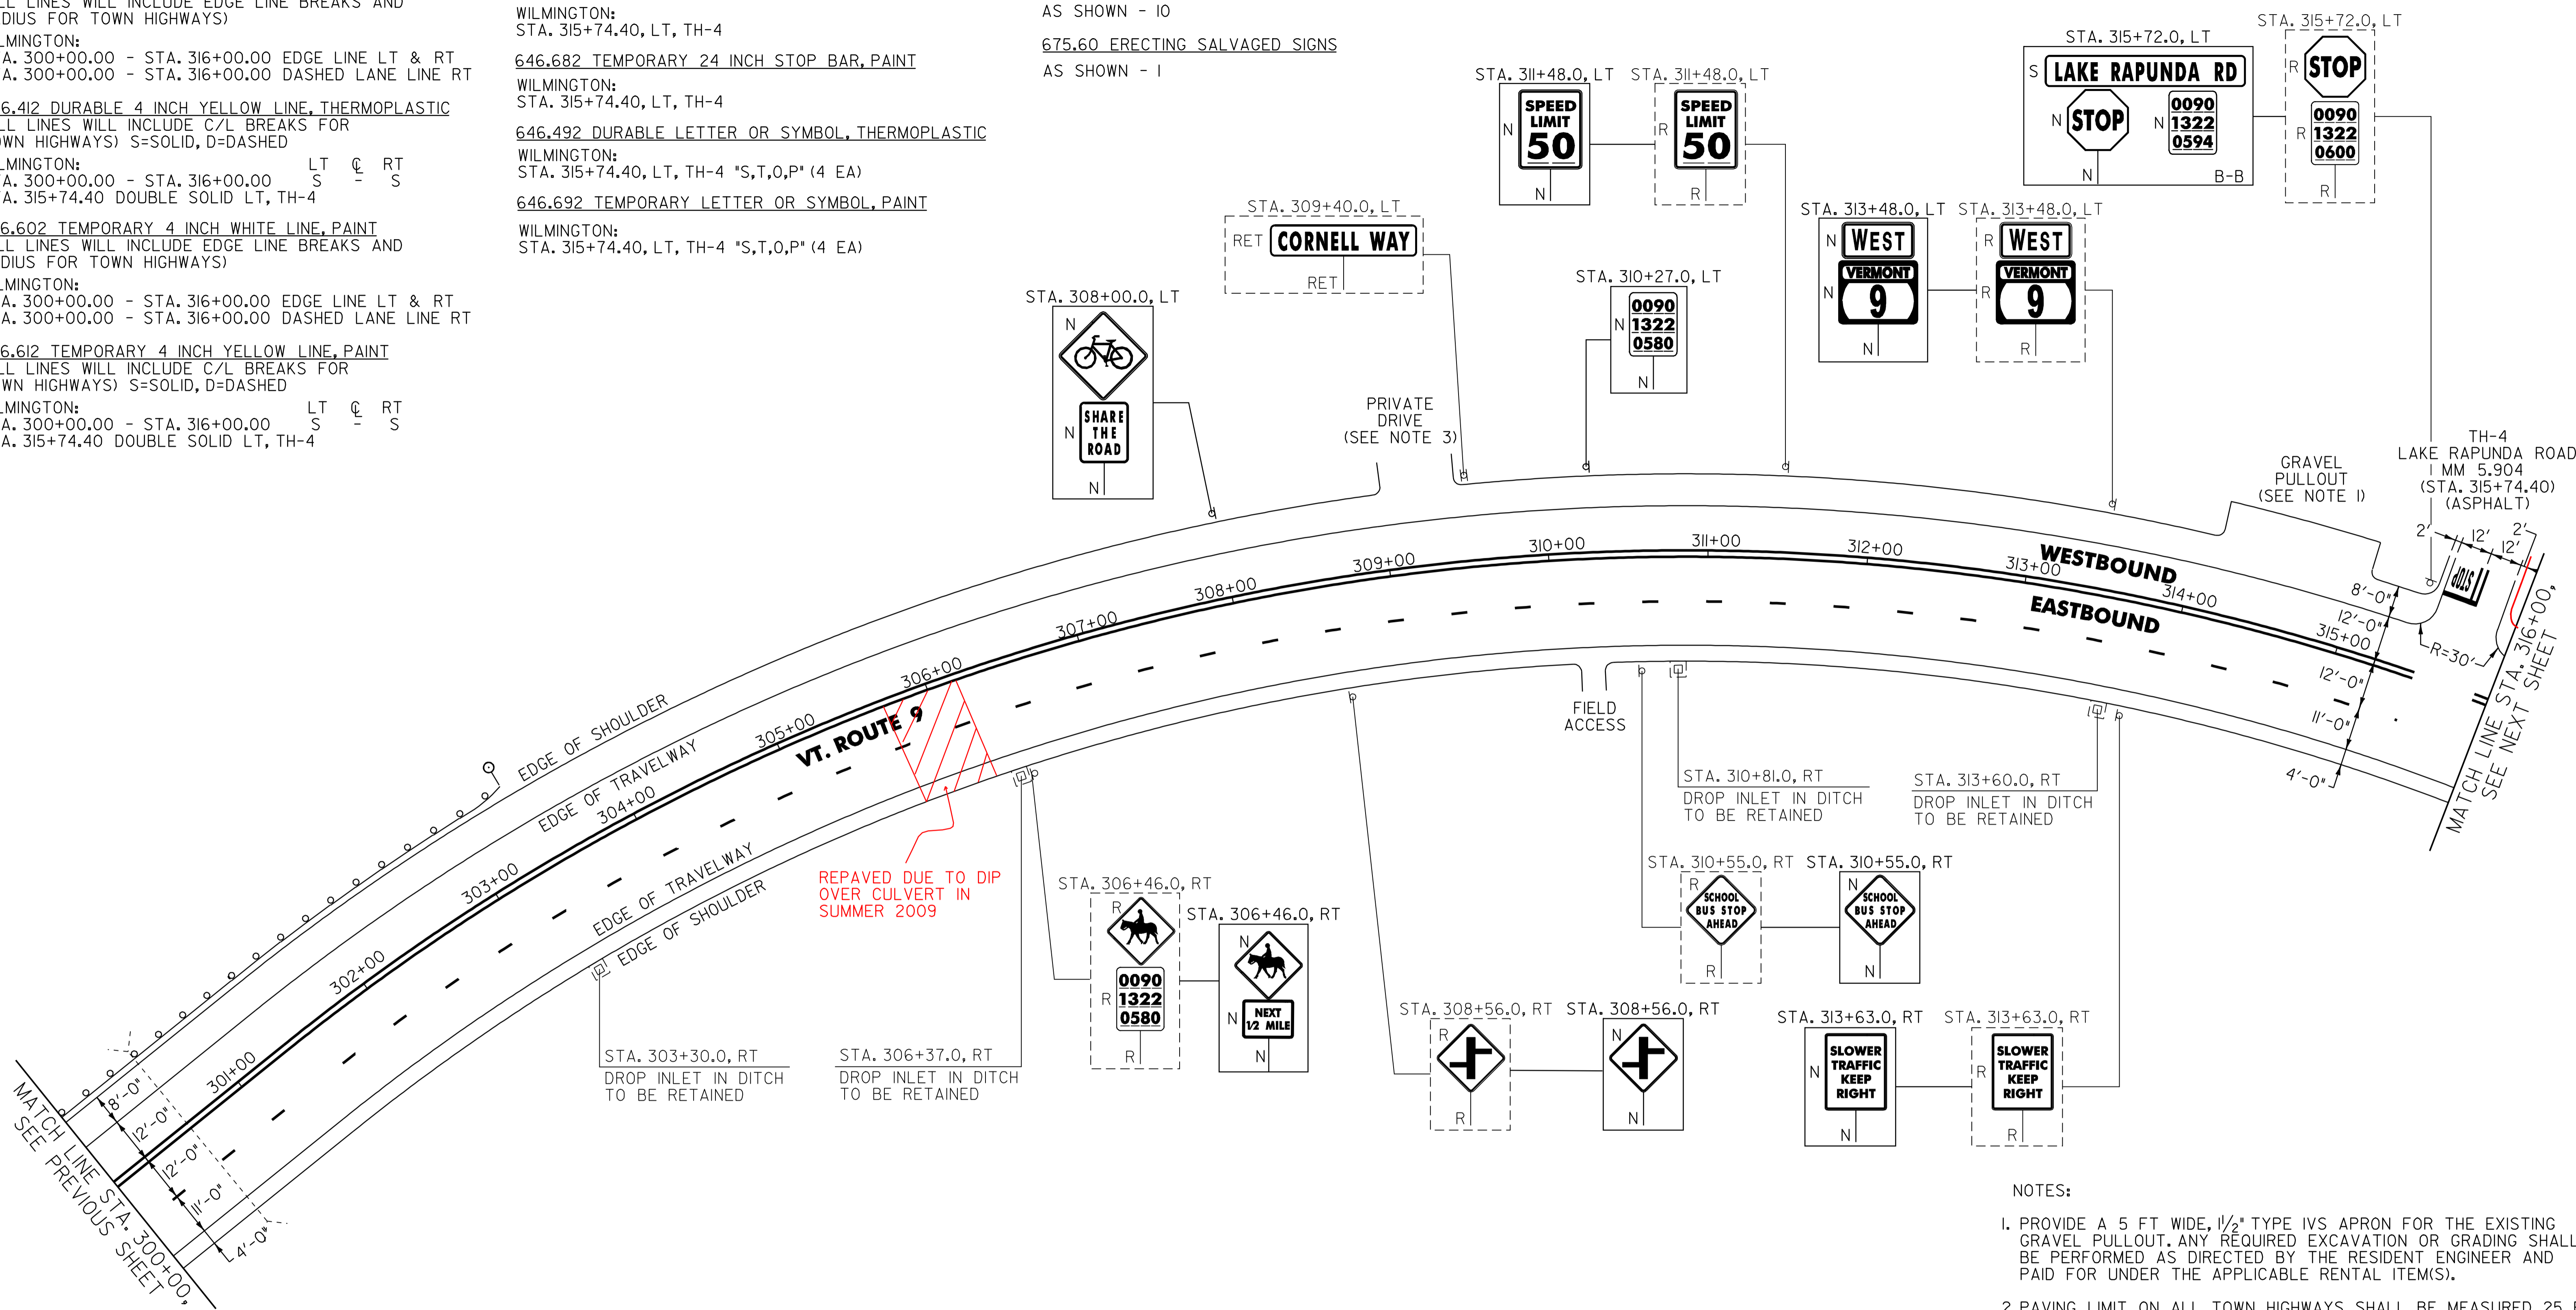

- NOTES:
1. PROVIDE A 5 FT WIDE, 1/2" TYPE IVS APRON FOR THE EXISTING GRAVEL PULLOUT. ANY REQUIRED EXCAVATION OR GRADING SHALL BE PERFORMED AS DIRECTED BY THE RESIDENT ENGINEER AND PAID FOR UNDER THE APPLICABLE RENTAL ITEM(S).
 2. PAVING LIMIT ON ALL TOWN HIGHWAYS SHALL BE MEASURED 25 FT BACK FROM VT. ROUTE 9 EDGE OF SHOULDER UNLESS DENOTED OTHERWISE ON THE PLANS OR AS DIRECTED BY THE RESIDENT ENGINEER.
 3. PROVIDE A 15 FT WIDE 1/2" TYPE IVS APRON FOR THE EXISTING PRIVATE ROAD. ANY REQUIRED EXCAVATION SHALL BE PERFORMED AS DIRECTED BY THE RESIDENT ENGINEER AND PAID FOR UNDER ITEM 608.25 ALL PURPOSE EXCAVATOR RENTAL, TYPE I.

616.35 TEATED TIMBER CURB
WILMINGTON:
STA. 300+00.0 - STA. 300+62.0 LT (62.0 LF)
621.20 STEEL BEAM GUARDRAIL, GALVANIZED
WILMINGTON:
STA. 300+00.0 - STA. 302+94.5 LT (294.5 LF)
621.50 MANUFACTURED TERMINAL SECTION, FLARED
WILMINGTON:
STA. 302+94.5 - STA. 303+32.0 LT (37.5 LF)

621.80 REMOVAL AND DISPOSAL OF GUARDRAIL
WILMINGTON:
STA. 300+00.0 - STA. 303+30.0 LT (393.0 LF)
676.10 DELINEATOR WITH STEEL POST
φ TYPE I WHITE
WILMINGTON:
STA. 303+32.0 LT

SIGN LEGEND
R = REMOVE
S = SALVAGE
N = NEW
RET = RETAIN
B-B = BACK TO BACK
EXISTING = - - - - -
NEW = _____

PROJECT LAYOUT SHEET #16	NOT TO SCALE	
	PROJECT NAME: WILMINGTON	PLOT DATE: 23-AUG-2010 14
	PROJECT NUMBER: AC_NH_2504(I)S	DRAWN BY: C.A.K.
	FILE NAME: p05b044.dgn	CHECKED BY: D.W.E.
	DESIGNED BY: M.J.M.	SHEET 35 OF 125
	IPARM FILE: p05b044L16.i	