

646.402 DURABLE 4 INCH WHITE LINE, THERMOPLASTIC
 (ALL LINES WILL INCLUDE EDGE LINE BREAKS AND
 RADIUS FOR TOWN HIGHWAYS)

WILMINGTON:
 STA. 364+00.00 - STA. 378+20.64 EDGE LINE LT & RT
 STA. 364+00.00 - STA. 364+12.50 DASHED LINE RT

646.412 DURABLE 4 INCH YELLOW LINE, THERMOPLASTIC
 (ALL LINES WILL INCLUDE C/L BREAKS FOR
 TOWN HIGHWAYS) S=SOLID, D=DASHED

WILMINGTON: LT C RT
 STA. 364+00.00 - STA. 378+20.64 S - S


646.602 TEMPORARY 4 INCH WHITE LINE, PAINT
 (ALL LINES WILL INCLUDE EDGE LINE BREAKS AND
 RADIUS FOR TOWN HIGHWAYS)

WILMINGTON:
 STA. 364+00.00 - STA. 378+20.64 EDGE LINE LT & RT
 STA. 364+00.00 - STA. 364+12.50 DASHED LINE RT

646.612 TEMPORARY 4 INCH YELLOW LINE, PAINT
 (ALL LINES WILL INCLUDE C/L BREAKS FOR
 TOWN HIGHWAYS) S=SOLID, D=DASHED

WILMINGTON: LT C RT
 STA. 364+00.00 - STA. 378+20.64 S - S

675.50 REMOVING SIGNS
 AS SHOWN - 5

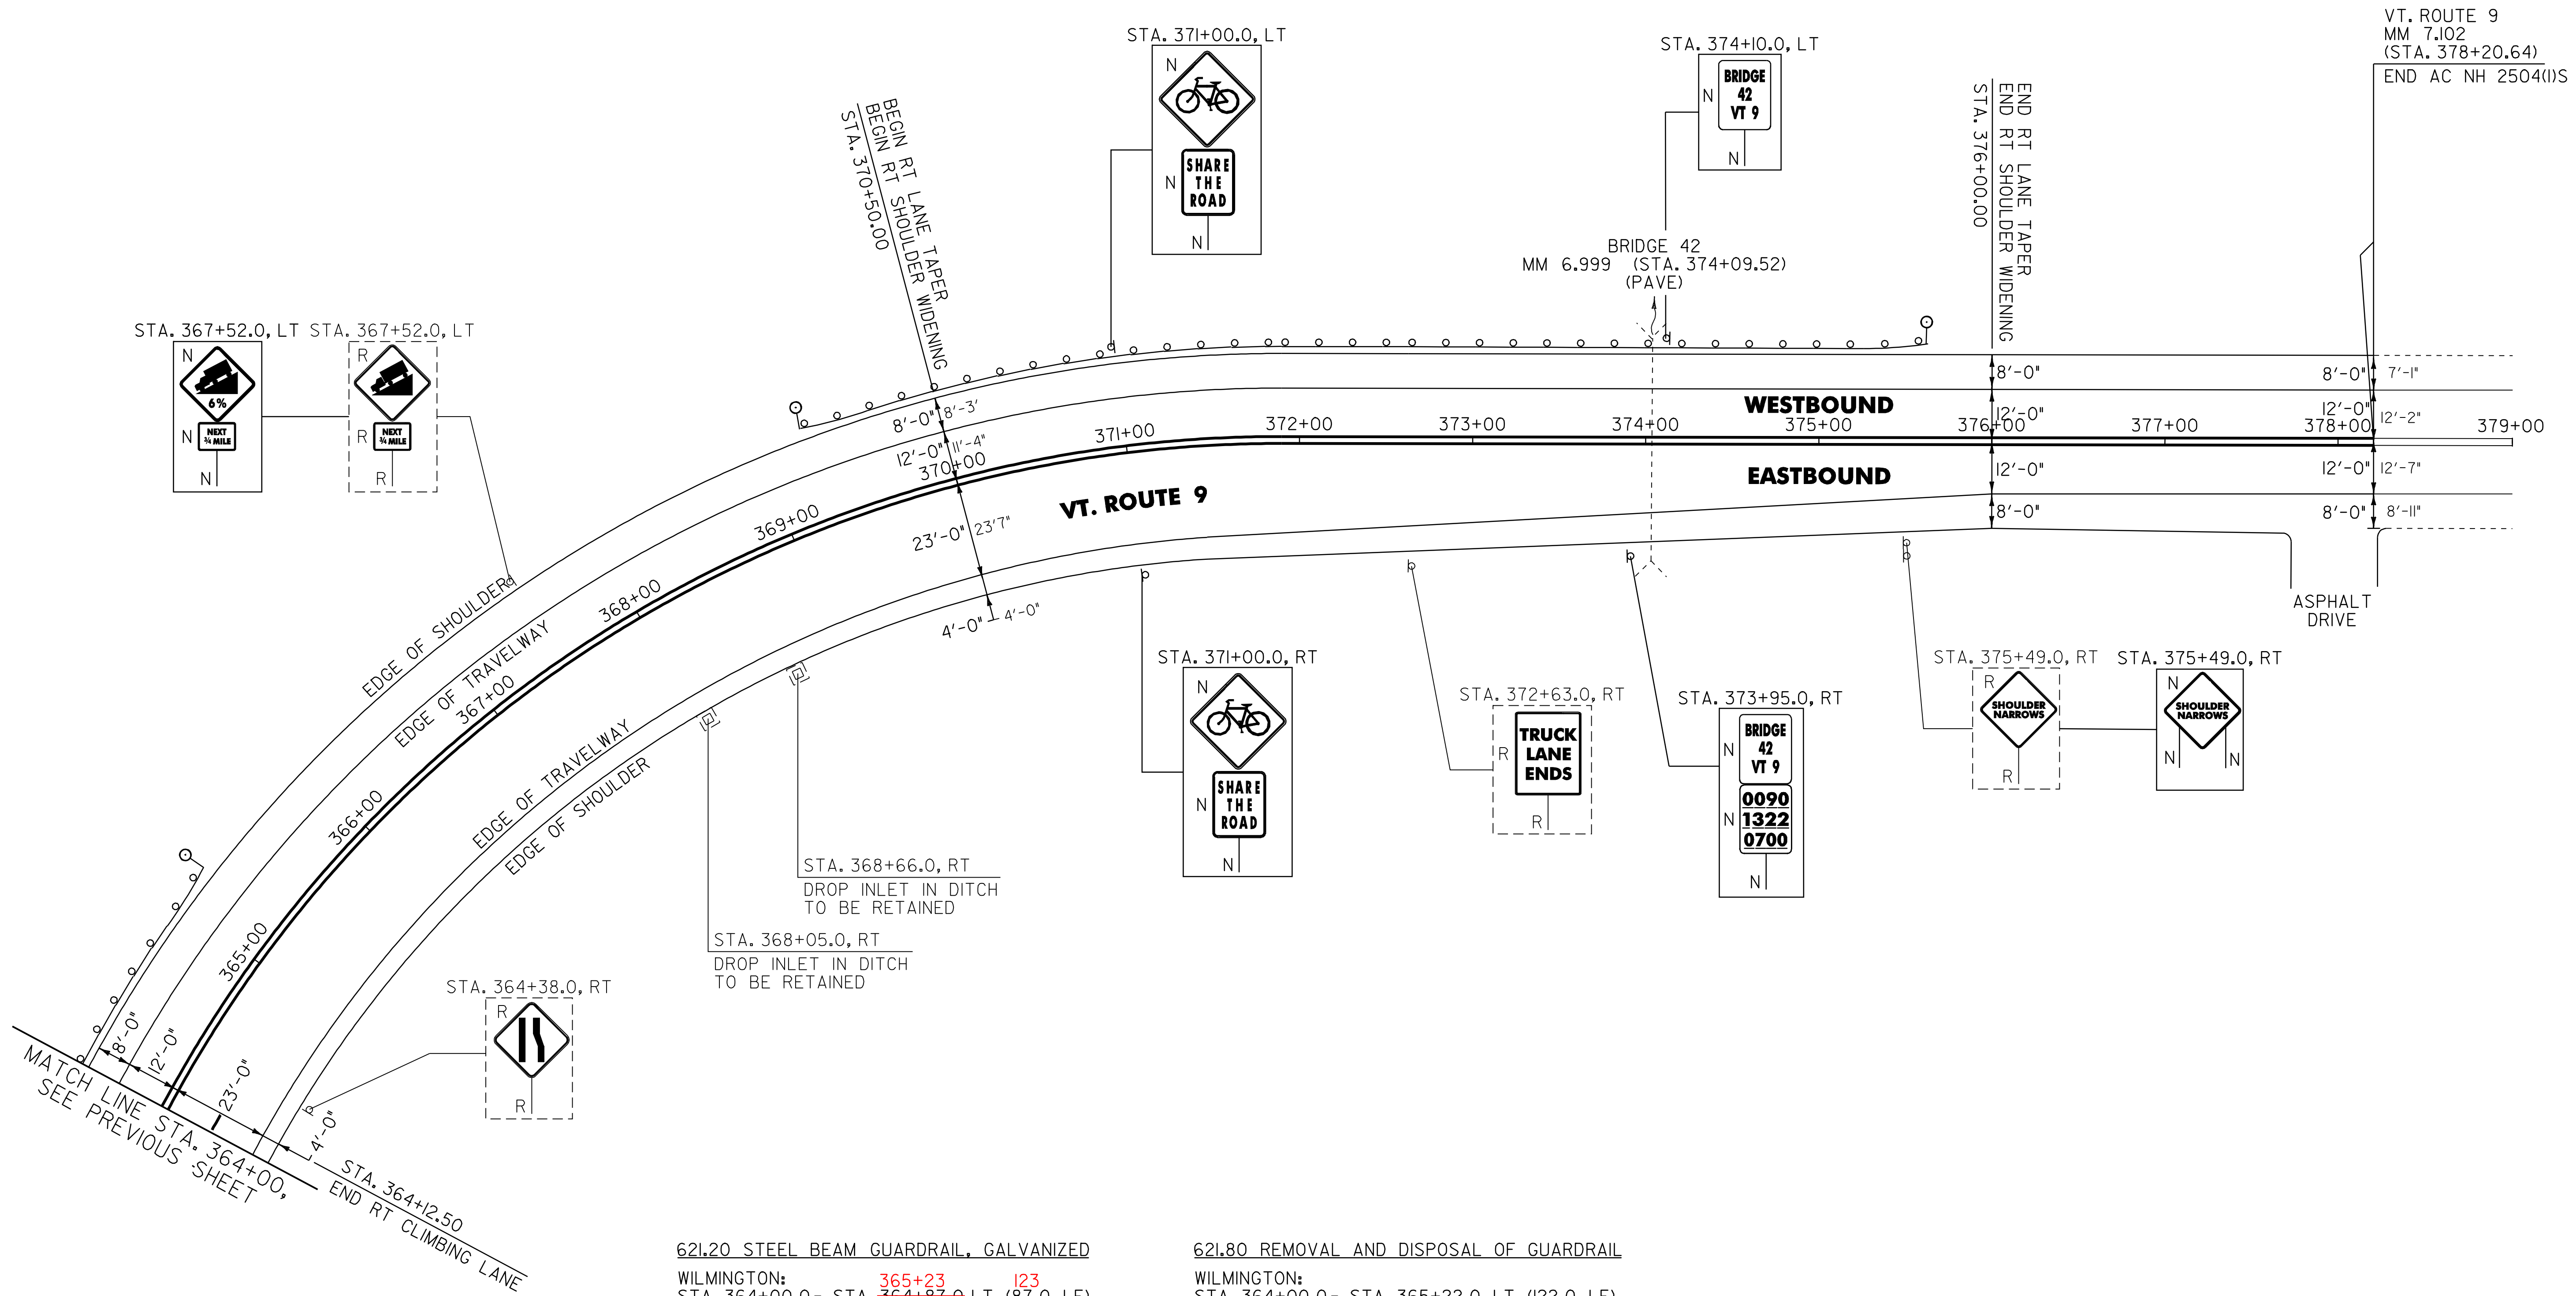

VT. ROUTE 9
 MM 7.102
 (STA. 378+20.64)
 END AC NH 2504(I)S

621.20 STEEL BEAM GUARDRAIL, GALVANIZED
 WILMINGTON:
 STA. 364+00.0 - STA. 365+23.0 LT (87.0 LF)
 STA. 369+63.0 - STA. 375+25.5 LT (562.5 LF)
 96 42 550

621.50 MANUFACTURED TERMINAL SECTION, FLARED
 WILMINGTON:
 STA. 364+87.0 - STA. 365+24.5 LT
 STA. 369+25.5 - STA. 369+63.0 LT
 STA. 375+25.5 - STA. 375+63.0 LT
 25 42 79.5

621.80 REMOVAL AND DISPOSAL OF GUARDRAIL
 WILMINGTON:
 STA. 364+00.0 - STA. 365+22.0 LT (122.0 LF)
 STA. 369+00.0 - STA. 375+57.0 LT (657.0 LF)

676.10 DELINEATOR WITH STEEL POST
 ♀ TYPE I WHITE
 WILMINGTON:
 STA. 365+24.5 LT
 STA. 369+25.5 LT
 STA. 375+63.0 LT

SIGN LEGEND
 R = REMOVE
 S = SALVAGE
 N = NEW
 RET = RETAIN
 B-B = BACK TO BACK
 EXISTING = - - - - -
 NEW = _____

NOT TO SCALE PROJECT LAYOUT SHEET #20	PROJECT NAME: WILMINGTON PROJECT NUMBER: AC_NH_2504(I)S
	FILE NAME: p05b044.dgn PROJECT LEADER: D.E.G. DESIGNED BY: M.J.M. IPARM FILE: p05b044L20.i