

TRAFFIC SIGN SUMMARY SHEET 22

MILEMARKER, STATION, OR SIGN NUMBER	SIGN LEGEND	SIGN DIMENSIONS		NEW & SALVAGED SIGNS				EXIST POST REMAIN SALVAGE	NO. OF POSTS	NEW SIGN POSTS																REMARKS	SIGN DETAIL					
		E A	WIDTH (in)	HEIGHT (in)	"A"	"B"	SALV SIGN			SALV TIS	FLANGED CHANNEL			SQUARE STEEL (in)			TUBULAR ALUMINUM Ø (in)			TUBULAR STEEL Ø (in)				W-SHAPE STEEL			DETAIL ON DWG. NUMBER	STD. SHEET NUMBER				
											lb/ft		1.75	2.0	2.5	ANCHOR	S L I P T I V E	3.0	4.0	4.0 MOD	FOUND-ATION	3.0	3.5	4.0	5.0				FTG. SIZE		WEIGHT	POST SIZE
											1.12	2.0	3.0	1.88	2.16			3.35	1.3	1.7		1.7	lb/ft						24"	30"		
WILMINGTON: 335+50.0, LT		I	24	30	5.00				I			14 X		X	X											SIGN ID CODE R2-1	1 REMOVAL	E-142				
337+30.0, LT		I	24	12	2.00				I			16 X		X	X											SIGN ID CODE M3-4		E-136B				
		I	24	24	4.00																					SIGN ID CODE MI-5		E-136B				
337+75.0, RT		I	6	8	0.33				I			8 X		X	X												SIGN ID CODE VD-701		E-134			
337+92.0, LT		I	6	8	0.33				I			8 X		X	X												SIGN ID CODE VD-701		E-134			
338+85.0, RT		I	24	30	5.00				I			14 X		X	X												SIGN ID CODE VR-017	1 REMOVAL	E-141			
339+33.0, RT		I	30	30	6.25				I			14 X		X	X											BACK-TO-BACK SIGN ID CODE RI-1	2 REMOVALS	E-143				
		I	6	10	0.42																					SIGN ID CODE VD-700		E-138				
340+45.0, RT		I	24	12	2.00				I			16 X		X	X												SIGN ID CODE M3-4	3 REMOVALS	E-136B			
		I	24	24	4.00																						SIGN ID CODE MI-5		E-136B			
																											SALVAGED SIGN TO BE MOUNTED ON NEW POST.	-	-			

FINAL POST LENGTHS ARE TO BE DETERMINED IN THE FIELD. POST SIZES ARE COMPUTED BASED ON INFORMATION FURNISHED ON THE STANDARD SHEETS AND THE ROADWAY, TRAFFIC, AND SAFETY SECTION'S "SIGN POST DESIGN GUIDELINE."


TOTALS

SF
29.33

SF

EA.

SF

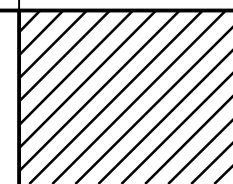


LF
-28
16

LF
-70
74

LF
-28

LF
-70

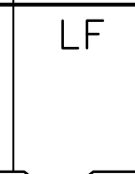

EA.

LB

LB

LB

EA.

LB

EA.

EA.

LB

EA.

EA.

LB

TRAFFIC SIGN SUMMARY SHEET #22

7 REMOVALS
PROJECT NAME: WILMINGTON
PROJECT NUMBER: AC NH 2504(I)S

FILE NAME: p05b044.dgn
PROJECT LEADER: D.E.G.
DESIGNED BY: M.J.M.
IPARM FILE: p05b044+ss22.i

PLOT DATE: 23-AUG-2010
DRAWN BY: C.A.K.
CHECKED BY: D.W.E.
SHEET 62 OF 125