


**BR 34 WILMINGTON MM 4.243 (STA. 226+03.68)**

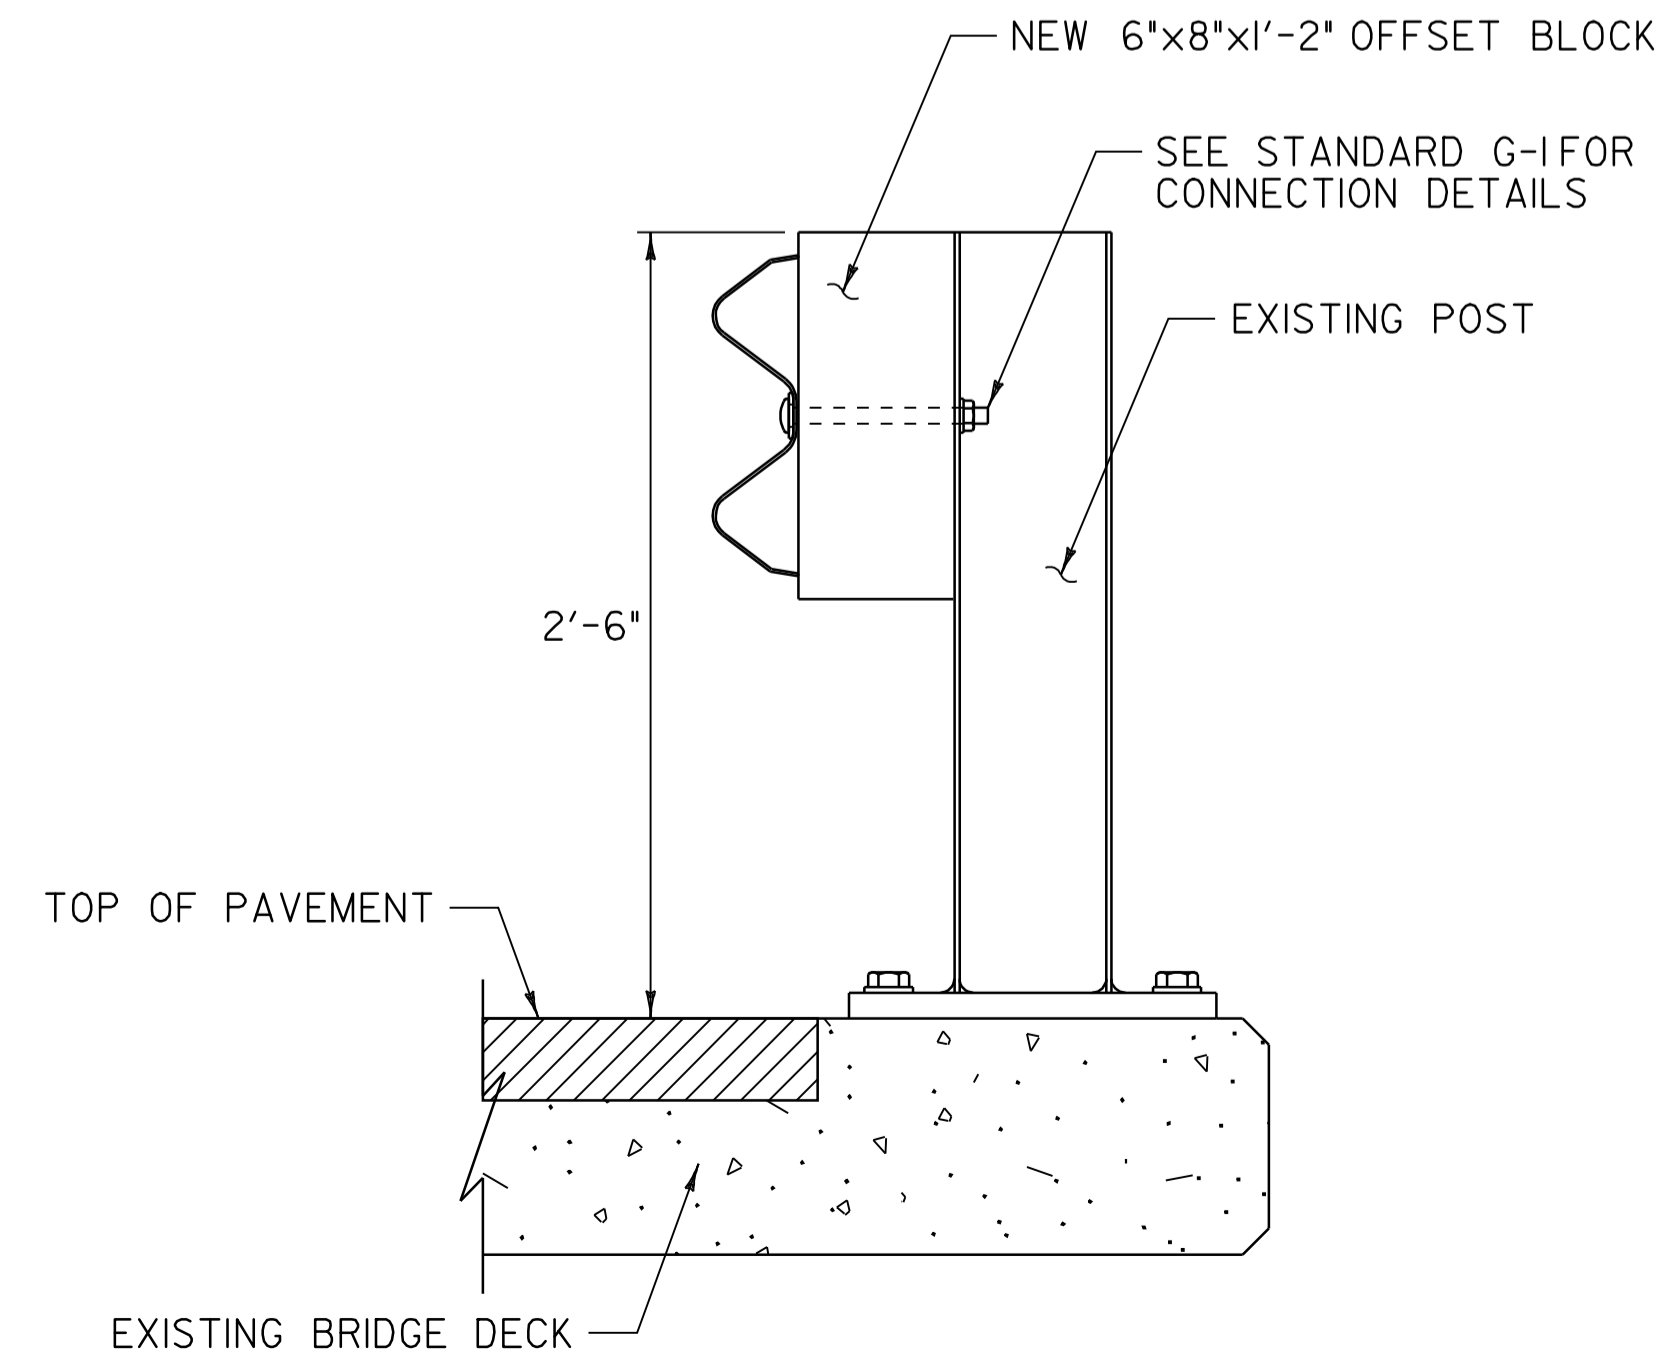

**BR 34 BRIDGE RAILING DETAIL**

NOT TO SCALE

**BRIDGE  
DETAIL  
SHEET #4**

PROJECT NAME: WILMINGTON  
PROJECT NUMBER: AC\_NH\_2504(I)S

FILE NAME: p05b044.dgn --  
PROJECT LEADER: D.E.G.  
DESIGNED BY: M.J.M.  
IPARM FILE: p05b044bd04.i

PLOT DATE: 23-AUG-2010 1:  
DRAWN BY: C.A.K.  
CHECKED BY: D.W.E.  
SHEET 74 OF 125