


FIRE HYDRANT PAVEMENT MARKING DETAIL

VT. ROUTE 9 WILMINGTON:

- STA. 136+42.0 LT
- STA. 143+78.0 LT
- STA. 148+92.0 LT
- STA. 152+43.0 LT
- STA. 156+19.0 RT
- STA. 159+52.8 RT
- STA. 169+06.0 RT
- STA. 172+80.0 RT
- STA. 185+00.0 LT

NOTE:


- I. THE CONTRACTOR SHALL ADJUST THE PLACEMENT OF THE FIRE HYDRANT PAVEMENT MARKINGS TO MEET THE EXISTING SITE CONSTRAINTS AS DIRECTED BY THE RESIDENT ENGINEER.

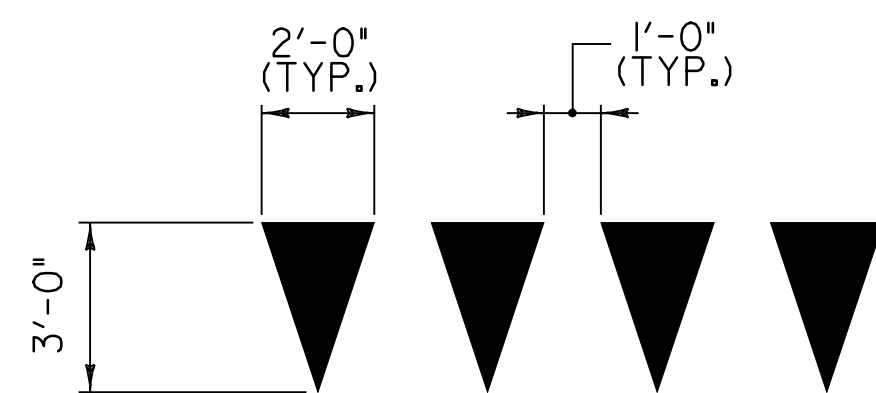

YIELD LINE DETAILS

NOTE:

- I. EACH TRIANGLE SHALL BE PAID AS ONE EACH ITEM 646.492 DURABLE LETTER OR SYMBOL, THERMOPLASTIC AND 646.692 TEMPORARY LETTER OR SYMBOL, PAINT.

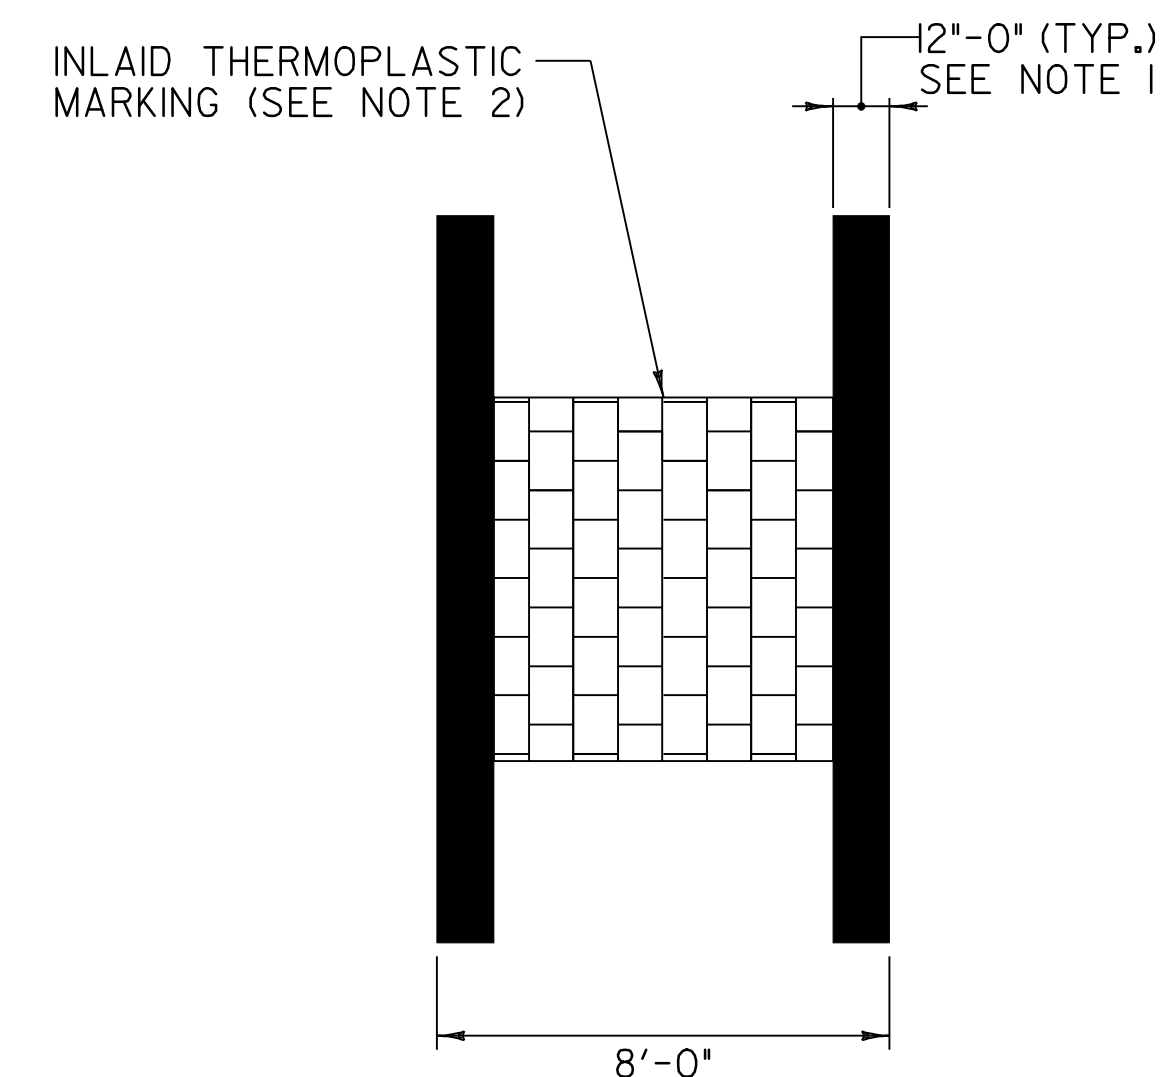

DETAIL OF CROSSWALK MARKINGS

VT. ROUTE 9

VT. ROUTE 9 WILMINGTON:

- STA. 159+24.00 LT/RT
- STA. 161+41.96 LT, TH-8
- STA. 162+50.00 LT/RT
- STA. 163+04.64 RT, TH-33
- STA. 163+15.20 LT, VT. ROUTE 100
- STA. 163+50.00 LT/RT
- STA. 165+26.40 RT, TH-63
- STA. 169+43.52 RT, TH-64
- STA. 169+85.00 LT/RT

NOTES:

1. PERMANENT CROSSWALKS SHALL HAVE A DURABLE 12" WIDE WHITE LINE PLACED ON THE OUTSIDE EDGES OF THE INLAID BRICK PATTERN.
2. THE INLAID THERMOPLASTIC MARKINGS SHALL BE RETROREFLECTIVE MATERIAL CONSISTING OF A BRICK PAVER PATTERN.
3. THE PER FOOT COST OF INSTALLED PERMANENT CROSSWALK MARKINGS, SHALL BE PAID AS ITEM 900.640 SPECIAL PROVISION (DURABLE CROSSWALK MARKING, INLAID THERMOPLASTIC).
4. TEMPORARY CROSSWALK MARKINGS SHALL ONLY CONSIST OF 12" WIDE WHITE LINE ON THE OUTSIDE EDGES AS SHOWN ABOVE. THE PER FOOT COST OF INSTALLED TEMPORARY CROSSWALK MARKINGS SHALL BE PAID UNDER ITEM 646.702 TEMPORARY CROSSWALK MARKING, PAINT.
5. THE INLAID THERMOPLASTIC MARKINGS SHALL BE WHITE "DURATHERM" OR APPROVED EQUAL.

NOT TO SCALE

**MISCELLANEOUS
DETAILS
SHEET #2**

SHEET REVISED 05/20/08

PROJECT NAME: WILMINGTON
PROJECT NUMBER: AC_NH_2504(I)S

FILE NAME: p05b044.dgn__ PLOT DATE: 23-AUG-2010 14
PROJECT LEADER: D.E.G. DRAWN BY: C.A.K.
DESIGNED BY: M.J.M. CHECKED BY: D.W.E.
IPARM FILE: p05b044md2.i SHEET 77 OF 125