


VT. ROUTE 9 POB
 STA. 218+00.00
 STOP AC NH 2504 (1) S
 BEGIN HES 010-1 (38)

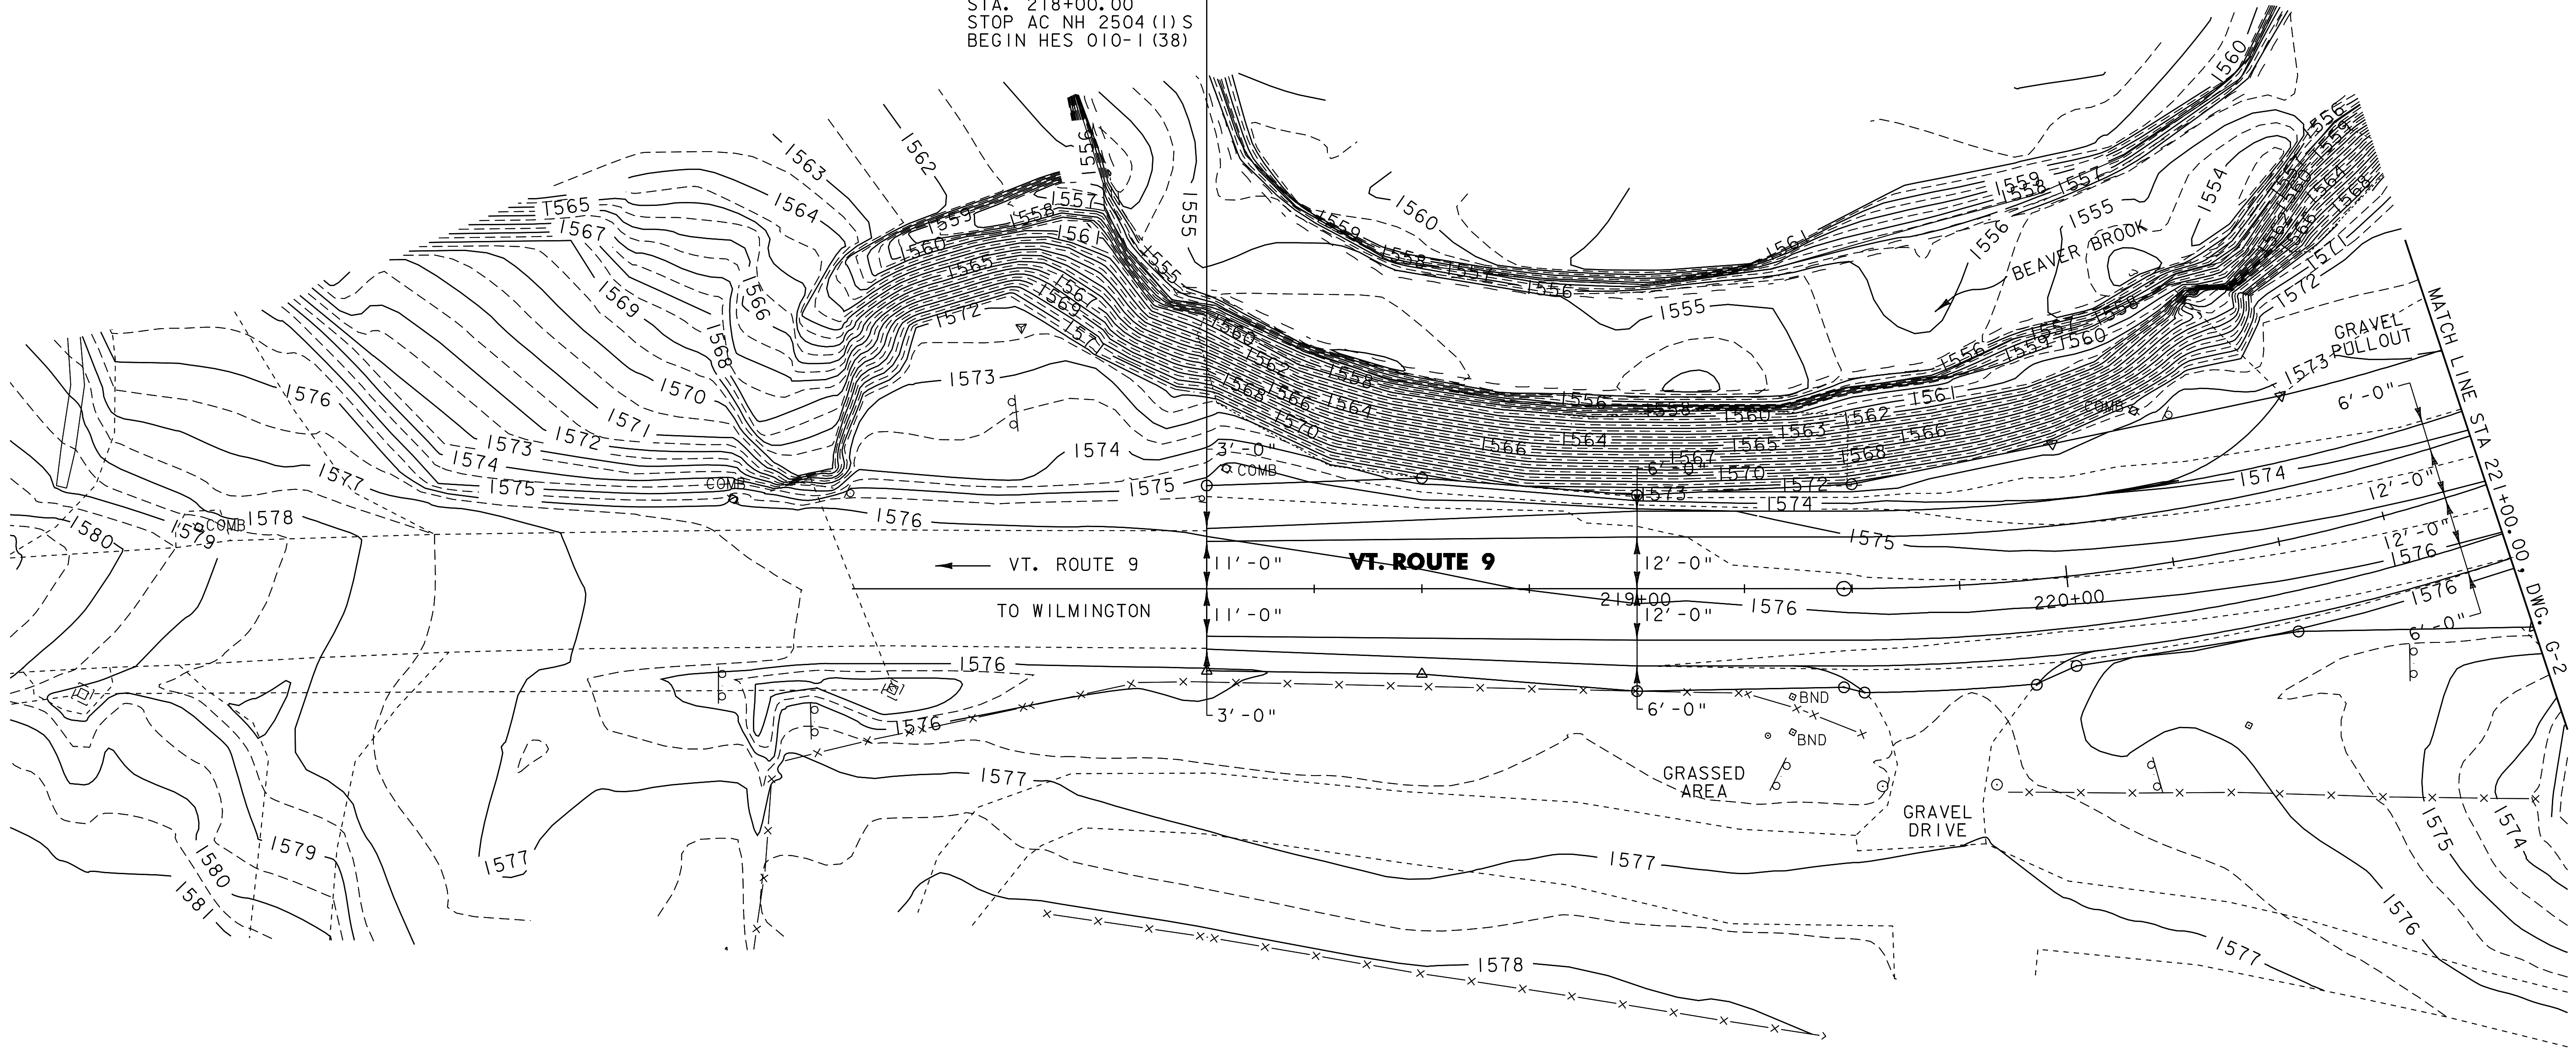

GRADING LAYOUT SHEET 1

PROJECT NAME:	WILMINGTON	PLOT DATE:	2014-03-27
PROJECT NUMBER:	HES_010-1(38)	DRAWN BY:	CAK
FILE NAME:	05c324sta lay.dgn	DESIGNED BY:	DWE
PROJECT LEADER:	DEG	CHECKED BY:	DWE
GRADING_LAYOUT_SHEET_GG-I		SHEET	94 OF 125

