


POE  
VT. ROUTE 9 STA 223+33.25 =  
VT. ROUTE 100 STA 130+71.21  
 $\Delta=90^{\circ}00'00''$

VT. ROUTE 9 POE  
STA 225+50.00  
END HES 010-1 (38)  
RESUME AC NH 2504 (1) S

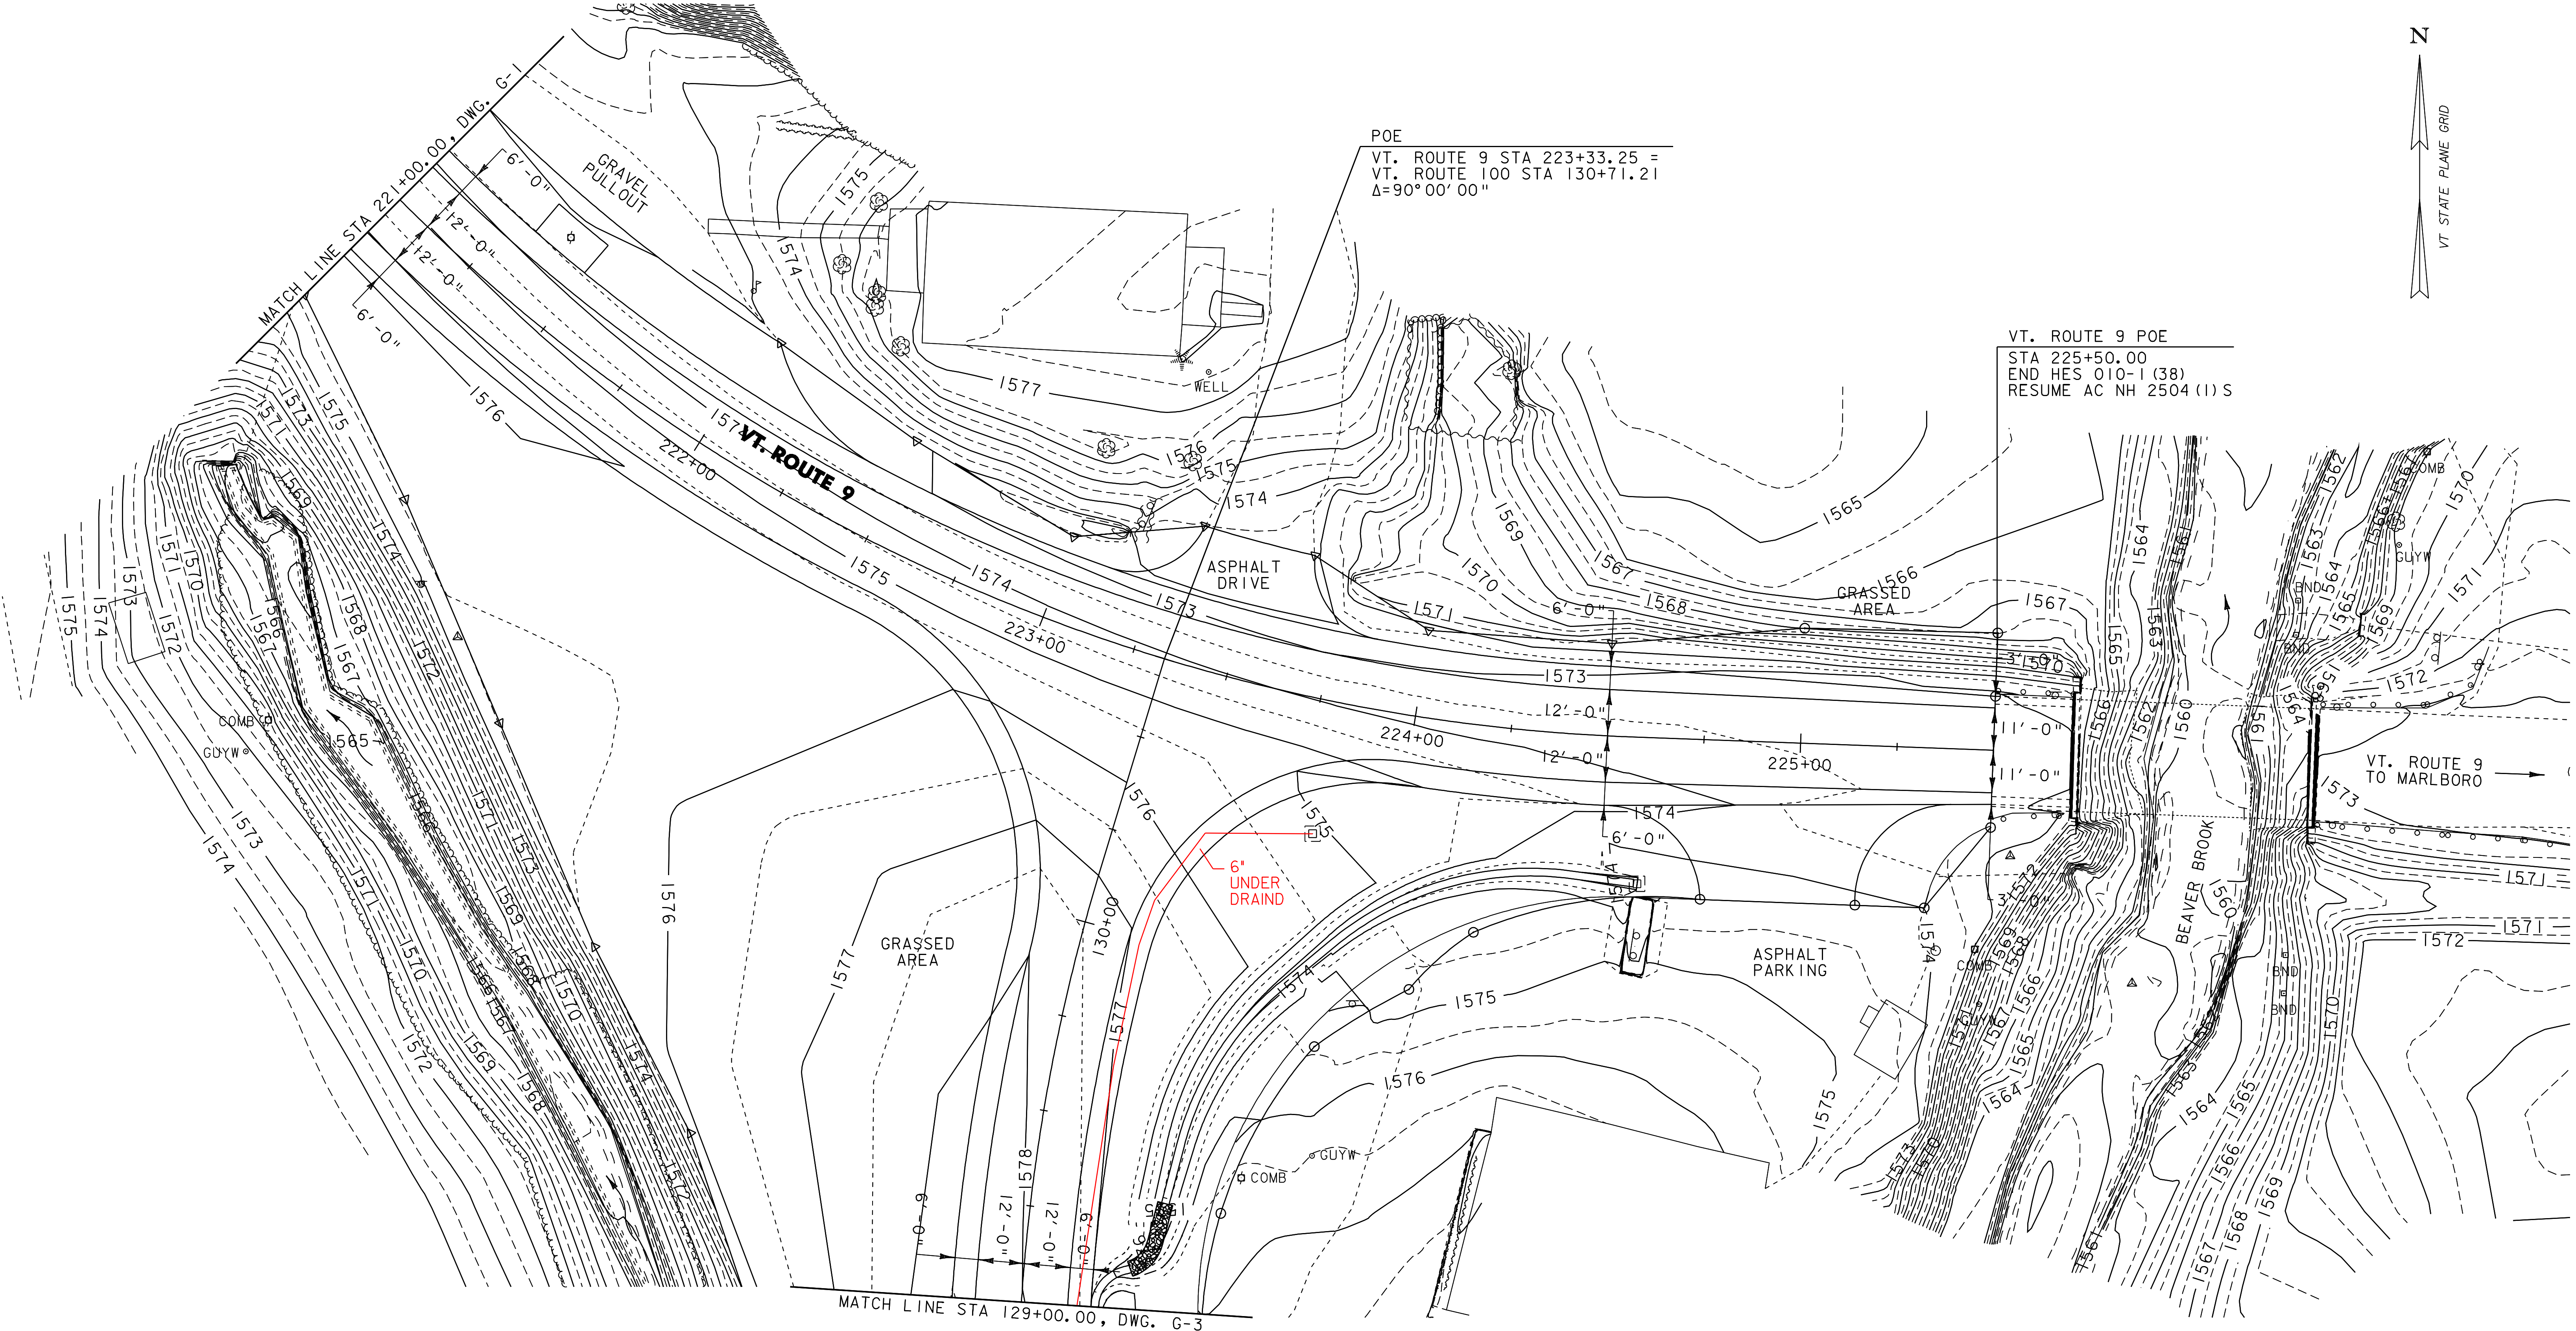

### GRADING LAYOUT SHEET 2

PROJECT NAME:	WILMINGTON	PLOT DATE:	2024-03-22 09:41:41
PROJECT NUMBER:	HES_010-1(38)	DRAWN BY:	CAK
FILE NAME:	Q5c324.stn lay.dgn	CHECKED BY:	DWE
DESIGNED BY:	DWE	SHEET	95 OF 125
GRADING_LAYOUT_SHEET_G622			

