




VT. ROUTE 100
STA 123+00.00
BEGIN APPROACH

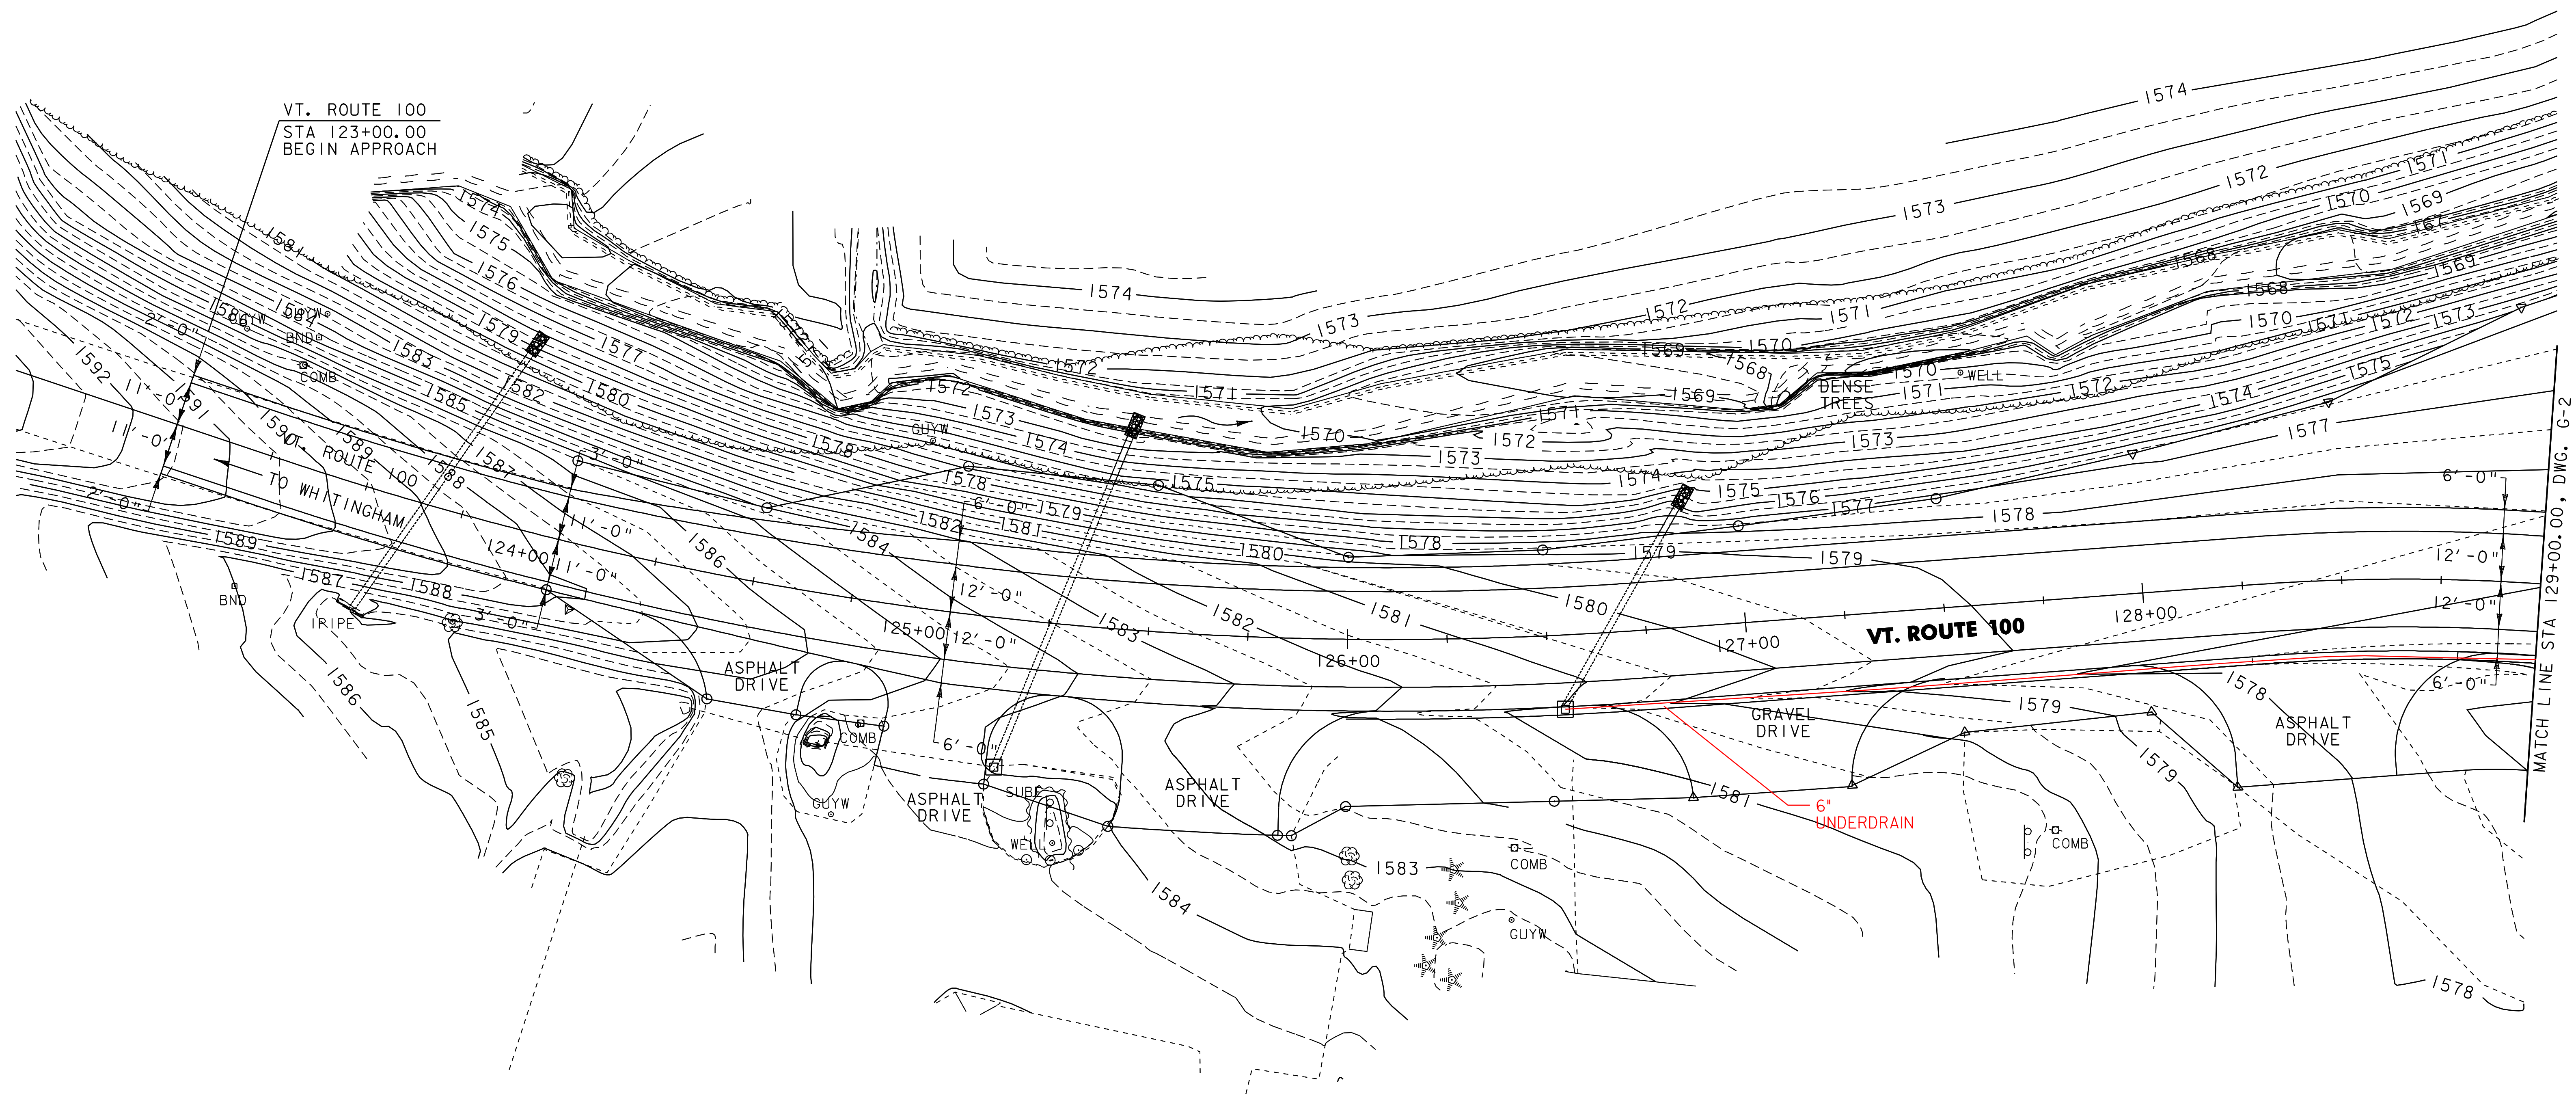

MATCH LINE STA 129+00.00, DWG. G-2

GRADING LAYOUT SHEET 3

PROJECT NAME:	WILMINGTON	FILE NAME:	Q5c324.stn lay.dgn	PLOT DATE:	2004/03/24 09:41:48
PROJECT NUMBER:	HES_OIO-1(38)	PROJECT LEADER:	DEG	DRAWN BY:	CAK
		DESIGNED BY:	DWE	CHECKED BY:	DWE
		GRADING_LAYOUT_SHEET_G633		SHEET	96 OF 125

