


RESOURCES LEGEND	
XXX	SOIL MAP UNIT TYPE (SEE SHEET 97 FOR DETAILS)
.....	SOIL LINE BOUNDARY
~~~~~	WETLAND / RIPARIAN BOUNDARY
- - - - -	WETLAND BUFFER / RIPARIAN BUFFER

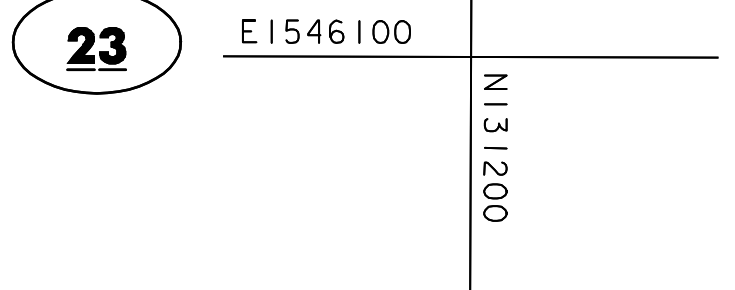

**EXISTING  
CONDITION  
PLAN  
SHEET 3**

PROJECT NAME: WILMINGTON	PLOT DATE: 12/13/2011
PROJECT NUMBER: HES_010-1(38)	DRAWN BY: CAK
FILE NAME: Q5c324.dwg	CHECKED BY: DWE
PROJECT LEADER: DEC	SHEET 104 OF 125
DESIGNED BY: DWE	
EXISTING_CONDITION_PLAN_EXP33	