


POE
 VT. ROUTE 9 STA 223+33.25 =
 VT. ROUTE 100 STA 130+71.21
 $\Delta=90^{\circ}0'0''$

VT. ROUTE 9 POE
 STA. 225+50.00
 END HES 010-1(38)
 RESUME AC NH 2504(1) S

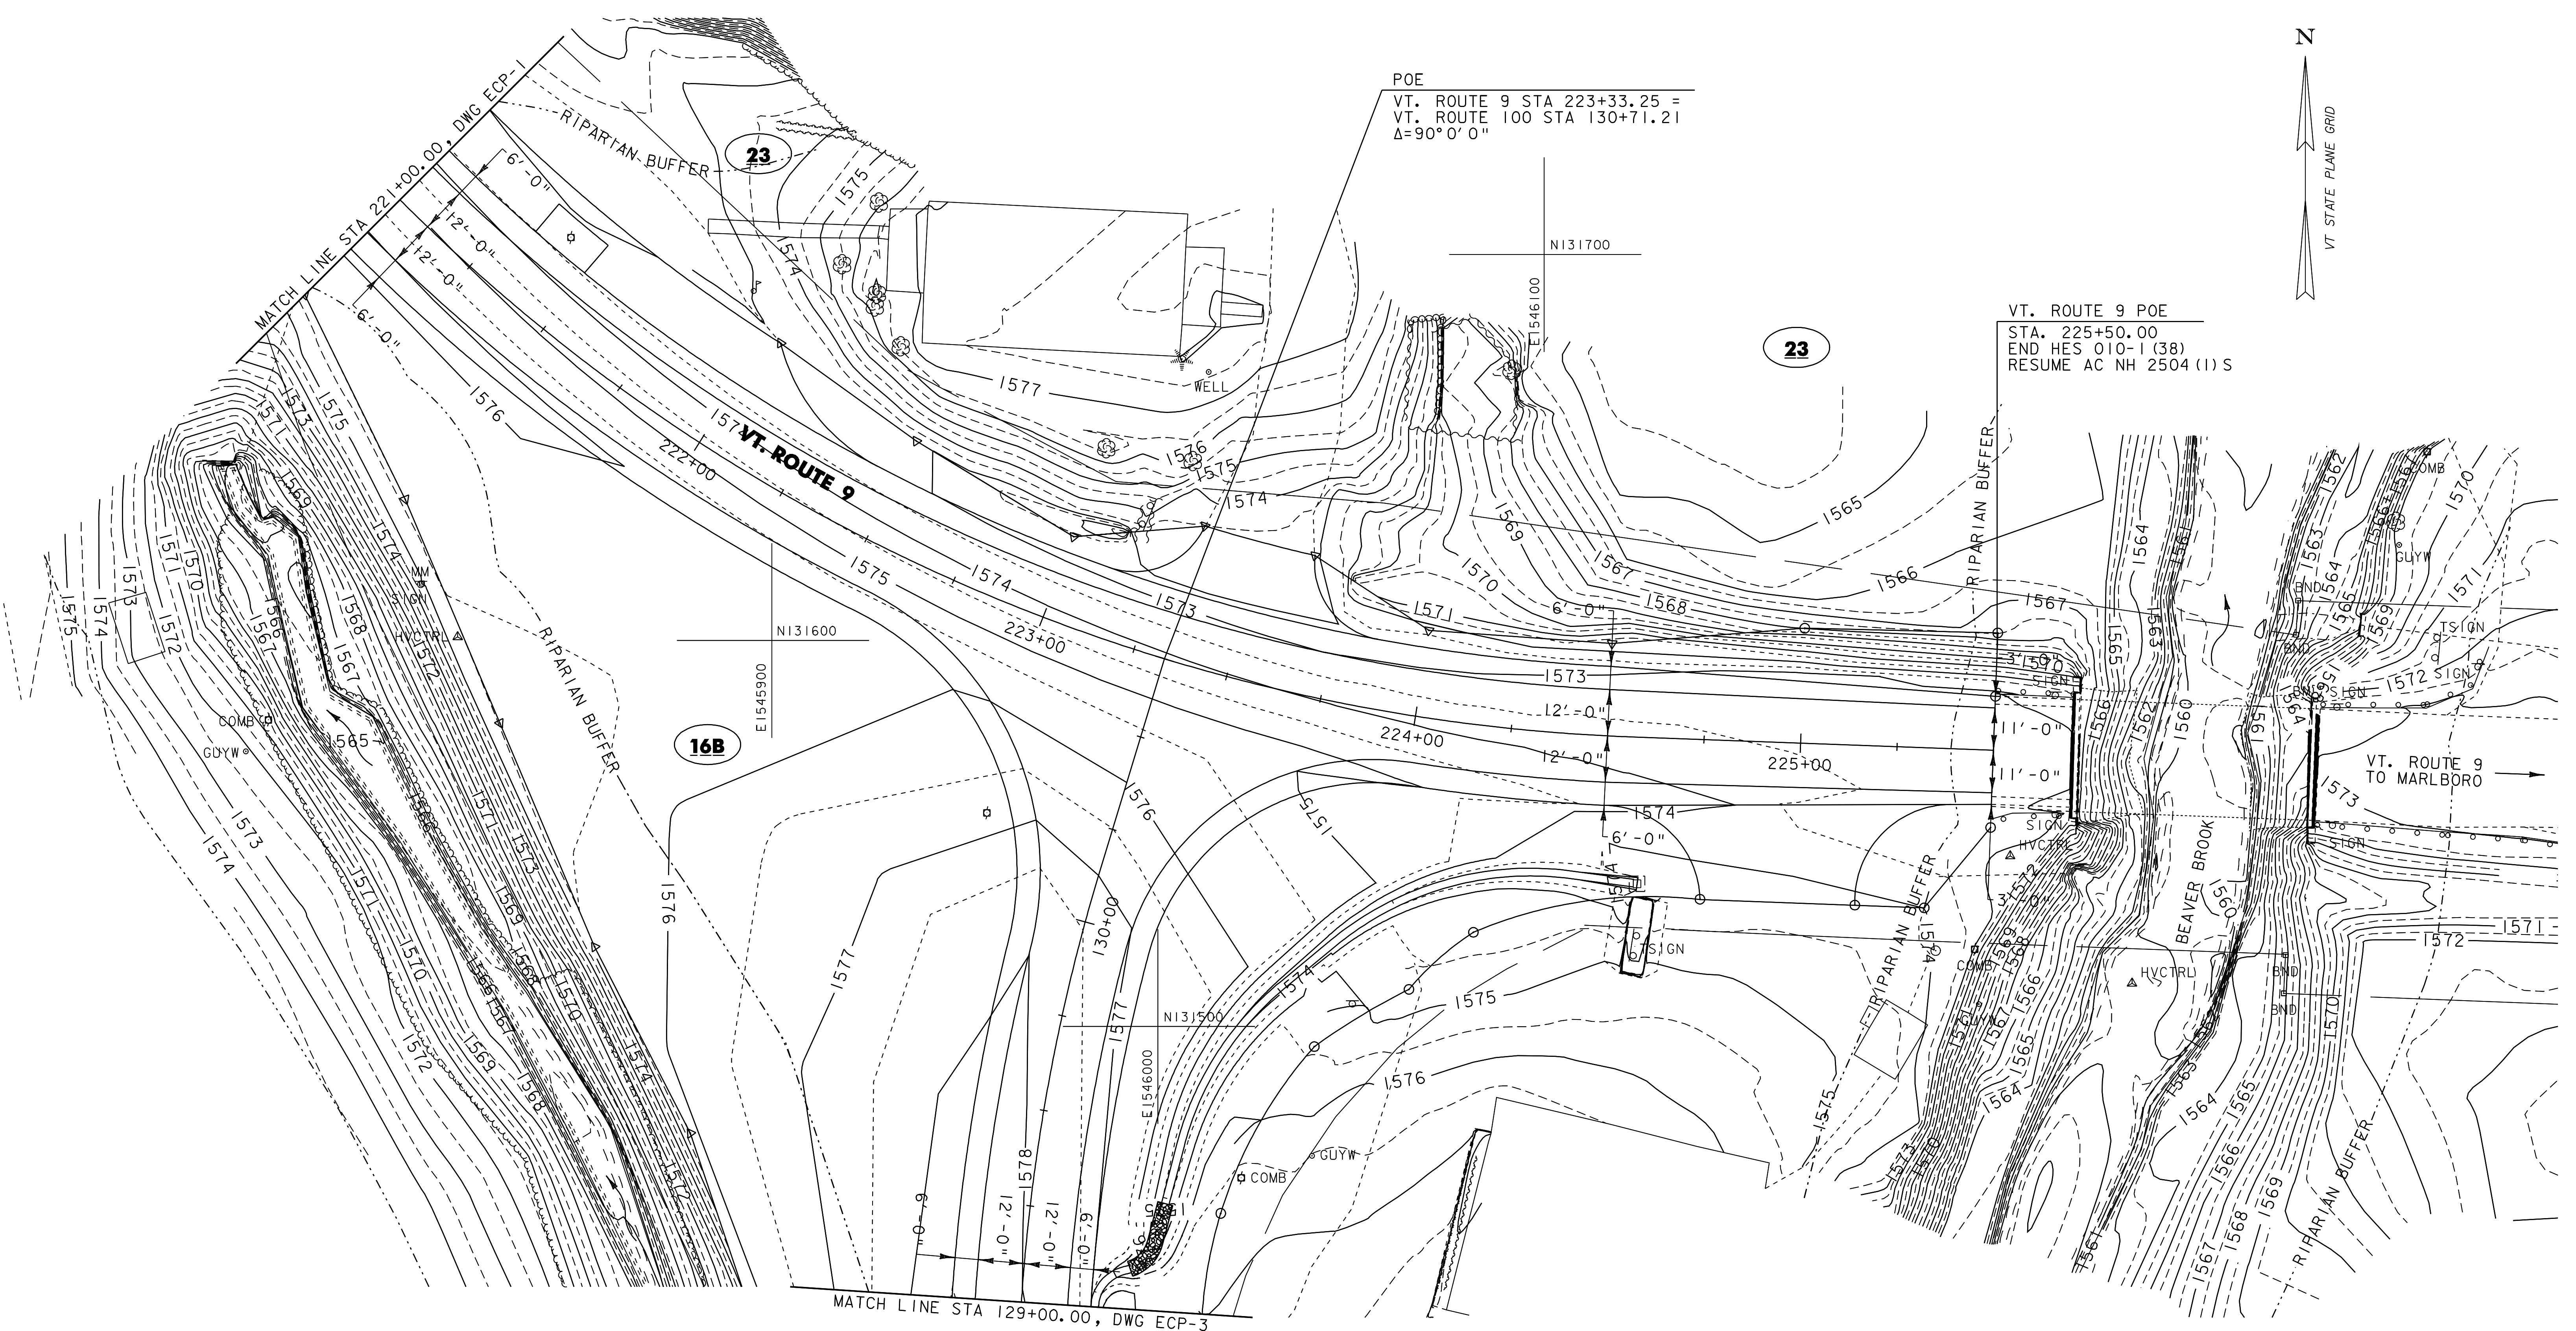

16B

23

23

RESOURCES LEGEND

	SOIL MAP UNIT TYPE (SEE SHEET 97 FOR DETAILS)
	SOIL LINE BOUNDARY
	WETLAND / RIPARIAN BOUNDARY
	WETLAND BUFFER / RIPARIAN BUFFER



**FINAL
 CONDITIONS
 PLAN
 SHEET 2**

0 20 40
 SCALE IN FEET

PROJECT NAME: WILMINGTON	PLOT DATE: 2024-03-22
PROJECT NUMBER: HES_010-1(38)	DRAWN BY: CAK
FILE NAME: 05c324.dwg	DESIGNED BY: DWE
PROJECT LEADER: DEG	CHECKED BY: DWE
DESIGNED BY: DWE	SHEET 109 OF 125
FINAL_CONDITIONS_PLAN_FEEP22	