



130+50
END HES 010-1 (38)

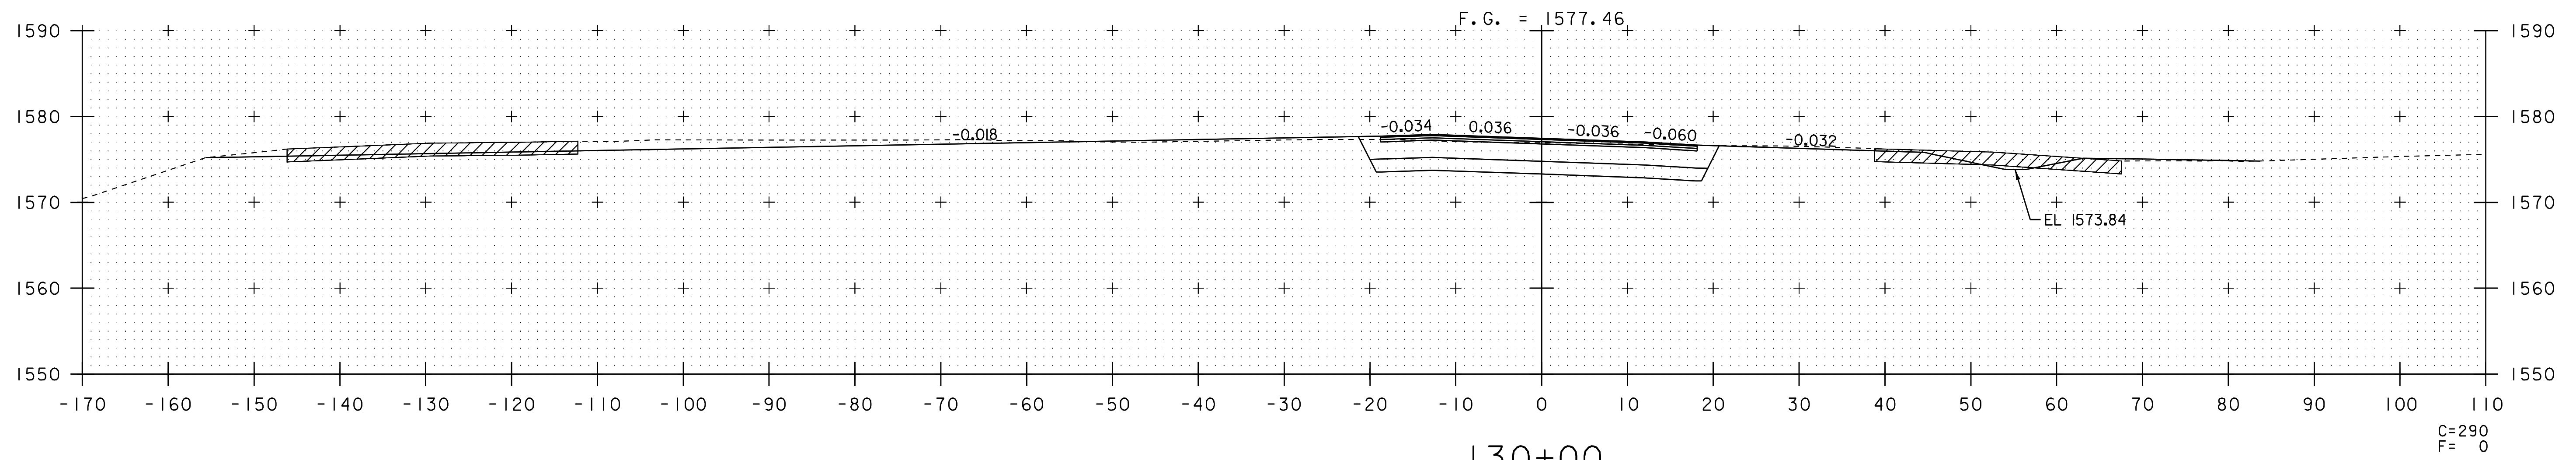

130+00

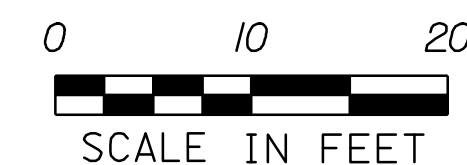

VT RTE 100
CROSS SECTION
SHEET 4
STA. 130+00 TO STA. 130+50

PROJECT NAME: WILMINGTON	PLOT DATE: 2/24/2010
PROJECT NUMBER: HES 010-1(38)	DRAWN BY: CAK
FILE NAME: 05c324.dwg	CHECKED BY: DWE
PROJECT LEADER: DEG	SHEET 121 OF 125
DESIGNED BY: DWE	
VI. ROUTE 100 CROSS SECTIONS XS-4	