




223+00

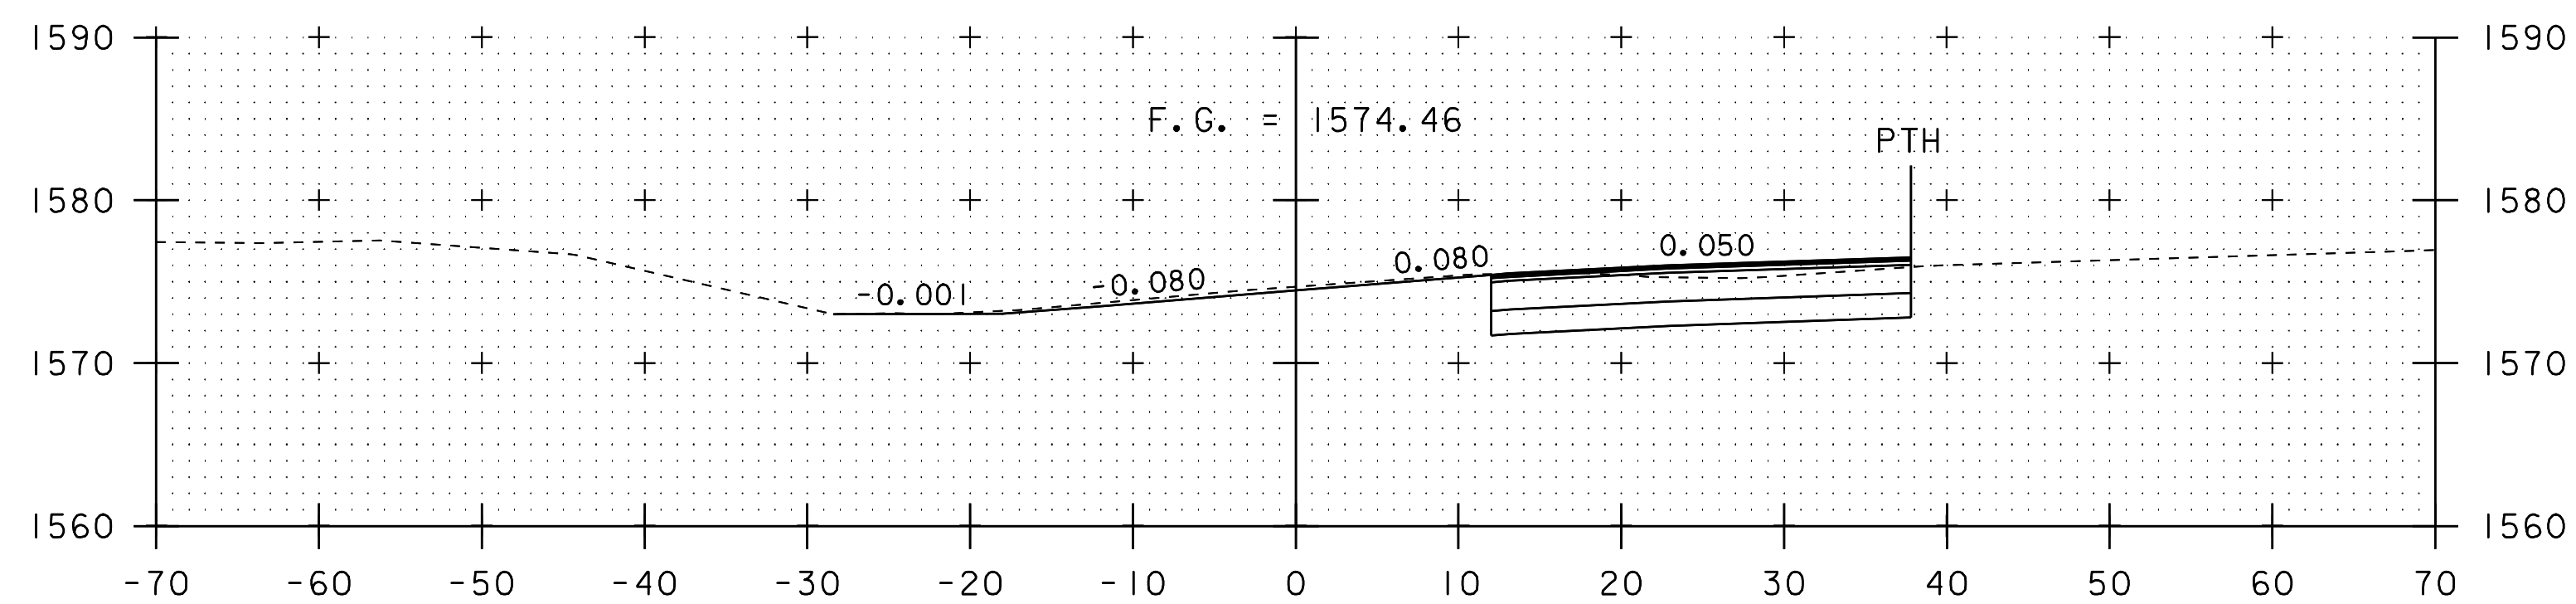


222+50

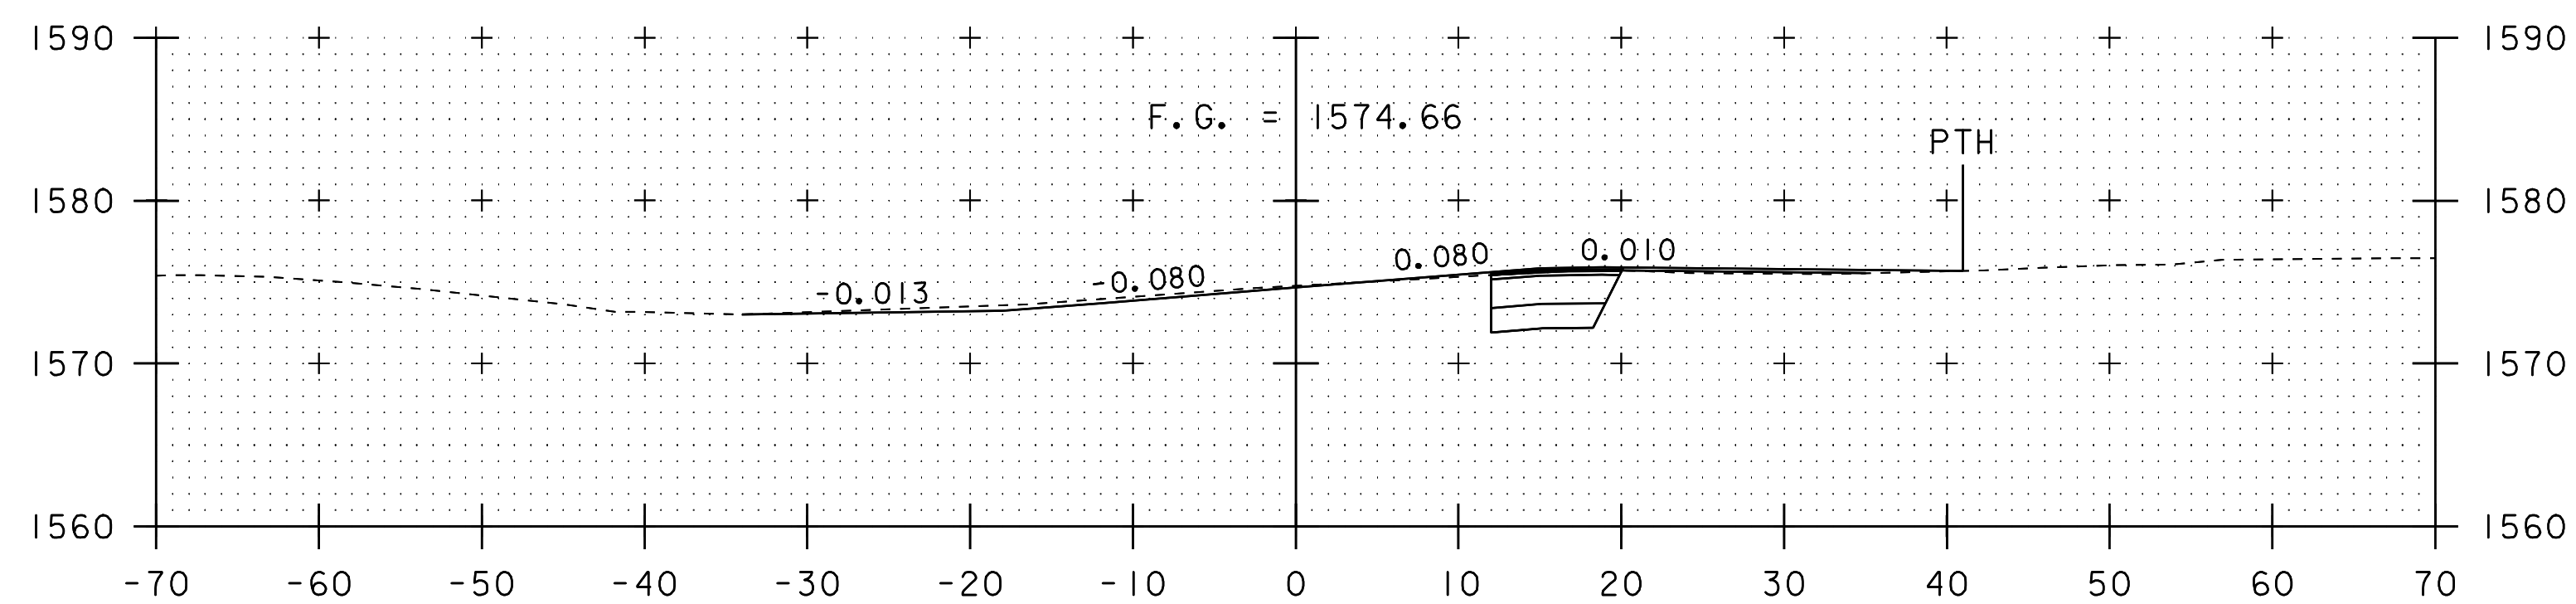


222+00

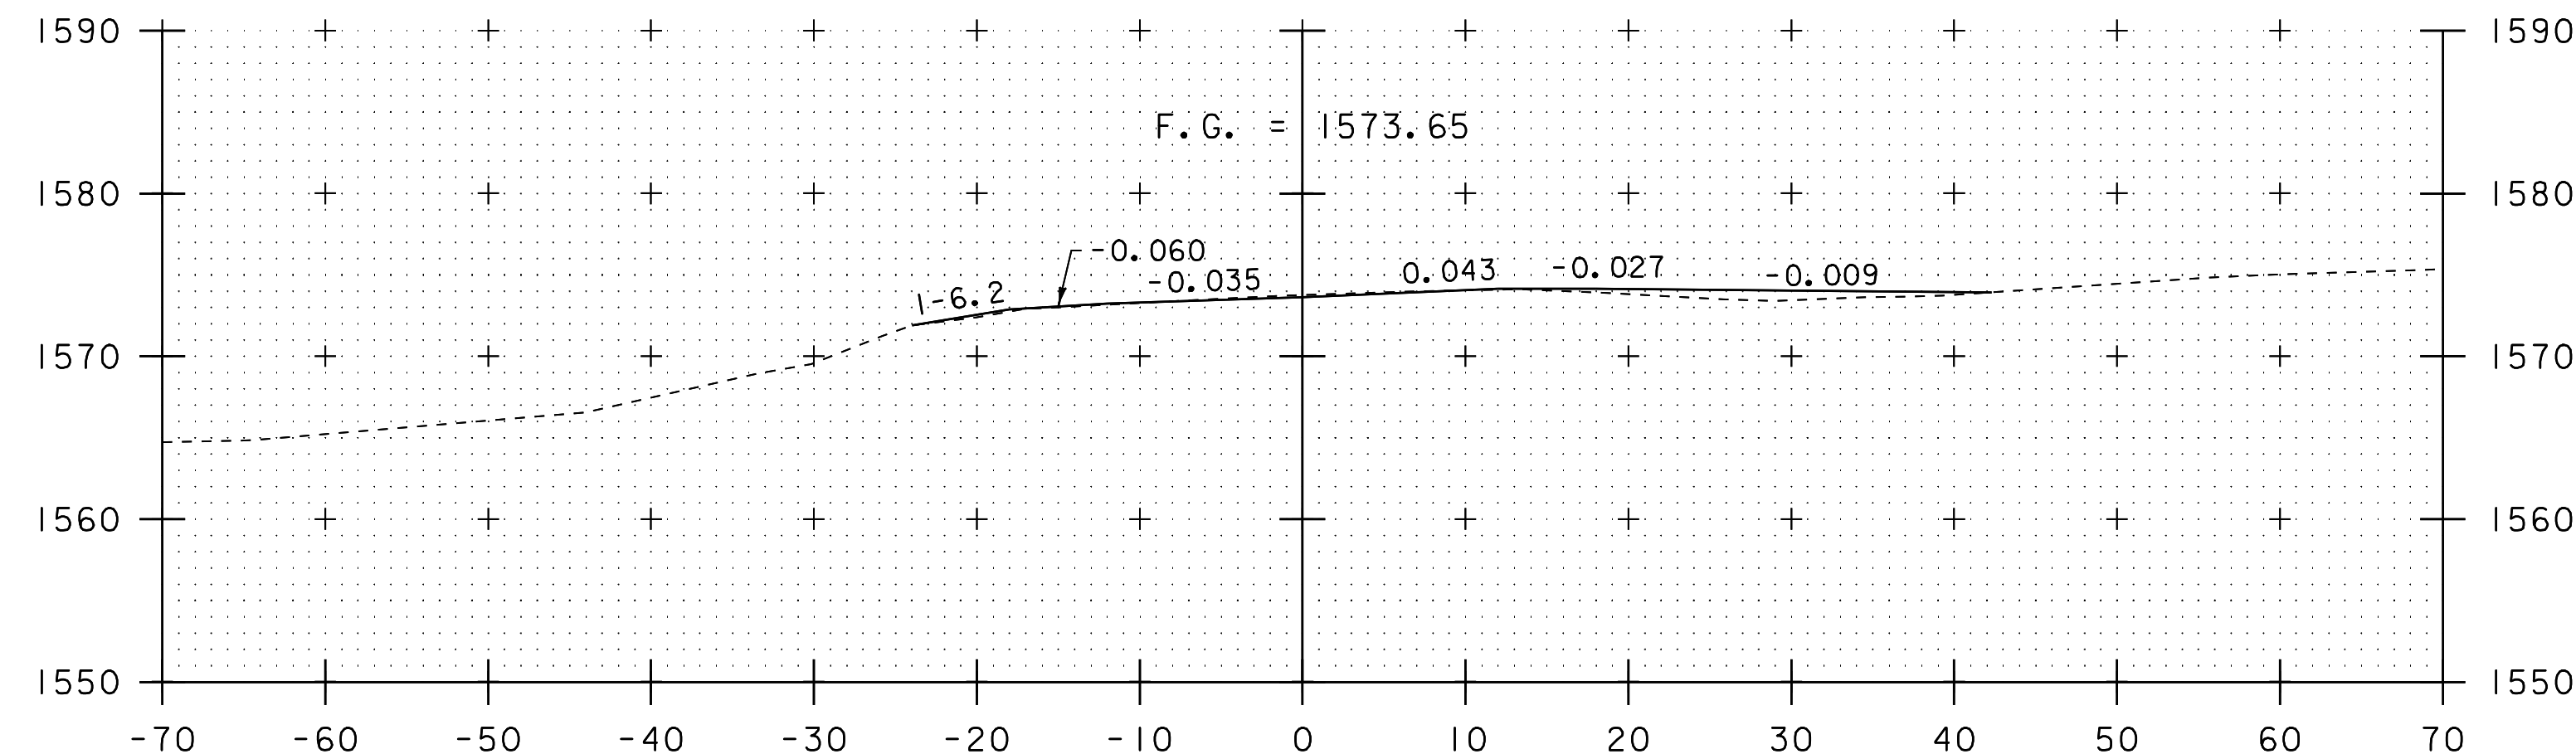


224+50

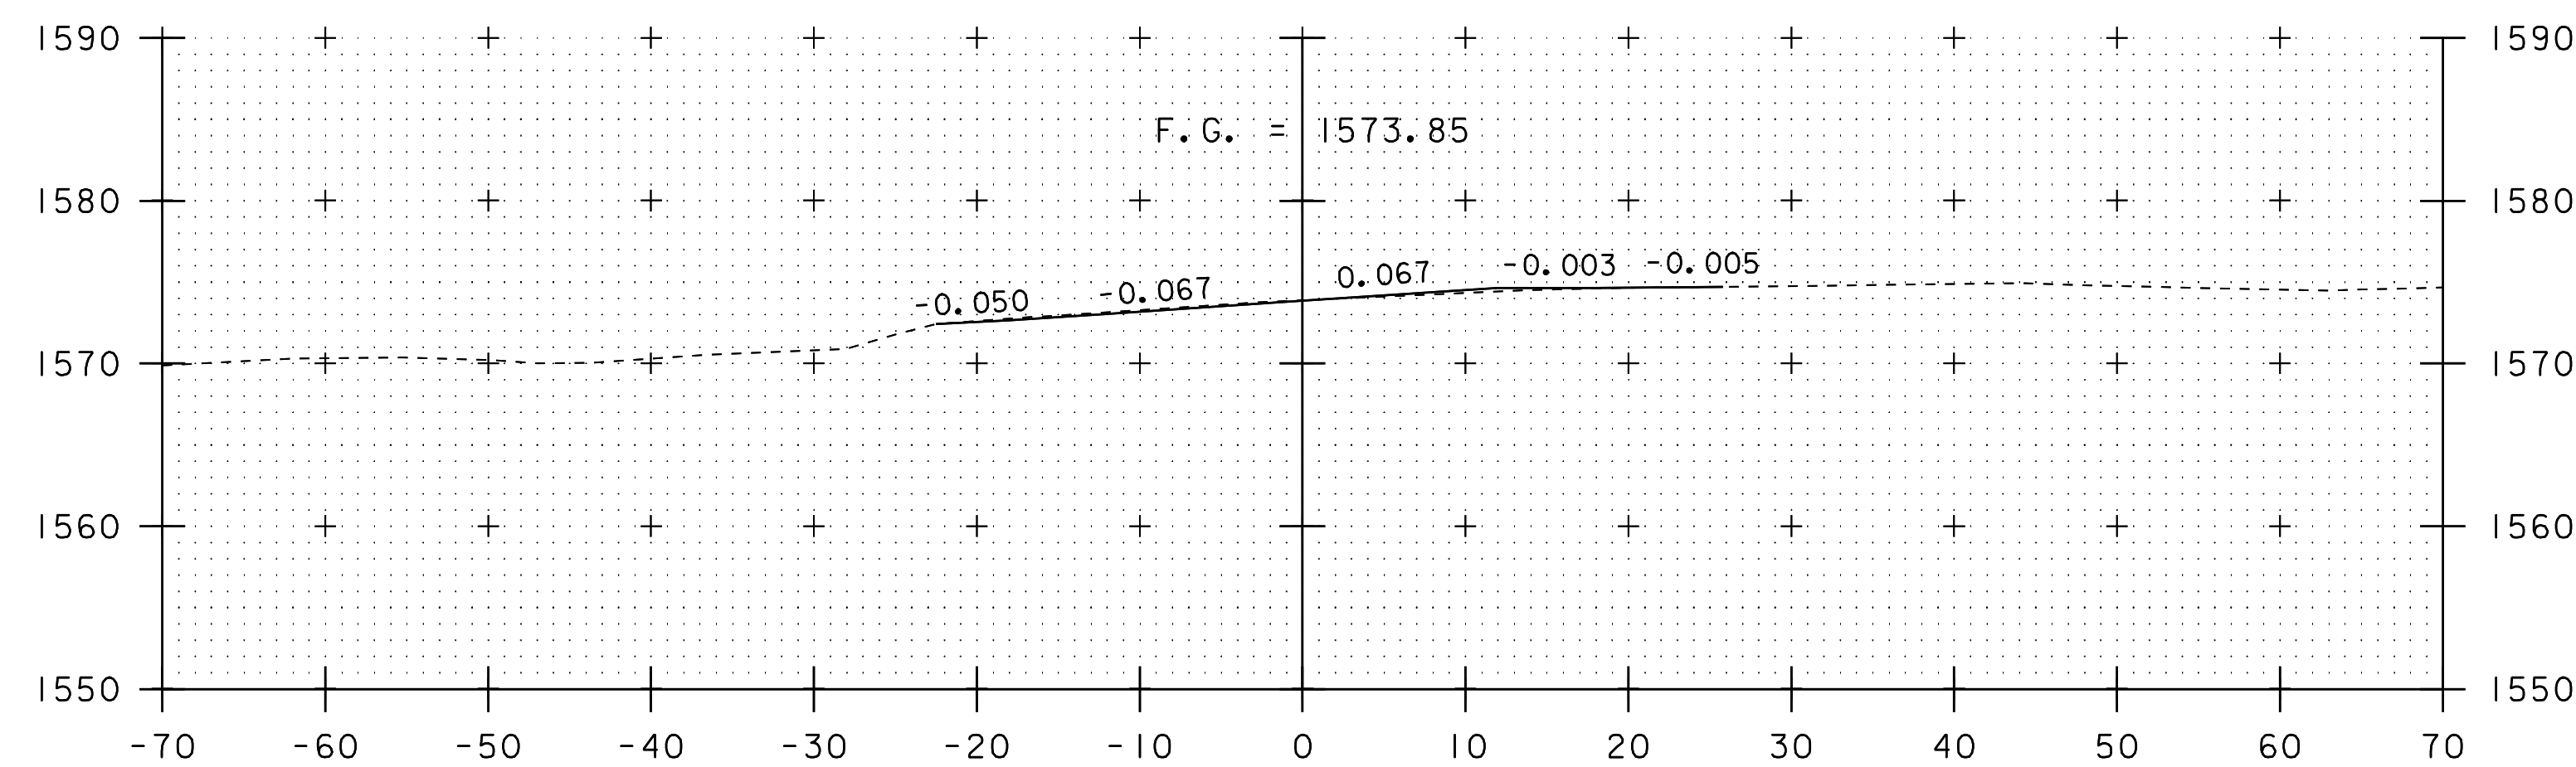

224+00

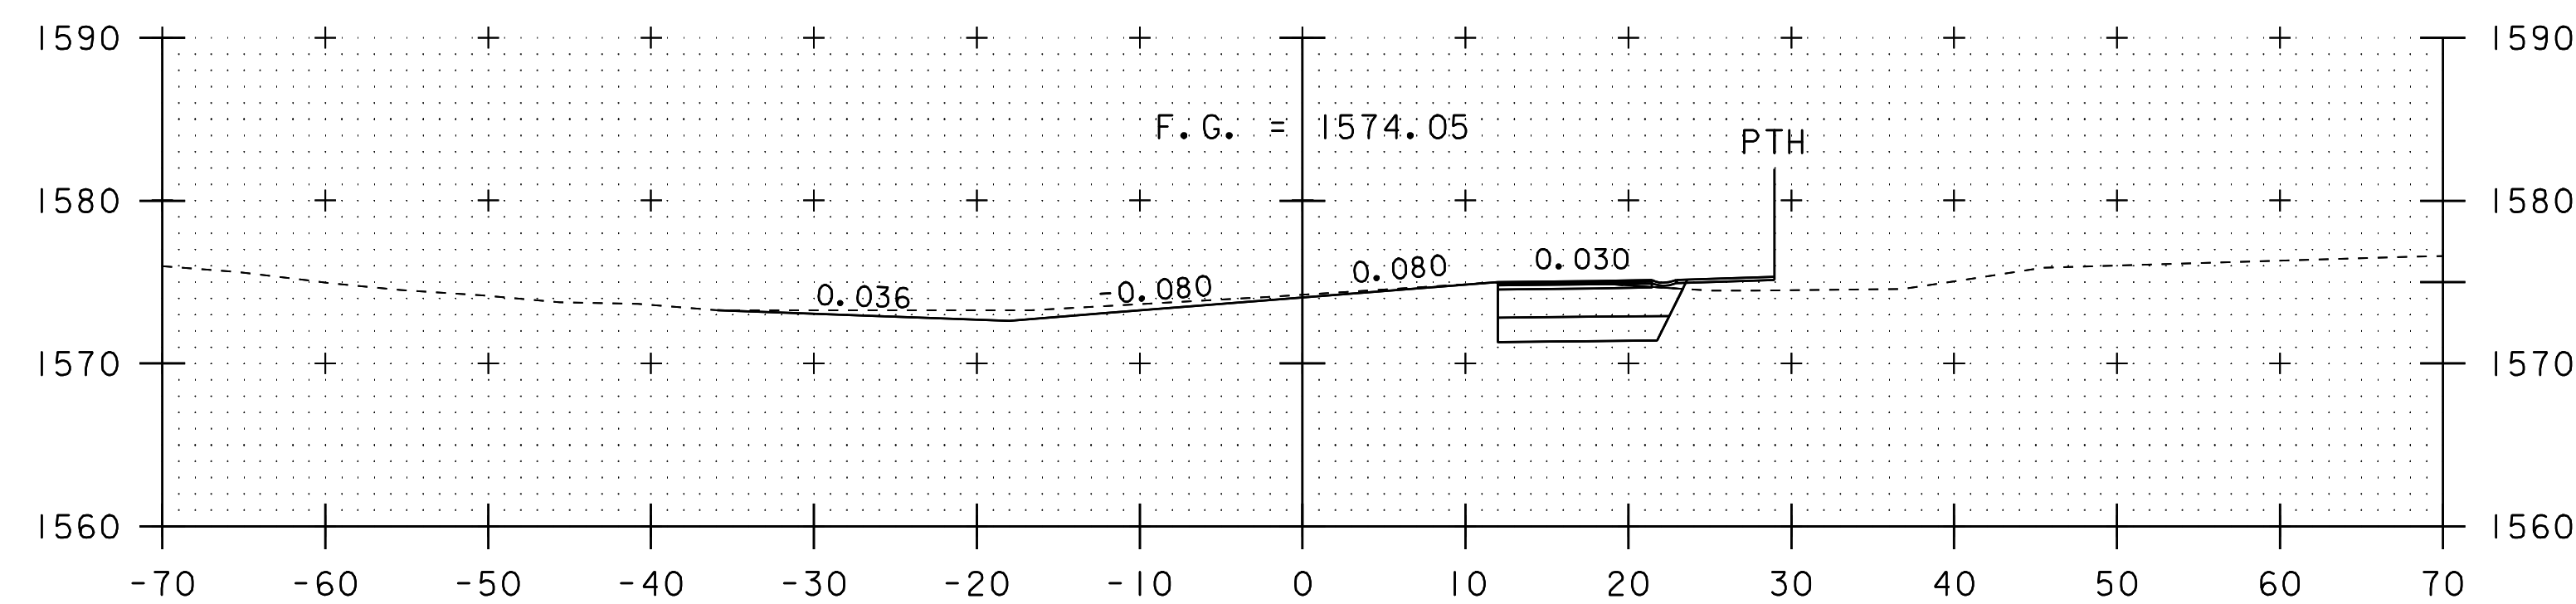

223+50

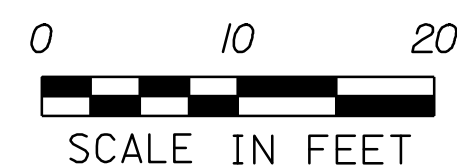

VT ROUTE 9
CROSS SECTION
SHEET 3

STA. 222+00 TO STA. 224+50

PROJECT NAME: WILMINGTON	FILE NAME: 05c324x80.dgn	PLOT DATE: 2/24/2010 10:48:48
PROJECT NUMBER: HES_OIO-1(38)	PROJECT LEADER: DEG	DRAWN BY: CAK
DESIGNED BY: DWE	CHECKED BY: DWE	
VI ROUTE 9 CROSS SECTIONS X8577	SHEET 124	OF 125