



225+50
RESUME AC NH 2504 (1) S
END HES 010-1 (38)

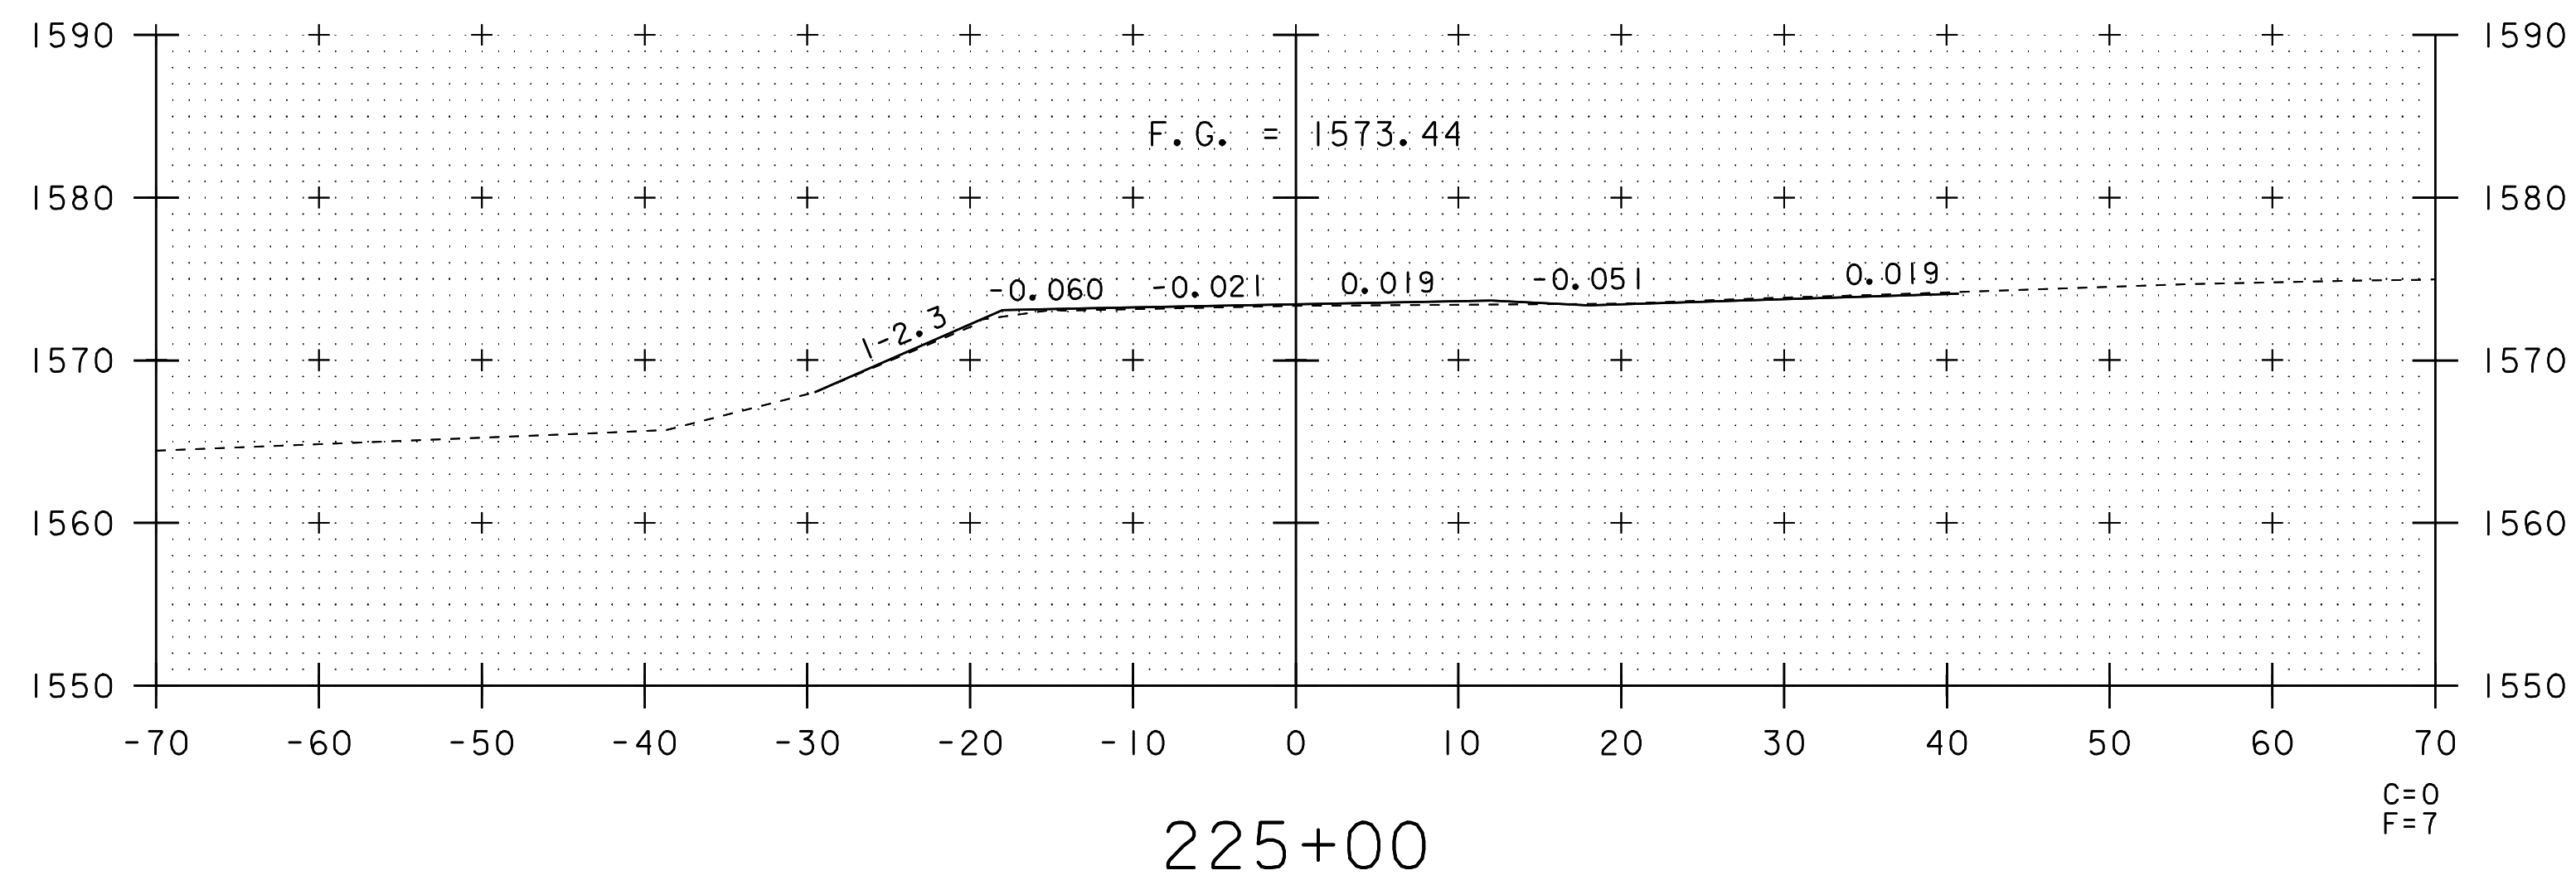

225+00

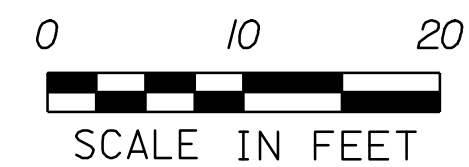

VT ROUTE 9
CROSS SECTION
SHEET 4
STA. 225+00 TO STA. 225+50

PROJECT NAME: WILMINGTON	PLOT DATE: 2/24/2010
PROJECT NUMBER: HES_010-1(38)	DRAWN BY: CAK
FILE NAME: Q5c324xs2.dgn	CHECKED BY: DWE
DESIGNED BY: DWE	SHEET 125 OF 125