


C&E
2/24/09
✓ M.W.H. 3/5/09

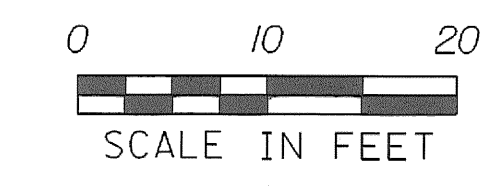

**VT RTE. 100
CROSS SECTION
SHEET 3**

STA. 129+00 TO STA. 130+00

| | |
|-----------------------------------|------------------------|
| PROJECT NAME: WILMINGTON | PLOT DATE: 28-APR-2008 |
| PROJECT NUMBER: HES 010-K(38) | DRAWN BY: CAK |
| FILE NAME: 05c324.dgn | CHECKED BY: DWE |
| DESIGNED BY: DWE | SHEET 120 OF 125 |
| VT. ROUTE 100 CROSS SECTIONS XS-3 | |