


C=216  
F= 64

130+50  
END HES 010-1 (38)

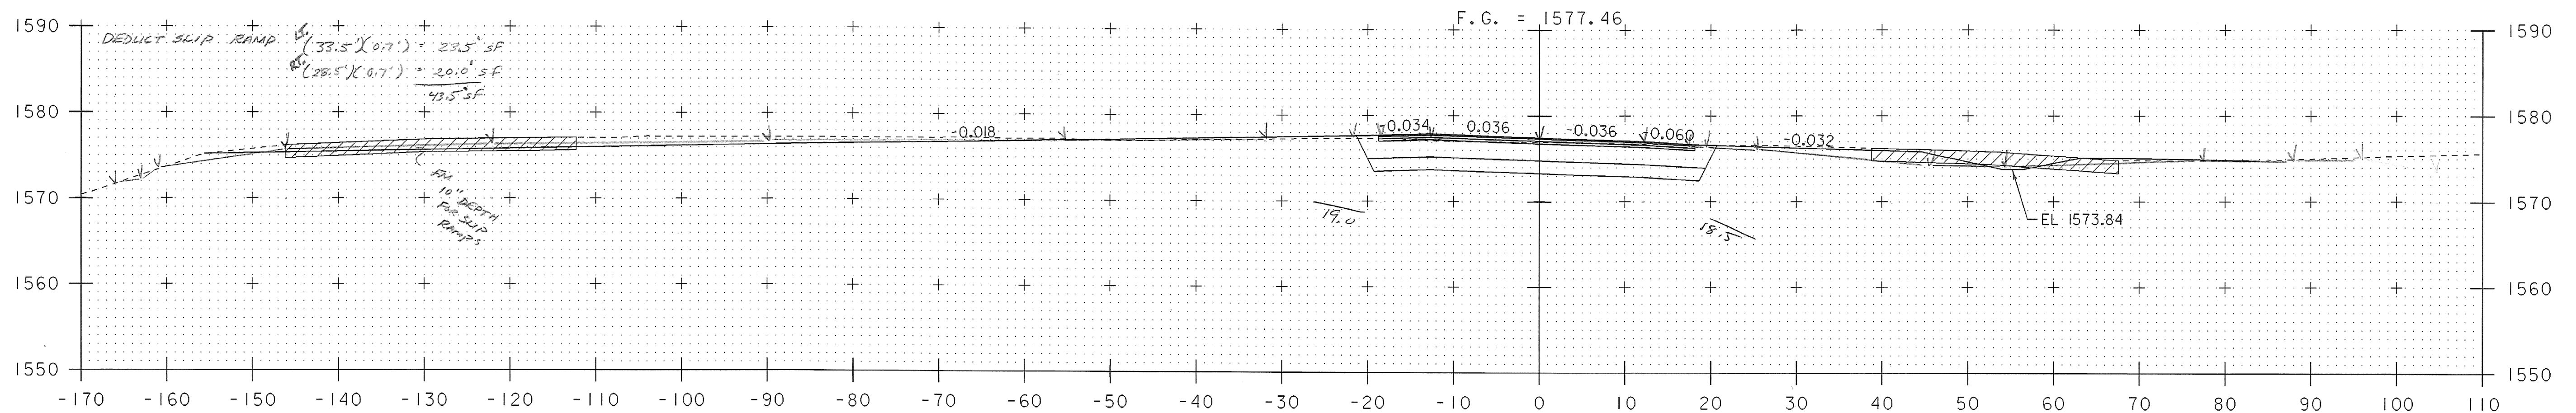


C=290  
F= 0

130+00

*2/24/09*

*J.M. H.H. 3/5/09*

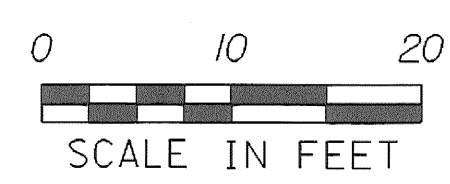

**VT RTE. 100  
CROSS SECTION  
SHEET 4**  
STA. 130+00 TO STA. 130+50

PROJECT NAME: WILMINGTON	PLOT DATE: 28-APR-2008
PROJECT NUMBER: HES 010-1(38)	DRAWN BY: CAK
FILE NAME: 05c324.dgn	CHECKED BY: DWE
PROJECT LEADER: DEG	SHEET 121 OF 125
DESIGNED BY: DWE	
VT. ROUTE 100 CROSS SECTIONS XS-4	