


218+00  
 STOP AC NH 2504 (1) S  
 BEGIN HES 010-1 (38)

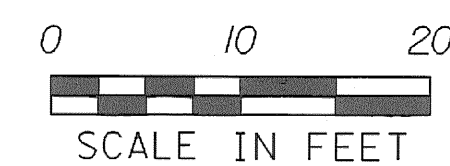

**VT RTE. 9  
 CROSS SECTION  
 SHEET 1**  
 STA. 218+00 TO STA. 219+50

PROJECT NAME: WILMINGTON	PLOT DATE: 28-APR-2008
PROJECT NUMBER: HES 010-1(38)	DRAWN BY: CAK
FILE NAME: 05c324.dgn	DESIGNED BY: DWE
DESIGNED BY: DWE	CHECKED BY: DWE
VT. ROUTE 9 CROSS SECTIONS XS-5	SHEET 122 OF 125