
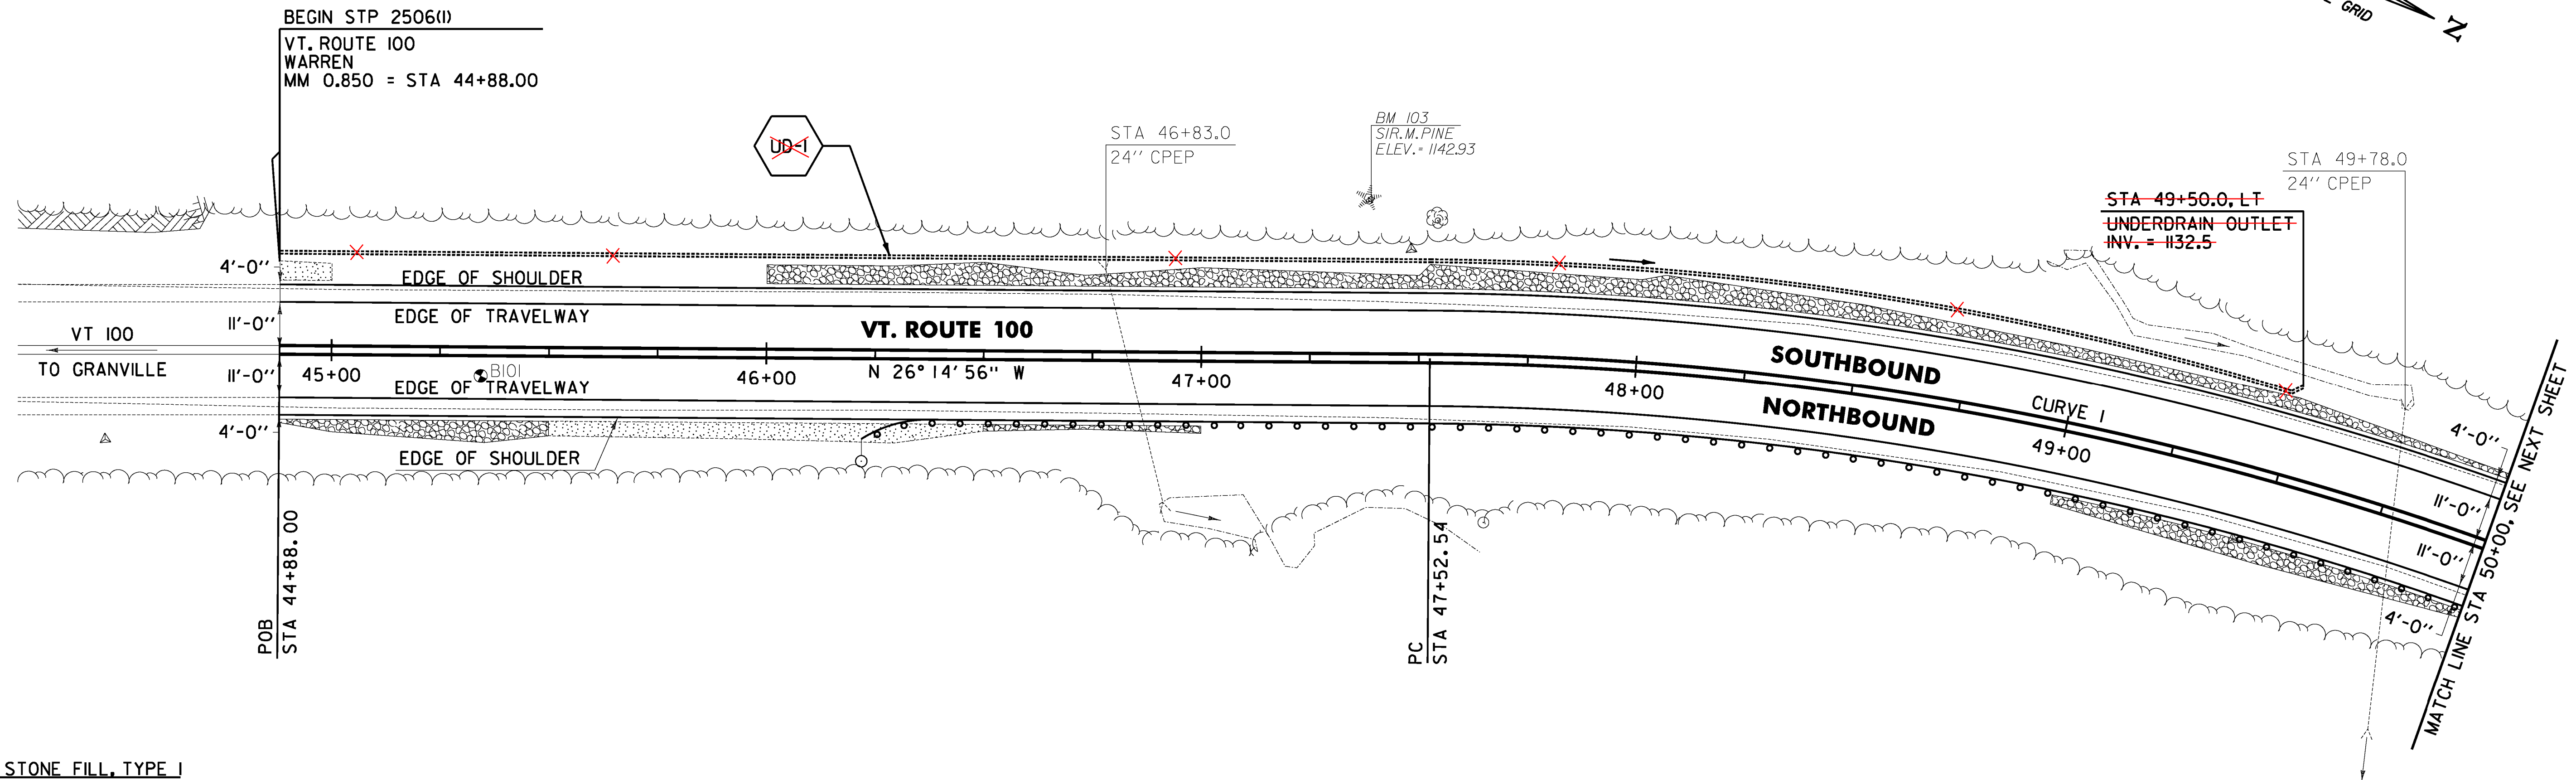


646.402 DURABLE 4 INCH WHITE LINE, THERMOPLASTIC OR
 646.403 DURABLE 4 INCH WHITE LINE, EPOXY PAINT OR
 646.404 DURABLE 4 INCH WHITE LINE, POLYUREA
 (ALL LINES WILL INCLUDE EDGE LINE BREAKS AND
 RADII FOR TOWN HIGHWAYS)
 WARREN:
 STA 44+88.00 - STA 50+00.00 LT & RT

646.412 DURABLE 4 INCH YELLOW LINE, THERMOPLASTIC OR
 646.413 DURABLE 4 INCH YELLOW LINE, EPOXY PAINT OR
 646.414 DURABLE 4 INCH YELLOW LINE, POLYUREA
 (ALL LINES WILL INCLUDE C/L BREAKS FOR
 TOWN HIGHWAYS) S=SOLID, D=DASHED
 WARREN:
 STA 44+88.00 - STA 50+00.00 LT C RT
 S - S

646.602 TEMPORARY 4 INCH WHITE LINE, PAINT
 (ALL LINES WILL INCLUDE EDGE LINE BREAKS AND
 RADII FOR TOWN HIGHWAYS)
 WARREN:
 STA 44+88.00 - STA 50+00.00 LT & RT

646.612 TEMPORARY 4 INCH YELLOW LINE, PAINT
 (ALL LINES WILL INCLUDE C/L BREAKS FOR
 TOWN HIGHWAYS) S=SOLID, D=DASHED
 WARREN:
 STA 44+88.00 - STA 50+00.00 LT C RT
 S - S

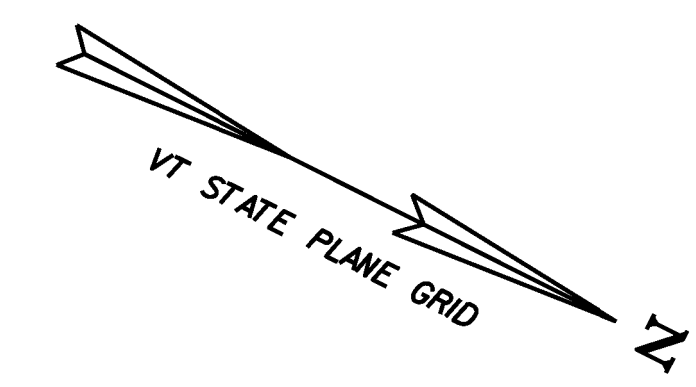

613.10 STONE FILL, TYPE I
 WARREN:
 STA 44+88.0 - STA 45+50.0 RT (4.1 CY)
 STA 46+00.0 - STA 50+00.0 LT (73.2 CY)
 STA 46+50.0 - STA 47+00.0 RT (1.9 CY)
 STA 49+00.0 - STA 50+00.0 RT (14.5 CY)

621.80 REMOVAL AND DISPOSAL OF GUARDRAIL
 WARREN:
 STA 46+93.0 - STA 50+00.0 RT (307.0 LF)

649.31 GEOTEXTILE UNDER STONE FILL
 WARREN:
 STA 44+88.0 - STA 45+50.0 RT (36.7 SY)
 STA 46+00.0 - STA 50+00.0 LT (302.9 SY)
 STA 46+50.0 - STA 47+00.0 RT (21.1 SY)
 STA 49+00.0 - STA 50+00.0 RT (64.3 SY)

651.40 GRUBBING MATERIAL
 WARREN:
 STA 44+88.0 - STA 45+00.0 LT (6.4 SY)
 STA 44+88.0 - STA 45+50.0 RT (22.9 SY)
 STA 45+50.0 - STA 46+50.0 RT (39.6 SY)
 STA 46+00.0 - STA 50+00.0 LT (214.0 SY)
 STA 46+50.0 - STA 47+00.0 RT (10.0 SY)
 STA 49+00.0 - STA 50+00.0 RT (42.1 SY)

653.20 TEMPORARY EROSION MATTING
 WARREN:
 STA 44+88.0 - STA 45+00.0 LT (6.4 SY)
 STA 44+88.0 - STA 45+50.0 RT (22.9 SY)
 STA 45+50.0 - STA 46+50.0 RT (39.6 SY)
 STA 46+00.0 - STA 50+00.0 LT (214.0 SY)
 STA 46+50.0 - STA 47+00.0 RT (10.0 SY)
 STA 49+00.0 - STA 50+00.0 RT (42.1 SY)


676.10 DELINEATOR WITH STEEL POST
 WARREN:
 STA 46+22.0 RT

900.640 SPECIAL PROVISION (BOX BEAM GUARDRAIL W/7 FEET POSTS)
 WARREN:
 STA 46+22.0 - STA 50+00.0 RT (378.0 LF)

SOIL BORING DATA			
BORING #	DEPTH (FT.)	PCC	COMMENTS
BIO1	5.0	NO	

CURVE 1
 $\Delta = 47^\circ 59' 25''$
 $D = 7^\circ 44' 34''$
 $R = 740.00'$
 $T = 329.39'$
 $L = 619.82'$
 $E = 70.00'$
 $e = 0.080 \text{ FT/FT}$

SIGN LEGEND
 R = REMOVE
 S = SALVAGE
 N = NEW
 RET = RETAIN
 B-B = BACK TO BACK
 EXISTING = _____
 NEW = _____
 ⊙ = RETURN TO THE TOWN OF WARREN

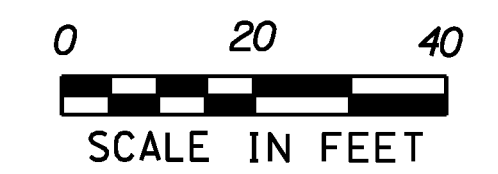

PROJECT LAYOUT SHEET #1

PROJECT NAME: WARREN - WAITSFIELD
 PROJECT NUMBER: STP 2506(1)
 FILE NAME: p05b048.dgn
 PROJECT LEADER: D.E.G.
 DESIGNED BY: M.J.M.
 IPARM FILE: p05b048(1).l

PLOT DATE: 12/20/2012
 DRAWN BY: W.G.P.
 CHECKED BY: D.E.G.
 SHEET 27 OF 310

NOTE:
 1. APPROXIMATE WETLAND LOCATION FROM STA 46+00 TO STA 49+00 RT.

LEGEND
 ITEM 613.10 STONE FILL, TYPE I
 ITEM 653.20 TEMPORARY EROSION MATTING

FILE NAME = I:\17762\CADD\MSTN\STP_2506\p05b048_Contract_Plan.dgn
 DATE/TIME = 12/20/2012
 USER = 4866