

646.402 DURABLE 4 INCH WHITE LINE, THERMOPLASTIC OR
 646.403 DURABLE 4 INCH WHITE LINE, EPOXY PAINT OR
 646.404 DURABLE 4 INCH WHITE LINE, POLYUREA
 (ALL LINES WILL INCLUDE EDGE LINE BREAKS AND
 RADII FOR TOWN HIGHWAYS)
 WARREN:
 STA 83+00.00 - STA 88+50.00 LT & RT



646.412 DURABLE 4 INCH YELLOW LINE, THERMOPLASTIC OR
 646.413 DURABLE 4 INCH YELLOW LINE, EPOXY PAINT OR
 646.414 DURABLE 4 INCH YELLOW LINE, POLYUREA
 (ALL LINES WILL INCLUDE C/L BREAKS FOR
 TOWN HIGHWAYS) S=SOLID, D=DASHED
 WARREN:
 STA 83+00.00 - STA 88+50.00 LT C RT
 S - S

646.602 TEMPORARY 4 INCH WHITE LINE, PAINT
 (ALL LINES WILL INCLUDE EDGE LINE BREAKS AND
 RADII FOR TOWN HIGHWAYS)
 WARREN:
 STA 83+00.00 - STA 88+50.00 LT & RT

646.612 TEMPORARY 4 INCH YELLOW LINE, PAINT
 (ALL LINES WILL INCLUDE C/L BREAKS FOR
 TOWN HIGHWAYS) S=SOLID, D=DASHED
 WARREN:
 STA 83+00.00 - STA 88+50.00 LT C RT
 S - S

675.50 REMOVING SIGNS
 AS SHOWN - I

675.60 ERECTING SALVAGED SIGNS
 AS SHOWN - I

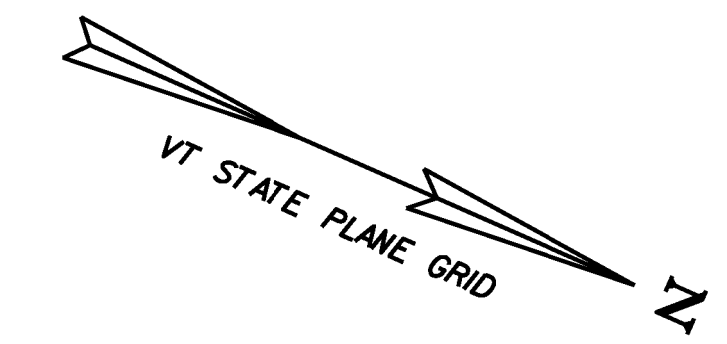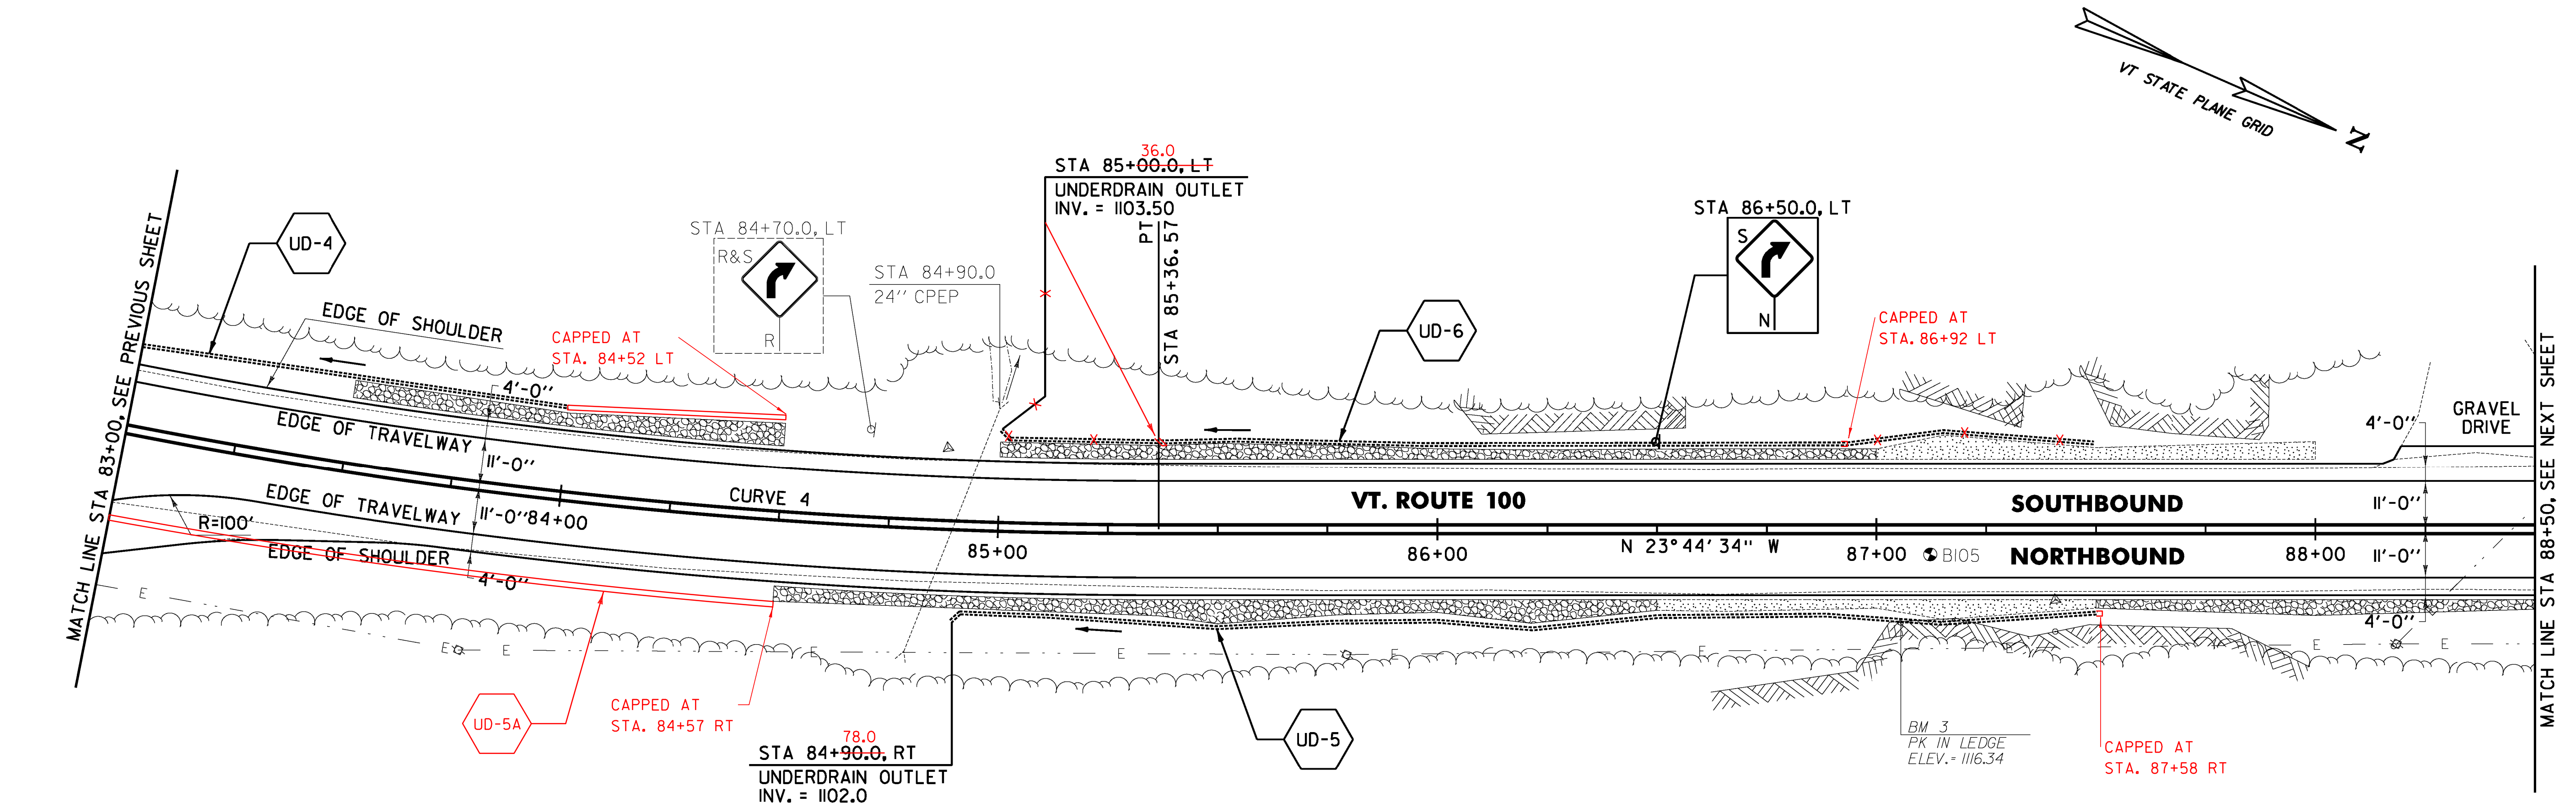

613.10 STONE FILL, TYPE I
 WARREN:
 STA 83+50.0 - STA 84+50.0 LT (6.5 CY)
 STA 84+50.0 - STA 86+50.0 RT (13.3 CY)
 STA 85+00.0 - STA 87+00.0 LT (27.6 CY)
 STA 87+50.0 - STA 88+50.0 RT (5.1 CY)

651.40 GRUBBING MATERIAL
 WARREN:
 STA 83+50.0 - STA 84+50.0 LT (45.8 SY)
 STA 84+50.0 - STA 86+50.0 RT (90.1 SY)
 STA 85+00.0 - STA 87+00.0 LT (80.1 SY)
 STA 86+50.0 - STA 87+50.0 RT (27.2 SY)
 STA 87+00.0 - STA 88+00.0 LT (38.6 SY)
 STA 87+50.0 - STA 88+50.0 RT (36.9 SY)

653.20 TEMPORARY EROSION MATTING
 WARREN:
 STA 83+50.0 - STA 84+50.0 LT (45.8 SY)
 STA 84+50.0 - STA 86+50.0 RT (90.1 SY)
 STA 85+00.0 - STA 87+00.0 LT (80.1 SY)
 STA 86+50.0 - STA 87+50.0 RT (27.2 SY)
 STA 87+00.0 - STA 88+00.0 LT (38.6 SY)
 STA 87+50.0 - STA 88+50.0 RT (36.9 SY)

649.31 GEOTEXTILE UNDER STONE FILL
 WARREN:
 STA 83+50.0 - STA 84+50.0 LT (68.1 SY)
 STA 84+50.0 - STA 86+50.0 RT (134.5 SY)
 STA 85+00.0 - STA 87+00.0 LT (124.5 SY)
 STA 87+50.0 - STA 88+50.0 RT (59.1 SY)

SOIL BORING DATA			
BORING #	DEPTH (FT.)	PCC	COMMENTS
BI05	4.3	NO	REFUSAL AT 4.3 FT

- LEGEND**
- ITEM 613.10 STONE FILL, TYPE I
 - ITEM 653.20 TEMPORARY EROSION MATTING



SIGN LEGEND

R = REMOVE
 S = SALVAGE
 N = NEW
 RET = RETAIN
 B-B = BACK TO BACK
 EXISTING = _____
 NEW = _____
 ⊙ = RETURN TO THE TOWN OF WARREN

CURVE 4
 $\Delta = 28^\circ 12' 22''$
 $D = 4^\circ 41' 47''$
 $R = 1220.00'$
 $T = 306.51'$
 $L = 600.59'$
 $E = 37.91'$
 $e = 0.055 \text{ FT/FT}$

PROJECT LAYOUT SHEET #8	PROJECT NAME: WARREN - WAITSFIELD	PLOT DATE: 12/20/2012
	PROJECT NUMBER: STP 2506(1)	DRAWN BY: W.G.P.
	FILE NAME: p05b048.dgn	CHECKED BY: D.E.G.
	PROJECT LEADER: D.E.G.	SHEET 34 OF 310
	DESIGNED BY: M.J.M.	
	IPARM FILE: p05b048I08.1	

FILE NAME = U:\17762\CADD\MSTN\STP_2506\p05b048_Contract_Plan.dgn
 DATE/TIME = 12/20/2012
 USER = 4066