



646.402 DURABLE 4 INCH WHITE LINE, THERMOPLASTIC OR
 646.403 DURABLE 4 INCH WHITE LINE, EPOXY PAINT OR
 646.404 DURABLE 4 INCH WHITE LINE, POLYUREA
 (ALL LINES WILL INCLUDE EDGE LINE BREAKS AND
 RADII FOR TOWN HIGHWAYS)
 WARREN:
 STA 105+00.00 - STA 110+50.00 LT & RT

646.412 DURABLE 4 INCH YELLOW LINE, THERMOPLASTIC OR
 646.413 DURABLE 4 INCH YELLOW LINE, EPOXY PAINT OR
 646.414 DURABLE 4 INCH YELLOW LINE, POLYUREA
 (ALL LINES WILL INCLUDE C/L BREAKS FOR
 TOWN HIGHWAYS) S=SOLID, D=DASHED
 WARREN:
 STA 105+00.00 - STA 110+50.00 LT C RT
 S - S

646.602 TEMPORARY 4 INCH WHITE LINE, PAINT
 (ALL LINES WILL INCLUDE EDGE LINE BREAKS AND
 RADII FOR TOWN HIGHWAYS)
 WARREN:
 STA 105+00.00 - STA 110+50.00 LT & RT

646.612 TEMPORARY 4 INCH YELLOW LINE, PAINT
 (ALL LINES WILL INCLUDE C/L BREAKS FOR
 TOWN HIGHWAYS) S=SOLID, D=DASHED
 WARREN:
 STA 105+00.00 - STA 110+50.00 LT C RT
 S - S

675.50 REMOVING SIGNS
 AS SHOWN - I

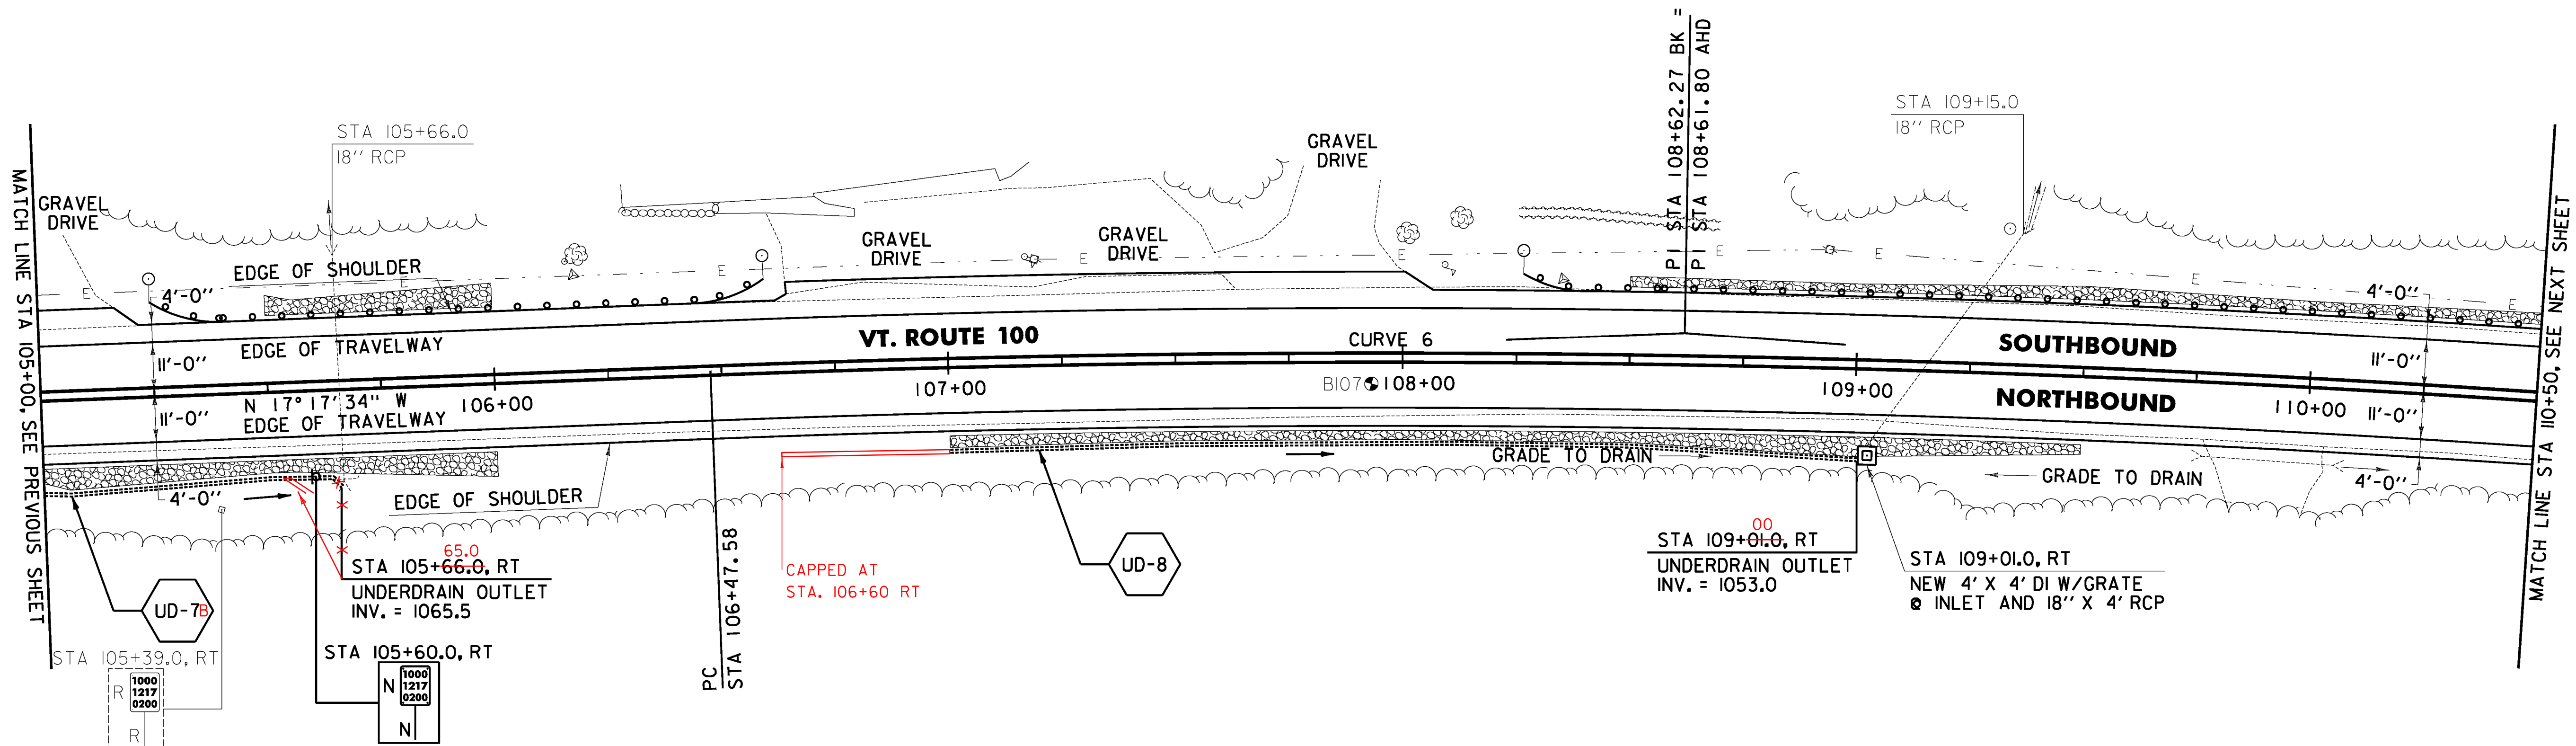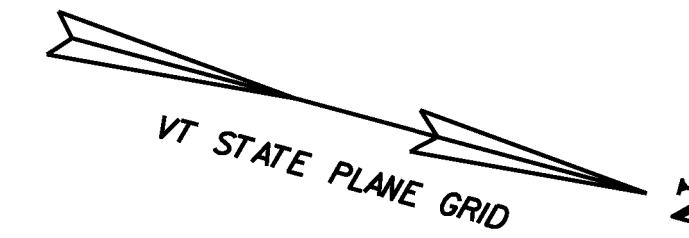

613.10 STONE FILL, TYPE I

WARREN:
 STA 105+00.0 - STA 106+00.0 RT (17.8 CY)
 STA 105+50.0 - STA 106+00.0 LT (11.0 CY)
 STA 107+00.0 - STA 109+50.0 RT (34.9 CY)
 STA 108+50.0 - STA 110+50.0 LT (8.8 CY)

621.80 REMOVAL AND DISPOSAL OF GUARDRAIL

WARREN:
 STA 108+41.0 - STA 110+50.0 LT (209.0 LF)

651.40 GRUBBING MATERIAL

WARREN:
 STA 105+00.0 - STA 106+00.0 RT (51.9 SY)
 STA 105+50.0 - STA 106+00.0 LT (32.1 SY)
 STA 107+00.0 - STA 109+50.0 RT (101.3 SY)
 STA 108+50.0 - STA 110+50.0 LT (57.7 SY)

653.20 TEMPORARY EROSION MATTING

WARREN:
 STA 105+00.0 - STA 106+00.0 RT (51.9 SY)
 STA 105+50.0 - STA 106+00.0 LT (32.1 SY)
 STA 107+00.0 - STA 109+50.0 RT (101.3 SY)
 STA 108+50.0 - STA 110+50.0 LT (57.7 SY)

676.10 DELINEATOR WITH STEEL POST

WARREN:
 STA 105+24.0 LT
 STA 106+60.0 LT
 STA 108+26.5 LT

649.31 GEOTEXTILE UNDER STONE FILL

WARREN:
 STA 105+00.0 - STA 106+00.0 RT (74.1 SY)
 STA 105+50.0 - STA 106+00.0 LT (43.2 SY)
 STA 107+00.0 - STA 109+50.0 RT (156.9 SY)
 STA 108+50.0 - STA 110+50.0 LT (102.1 SY)

900.640 SPECIAL PROVISION (BOX BEAM GUARDRAIL W/7 FEET POSTS)

WARREN:
 STA 105+24.0 - STA 106+60.0 LT (136.0 LF)
 STA 108+26.5 - STA 110+50.0 LT (223.5 LF)

SOIL BORING DATA			
BORING #	DEPTH (FT.)	PCC	COMMENTS
BI07	5.0	NO	LOOSE PAVEMENT 0.4 - 0.8 FT.

CURVE 6
 $\Delta = 6^{\circ}28'02''$
 $D = 1^{\circ}30'28''$
 $R = 3800.00'$
 $T = 214.69'$
 $L = 428.92'$
 $E = 6.06'$
 $e = 0.031 \text{ FT/FT}$

SIGN LEGEND
 R = REMOVE
 S = SALVAGE
 N = NEW
 RET = RETAIN
 B-B = BACK TO BACK
 EXISTING = _____
 NEW = _____
 ⊙ = RETURN TO THE TOWN OF WARREN



LEGEND

- ITEM 613.10 STONE FILL, TYPE I
- ITEM 653.20 TEMPORARY EROSION MATTING

PROJECT LAYOUT SHEET #12	PROJECT NAME: WARREN - WAITSFIELD	PLOT DATE: 12/20/2012
	PROJECT NUMBER: STP 2506(1)	DRAWN BY: W.G.P.
	FILE NAME: p05b048.dgn	CHECKED BY: D.E.G.
	DESIGNED BY: M.J.M.	SHEET 38 OF 310
	IPARM FILE: p05b048(12).i	

FILE NAME = I:\17762\CADD\MSTN\STP 2506\p05b048.Centrect Plans.dgn
 DATE/TIME = 12/20/2012
 USER = 4866