

646.402 DURABLE 4 INCH WHITE LINE, THERMOPLASTIC OR  
 646.403 DURABLE 4 INCH WHITE LINE, EPOXY PAINT OR  
 646.404 DURABLE 4 INCH WHITE LINE, POLYUREA  
 (ALL LINES WILL INCLUDE EDGE LINE BREAKS AND  
 RADII FOR TOWN HIGHWAYS)  
 WARREN:  
 STA 110+50.00 - STA 116+00.00 LT & RT



646.412 DURABLE 4 INCH YELLOW LINE, THERMOPLASTIC OR  
 646.413 DURABLE 4 INCH YELLOW LINE, EPOXY PAINT OR  
 646.414 DURABLE 4 INCH YELLOW LINE, POLYUREA  
 (ALL LINES WILL INCLUDE C/L BREAKS FOR  
 TOWN HIGHWAYS) S=SOLID, D=DASHED  
 WARREN:  
 STA 110+50.00 - STA 116+00.00

LT C RT  
 S - S

646.602 TEMPORARY 4 INCH WHITE LINE, PAINT  
 (ALL LINES WILL INCLUDE EDGE LINE BREAKS AND  
 RADII FOR TOWN HIGHWAYS)  
 WARREN:  
 STA 110+50.00 - STA 116+00.00 LT & RT

646.612 TEMPORARY 4 INCH YELLOW LINE, PAINT  
 (ALL LINES WILL INCLUDE C/L BREAKS FOR  
 TOWN HIGHWAYS) S=SOLID, D=DASHED  
 WARREN:  
 STA 110+50.00 - STA 116+00.00

LT C RT  
 S - S

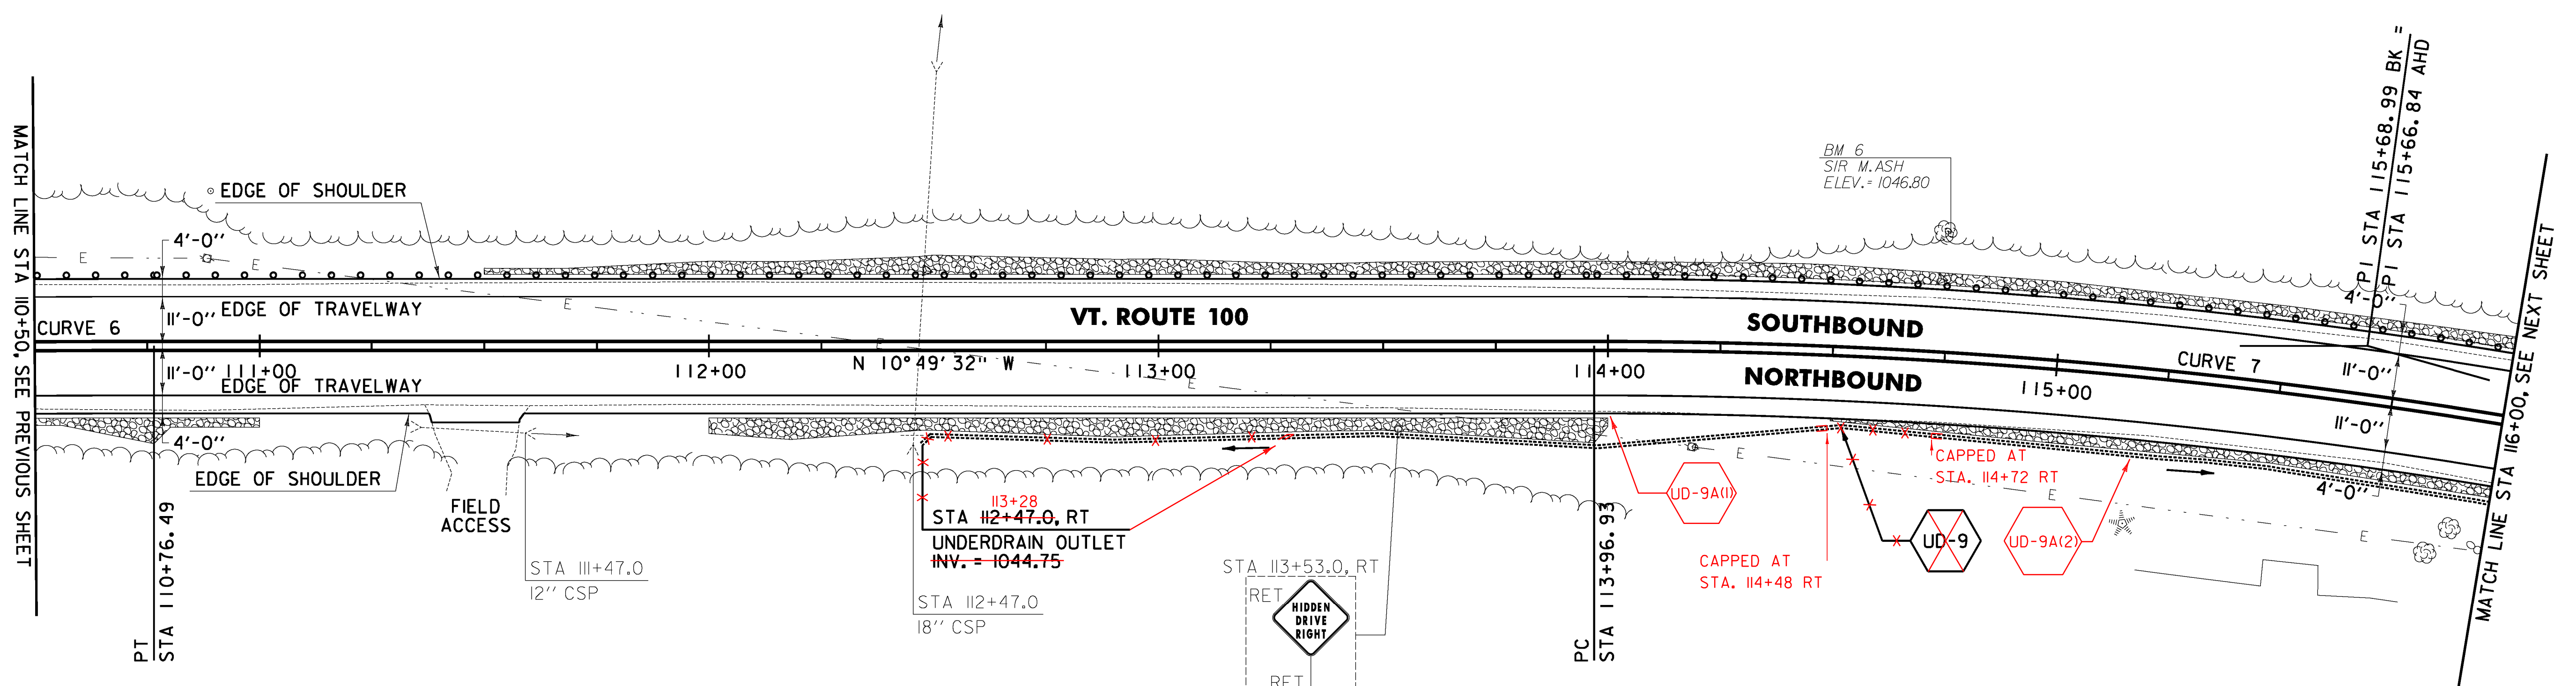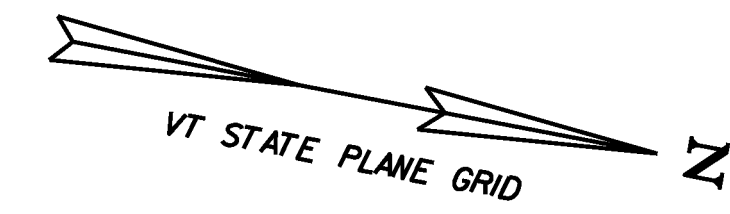

**613.10 STONE FILL, TYPE I**

WARREN:  
 STA 110+50.0 - STA 113+00.0 RT (5.0 CY)  
 STA 113+50.0 - STA 116+00.0 LT (67.0 CY)  
 STA 112+00.0 - STA 114+00.0 RT (31.3 CY)  
 STA 114+50.0 - STA 116+00.0 RT (5.3 CY)

**649.31 GEOTEXTILE UNDER STONE FILL**

WARREN:  
 STA 110+50.0 - STA 113+00.0 RT (25.4 SY)  
 STA 113+50.0 - STA 116+00.0 LT (294.9 SY)  
 STA 112+00.0 - STA 114+00.0 RT (135.4 SY)  
 STA 114+50.0 - STA 116+00.0 RT (54.7 SY)

**621.80 REMOVAL AND DISPOSAL OF GUARDRAIL**

WARREN:  
 STA 110+50.0 - STA 116+00.0 LT (550.0 LF)

**900.640 SPECIAL PROVISION (BOX BEAM GUARDRAIL W/7 FEET POSTS)**

WARREN:  
 STA 110+50.0 - STA 116+00.0 LT (550.0 LF)

**651.40 GRUBBING MATERIAL**

WARREN:  
 STA 110+50.0 - STA 113+00.0 RT (14.3 SY)  
 STA 113+50.0 - STA 116+00.0 LT (194.9 SY)  
 STA 112+00.0 - STA 114+00.0 RT (90.9 SY)  
 STA 114+50.0 - STA 116+00.0 RT (21.4 SY)

**653.20 TEMPORARY EROSION MATTING**

WARREN:  
 STA 110+50.0 - STA 113+00.0 RT (14.3 SY)  
 STA 113+50.0 - STA 116+00.0 LT (194.9 SY)  
 STA 112+00.0 - STA 114+00.0 RT (90.9 SY)  
 STA 114+50.0 - STA 116+00.0 RT (21.4 SY)

**CURVE 6**

Δ = 6° 28' 02"  
 D = 1° 30' 28"  
 R = 3800.00'  
 T = 214.69'  
 L = 428.92'  
 E = 6.06'  
 e = 0.031 FT/FT

**CURVE 7**

Δ = 15° 40' 28"  
 D = 4° 35' 01"  
 R = 1250.00'  
 T = 172.06'  
 L = 341.96'  
 E = 11.79'  
 e = 0.069 FT/FT

**SIGN LEGEND**

R = REMOVE  
 S = SALVAGE  
 N = NEW  
 RET = RETAIN  
 B-B = BACK TO BACK  
 EXISTING = \_\_\_\_\_  
 NEW = \_\_\_\_\_  
 ⊙ = RETURN TO THE TOWN OF WARREN

**LEGEND**

ITEM 613.10 STONE FILL, TYPE I  
 ITEM 653.20 TEMPORARY EROSION MATTING



**PROJECT LAYOUT SHEET #13**

PROJECT NAME: WARREN - WAITSFIELD	PLOT DATE: 12/20/2012
PROJECT NUMBER: STP 2506(1)	DRAWN BY: W.G.P.
FILE NAME: p05b048.dgn	CHECKED BY: D.E.G.
PROJECT LEADER: D.E.G.	SHEET 39 OF 310
DESIGNED BY: M.J.M.	
IPARM FILE: p05b048(1).i	

FILE NAME = I:\17762\CADD\MSTN\STP 2506\p05b048\_Contract\_Plan.dgn  
 DATE/TIME = 12/20/2012  
 USER = 4866