
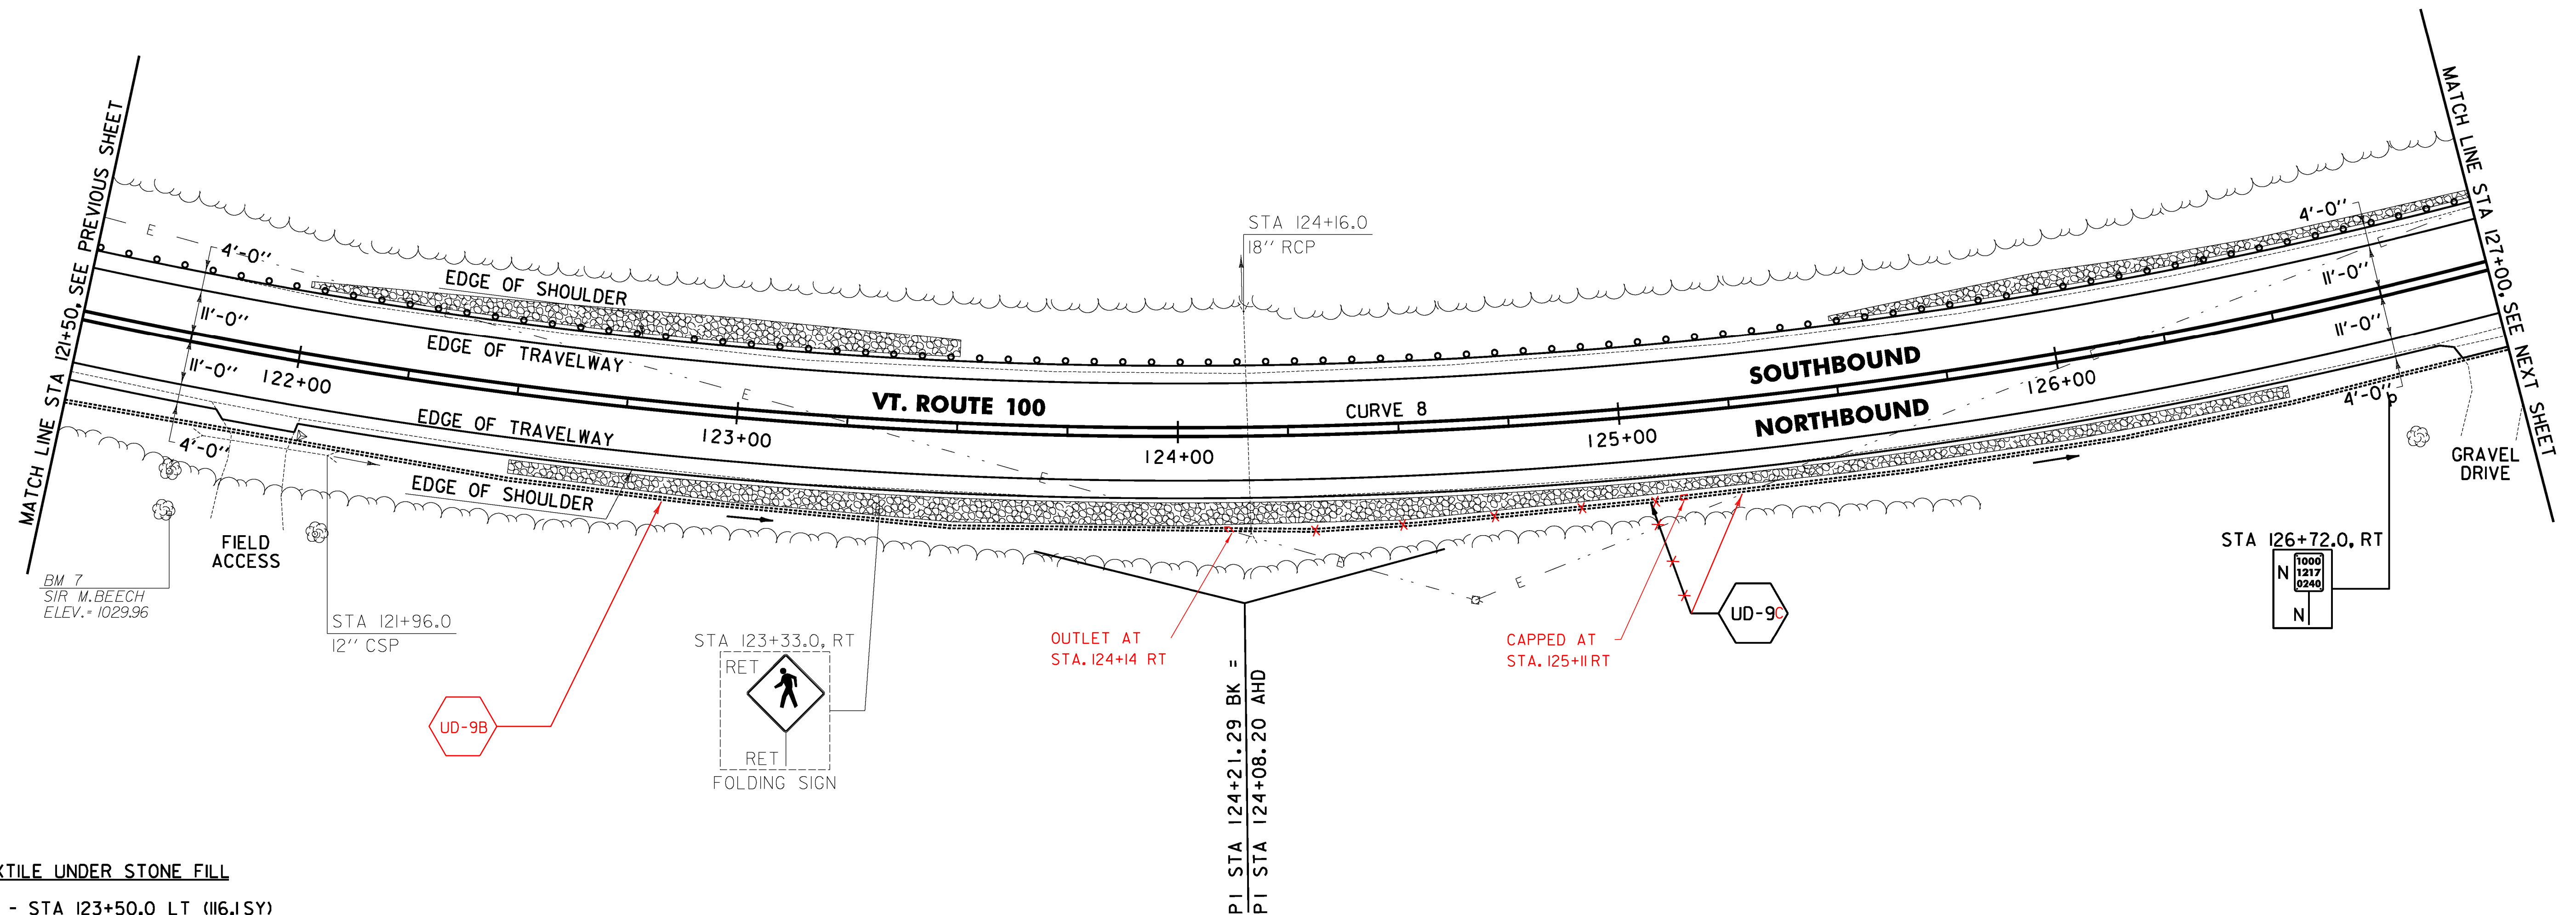


646.402 DURABLE 4 INCH WHITE LINE, THERMOPLASTIC OR  
 646.403 DURABLE 4 INCH WHITE LINE, EPOXY PAINT OR  
 646.404 DURABLE 4 INCH WHITE LINE, POLYUREA  
 (ALL LINES WILL INCLUDE EDGE LINE BREAKS AND  
 RADII FOR TOWN HIGHWAYS)  
 WARREN:  
 STA 121+50.00 - STA 127+00.00 LT & RT

646.412 DURABLE 4 INCH YELLOW LINE, THERMOPLASTIC OR  
 646.413 DURABLE 4 INCH YELLOW LINE, EPOXY PAINT OR  
 646.414 DURABLE 4 INCH YELLOW LINE, POLYUREA  
 (ALL LINES WILL INCLUDE C/L BREAKS FOR  
 TOWN HIGHWAYS) S=SOLID, D=DASHED  
 WARREN:  
 STA 121+50.00 - STA 127+00.00

646.602 TEMPORARY 4 INCH WHITE LINE, PAINT  
 (ALL LINES WILL INCLUDE EDGE LINE BREAKS AND  
 RADII FOR TOWN HIGHWAYS)  
 WARREN:  
 STA 121+50.00 - STA 127+00.00 LT & RT

646.612 TEMPORARY 4 INCH YELLOW LINE, PAINT  
 (ALL LINES WILL INCLUDE C/L BREAKS FOR  
 TOWN HIGHWAYS) S=SOLID, D=DASHED  
 WARREN:  
 STA 121+50.00 - STA 127+00.00

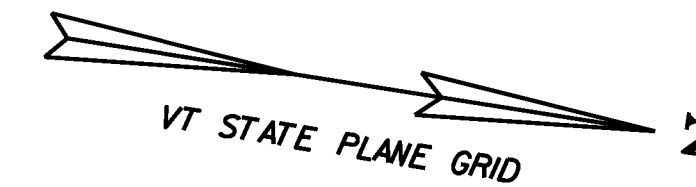

649.31 GEOTEXTILE UNDER STONE FILL  
 WARREN:  
 STA 122+00.0 - STA 123+50.0 LT (116.1 SY)  
 STA 122+50.0 - STA 126+50.0 RT (303.3 SY)  
 STA 125+50.0 - STA 127+00.0 LT (84.1 SY)

613.10 STONE FILL, TYPE I  
 WARREN:  
 STA 122+00.0 - STA 123+50.0 LT (28.3 CY)  
 STA 122+50.0 - STA 126+50.0 RT (73.4 CY)  
 STA 125+50.0 - STA 127+00.0 LT (17.6 CY)

651.40 GRUBBING MATERIAL  
 WARREN:  
 STA 122+00.0 - STA 123+50.0 LT (82.8 SY)  
 STA 122+50.0 - STA 126+50.0 RT (214.4 SY)  
 STA 125+50.0 - STA 127+00.0 LT (50.7 SY)

653.20 TEMPORARY EROSION MATTING  
 WARREN:  
 STA 122+00.0 - STA 123+50.0 LT (82.8 SY)  
 STA 122+50.0 - STA 126+50.0 RT (214.4 SY)  
 STA 125+50.0 - STA 127+00.0 LT (50.7 SY)

900.640 SPECIAL PROVISION (BOX BEAM GUARDRAIL W/7 FEET POSTS)  
 WARREN:  
 STA 121+50.0 - STA 127+00.0 LT (550. LF)

STA 124+16.0  
 18" RCP

BM 7  
 SIR M. BEECH  
 ELEV. = 1029.96

STA 121+96.0  
 12" CSP

STA 123+33.0, RT


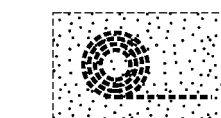
OUTLET AT  
 STA. 124+14 RT

CAPPED AT  
 STA. 125+11 RT

STA 126+72.0, RT

PI STA 124+21.29 BK =  
 PI STA 124+08.20 AHD

LEGEND

-  ITEM 613.10 STONE FILL, TYPE I
-  ITEM 653.20 TEMPORARY EROSION MATTING



SIGN LEGEND

- R = REMOVE
- S = SALVAGE
- N = NEW
- RET = RETAIN
- B-B = BACK TO BACK
- EXISTING = \_\_\_\_\_
- NEW = \_\_\_\_\_
- ⊙ = RETURN TO THE TOWN OF WARREN

CURVE 8  
 $\Delta = 28^\circ 59' 59''$   
 $D = 4^\circ 51' 20''$   
 $R = 1180.00'$   
 $T = 305.17'$   
 $L = 597.25'$   
 $E = 38.82'$   
 $e = 0.071 \text{ FT/FT}$

PROJECT LAYOUT SHEET #15

PROJECT NAME: WARREN - WAITSFIELD

PROJECT NUMBER: STP 2506(1)

FILE NAME: p05b048.dgn

PROJECT LEADER: D.E.G.

DESIGNED BY: M.J.M.

IPARM FILE: p05b048(1).i

PLOT DATE: 12/20/2012

DRAWN BY: W.G.P.

CHECKED BY: D.E.G.

SHEET 41 OF 310