

646.402 DURABLE 4 INCH WHITE LINE, THERMOPLASTIC OR
 646.403 DURABLE 4 INCH WHITE LINE, EPOXY PAINT OR
 646.404 DURABLE 4 INCH WHITE LINE, POLYUREA
 (ALL LINES WILL INCLUDE EDGE LINE BREAKS AND
 RADII FOR TOWN HIGHWAYS)
 WARREN:
 STA 137+50.00 - STA 143+00.00 LT & RT



646.412 DURABLE 4 INCH YELLOW LINE, THERMOPLASTIC OR
 646.413 DURABLE 4 INCH YELLOW LINE, EPOXY PAINT OR
 646.414 DURABLE 4 INCH YELLOW LINE, POLYUREA
 (ALL LINES WILL INCLUDE C/L BREAKS FOR
 TOWN HIGHWAYS) S=SOLID, D=DASHED
 WARREN:
 STA 137+50.00 - STA 143+00.00 LT C RT
 S - S

646.602 TEMPORARY 4 INCH WHITE LINE, PAINT
 (ALL LINES WILL INCLUDE EDGE LINE BREAKS AND
 RADII FOR TOWN HIGHWAYS)

WARREN:
 STA 137+50.00 - STA 143+00.00 LT & RT

646.612 TEMPORARY 4 INCH YELLOW LINE, PAINT
 (ALL LINES WILL INCLUDE C/L BREAKS FOR
 TOWN HIGHWAYS) S=SOLID, D=DASHED

WARREN:
 STA 137+50.00 - STA 143+00.00 LT C RT
 S - S

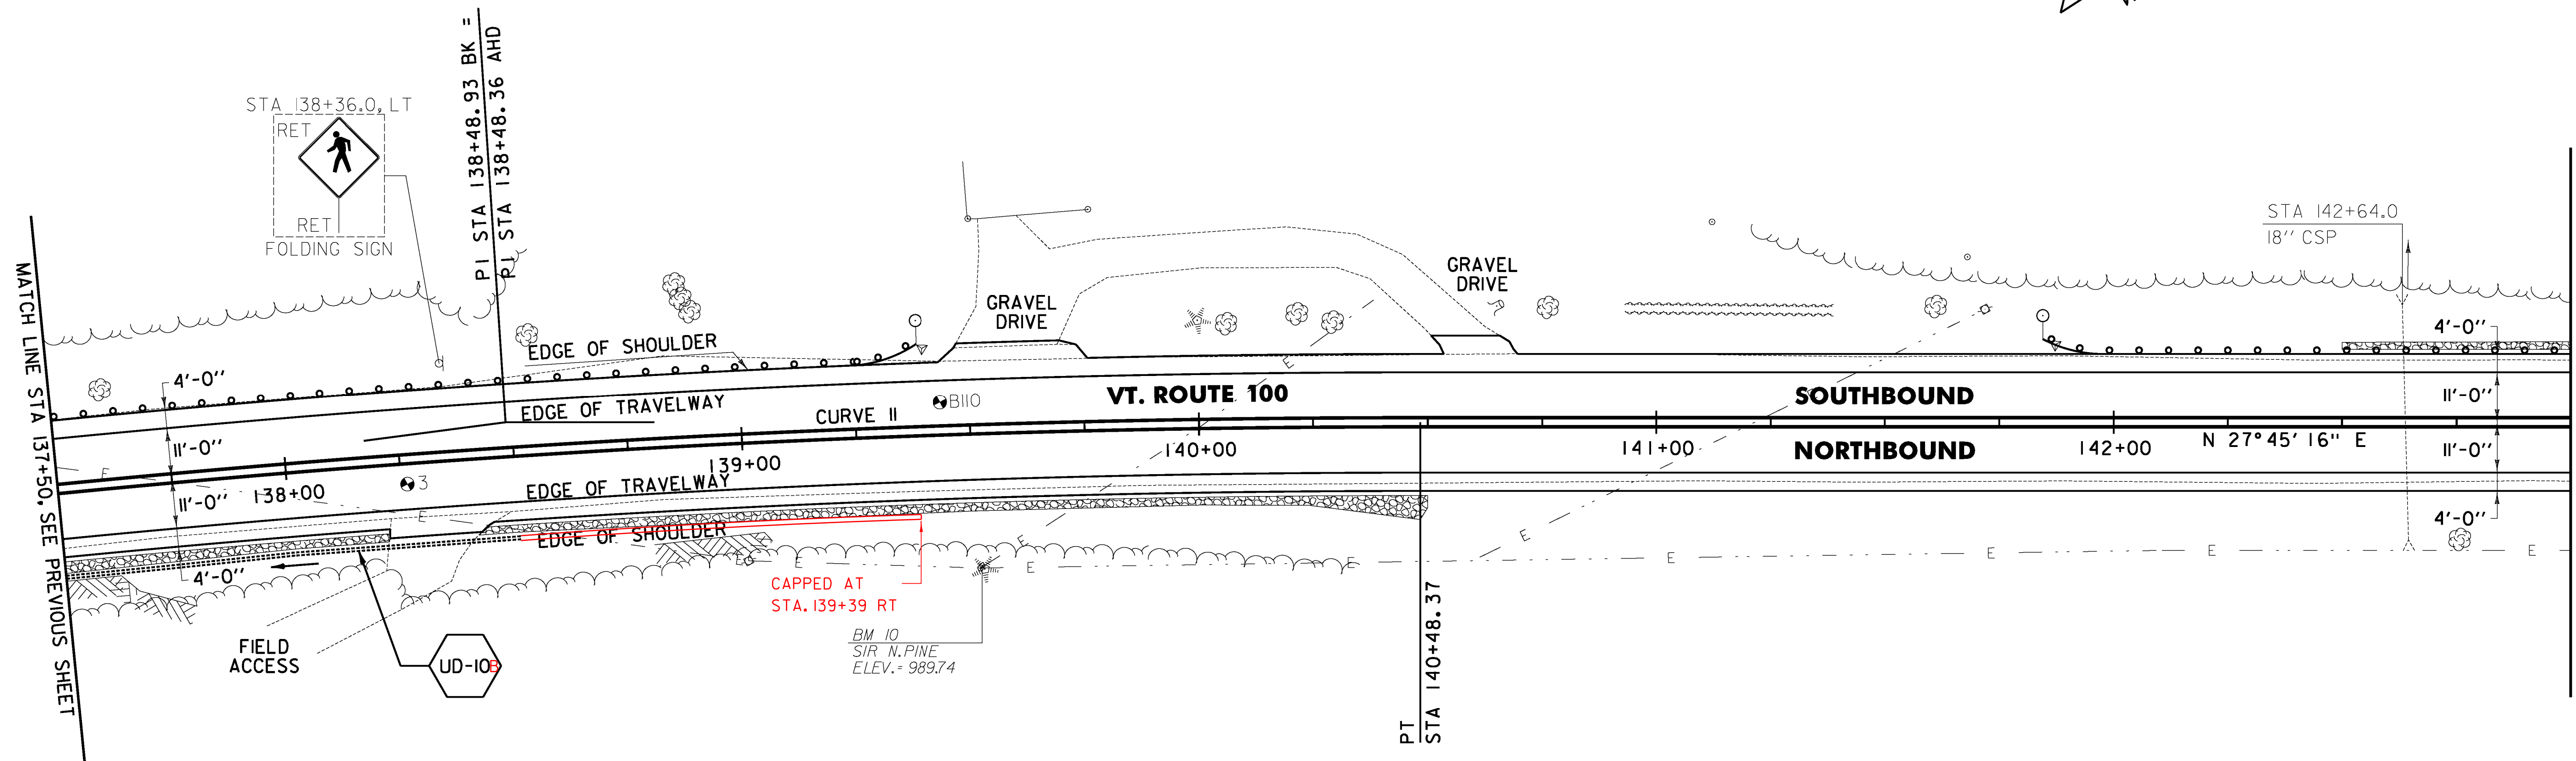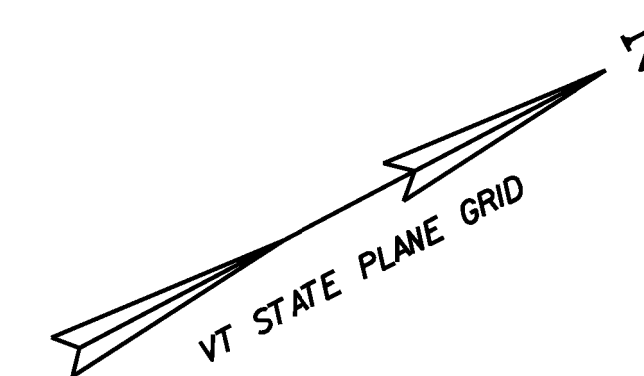

613.10 STONE FILL, TYPE I

WARREN:
 STA 137+50.0 - STA 138+22.0 RT (10.3 CY)
 STA 138+42.0 - STA 140+50.0 RT (20.3 CY)
 STA 142+50.0 - STA 143+00.0 LT (4.1 CY)

621.80 REMOVAL AND DISPOSAL OF GUARDRAIL

WARREN:
 STA 137+50.0 - STA 139+39.0 LT (189.0 LF)
 STA 141+93.0 - STA 143+00.0 LT (107.0 LF)

651.40 GRUBBING MATERIAL

WARREN:
 STA 137+50.0 - STA 138+22.0 RT (29.4 SY)
 STA 138+42.0 - STA 140+50.0 RT (58.1 SY)
 STA 142+50.0 - STA 143+00.0 LT (11.7 SY)

653.20 TEMPORARY EROSION MATTING

WARREN:
 STA 137+50.0 - STA 138+22.0 RT (29.4 SY)
 STA 138+42.0 - STA 140+50.0 RT (58.1 SY)
 STA 142+50.0 - STA 143+00.0 LT (11.7 SY)

676.10 DELINEATOR WITH STEEL POST

WARREN:
 STA 139+39.0 LT
 STA 141+84.5 LT

649.31 GEOTEXTILE UNDER STONE FILL

WARREN:
 STA 137+50.0 - STA 138+22.0 RT (51.6 SY)
 STA 138+42.0 - STA 140+50.0 RT (102.5 SY)
 STA 142+50.0 - STA 143+00.0 LT (22.8 SY)

900.640 SPECIAL PROVISION (BOX BEAM GUARDRAIL W/7 FEET POSTS)



WARREN:
 STA 137+50.0 - STA 139+39.0 LT (189.0 LF)
 STA 141+84.5 - STA 143+00.0 LT (115.5 LF)

CURVE II
 $\Delta = 7^{\circ}30'14''$
 $D = 1^{\circ}52'43''$
 $R = 3050.00'$
 $T = 200.01'$
 $L = 399.45'$
 $E = 6.55'$
 $e = 0.037 \text{ FT/FT}$

SOIL BORING DATA			
BORING #	DEPTH (FT.)	PCC	COMMENTS
B10	5.0	NO	


PAVEMENT CORING DATA			
CORE #	DEPTH (IN.)	PCC	COMMENTS
3	6.25	NO	

LEGEND

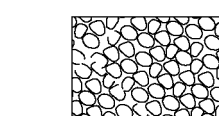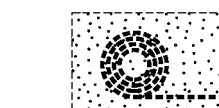-  ITEM 613.10 STONE FILL, TYPE I
-  ITEM 653.20 TEMPORARY EROSION MATTING

SIGN LEGEND

- R = REMOVE
- S = SALVAGE
- N = NEW
- RET = RETAIN
- B-B = BACK TO BACK
- EXISTING = _____
- NEW = _____
- ⊙ = RETURN TO THE TOWN OF WARREN

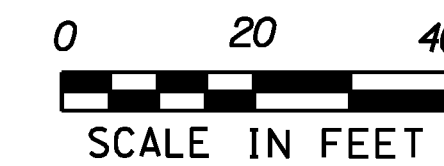

SCALE IN FEET

PROJECT LAYOUT SHEET #18

PROJECT NAME: WARREN - WAITSFIELD

PROJECT NUMBER: STP 2506(1)

FILE NAME: p05b048.dgn

PROJECT LEADER: D.E.G.

DESIGNED BY: M.J.M.

IPARM FILE: p05b048(1).i

PLOT DATE: 12/20/2012

DRAWN BY: W.G.P.

CHECKED BY: D.E.G.

SHEET 44 OF 310