



646.402 DURABLE 4 INCH WHITE LINE, THERMOPLASTIC OR
 646.403 DURABLE 4 INCH WHITE LINE, EPOXY PAINT OR
 646.404 DURABLE 4 INCH WHITE LINE, POLYUREA
 (ALL LINES WILL INCLUDE EDGE LINE BREAKS AND
 RADII FOR TOWN HIGHWAYS)
 WARREN:
 STA 154+00.00 - STA 159+50.00 LT & RT

646.412 DURABLE 4 INCH YELLOW LINE, THERMOPLASTIC OR
 646.413 DURABLE 4 INCH YELLOW LINE, EPOXY PAINT OR
 646.414 DURABLE 4 INCH YELLOW LINE, POLYUREA
 (ALL LINES WILL INCLUDE C/L BREAKS FOR
 TOWN HIGHWAYS) S=SOLID, D=DASHED
 WARREN:
 STA 154+00.00 - STA 159+50.00

646.602 TEMPORARY 4 INCH WHITE LINE, PAINT
 (ALL LINES WILL INCLUDE EDGE LINE BREAKS AND
 RADII FOR TOWN HIGHWAYS)
 WARREN:
 STA 154+00.00 - STA 159+50.00 LT & RT

646.612 TEMPORARY 4 INCH YELLOW LINE, PAINT
 (ALL LINES WILL INCLUDE C/L BREAKS FOR
 TOWN HIGHWAYS) S=SOLID, D=DASHED
 WARREN:
 STA 154+00.00 - STA 159+50.00

675.50 REMOVING SIGNS
 AS SHOWN - 1

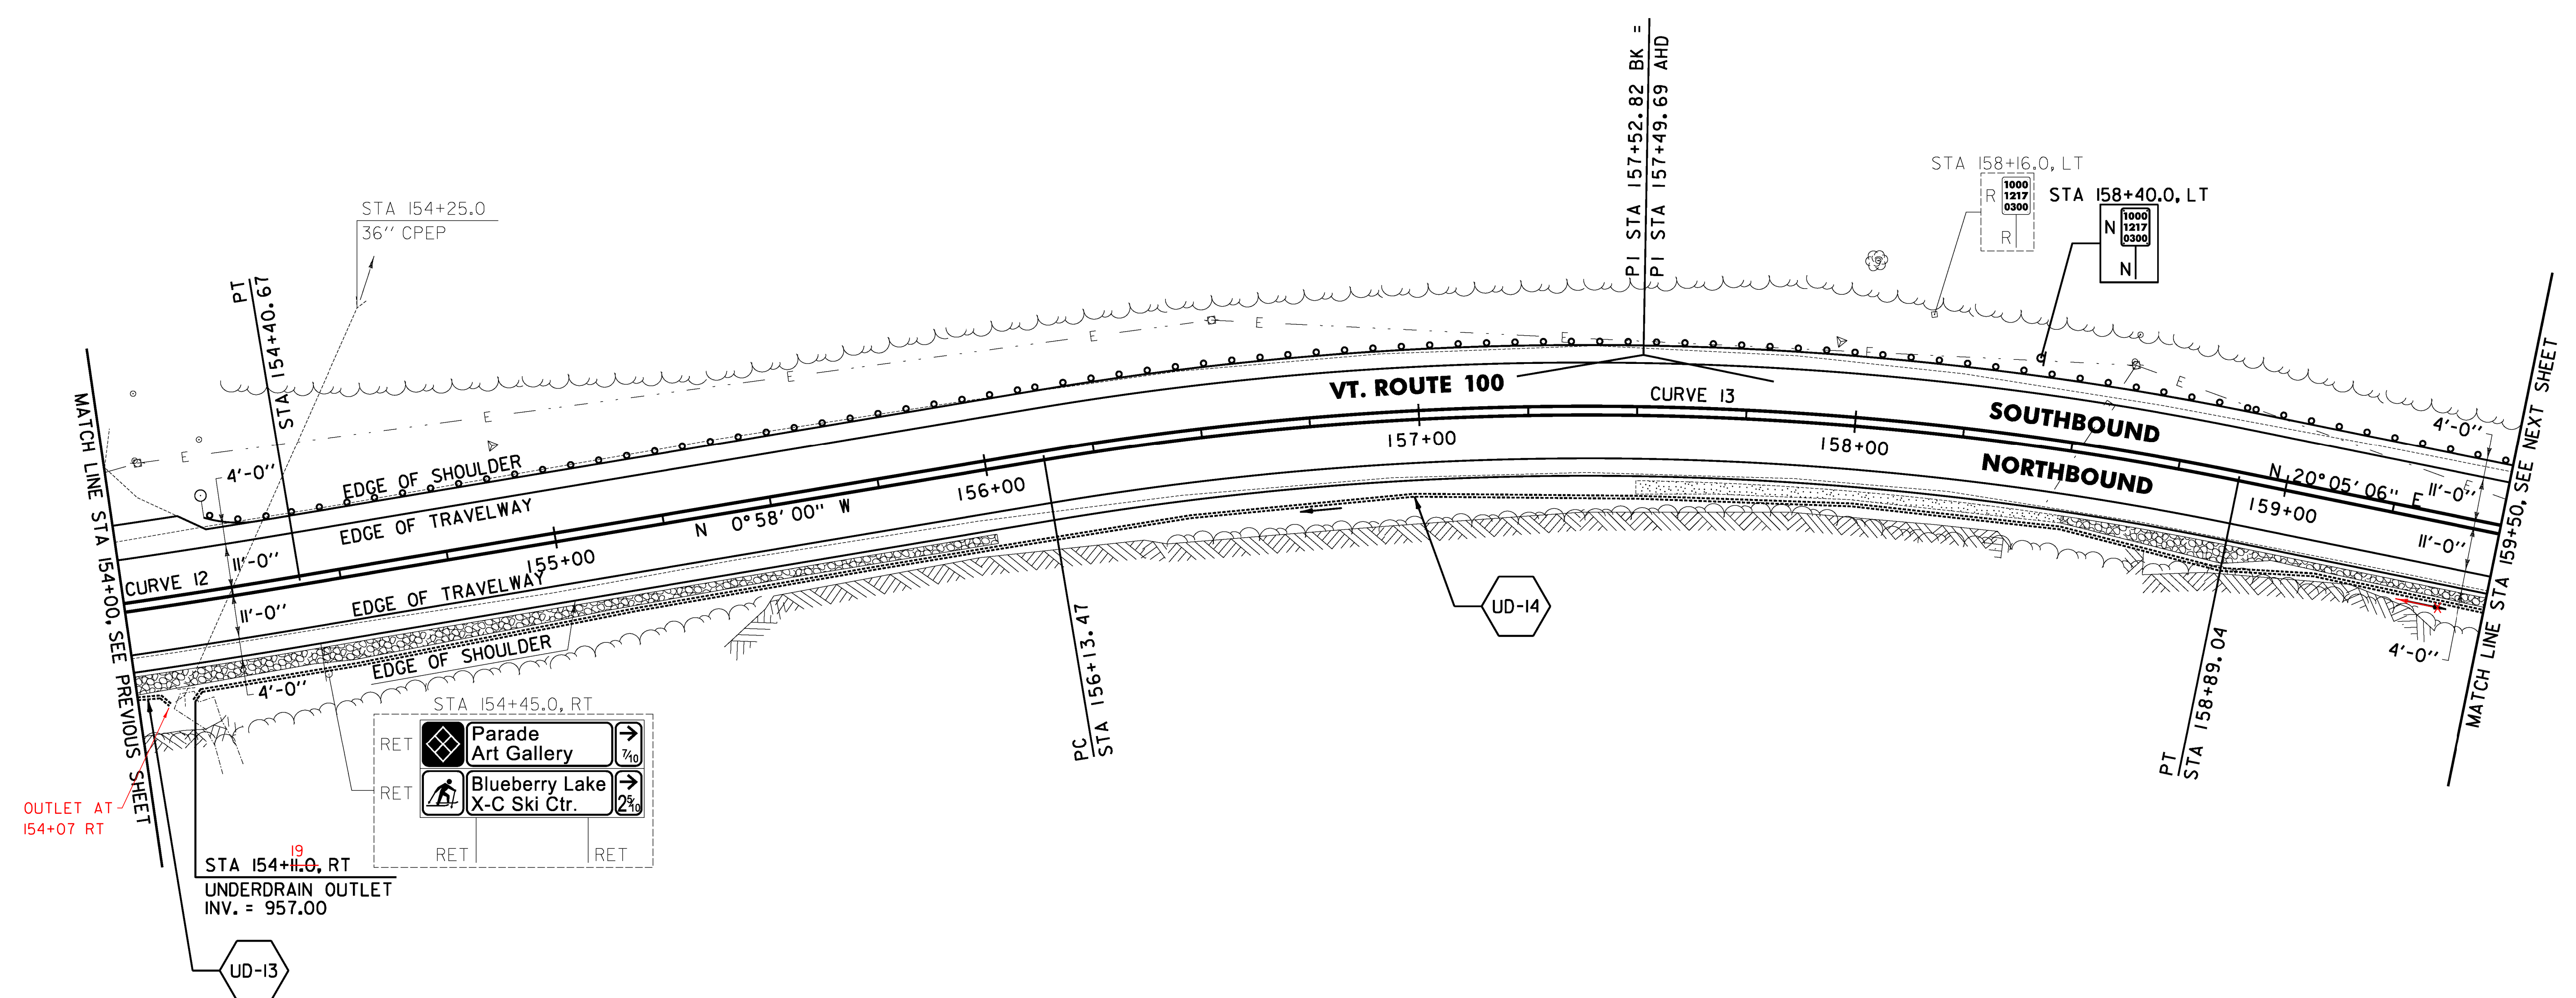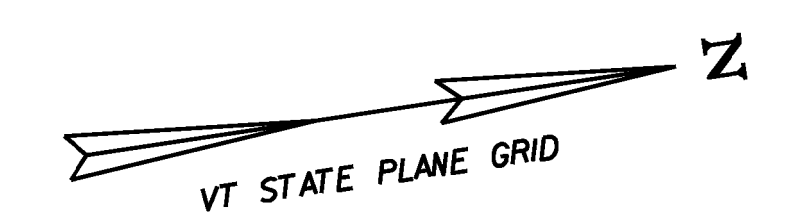

613.10 STONE FILL, TYPE I
 WARREN:
 STA 154+00.0 - STA 156+00.0 RT (29.9 CY)
 STA 158+50.0 - STA 159+50.0 RT (8.5 CY)

621.80 REMOVAL AND DISPOSAL OF GUARDRAIL
 WARREN:
 STA 154+15.0 - STA 159+50.0 LT (535.0 LF)

651.40 GRUBBING MATERIAL
 WARREN:
 STA 154+00.0 - STA 156+00.0 RT (86.9 SY)
 STA 157+50.0 - STA 158+50.0 RT (27.9 SY)
 STA 158+50.0 - STA 159+50.0 RT (23.9 SY)

653.20 TEMPORARY EROSION MATTING
 WARREN:
 STA 154+00.0 - STA 156+00.0 RT (86.9 SY)
 STA 157+50.0 - STA 158+50.0 RT (27.9 SY)
 STA 158+50.0 - STA 159+50.0 RT (23.9 SY)

676.10 DELINEATOR WITH STEEL POST
 WARREN:
 STA 154+21.2 LT

649.31 GEOTEXTILE UNDER STONE FILL
 WARREN:
 STA 154+00.0 - STA 156+00.0 RT (131.3 SY)
 STA 158+50.0 - STA 159+50.0 RT (46.1 SY)

900.640 SPECIAL PROVISION (BOX BEAM GUARDRAIL W/7 FEET POSTS)
 WARREN:
 STA 154+21.2 - STA 159+50.0 LT (528.8 LF)

CURVE 12
 $\Delta = 28^\circ 43' 16''$
 $D = 3^\circ 00' 56''$
 $R = 1900.00'$
 $T = 486.44'$
 $L = 952.43'$
 $E = 61.28'$
 $e = 0.053 \text{ FT/FT}$

CURVE 13
 $\Delta = 21^\circ 03' 06''$
 $D = 7^\circ 38' 22''$
 $R = 750.00'$
 $T = 139.35'$
 $L = 275.56'$
 $E = 12.84'$
 $e = 0.080 \text{ FT/FT}$

SIGN LEGEND
 R = REMOVE
 S = SALVAGE
 N = NEW
 RET = RETAIN
 B-B = BACK TO BACK
 EXISTING = _____
 NEW = _____
 ⊙ = RETURN TO THE TOWN OF WARREN

LEGEND

ITEM 613.10 STONE FILL, TYPE I

ITEM 653.20 TEMPORARY EROSION MATTING

0 20 40
 SCALE IN FEET

PROJECT LAYOUT SHEET #21	PROJECT NAME: WARREN - WAITSFIELD	PLOT DATE: 12/20/2012
	PROJECT NUMBER: STP 2506(1)	DRAWN BY: W.G.P.
	FILE NAME: p05b048.dgn	CHECKED BY: D.E.G.
	PROJECT LEADER: D.E.G.	SHEET 47 OF 310

FILE NAME = I:\17762\CADD\MSTN\STP_2506\p05b048_Contract_Plan.dgn
 DATE/TIME = 12/20/2012 4:06:56 PM