

646.402 DURABLE 4 INCH WHITE LINE, THERMOPLASTIC OR  
 646.403 DURABLE 4 INCH WHITE LINE, EPOXY PAINT OR  
 646.404 DURABLE 4 INCH WHITE LINE, POLYUREA  
 (ALL LINES WILL INCLUDE EDGE LINE BREAKS AND  
 RADII FOR TOWN HIGHWAYS)  
 WARREN:  
 STA 159+50.00 - STA 165+00.00 LT & RT

646.412 DURABLE 4 INCH YELLOW LINE, THERMOPLASTIC OR  
 646.413 DURABLE 4 INCH YELLOW LINE, EPOXY PAINT OR  
 646.414 DURABLE 4 INCH YELLOW LINE, POLYUREA  
 (ALL LINES WILL INCLUDE C/L BREAKS FOR  
 TOWN HIGHWAYS) S=SOLID, D=DASHED  
 WARREN:  
 STA 159+50.00 - STA 165+00.00

LT C RT  
 S - S


646.602 TEMPORARY 4 INCH WHITE LINE, PAINT  
 (ALL LINES WILL INCLUDE EDGE LINE BREAKS AND  
 RADII FOR TOWN HIGHWAYS)

WARREN:  
 STA 159+50.00 - STA 165+00.00 LT & RT

646.612 TEMPORARY 4 INCH YELLOW LINE, PAINT  
 (ALL LINES WILL INCLUDE C/L BREAKS FOR  
 TOWN HIGHWAYS) S=SOLID, D=DASHED

WARREN:  
 STA 159+50.00 - STA 165+00.00

LT C RT  
 S - S

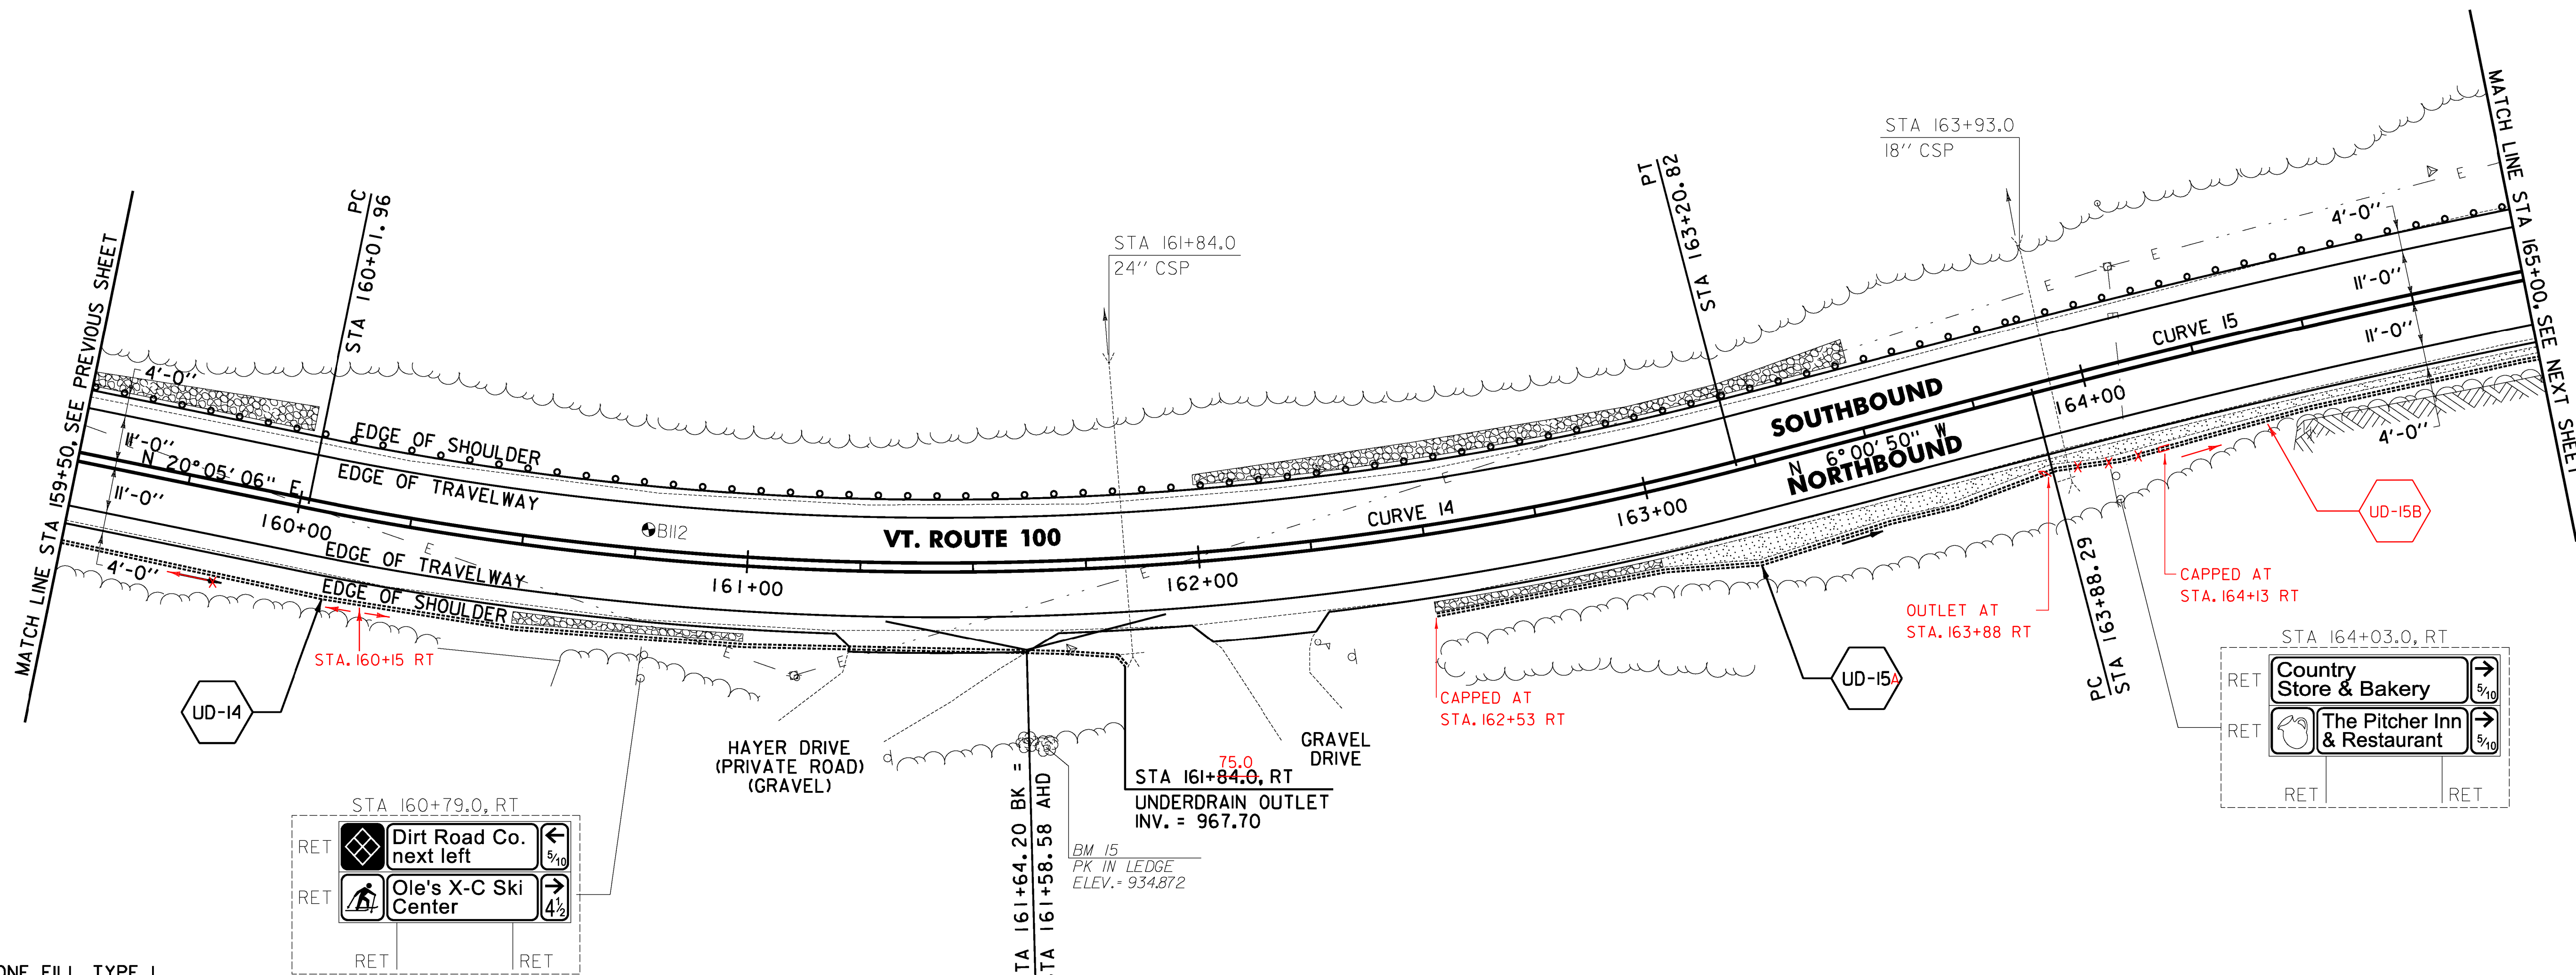

**613.10 STONE FILL, TYPE I**

WARREN:  
 STA 159+50.0 - STA 160+00.0 LT (9.8 CY)  
 STA 160+50.0 - STA 161+00.0 RT (5.1 CY)  
 STA 162+00.0 - STA 163+50.0 LT (23.6 CY)  
 STA 162+50.0 - STA 163+00.0 RT (2.3 CY)

**651.40 GRUBBING MATERIAL**

WARREN:  
 STA 159+50.0 - STA 160+00.0 LT (28.7 SY)  
 STA 160+50.0 - STA 161+00.0 RT (14.5 SY)  
 STA 162+00.0 - STA 163+50.0 LT (68.7 SY)  
 STA 162+50.0 - STA 163+00.0 RT (13.0 SY)  
 STA 163+00.0 - STA 165+00.0 RT (62.4 SY)

**653.20 TEMPORARY EROSION MATTING**

WARREN:  
 STA 159+50.0 - STA 160+00.0 LT (28.7 SY)  
 STA 160+50.0 - STA 161+00.0 RT (14.5 SY)  
 STA 162+00.0 - STA 163+50.0 LT (68.7 SY)  
 STA 162+50.0 - STA 163+00.0 RT (13.0 SY)  
 STA 163+00.0 - STA 165+00.0 RT (62.4 SY)

**621.80 REMOVAL AND DISPOSAL OF GUARDRAIL**

WARREN:  
 STA 159+50.0 - STA 165+00.0 LT (550.0 LF)

**900.640 SPECIAL PROVISION (BOX BEAM GUARDRAIL W/7 FEET POSTS)**

WARREN:  
 STA 159+50.0 - STA 165+00.0 LT (550.0 LF)

**649.31 GEOTEXTILE UNDER STONE FILL**

WARREN:  
 STA 159+50.0 - STA 160+00.0 LT (39.8 SY)  
 STA 160+50.0 - STA 161+00.0 RT (25.6 SY)  
 STA 162+00.0 - STA 163+50.0 LT (102.0 SY)  
 STA 162+50.0 - STA 163+00.0 RT (24.1 SY)

**CURVE 14**  
 $\Delta = 26^{\circ}05'56''$   
 $D = 8^{\circ}11'06''$   
 $R = 700.00'$   
 $T = 162.24'$   
 $L = 318.86'$   
 $E = 18.56'$   
 $e = 0.080 \text{ FT/FT}$

**CURVE 15**  
 $\Delta = 14^{\circ}15'41''$   
 $D = 2^{\circ}51'53''$   
 $R = 2000.00'$   
 $T = 250.20'$   
 $L = 497.82'$   
 $E = 15.59'$   
 $e = 0.051 \text{ FT/FT}$


SOIL BORING DATA			
BORING #	DEPTH (FT.)	PCC	COMMENTS
BI12	5.0	NO	

**SIGN LEGEND**

R = REMOVE  
 S = SALVAGE  
 N = NEW  
 RET = RETAIN  
 B-B = BACK TO BACK  
 EXISTING = \_\_\_\_\_  
 NEW = \_\_\_\_\_  
 ⊙ = RETURN TO THE TOWN OF WARREN

**LEGEND**

- ITEM 613.10 STONE FILL, TYPE I
- ITEM 653.20 TEMPORARY EROSION MATTING

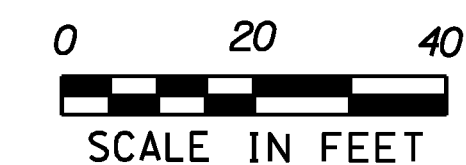

<b>PROJECT LAYOUT SHEET #22</b>	PROJECT NAME: WARREN - WAITSFIELD	PLOT DATE: 12/20/2012
	PROJECT NUMBER: STP 2506(1)	DRAWN BY: W.G.P.
	FILE NAME: p05b048.dgn	CHECKED BY: D.E.G.
	IPARM FILE: p05b048i22.1	SHEET 48 OF 310