

646.402 DURABLE 4 INCH WHITE LINE, THERMOPLASTIC OR  
 646.403 DURABLE 4 INCH WHITE LINE, EPOXY PAINT OR  
 646.404 DURABLE 4 INCH WHITE LINE, POLYUREA  
 (ALL LINES WILL INCLUDE EDGE LINE BREAKS AND  
 RADII FOR TOWN HIGHWAYS)  
 WARREN:  
 STA 174+00.00 - STA 179+50.00 LT & RT

646.412 DURABLE 4 INCH YELLOW LINE, THERMOPLASTIC OR  
 646.413 DURABLE 4 INCH YELLOW LINE, EPOXY PAINT OR  
 646.414 DURABLE 4 INCH YELLOW LINE, POLYUREA  
 (ALL LINES WILL INCLUDE C/L BREAKS FOR  
 TOWN HIGHWAYS) S=SOLID, D=DASHED  
 WARREN:  
 STA 174+00.00 - STA 179+50.00 LT ☉ RT  
 STA 174+87.36 DOUBLE SOLID RT, TH-4 S - S  
 STA 177+24.96 DOUBLE SOLID LT, TH-43 S - S

646.482 DURABLE 24 INCH STOP BAR, THERMOPLASTIC OR  
 646.483 DURABLE 24 INCH STOP BAR, EPOXY PAINT OR  
 646.484 DURABLE 24 INCH STOP BAR, POLYUREA  
 WARREN:  
 STA 174+87.36 RT, TH-4  
 STA 177+24.96 LT, TH-43

646.492 DURABLE LETTER OR SYMBOL, THERMOPLASTIC OR  
 646.493 DURABLE LETTER OR SYMBOL, EPOXY PAINT OR  
 646.494 DURABLE LETTER OR SYMBOL, POLYUREA  
 WARREN:  
 STA 174+87.36 RT, TH-4, "S,T,O,P" (4 EA)  
 STA 177+24.96 LT, TH-43, "S,T,O,P" (4 EA)



646.602 TEMPORARY 4 INCH WHITE LINE, PAINT  
 (ALL LINES WILL INCLUDE EDGE LINE BREAKS AND  
 RADII FOR TOWN HIGHWAYS)  
 WARREN:  
 STA 174+00.00 - STA 179+50.00 LT & RT

646.612 TEMPORARY 4 INCH YELLOW LINE, PAINT  
 (ALL LINES WILL INCLUDE C/L BREAKS FOR  
 TOWN HIGHWAYS) S=SOLID, D=DASHED  
 WARREN:  
 STA 174+00.00 - STA 179+50.00 LT ☉ RT  
 STA 174+87.36 DOUBLE SOLID RT, TH-4 S - S  
 STA 177+24.96 DOUBLE SOLID LT, TH-43 S - S

646.682 TEMPORARY 24 INCH STOP BAR, PAINT  
 WARREN:  
 STA 174+87.36 RT, TH-4  
 STA 177+24.96 LT, TH-43

646.692 TEMPORARY LETTER OR SYMBOL, PAINT  
 WARREN:  
 STA 174+87.36 RT, TH-4, "S,T,O,P" (8 EA)  
 STA 177+24.96 LT, TH-43, "S,T,O,P" (8 EA)

675.50 REMOVING SIGNS  
 AS SHOWN - 8  
 675.60 ERECTING SALVAGED SIGNS  
 AS SHOWN - 2

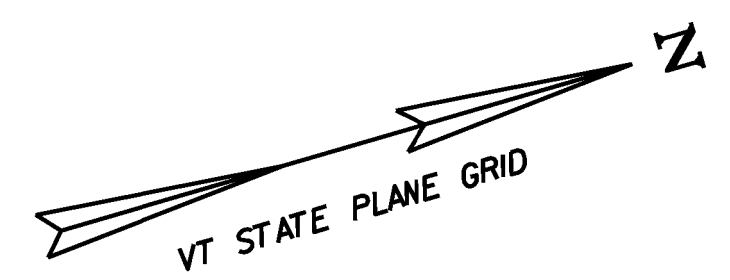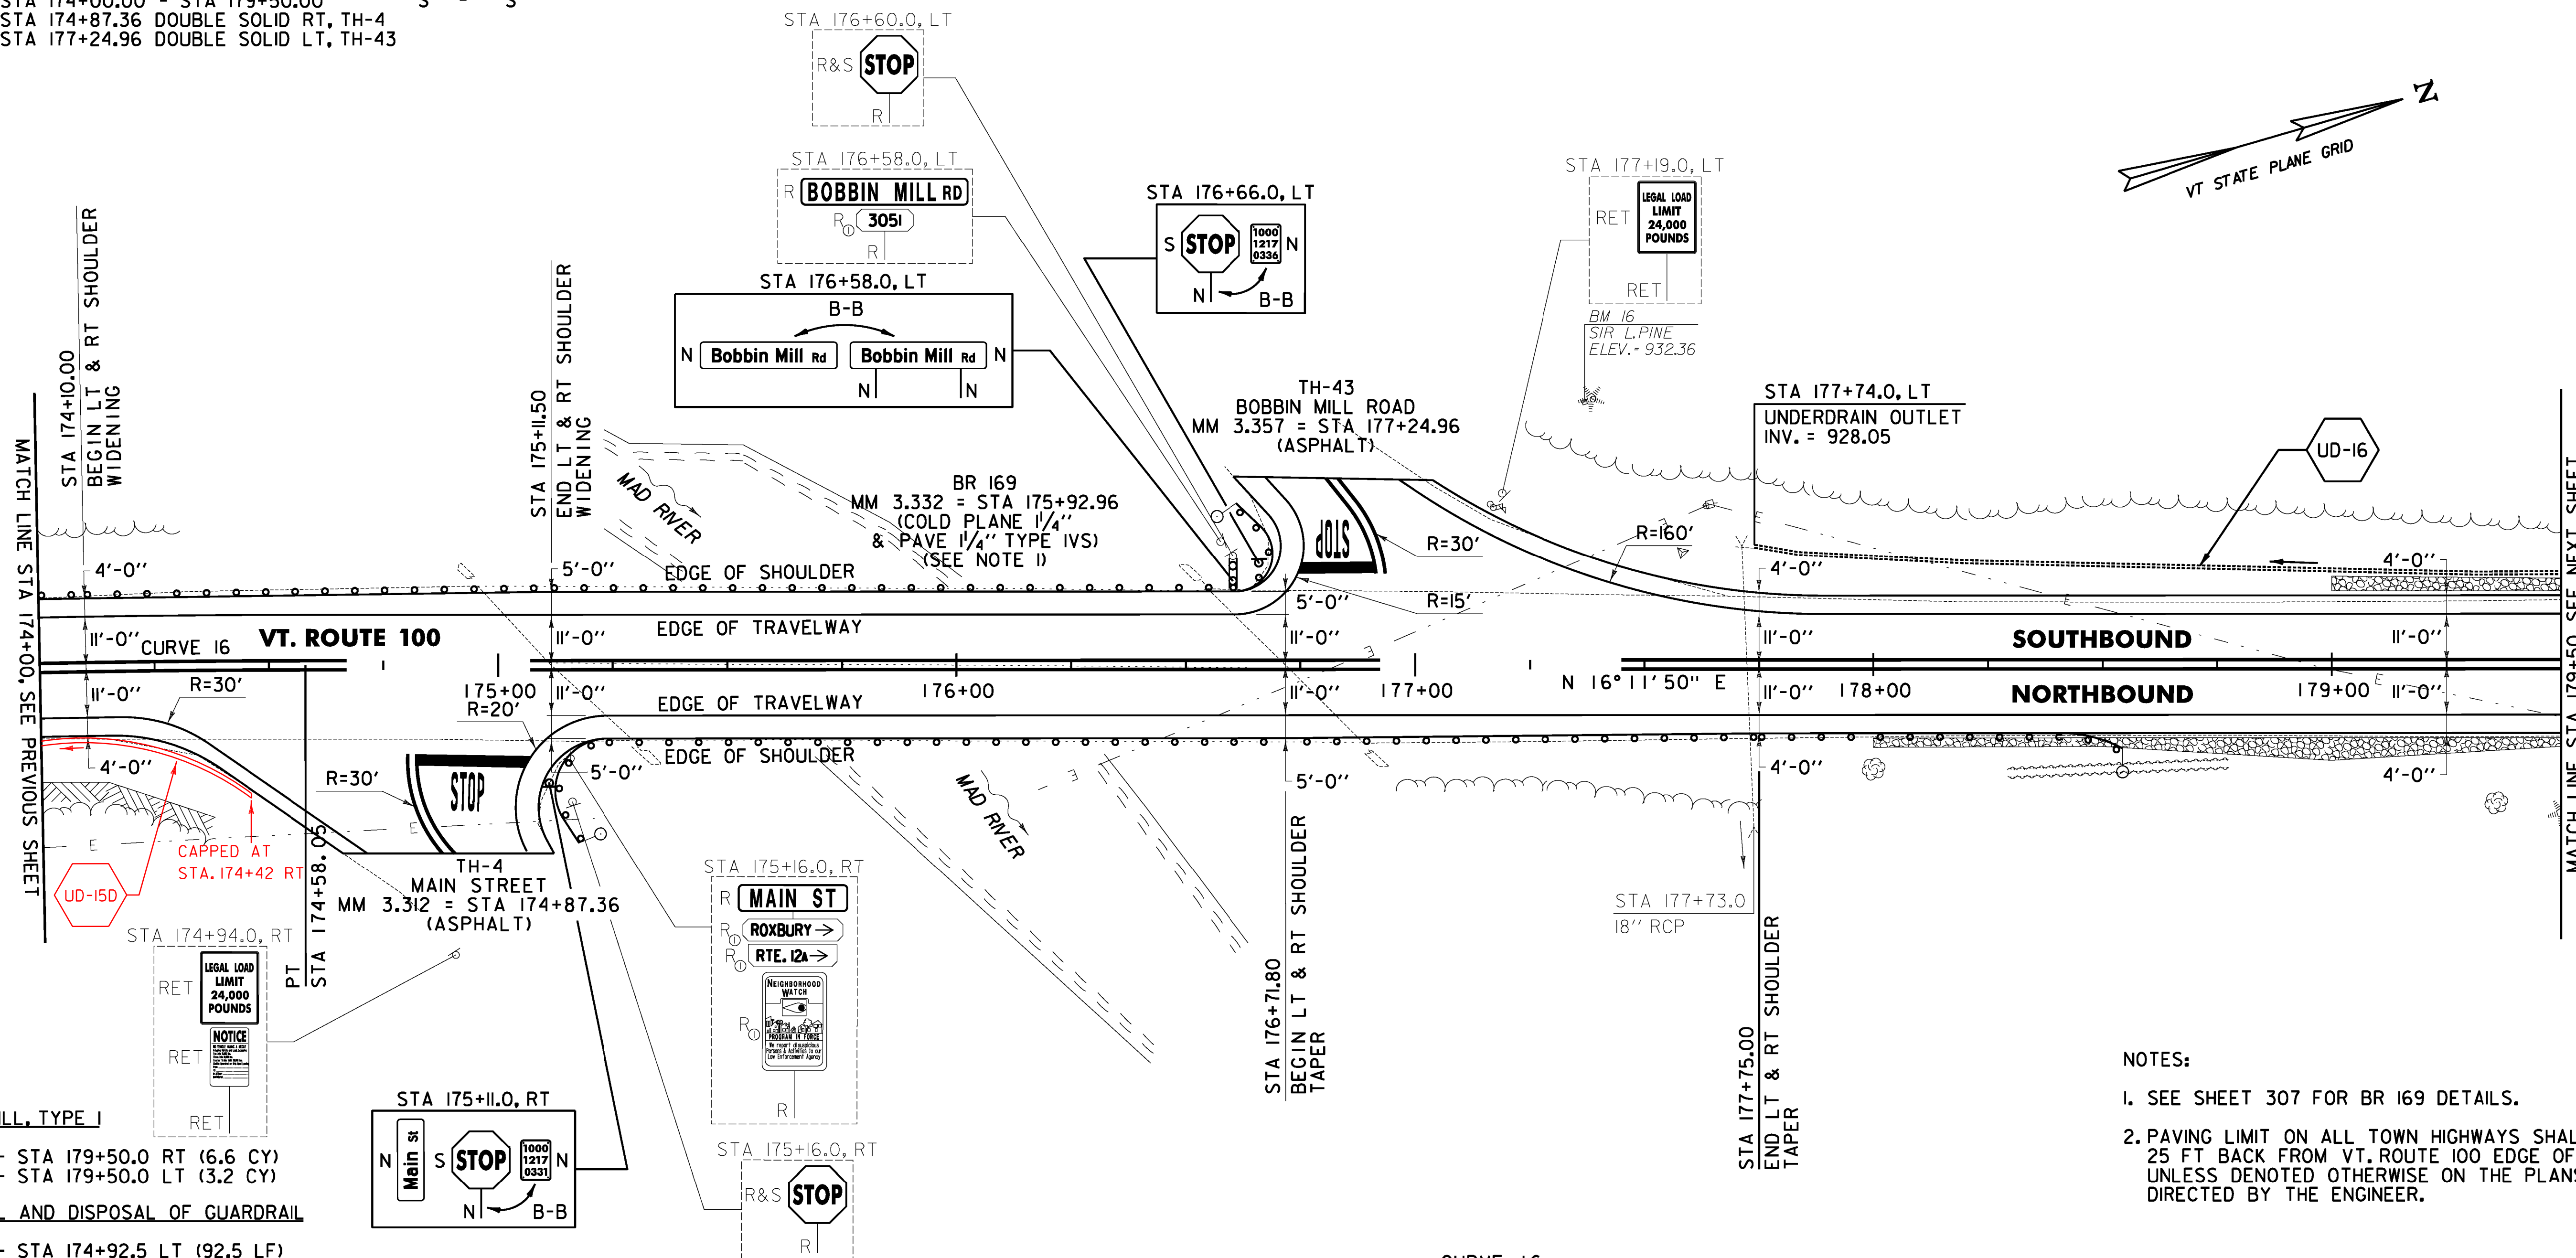

613.10 STONE FILL, TYPE I  
 WARREN:  
 STA 178+00.0 - STA 179+50.0 RT (6.6 CY)  
 STA 179+00.0 - STA 179+50.0 LT (3.2 CY)

621.80 REMOVAL AND DISPOSAL OF GUARDRAIL  
 WARREN:  
 STA 174+00.0 - STA 174+92.5 LT (92.5 LF)  
 STA 175+25.0 - STA 175+27.5 RT (52.0 LF)  
 STA 176+55.0 - STA 176+67.0 LT (12.0 LF)  
 STA 176+89.7 - STA 178+28.0 RT (138.3 LF)

651.40 GRUBBING MATERIAL  
 WARREN:  
 STA 178+00.0 - STA 179+50.0 RT (55.8 SY)  
 STA 179+00.0 - STA 179+50.0 LT (18.2 SY)

653.20 TEMPORARY EROSION MATTING  
 WARREN:  
 STA 178+00.0 - STA 179+50.0 RT (55.8 SY)  
 STA 179+00.0 - STA 179+50.0 LT (18.2 SY)

676.10 DELINEATOR WITH STEEL POST  
 WARREN:  
 STA 175+25.0 RT  
 STA 176+55.0 LT  
 STA 178+53.3 RT

649.31 GEOTEXTILE UNDER STONE FILL  
 WARREN:  
 STA 178+00.0 - STA 179+50.0 RT (92.1 SY)  
 STA 179+00.0 - STA 179+50.0 LT (30.6 SY)

900.620 SPECIAL PROVISION (GUARDRAIL APPROACH SECTION, GALVANIZED 2 RAIL BOX BEAM)  
 WARREN:  
 STA 174+60.2 - STA 174+92.5 LT (1 EA)  
 STA 175+25.0 - STA 175+27.5 RT (1 EA)  
 STA 176+55.0 - STA 176+55.0 LT (1 EA)  
 STA 176+90.0 - STA 177+22.3 RT (1 EA)

900.640 SPECIAL PROVISION (BOX BEAM GUARDRAIL W/7 FEET POSTS)  
 WARREN:  
 STA 174+00.0 - STA 174+60.2 LT (60.2 LF)  
 STA 175+25.0 - STA 175+25.0 RT (59.0 LF)  
 STA 176+55.0 - STA 176+62.0 LT (23.0 LF)  
 STA 177+22.3 - STA 178+53.3 RT (131.0 LF)

**CURVE 16**  
 Δ = 7° 56' 59"  
 D = 1° 54' 35"  
 R = 3000.00'  
 T = 208.46'  
 L = 416.24'  
 E = 7.23'  
 e = 0.037 FT/FT

**SIGN LEGEND**  
 R = REMOVE  
 S = SALVAGE  
 N = NEW  
 RET = RETAIN  
 B-B = BACK TO BACK  
 EXISTING = \_\_\_\_\_  
 NEW = \_\_\_\_\_  
 ☉ = RETURN TO THE TOWN OF WARREN

**NOTES:**  
 1. SEE SHEET 307 FOR BR 169 DETAILS.  
 2. PAVING LIMIT ON ALL TOWN HIGHWAYS SHALL BE MEASURED 25 FT BACK FROM VT. ROUTE 100 EDGE OF SHOULDER UNLESS DENOTED OTHERWISE ON THE PLANS OR AS DIRECTED BY THE ENGINEER.

**LEGEND**  
 ITEM 613.10 STONE FILL, TYPE I  
 ITEM 653.20 TEMPORARY EROSION MATTING



<b>PROJECT LAYOUT SHEET #25</b>	PROJECT NAME: WARREN - WAITSFIELD
	PROJECT NUMBER: STP 2506(1)
	FILE NAME: p05b048.dgn
	IPARM FILE: p05b048i25.i
	PLOT DATE: 12/20/2012
	DRAWN BY: W.G.P.
	CHECKED BY: D.E.G.
	SHEET 51 OF 310

FILE NAME = I:\17762\CADD\MSTN\STP 2506\p05b048\_Contract Plans.dgn  
 DATE/TIME = 12/20/2012 10:46:56  
 USER =