

646.402 DURABLE 4 INCH WHITE LINE, THERMOPLASTIC OR
 646.403 DURABLE 4 INCH WHITE LINE, EPOXY PAINT OR
 646.404 DURABLE 4 INCH WHITE LINE, POLYUREA
 (ALL LINES WILL INCLUDE EDGE LINE BREAKS AND
 RADII FOR TOWN HIGHWAYS)
 WARREN:
 STA 179+50.00 - STA 185+50.00 LT & RT
 STA 181+89.60 TH-3 EDGE LINE LT

646.412 DURABLE 4 INCH YELLOW LINE, THERMOPLASTIC OR
 646.413 DURABLE 4 INCH YELLOW LINE, EPOXY PAINT OR
 646.414 DURABLE 4 INCH YELLOW LINE, POLYUREA
 (ALL LINES WILL INCLUDE C/L BREAKS FOR
 TOWN HIGHWAYS) S=SOLID, D=DASHED
 WARREN:
 STA 179+50.00 - STA 185+50.00 LT C RT
 STA 181+89.60 TH-3 EDGE LINE LT S - S
 STA 181+89.60 DOUBLE SOLID LT, TH-3

646.442 DURABLE 8 INCH WHITE LINE, THERMOPLASTIC OR
 646.443 DURABLE 8 INCH WHITE LINE, EPOXY PAINT OR
 646.444 DURABLE 8 INCH WHITE LINE, POLYUREA
 WARREN:
 STA 181+89.60 TH-3, HATCHED AREA LT
 STA 181+91.00 - STA 182+69.00 TH-3 HATCHED AREA LT

646.492 DURABLE LETTER OR SYMBOL, THERMOPLASTIC OR
 646.493 DURABLE LETTER OR SYMBOL, EPOXY PAINT OR
 646.494 DURABLE LETTER OR SYMBOL, POLYUREA
 WARREN:
 STA 181+89.60 LT, TH-3, YIELD LINE (5 EA)
 STA 181+89.60 LT, TH-3, "S,T,O,P" (4 EA)

646.482 DURABLE 24 INCH STOP BAR, THERMOPLASTIC OR
 646.483 DURABLE 24 INCH STOP BAR, EPOXY PAINT OR
 646.484 DURABLE 24 INCH STOP BAR, POLYUREA
 WARREN:
 STA 181+89.60 LT, TH-3

646.602 TEMPORARY 4 INCH WHITE LINE, PAINT
 (ALL LINES WILL INCLUDE EDGE LINE BREAKS AND
 RADII FOR TOWN HIGHWAYS)
 WARREN:
 STA 179+50.00 - STA 185+50.00 LT & RT
 STA 181+89.60 TH-3 EDGE LINE LT



646.612 TEMPORARY 4 INCH YELLOW LINE, PAINT
 (ALL LINES WILL INCLUDE C/L BREAKS FOR
 TOWN HIGHWAYS) S=SOLID, D=DASHED
 WARREN:
 STA 179+50.00 - STA 185+50.00 LT C RT
 STA 181+89.60 TH-3 EDGE LINE LT S - S
 STA 181+89.60 DOUBLE SOLID LT, TH-3

646.682 TEMPORARY 24 INCH STOP BAR, PAINT
 WARREN:
 STA 181+89.60 LT, TH-3

646.692 TEMPORARY LETTER OR SYMBOL, PAINT
 WARREN:
 STA 181+89.60 LT, TH-3, YIELD LINE (10 EA)
 STA 181+89.60 LT, TH-3, "S,T,O,P" (8 EA)

675.50 REMOVING SIGNS
 AS SHOWN - 4

675.60 ERECTING SALVAGED SIGNS
 AS SHOWN - 1

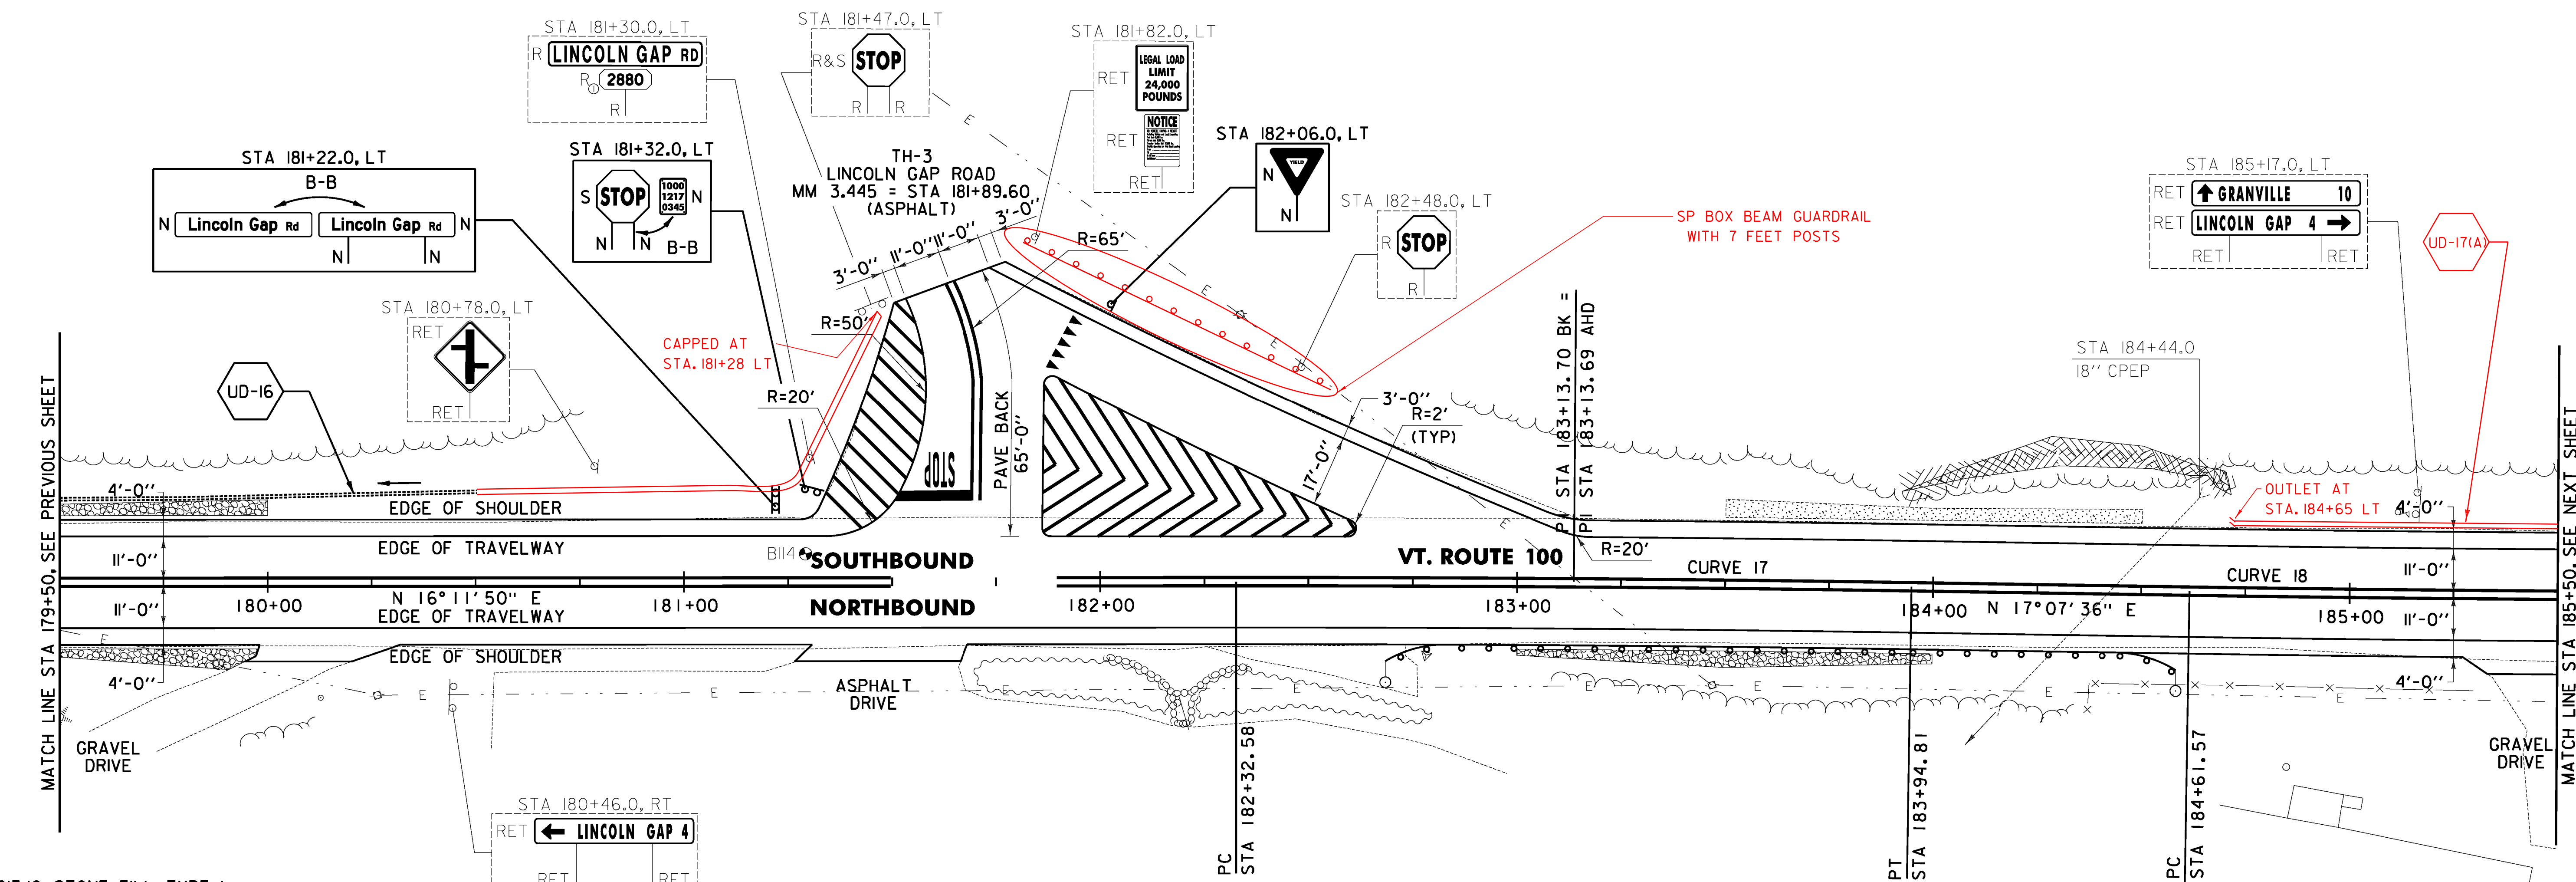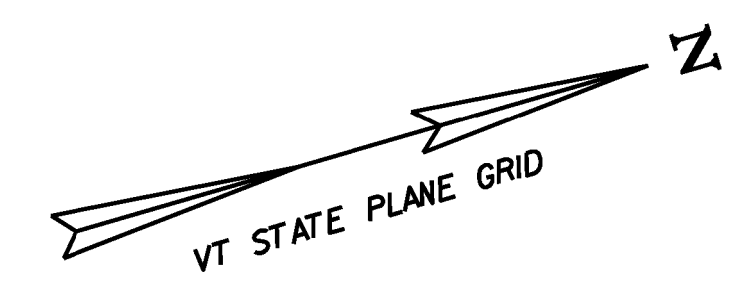

613.10 STONE FILL, TYPE I
 WARREN:
 STA 179+50.0 - STA 180+00.0 LT (3.2 CY)
 STA 179+50.0 - STA 179+97.0 RT (2.3 CY)
 STA 183+00.0 - STA 184+00.0 RT (13.6 CY)

621.80 REMOVAL AND DISPOSAL OF GUARDRAIL
 WARREN:
 STA 182+83.0 - STA 184+45.0 RT (162.0 LF)

651.40 GRUBBING MATERIAL
 WARREN:
 STA 179+50.0 - STA 180+00.0 LT (20.8 SY)
 STA 179+50.0 - STA 179+97.0 RT (22.6 SY)
 STA 183+00.0 - STA 184+00.0 RT (39.4 SY)
 STA 183+50.0 - STA 184+50.0 LT (42.5 SY)

653.20 TEMPORARY EROSION MATTING
 WARREN:
 STA 179+50.0 - STA 180+00.0 LT (20.8 SY)
 STA 179+50.0 - STA 179+97.0 RT (22.6 SY)
 STA 183+00.0 - STA 184+00.0 RT (39.4 SY)
 STA 183+50.0 - STA 184+50.0 LT (42.5 SY)

676.10 DELINEATOR WITH STEEL POST
 WARREN:
 STA 182+68.5 RT
 STA 184+58.5 RT

649.31 GEOTEXTILE UNDER STONE FILL
 WARREN:
 STA 179+50.0 - STA 180+00.0 LT (30.6 SY)
 STA 179+50.0 - STA 179+97.0 RT (30.7 SY)
 STA 183+00.0 - STA 184+00.0 RT (61.6 SY)
 900.640 SPECIAL PROVISION (BOX BEAM GUARDRAIL W/7 FEET POSTS)
 WARREN:
 STA 182+68.5 - STA 184+58.5 RT (190.0 LF)
 LINCOLN GAP ROAD "RT" (130 LF)

SOIL BORING DATA			
BORING #	DEPTH (FT.)	PCC	COMMENTS
BII4	5.0	NO	

CURVE 17
 $\Delta = 0^{\circ}55'46''$
 $D = 0^{\circ}34'23''$
 $R = 10000.00'$
 $T = 81.12'$
 $L = 162.23'$
 $E = 0.33'$
 $e = NC$

CURVE 18
 $\Delta = 1^{\circ}20'12''$
 $D = 0^{\circ}34'23''$
 $R = 10000.00'$
 $T = 116.66'$
 $L = 233.30'$
 $E = 0.68'$
 $e = NC$

SIGN LEGEND
 R = REMOVE
 S = SALVAGE
 N = NEW
 RET = RETAIN
 B-B = BACK TO BACK
 EXISTING = _____
 NEW = _____
 ⊙ = RETURN TO THE TOWN OF WARREN



LEGEND
 ITEM 613.10 STONE FILL, TYPE I
 ITEM 653.20 TEMPORARY EROSION MATTING

PROJECT LAYOUT SHEET #26	PROJECT NAME: WARREN - WAITSFIELD	PLOT DATE: 12/20/2012
	PROJECT NUMBER: STP 2506(1)	DRAWN BY: W.G.P.
	FILE NAME: p05b048.dgn	CHECKED BY: D.E.G.
	PROJECT LEADER: D.E.G.	SHEET 52 OF 310

FILE NAME = U:\17762\CADD\MSTN\STP 2506\p05b048.dgn
 DATE/TIME = 12/20/2012
 USER =