

646.402 DURABLE 4 INCH WHITE LINE, THERMOPLASTIC OR
 646.403 DURABLE 4 INCH WHITE LINE, EPOXY PAINT OR
 646.404 DURABLE 4 INCH WHITE LINE, POLYUREA
 (ALL LINES WILL INCLUDE EDGE LINE BREAKS AND
 RADII FOR TOWN HIGHWAYS)
 WARREN:
 STA 185+50.00 - STA 191+50.00 LT & RT

646.412 DURABLE 4 INCH YELLOW LINE, THERMOPLASTIC OR
 646.413 DURABLE 4 INCH YELLOW LINE, EPOXY PAINT OR
 646.414 DURABLE 4 INCH YELLOW LINE, POLYUREA
 (ALL LINES WILL INCLUDE C/L BREAKS FOR
 TOWN HIGHWAYS) S=SOLID, D=DASHED
 WARREN:
 STA 185+50.00 - STA 191+50.00 LT & RT
 STA 186+38.40 DOUBLE SOLID RT, TH-3

646.482 DURABLE 24 INCH STOP BAR, THERMOPLASTIC OR
 646.483 DURABLE 24 INCH STOP BAR, EPOXY PAINT OR
 646.484 DURABLE 24 INCH STOP BAR, POLYUREA
 WARREN:
 STA 186+38.40 RT, TH-3

646.492 DURABLE LETTER OR SYMBOL, THERMOPLASTIC OR
 646.493 DURABLE LETTER OR SYMBOL, EPOXY PAINT OR
 646.494 DURABLE LETTER OR SYMBOL, POLYUREA
 WARREN:
 STA 186+38.40 RT, TH-3, "S,T,O,P" (4 EA)



646.602 TEMPORARY 4 INCH WHITE LINE, PAINT
 (ALL LINES WILL INCLUDE EDGE LINE BREAKS AND
 RADII FOR TOWN HIGHWAYS)
 WARREN:
 STA 185+50.00 - STA 191+50.00 LT & RT

646.612 TEMPORARY 4 INCH YELLOW LINE, PAINT
 (ALL LINES WILL INCLUDE C/L BREAKS FOR
 TOWN HIGHWAYS) S=SOLID, D=DASHED
 WARREN:
 STA 185+50.00 - STA 191+50.00 LT & RT
 STA 186+38.40 DOUBLE SOLID RT, TH-3

646.682 TEMPORARY 24 INCH STOP BAR, PAINT
 WARREN:
 STA 186+38.40 RT, TH-3

646.692 TEMPORARY LETTER OR SYMBOL, PAINT
 WARREN:
 STA 186+38.40 RT, TH-3, "S,T,O,P" (8 EA)

675.50 REMOVING SIGNS
 AS SHOWN - 5
 675.60 ERECTING SALVAGED SIGNS
 AS SHOWN - 1

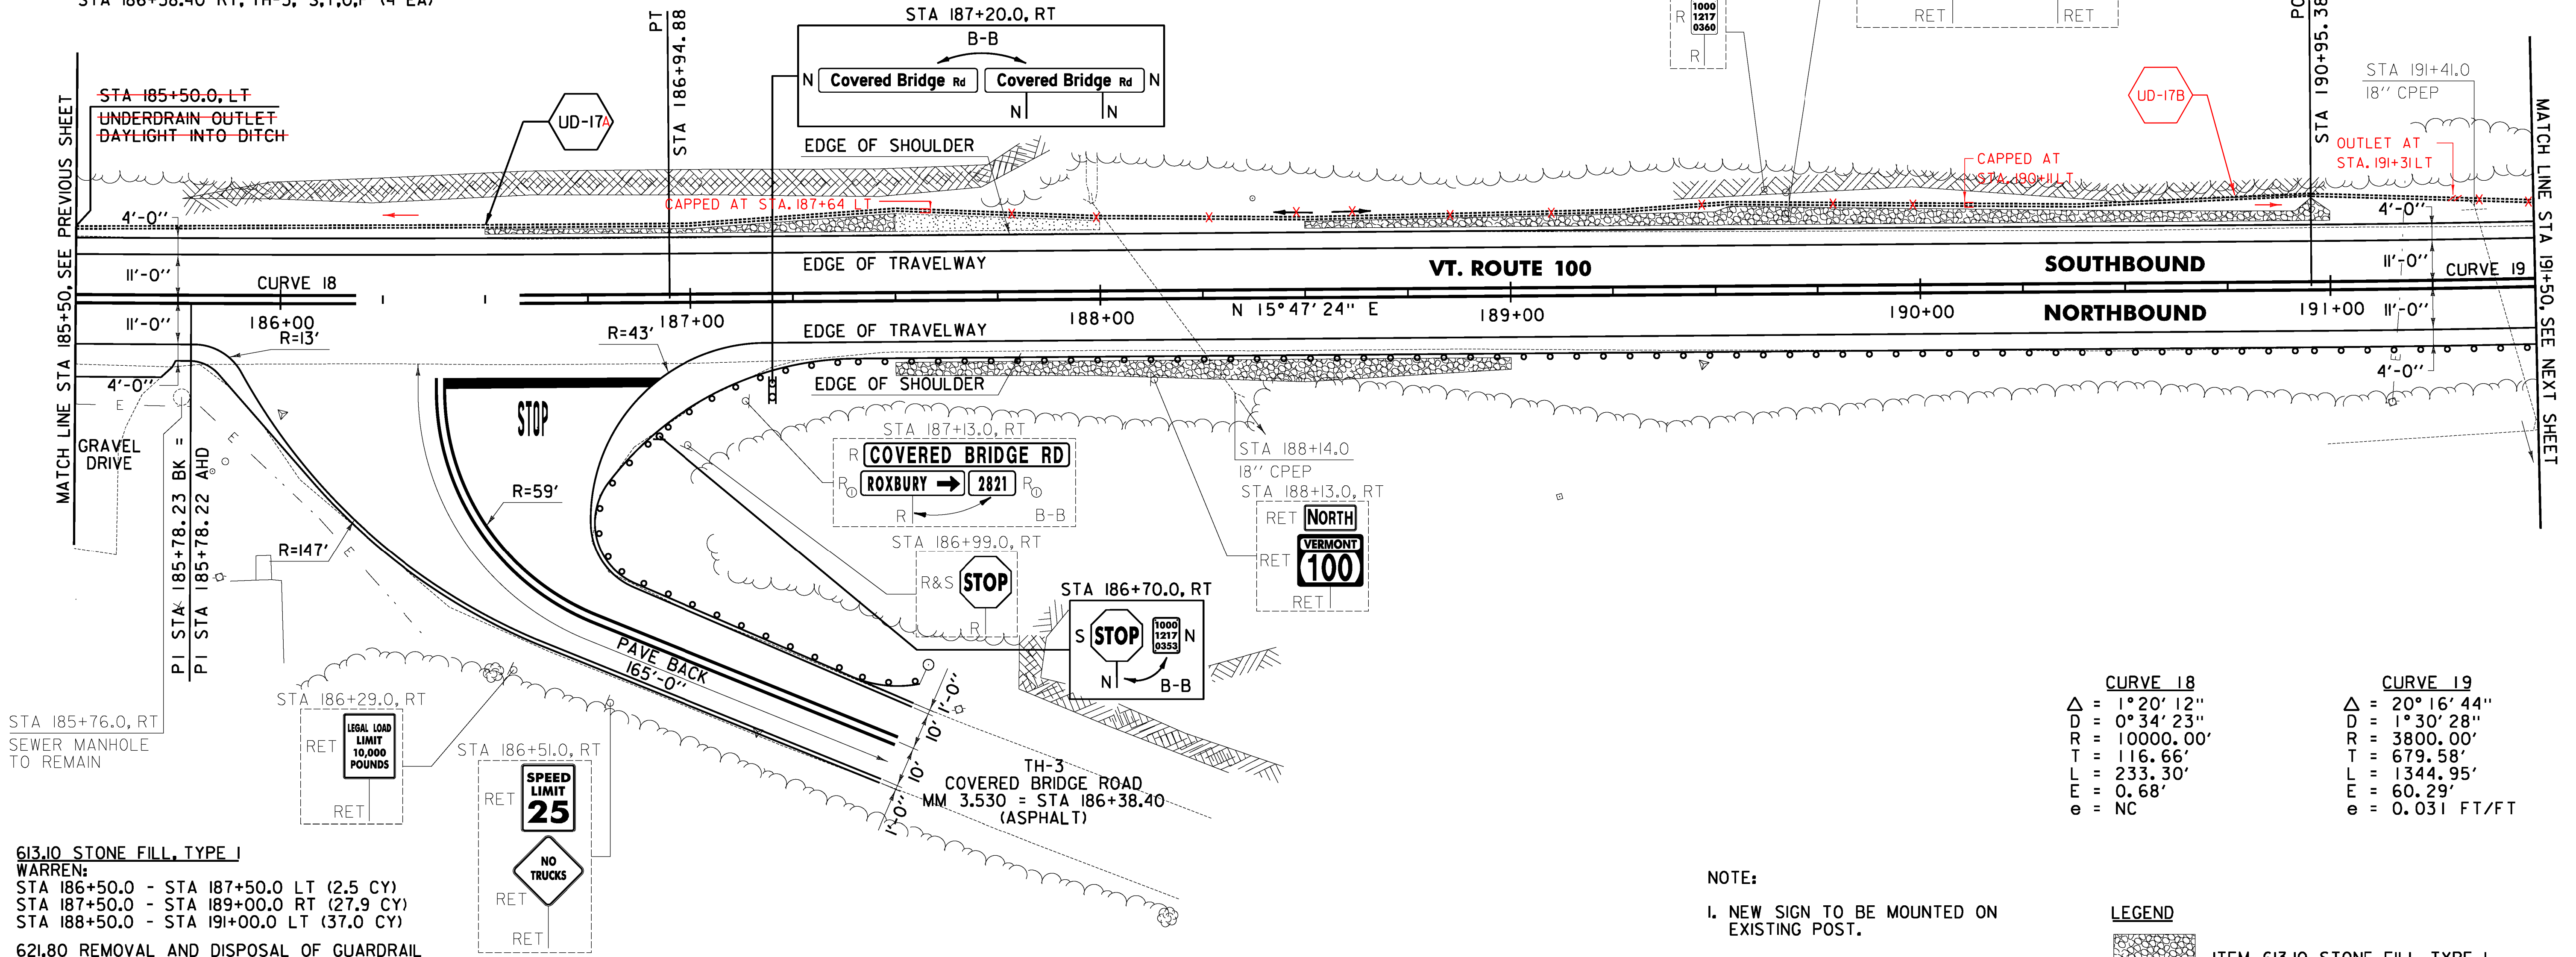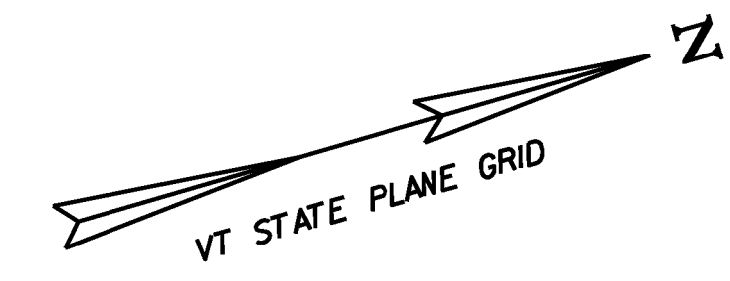


CURVE 18	CURVE 19
Δ = 1° 20' 12"	Δ = 20° 16' 44"
D = 0° 34' 23"	D = 1° 30' 28"
R = 10000.00'	R = 3800.00'
T = 116.66'	T = 679.58'
L = 233.30'	L = 1344.95'
E = 0.68'	E = 60.29'
e = NC	e = 0.031 FT/FT

NOTE:
 I. NEW SIGN TO BE MOUNTED ON EXISTING POST.

LEGEND

	ITEM 613.10 STONE FILL, TYPE I
	ITEM 653.20 TEMPORARY EROSION MATTING

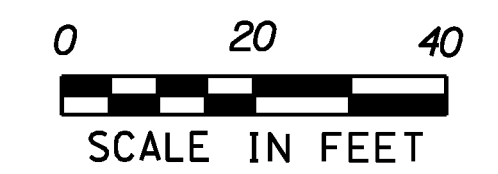

SIGN LEGEND
 R = REMOVE
 S = SALVAGE
 N = NEW
 RET = RETAIN
 B-B = BACK TO BACK
 EXISTING = _____
 NEW = _____
 ⊙ = RETURN TO THE TOWN OF WARREN

PROJECT LAYOUT SHEET #27	PROJECT NAME: WARREN - WAITSFIELD
	PROJECT NUMBER: STP 2506(1)
	FILE NAME: p05b048.dgn
	IPARM FILE: p05b048i27.i
	PLOT DATE: 12/20/2012
	DRAWN BY: W.G.P.
	CHECKED BY: D.E.G.
	SHEET 53 OF 310

FILE NAME = U:\17762\CADD\MST\STP_2506\p05b048_Contract_Plane.dgn
 DATE/TIME = 12/20/2012
 USER = 4866