


646.402 DURABLE 4 INCH WHITE LINE, THERMOPLASTIC OR  
 646.403 DURABLE 4 INCH WHITE LINE, EPOXY PAINT OR  
 646.404 DURABLE 4 INCH WHITE LINE, POLYUREA  
 (ALL LINES WILL INCLUDE EDGE LINE BREAKS AND  
 RADII FOR TOWN HIGHWAYS)  
 WARREN:  
 STA 209+00.00 - STA 214+50.00 LT & RT

646.412 DURABLE 4 INCH YELLOW LINE, THERMOPLASTIC OR  
 646.413 DURABLE 4 INCH YELLOW LINE, EPOXY PAINT OR  
 646.414 DURABLE 4 INCH YELLOW LINE, POLYUREA  
 (ALL LINES WILL INCLUDE C/L BREAKS FOR  
 TOWN HIGHWAYS) S=SOLID, D=DASHED  
 WARREN:  
 STA 209+00.00 - STA 214+50.00 LT C RT  
 S - S

646.602 TEMPORARY 4 INCH WHITE LINE, PAINT  
 (ALL LINES WILL INCLUDE EDGE LINE BREAKS AND  
 RADII FOR TOWN HIGHWAYS)  
 WARREN:  
 STA 209+00.00 - STA 214+50.00 LT & RT

646.612 TEMPORARY 4 INCH YELLOW LINE, PAINT  
 (ALL LINES WILL INCLUDE C/L BREAKS FOR  
 TOWN HIGHWAYS) S=SOLID, D=DASHED  
 WARREN:  
 STA 209+00.00 - STA 214+50.00 LT C RT  
 S - S

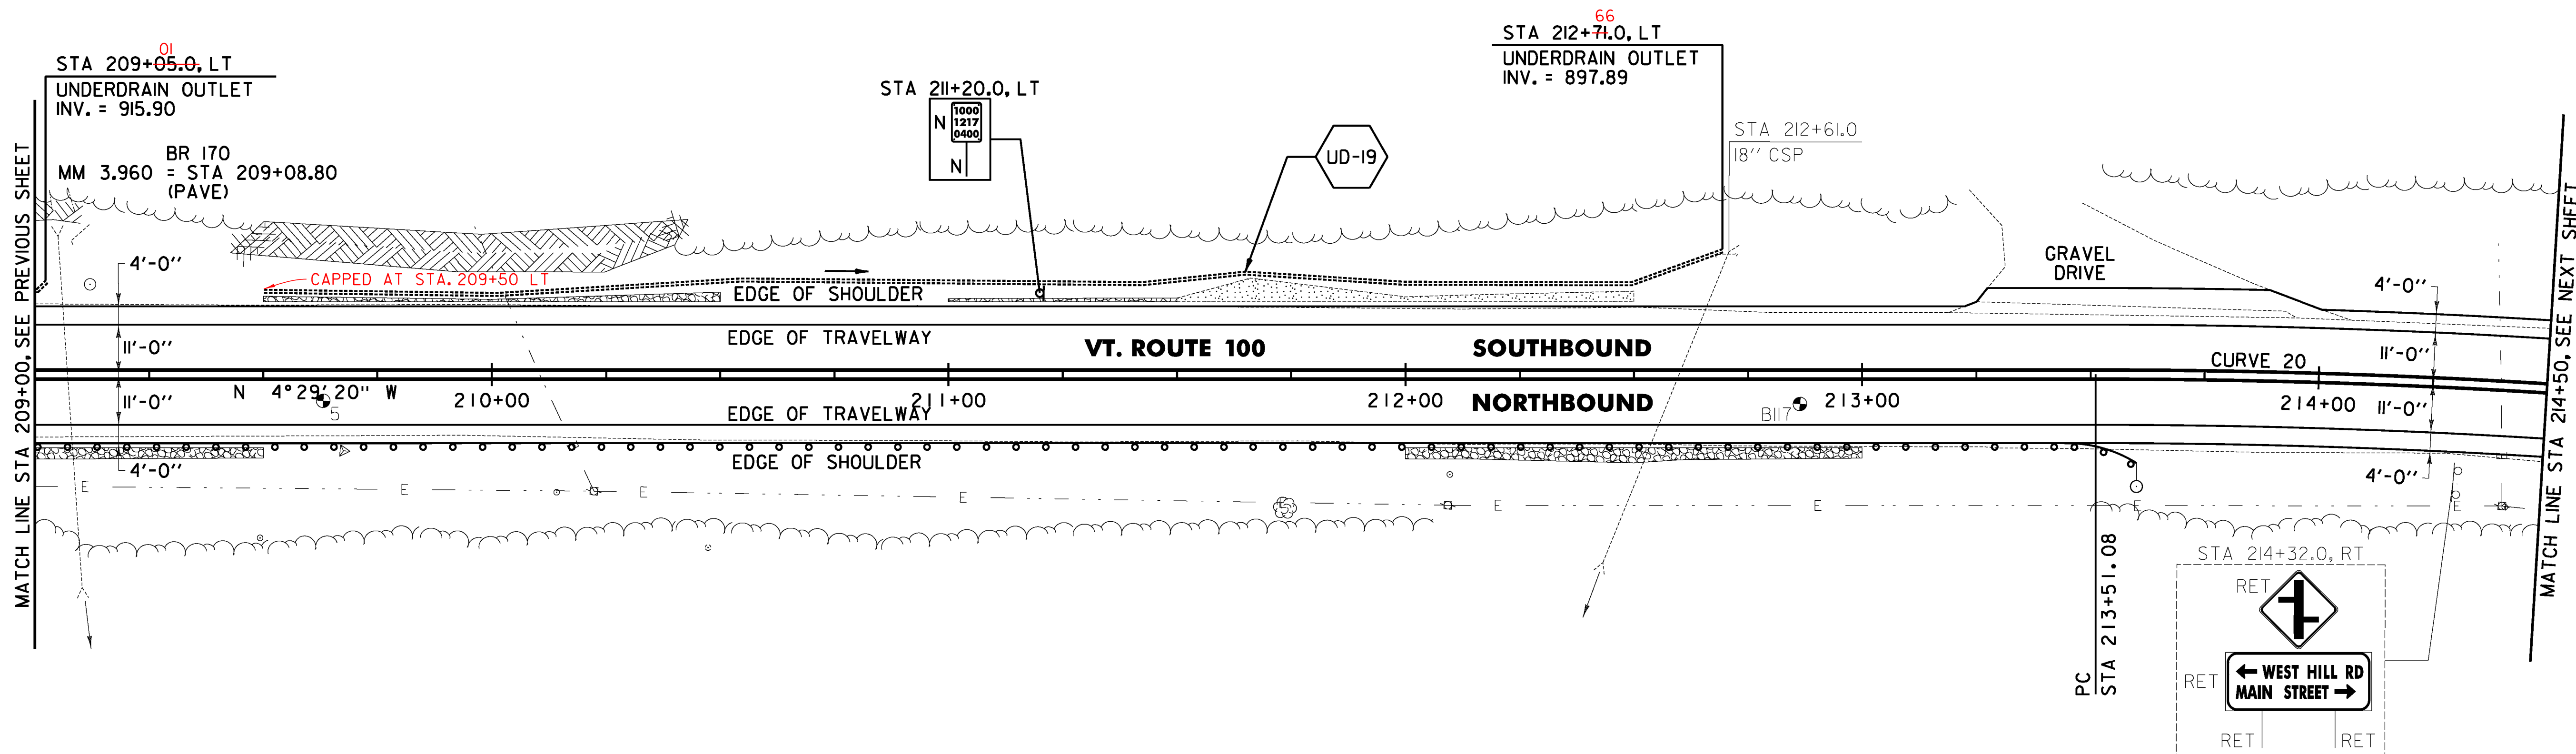

**613.10 STONE FILL, TYPE I**

WARREN:  
 STA 209+00.0 - STA 209+50.0 RT (2.9 CY)  
 STA 209+50.0 - STA 210+50.0 LT (11.5 CY)  
 STA 211+00.0 - STA 211+50.0 LT (2.1 CY)  
 STA 212+00.0 - STA 213+00.0 RT (13.1 CY)

**621.80 REMOVAL AND DISPOSAL OF GUARDRAIL**

WARREN:  
 STA 209+00.0 - STA 210+25.0 RT (125.0 LF)

**651.40 GRUBBING MATERIAL**

WARREN:  
 STA 209+00.0 - STA 209+50.0 RT (15.4 SY)  
 STA 209+50.0 - STA 210+50.0 LT (14.3 SY)  
 STA 211+00.0 - STA 211+50.0 LT (5.7 SY)  
 STA 211+50.0 - STA 212+50.0 LT (16.8 SY)  
 STA 212+00.0 - STA 213+00.0 RT (37.8 SY)

**653.20 TEMPORARY EROSION MATTING**

WARREN:  
 STA 209+00.0 - STA 209+50.0 RT (15.4 SY)  
 STA 209+50.0 - STA 210+50.0 LT (14.3 SY)  
 STA 211+00.0 - STA 211+50.0 LT (5.7 SY)  
 STA 211+50.0 - STA 212+50.0 LT (16.8 SY)  
 STA 212+00.0 - STA 213+00.0 RT (37.8 SY)

**649.31 GEOTEXTILE UNDER STONE FILL**

WARREN:  
 STA 209+00.0 - STA 209+50.0 RT (26.5 SY)  
 STA 209+50.0 - STA 210+50.0 LT (36.6 SY)  
 STA 211+00.0 - STA 211+50.0 LT (16.8 SY)  
 STA 212+00.0 - STA 213+00.0 RT (60.0 SY)

**900.640 SPECIAL PROVISION (BOX BEAM GUARDRAIL W/7 FEET POSTS)**

WARREN:  
 STA 209+00.0 - STA 213+60.0 RT (460.0 LF)

**676.10 DELINEATOR WITH STEEL POST**


WARREN:  
 STA 213+60.0 RT

PAVEMENT CORING DATA			
CORE #	DEPTH (IN.)	PCC	COMMENTS
5	8.25	NO	

SOIL BORING DATA			
BORING #	DEPTH (FT.)	PCC	COMMENTS
B117	5.0	NO	

**LEGEND**

- ITEM 613.10 STONE FILL, TYPE I
- ITEM 653.20 TEMPORARY EROSION MATTING

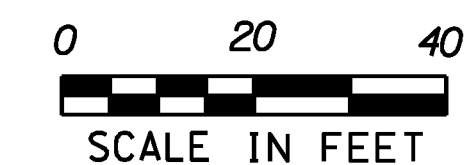

**SIGN LEGEND**

- R = REMOVE
- S = SALVAGE
- N = NEW
- RET = RETAIN
- B-B = BACK TO BACK
- EXISTING = -----
- NEW = \_\_\_\_\_
- ⊙ = RETURN TO THE TOWN OF WARREN

**PROJECT LAYOUT SHEET #31**

PROJECT NAME: WARREN - WAITSFIELD

PROJECT NUMBER: STP 2506(1)

FILE NAME: p05b048.dgn

PROJECT LEADER: D.E.G.

DESIGNED BY: M.J.M.

IPARM FILE: p05b048(3).i

PLOT DATE: 12/20/2012

DRAWN BY: W.G.P.

CHECKED BY: D.E.G.

SHEET 57 OF 310