

PI STA 221+45.06 BK =
PI STA 220+32.98 AHD

646.402 DURABLE 4 INCH WHITE LINE, THERMOPLASTIC OR
646.403 DURABLE 4 INCH WHITE LINE, EPOXY PAINT OR
646.404 DURABLE 4 INCH WHITE LINE, POLYUREA
(ALL LINES WILL INCLUDE EDGE LINE BREAKS AND
RADI FOR TOWN HIGHWAYS)
WARREN:
STA 220+50.00 - STA 225+50.00 LT & RT

646.412 DURABLE 4 INCH YELLOW LINE, THERMOPLASTIC OR
646.413 DURABLE 4 INCH YELLOW LINE, EPOXY PAINT OR
646.414 DURABLE 4 INCH YELLOW LINE, POLYUREA
(ALL LINES WILL INCLUDE C/L BREAKS FOR
TOWN HIGHWAYS) S=SOLID, D=DASHED
WARREN:
STA 220+50.00 - STA 225+50.00 LT & RT
STA 221+28.48 DOUBLE SOLID LT, TH-16

646.482 DURABLE 24 INCH STOP BAR, THERMOPLASTIC OR
646.483 DURABLE 24 INCH STOP BAR, EPOXY PAINT OR
646.484 DURABLE 24 INCH STOP BAR, POLYUREA
WARREN:
STA 221+28.48 LT, TH-16

646.492 DURABLE LETTER OR SYMBOL, THERMOPLASTIC OR
646.493 DURABLE LETTER OR SYMBOL, EPOXY PAINT OR
646.494 DURABLE LETTER OR SYMBOL, POLYUREA
WARREN:
STA 221+28.48 LT, TH-16, "S,T,O,P" (4 EA)

646.602 TEMPORARY 4 INCH WHITE LINE, PAINT
(ALL LINES WILL INCLUDE EDGE LINE BREAKS AND
RADI FOR TOWN HIGHWAYS)
WARREN:
STA 220+50.00 - STA 225+50.00 LT & RT



646.612 TEMPORARY 4 INCH YELLOW LINE, PAINT
(ALL LINES WILL INCLUDE C/L BREAKS FOR
TOWN HIGHWAYS) S=SOLID, D=DASHED
WARREN:
STA 220+50.00 - STA 225+50.00 LT & RT
STA 221+28.48 DOUBLE SOLID LT, TH-16

675.50 REMOVING SIGNS
AS SHOWN - 5

675.60 ERECTING SALVAGED SIGNS
AS SHOWN - 2

646.682 TEMPORARY 24 INCH STOP BAR, PAINT
WARREN:
STA 221+28.48 LT, TH-16

646.692 TEMPORARY LETTER OR SYMBOL, PAINT
WARREN:
STA 221+28.48 LT, TH-16, "S,T,O,P" (8 EA)

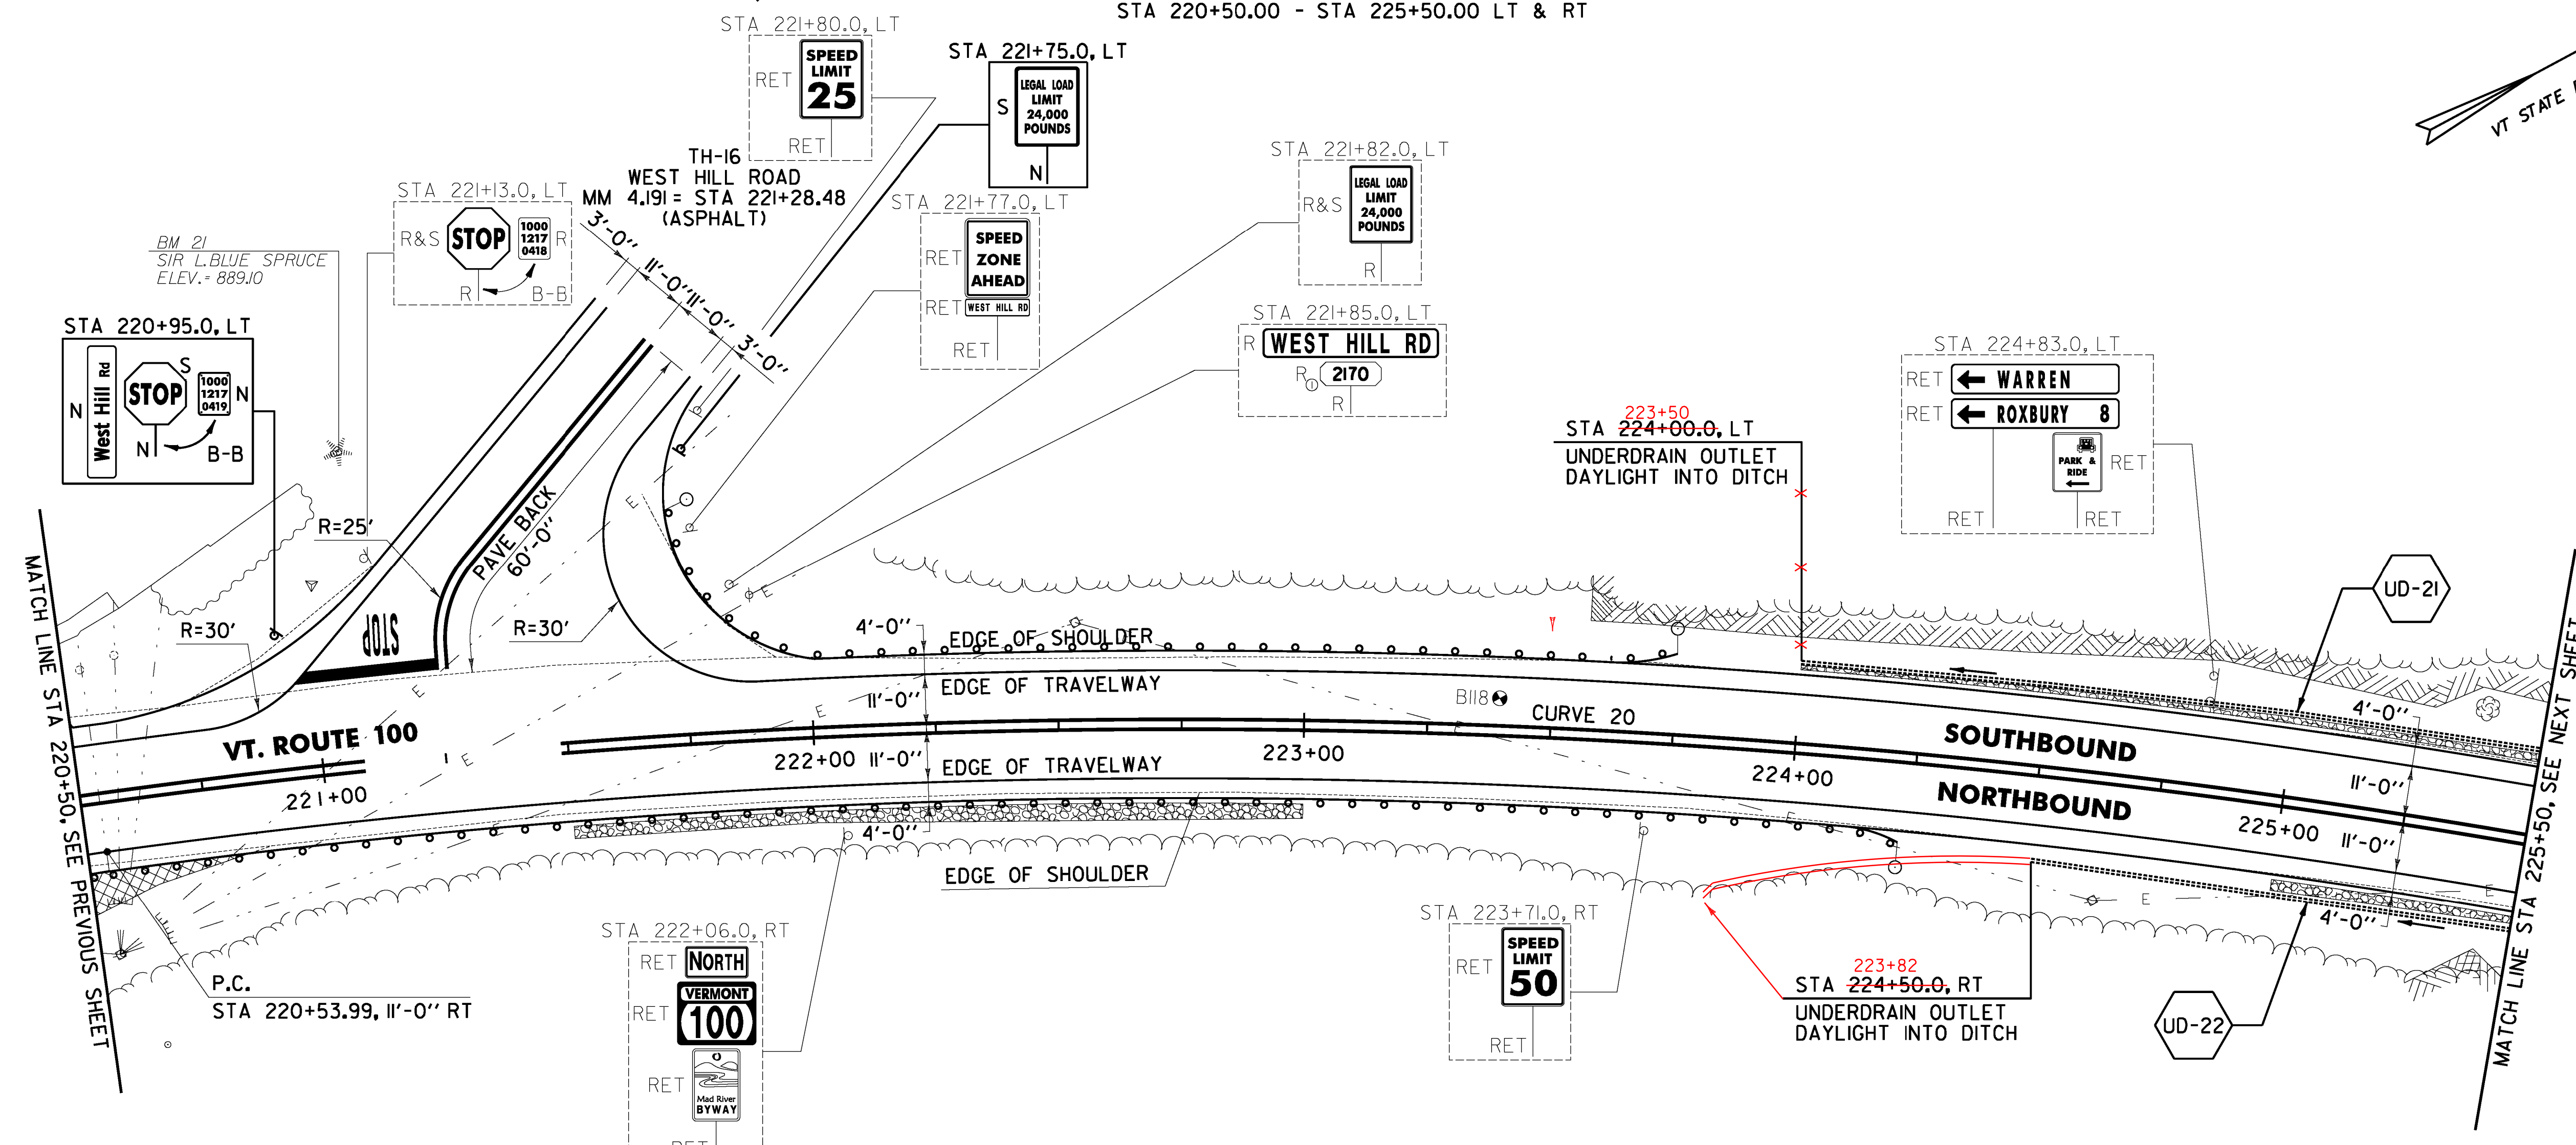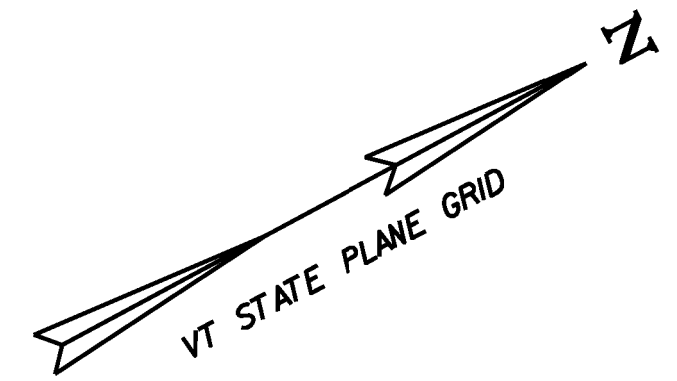

613.10 STONE FILL, TYPE I
WARREN:
STA 221+50.0 - STA 223+00.0 RT (19.7 CY)
STA 224+00.0 - STA 225+50.0 LT (9.4 CY)
STA 225+00.0 - STA 225+50.0 RT (1.8 CY)

621.80 REMOVAL AND DISPOSAL OF GUARDRAIL
WARREN:
STA 220+50.0 - STA 223+88.0 RT (338.0 LF)
STA 221+77.0 - STA 223+70.0 LT (211.0 LF)

651.40 GRUBBING MATERIAL
WARREN:
STA 221+50.0 - STA 223+00.0 RT (56.8 SY)
STA 224+00.0 - STA 225+50.0 LT (26.2 SY)
STA 225+00.0 - STA 225+50.0 RT (12.1 SY)

653.20 TEMPORARY EROSION MATTING
WARREN:
STA 221+50.0 - STA 223+00.0 RT (56.8 SY)
STA 224+00.0 - STA 225+50.0 LT (26.2 SY)
STA 225+00.0 - STA 225+50.0 RT (12.1 SY)

676.10 DELINEATOR WITH STEEL POST
WARREN:
STA 221+73.0 LT
STA 223+75.0 LT
STA 224+22.5 RT

NOTE:

1. THE CONTRACTOR SHALL REMOVE THE TOP 18" OF THE EXISTING MAIN STREET ROAD SURFACE LOCATED OUTSIDE THE PROPOSED ROADWAY UNDER ITEM 203.17 UNCLASSIFIED EXCAVATION. THE CONTRACTOR SHALL REPLACE THE EXCAVATED MATERIAL WITH ITEM 203.30 EARTH BORROW AND 4" OF ITEM 651.35 TOPSOIL OR AS DIRECTED BY THE ENGINEER.

649.31 GEOTEXTILE UNDER STONE FILL
WARREN:
STA 221+50.0 - STA 223+00.0 RT (90.1 SY)
STA 224+00.0 - STA 225+50.0 LT (59.5 SY)
STA 225+00.0 - STA 225+50.0 RT (23.2 SY)

900.640 SPECIAL PROVISION (BOX BEAM GUARDRAIL W/7 FEET POSTS)
WARREN:
STA 220+50.0 - STA 224+22.5 RT (372.5 LF)
STA 221+73.0 - STA 223+75.0 LT (244.0 LF)

SOIL BORING DATA			
BORING #	DEPTH (FT.)	PCC	COMMENTS
B118	4.4	NO	REFUSAL AT 4.4 FT

CURVE 20
Δ = 52°21'36"
D = 3°32'52"
R = 1615.00'
T = 793.98'
L = 1475.87'
E = 184.62'
e = 0.059 FT/FT

SIGN LEGEND
R = REMOVE
S = SALVAGE
N = NEW
RET = RETAIN
B-B = BACK TO BACK
EXISTING = _____
NEW = _____
⊙ = RETURN TO THE TOWN OF WARREN

LEGEND

- ITEM 613.10 STONE FILL, TYPE I
- ITEM 653.20 TEMPORARY EROSION MATTING
- EXISTING PAVEMENT TO BE REMOVED (SEE NOTE 1)



PROJECT LAYOUT SHEET #33

PROJECT NAME: WARREN - WAITSFIELD

PROJECT NUMBER: STP 2506(1)

FILE NAME: p05b048.dgn

PROJECT LEADER: D.E.G.

DESIGNED BY: M.J.M.

IPARM FILE: p05b048i33.1

PLOT DATE: 12/20/2012

DRAWN BY: W.G.P.

CHECKED BY: D.E.G.

SHEET 59 OF 310