
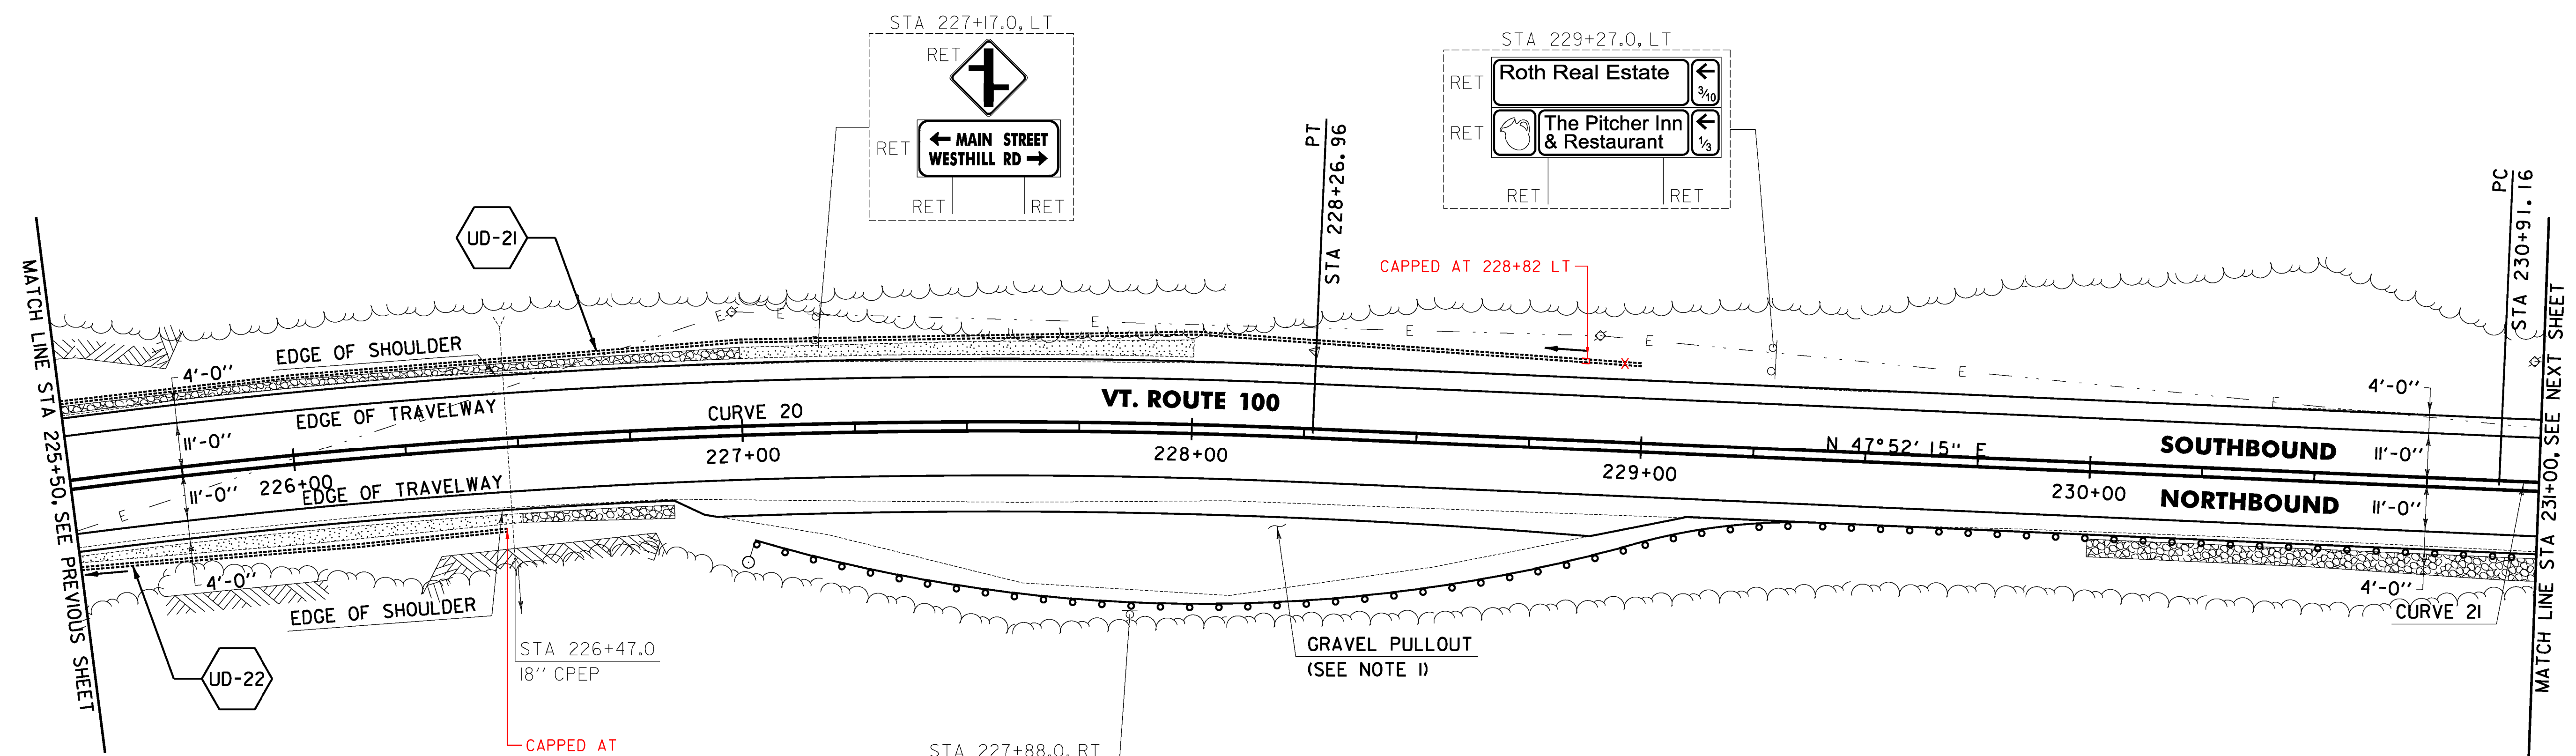


646.402 DURABLE 4 INCH WHITE LINE, THERMOPLASTIC OR
 646.403 DURABLE 4 INCH WHITE LINE, EPOXY PAINT OR
 646.404 DURABLE 4 INCH WHITE LINE, POLYUREA
 (ALL LINES WILL INCLUDE EDGE LINE BREAKS AND
 RADII FOR TOWN HIGHWAYS)
 WARREN:
 STA 225+50.00 - STA 231+00.00 LT & RT

646.412 DURABLE 4 INCH YELLOW LINE, THERMOPLASTIC OR
 646.413 DURABLE 4 INCH YELLOW LINE, EPOXY PAINT OR
 646.414 DURABLE 4 INCH YELLOW LINE, POLYUREA
 (ALL LINES WILL INCLUDE C/L BREAKS FOR
 TOWN HIGHWAYS) S=SOLID, D=DASHED
 WARREN:
 STA 225+50.00 - STA 231+00.00 LT C RT
 S - S

646.602 TEMPORARY 4 INCH WHITE LINE, PAINT
 (ALL LINES WILL INCLUDE EDGE LINE BREAKS AND
 RADII FOR TOWN HIGHWAYS)
 WARREN:
 STA 225+50.00 - STA 231+00.00 LT & RT

646.612 TEMPORARY 4 INCH YELLOW LINE, PAINT
 (ALL LINES WILL INCLUDE C/L BREAKS FOR
 TOWN HIGHWAYS) S=SOLID, D=DASHED
 WARREN:
 STA 225+50.00 - STA 231+00.00 LT C RT
 S - S

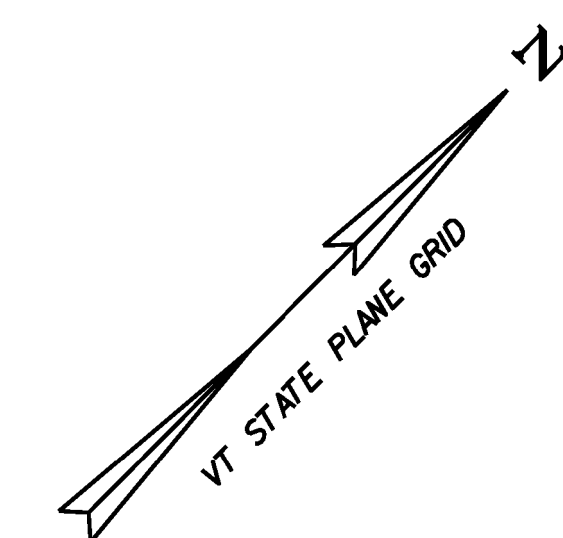

649.31 GEOTEXTILE UNDER STONE FILL
 WARREN:
 STA 225+50.0 - STA 227+00.0 LT (70.3 SY)
 STA 226+50.0 - STA 226+84.0 RT (26.8 SY)
 STA 230+00.0 - STA 231+00.0 RT (78.4 SY)

613.10 STONE FILL, TYPE I
 WARREN:
 STA 225+50.0 - STA 227+00.0 LT (13.1 CY)
 STA 226+50.0 - STA 226+84.0 RT (2.3 CY)
 STA 230+00.0 - STA 231+00.0 RT (19.2 CY)


621.80 REMOVAL AND DISPOSAL OF GUARDRAIL
 WARREN:
 STA 227+18.0 - STA 231+00.0 RT (382.0 LF)

651.40 GRUBBING MATERIAL
 WARREN:
 STA 225+50.0 - STA 226+50.0 RT (30.3 SY)
 STA 225+50.0 - STA 227+00.0 LT (36.9 SY)
 STA 226+50.0 - STA 226+84.0 RT (15.7 SY)
 STA 227+00.0 - STA 228+00.0 LT (38.1 SY)
 STA 230+00.0 - STA 231+00.0 RT (56.2 SY)

653.20 TEMPORARY EROSION MATTING
 WARREN:
 STA 225+50.0 - STA 226+50.0 RT (30.3 SY)
 STA 225+50.0 - STA 227+00.0 LT (36.9 SY)
 STA 226+50.0 - STA 226+84.0 RT (15.7 SY)
 STA 227+00.0 - STA 228+00.0 LT (38.1 SY)
 STA 230+00.0 - STA 231+00.0 RT (56.2 SY)

676.10 DELINEATOR WITH STEEL POST
 WARREN:
 STA 227+02.0 RT


900.640 SPECIAL PROVISION (BOX BEAM GUARDRAIL W/7 FEET POSTS)
 WARREN:
 STA 227+02.0 - STA 231+00.0 RT (398.0 LF)

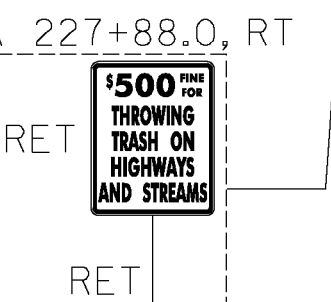

CURVE 20
 $\Delta = 52^\circ 21' 36''$
 $D = 3^\circ 32' 52''$
 $R = 1615.00'$
 $T = 793.98'$
 $L = 1475.87'$
 $E = 184.62'$
 $e = 0.059 \text{ FT/FT}$

CURVE 21
 $\Delta = 32^\circ 35' 58''$
 $D = 4^\circ 07' 19''$
 $R = 1390.00'$
 $T = 406.46'$
 $L = 790.86'$
 $E = 58.21'$
 $e = 0.065 \text{ FT/FT}$

SIGN LEGEND
 R = REMOVE
 S = SALVAGE
 N = NEW
 RET = RETAIN
 B-B = BACK TO BACK
 EXISTING = _____
 NEW = _____
 ⊙ = RETURN TO THE TOWN OF WARREN

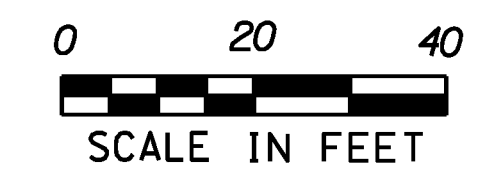

NOTE:
 1. PROVIDE A 4 FT WIDE, 1/2" TYPE IVS APRON FOR THE EXISTING GRAVEL PULLOUT AREA. ANY REQUIRED EXCAVATION SHALL BE PERFORMED AS DIRECTED BY THE ENGINEER AND PAID FOR UNDER ITEM 608.25 ALL PURPOSE EXCAVATOR RENTAL, TYPE I.

LEGEND
 ITEM 613.10 STONE FILL, TYPE I
 ITEM 653.20 TEMPORARY EROSION MATTING

PROJECT LAYOUT SHEET #34	PROJECT NAME: WARREN - WAITSFIELD	PLOT DATE: 12/20/2012
	PROJECT NUMBER: STP 2506(1)	DRAWN BY: W.G.P.
	FILE NAME: p05b048.dgn	CHECKED BY: D.E.G.
	DESIGNED BY: M.J.M.	SHEET 60 OF 310
	IPARM FILE: p05b048134.1	

FILE NAME = I:\17762\CADD\MSTN\STP_2506\p05b048_Contract_Plane.dgn
 DATE/TIME = 12/20/2012
 USER = 4866