
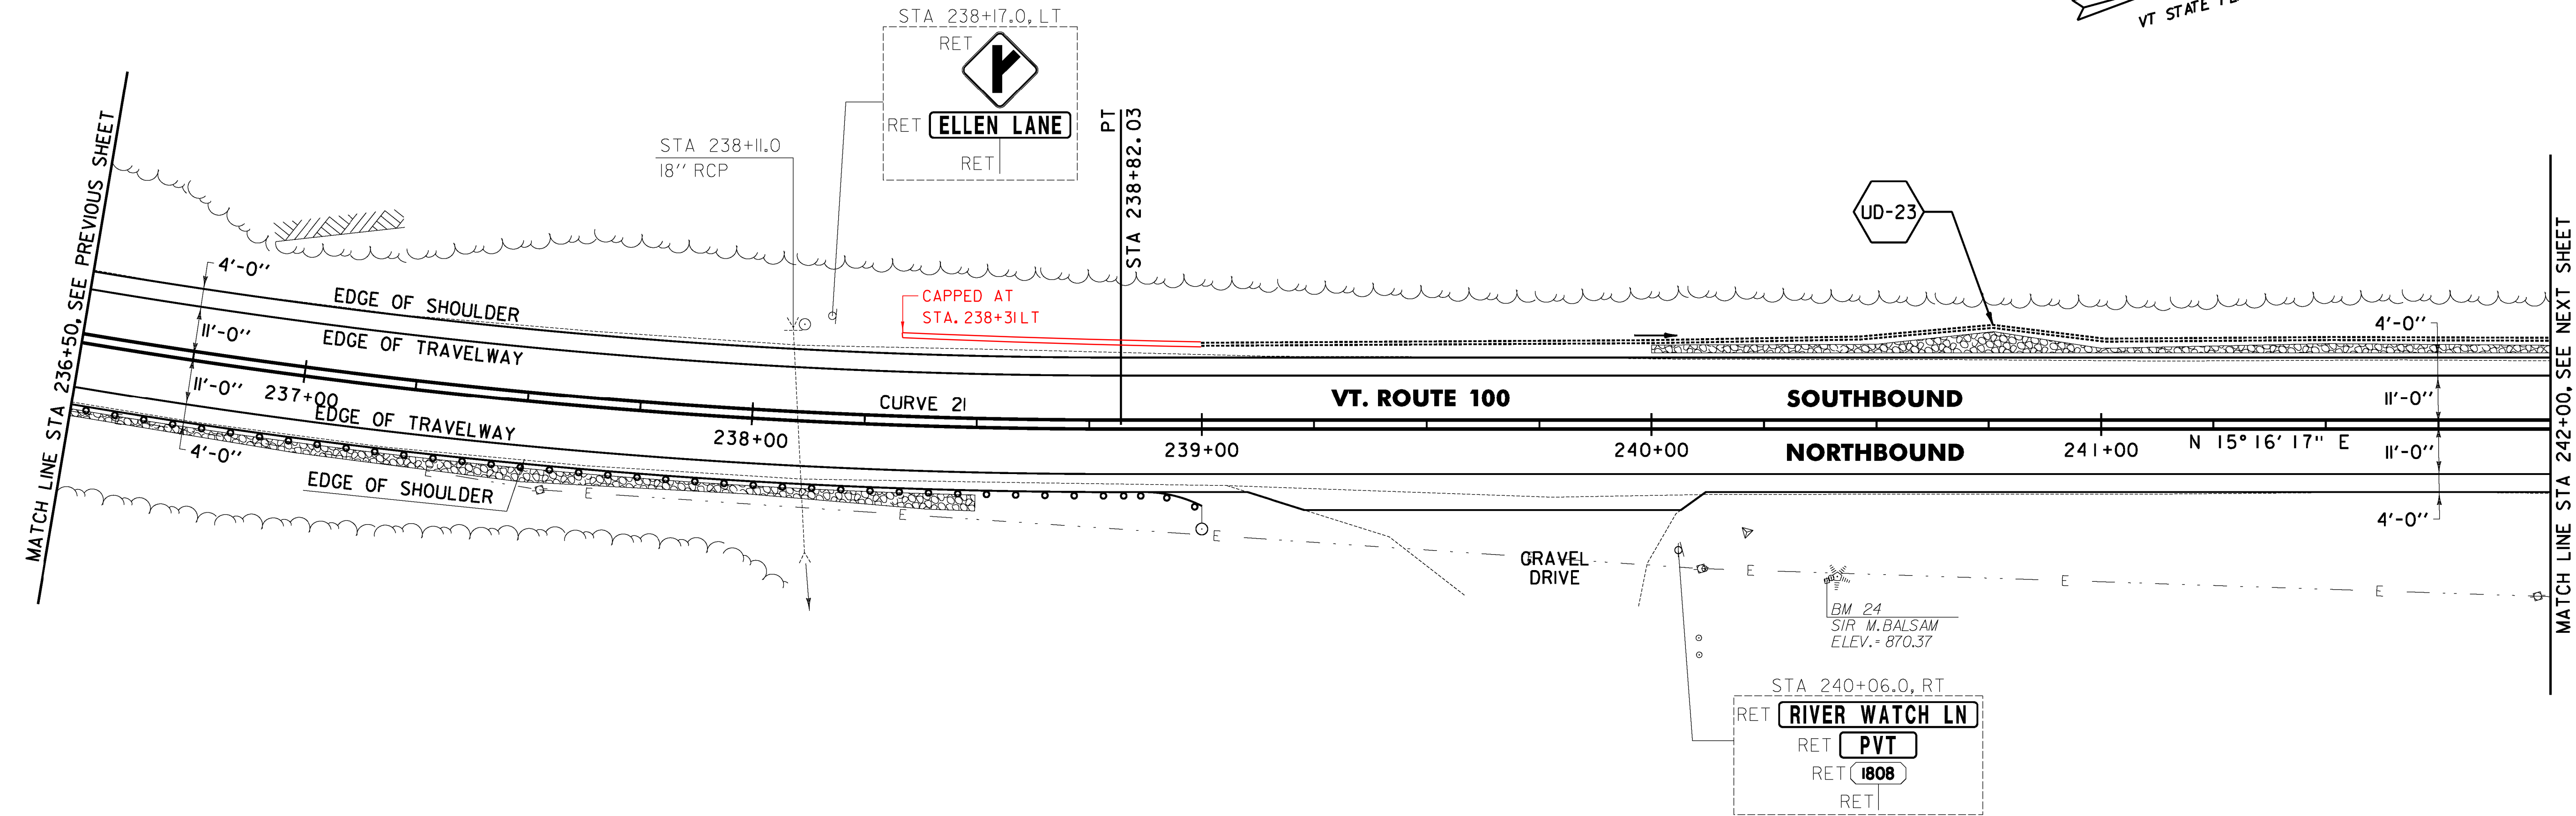


646.402 DURABLE 4 INCH WHITE LINE, THERMOPLASTIC OR  
 646.403 DURABLE 4 INCH WHITE LINE, EPOXY PAINT OR  
 646.404 DURABLE 4 INCH WHITE LINE, POLYUREA  
 (ALL LINES WILL INCLUDE EDGE LINE BREAKS AND  
 RADII FOR TOWN HIGHWAYS)  
 WARREN:  
 STA 236+50.00 - STA 242+00.00 LT & RT

646.412 DURABLE 4 INCH YELLOW LINE, THERMOPLASTIC OR  
 646.413 DURABLE 4 INCH YELLOW LINE, EPOXY PAINT OR  
 646.414 DURABLE 4 INCH YELLOW LINE, POLYUREA  
 (ALL LINES WILL INCLUDE C/L BREAKS FOR  
 TOWN HIGHWAYS) S=SOLID, D=DASHED  
 WARREN:  
 STA 236+50.00 - STA 242+00.00 LT C RT  
 S - S

646.602 TEMPORARY 4 INCH WHITE LINE, PAINT  
 (ALL LINES WILL INCLUDE EDGE LINE BREAKS AND  
 RADII FOR TOWN HIGHWAYS)  
 WARREN:  
 STA 236+50.00 - STA 242+00.00 LT & RT

646.612 TEMPORARY 4 INCH YELLOW LINE, PAINT  
 (ALL LINES WILL INCLUDE C/L BREAKS FOR  
 TOWN HIGHWAYS) S=SOLID, D=DASHED  
 WARREN:  
 STA 236+50.00 - STA 242+00.00 LT C RT  
 S - S

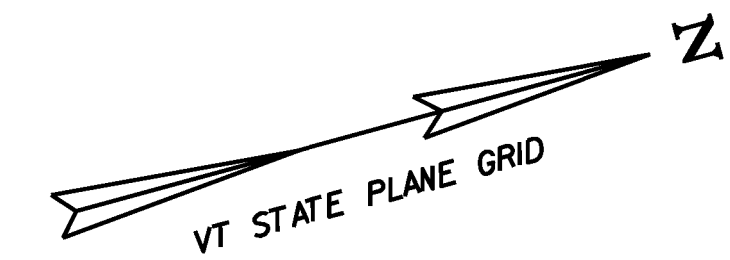

649.31 GEOTEXTILE UNDER STONE FILL  
 WARREN:  
 STA 236+50.0 - STA 238+50.0 RT (14.5 SY)  
 STA 240+00.0 - STA 242+00.0 LT (91.7 SY)

613.10 STONE FILL, TYPE I  
 WARREN:  
 STA 236+50.0 - STA 238+50.0 RT (24.3 CY)  
 STA 240+00.0 - STA 242+00.0 LT (16.7 CY)

621.80 REMOVAL AND DISPOSAL OF GUARDRAIL  
 WARREN:  
 STA 236+50.0 - STA 238+95.0 RT (245.0 LF)

651.40 GRUBBING MATERIAL  
 WARREN:  
 STA 236+50.0 - STA 238+50.0 RT (70.1 SY)  
 STA 240+00.0 - STA 242+00.0 LT (47.3 SY)


653.20 TEMPORARY EROSION MATTING  
 WARREN:  
 STA 236+50.0 - STA 238+50.0 RT (70.1 SY)  
 STA 240+00.0 - STA 242+00.0 LT (47.3 SY)



676.10 DELINEATOR WITH STEEL POST  
 WARREN:  
 STA 239+00.0 RT

900.640 SPECIAL PROVISION (BOX BEAM GUARDRAIL W/7 FEET POSTS)  
 WARREN:  
 STA 236+50.0 - STA 239+00.0 RT (250.0 LF)

CURVE 21  
 $\Delta = 32^{\circ} 35' 58''$   
 $D = 4^{\circ} 07' 19''$   
 $R = 1390.00'$   
 $T = 406.46'$   
 $L = 790.86'$   
 $E = 58.21'$   
 $e = 0.065 \text{ FT/FT}$

SIGN LEGEND  
 R = REMOVE  
 S = SALVAGE  
 N = NEW  
 RET = RETAIN  
 B-B = BACK TO BACK  
 EXISTING = \_\_\_\_\_  
 NEW = \_\_\_\_\_  
 ⊙ = RETURN TO THE TOWN OF WARREN

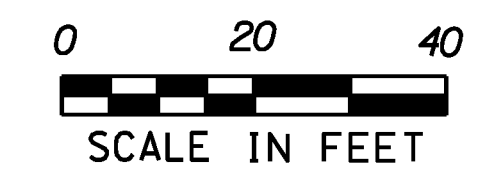

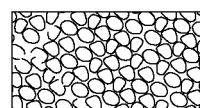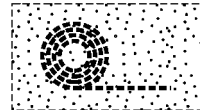LEGEND  
 ITEM 613.10 STONE FILL, TYPE I  
 ITEM 653.20 TEMPORARY EROSION MATTING

<b>PROJECT LAYOUT SHEET #36</b>	PROJECT NAME: WARREN - WAITSFIELD	PLOT DATE: 12/20/2012
	PROJECT NUMBER: STP 2506(1)	DRAWN BY: W.G.P.
	FILE NAME: p05b048.dgn	CHECKED BY: D.E.G.
	DESIGNED BY: M.J.M.	SHEET 62 OF 310
	IPARM FILE: p05b048i36.1	

FILE NAME = I:\17762\CADD\MSTN\STP 2506\p05b048.dgn  
 DATE/TIME = 12/20/2012  
 USER = 4866