



646.402 DURABLE 4 INCH WHITE LINE, THERMOPLASTIC OR
 646.403 DURABLE 4 INCH WHITE LINE, EPOXY PAINT OR
 646.404 DURABLE 4 INCH WHITE LINE, POLYUREA
 (ALL LINES WILL INCLUDE EDGE LINE BREAKS AND
 RADII FOR TOWN HIGHWAYS)
 WARREN:
 STA 242+00.00 - STA 247+50.00 LT & RT

646.412 DURABLE 4 INCH YELLOW LINE, THERMOPLASTIC OR
 646.413 DURABLE 4 INCH YELLOW LINE, EPOXY PAINT OR
 646.414 DURABLE 4 INCH YELLOW LINE, POLYUREA
 (ALL LINES WILL INCLUDE C/L BREAKS FOR
 TOWN HIGHWAYS) S=SOLID, D=DASHED
 WARREN:
 STA 242+00.00 - STA 247+50.00 LT C RT
 S - S

646.602 TEMPORARY 4 INCH WHITE LINE, PAINT
 (ALL LINES WILL INCLUDE EDGE LINE BREAKS AND
 RADII FOR TOWN HIGHWAYS)
 WARREN:
 STA 242+00.00 - STA 247+50.00 LT & RT

646.612 TEMPORARY 4 INCH YELLOW LINE, PAINT
 (ALL LINES WILL INCLUDE C/L BREAKS FOR
 TOWN HIGHWAYS) S=SOLID, D=DASHED
 WARREN:
 STA 242+00.00 - STA 247+50.00 LT C RT
 S - S

675.50 REMOVING SIGNS
 AS SHOWN - 1

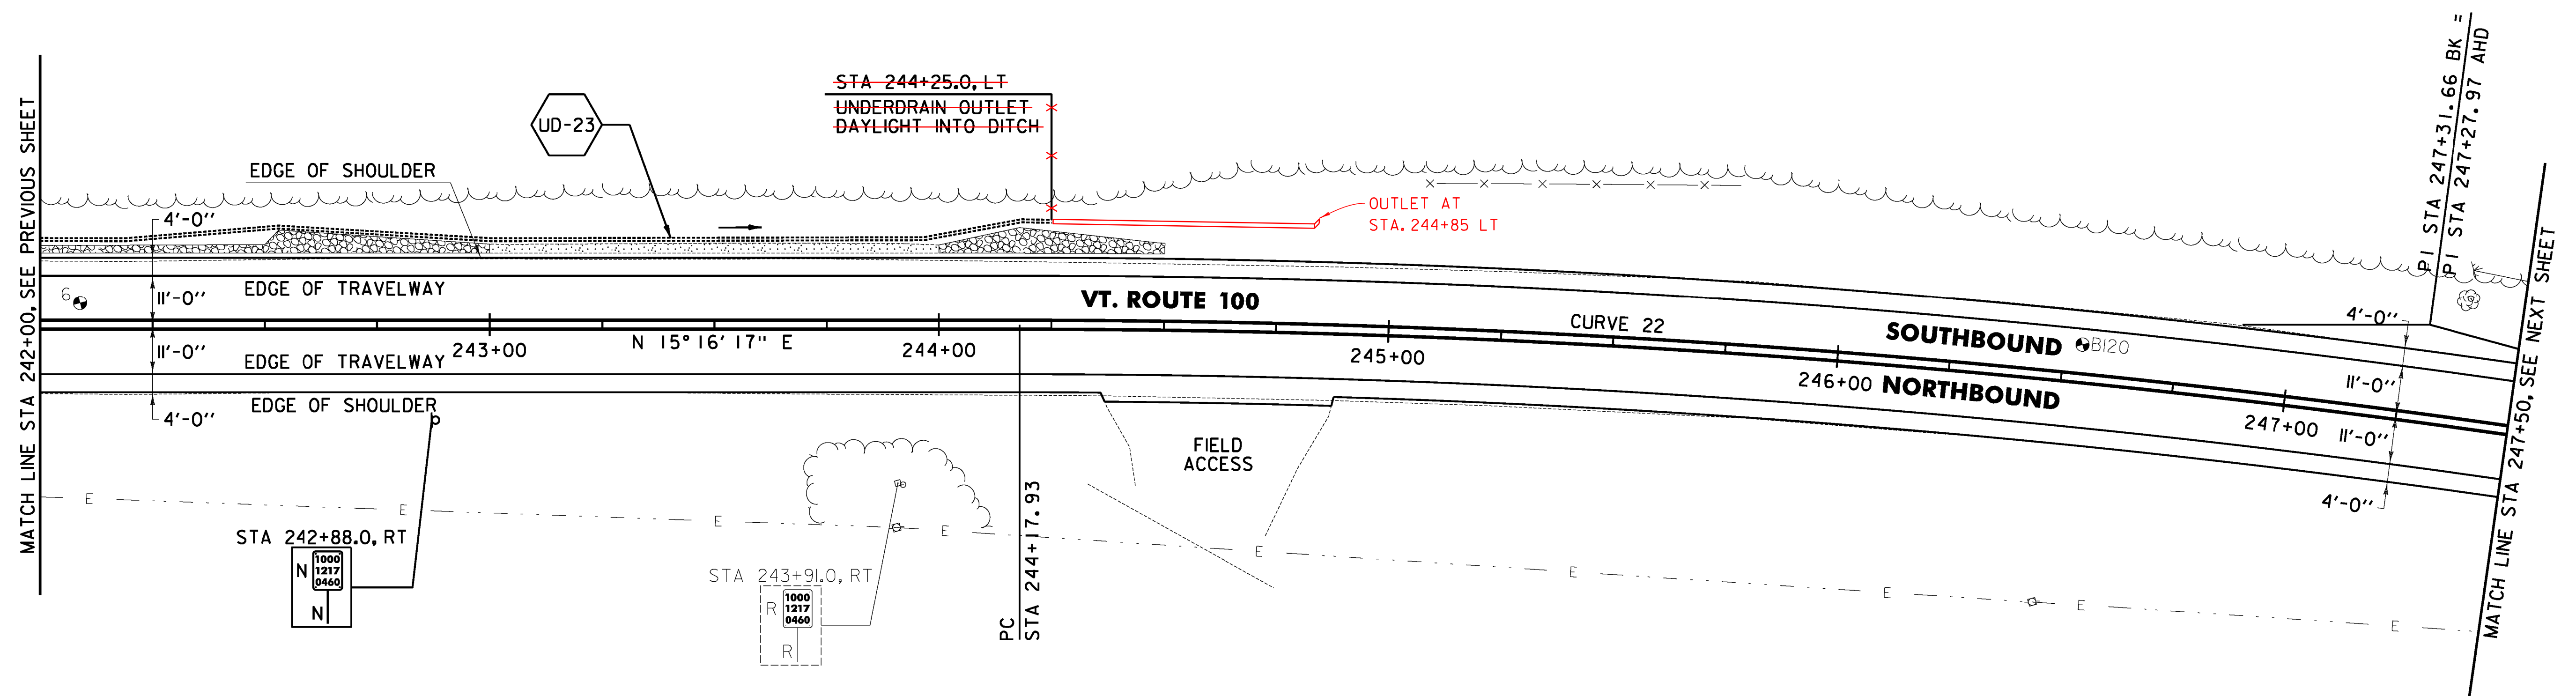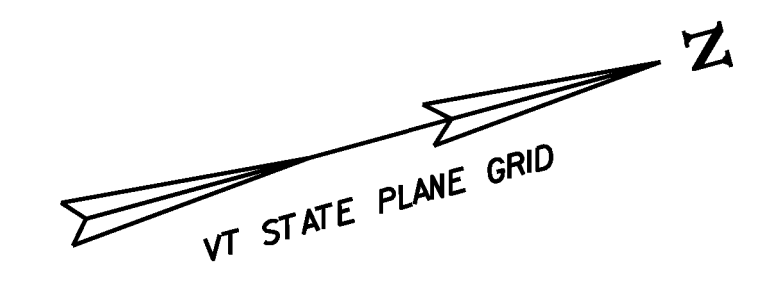

PAVEMENT CORING DATA			
CORE #	DEPTH (IN.)	PCC	COMMENTS
6	7.0	NO	

SOIL BORING DATA			
BORING #	DEPTH (FT.)	PCC	COMMENTS
B120	5.0	NO	

649.31 GEOTEXTILE UNDER STONE FILL
 WARREN:
 STA 242+00.0 - STA 243+00.0 LT (48.5 SY)
 STA 244+00.0 - STA 244+50.0 RT (24.8 SY)


613.10 STONE FILL, TYPE I
 WARREN:
 STA 242+00.0 - STA 243+00.0 LT (9.3 CY)
 STA 244+00.0 - STA 244+50.0 LT (2.2 CY)


651.40 GRUBBING MATERIAL
 WARREN:
 STA 242+00.0 - STA 243+00.0 LT (26.3 SY)
 STA 243+00.0 - STA 244+00.0 LT (27.7 SY)
 STA 244+00.0 - STA 244+50.0 LT (13.7 SY)


653.20 TEMPORARY EROSION MATTING
 WARREN:
 STA 242+00.0 - STA 243+00.0 LT (26.3 SY)
 STA 243+00.0 - STA 244+00.0 LT (27.7 SY)
 STA 244+00.0 - STA 244+50.0 LT (13.7 SY)

CURVE 22
 $\Delta = 15^\circ 12' 29''$
 $D = 2^\circ 26' 17''$
 $R = 2350.00'$
 $T = 313.73'$
 $L = 623.76'$
 $E = 20.85'$
 $e = 0.046 \text{ FT/FT}$

LEGEND

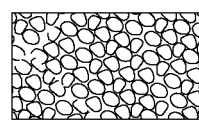 ITEM 613.10 STONE FILL, TYPE I

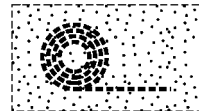 ITEM 653.20 TEMPORARY EROSION MATTING

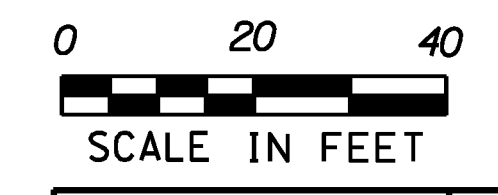

SIGN LEGEND
 R = REMOVE
 S = SALVAGE
 N = NEW
 RET = RETAIN
 B-B = BACK TO BACK
 EXISTING = _____
 NEW = _____
 ⊙ = RETURN TO THE TOWN OF WARREN

PROJECT LAYOUT SHEET #37	PROJECT NAME: WARREN - WAITSFIELD	PLOT DATE: 12/20/2012
	PROJECT NUMBER: STP 2506(1)	DRAWN BY: W.G.P.
	FILE NAME: p05b048.dgn	CHECKED BY: D.E.G.
	PROJECT LEADER: D.E.G.	SHEET 63 OF 310

DESIGNED BY: M.J.M.
 IPARM FILE: p05b048137.1

FILE NAME = I:\17762\CADD\MSTN\STP_2506\p05b048_Contract_Plan.dgn
 DATE/TIME = 12/20/2012 4:06:56 PM
 USER = 4866