
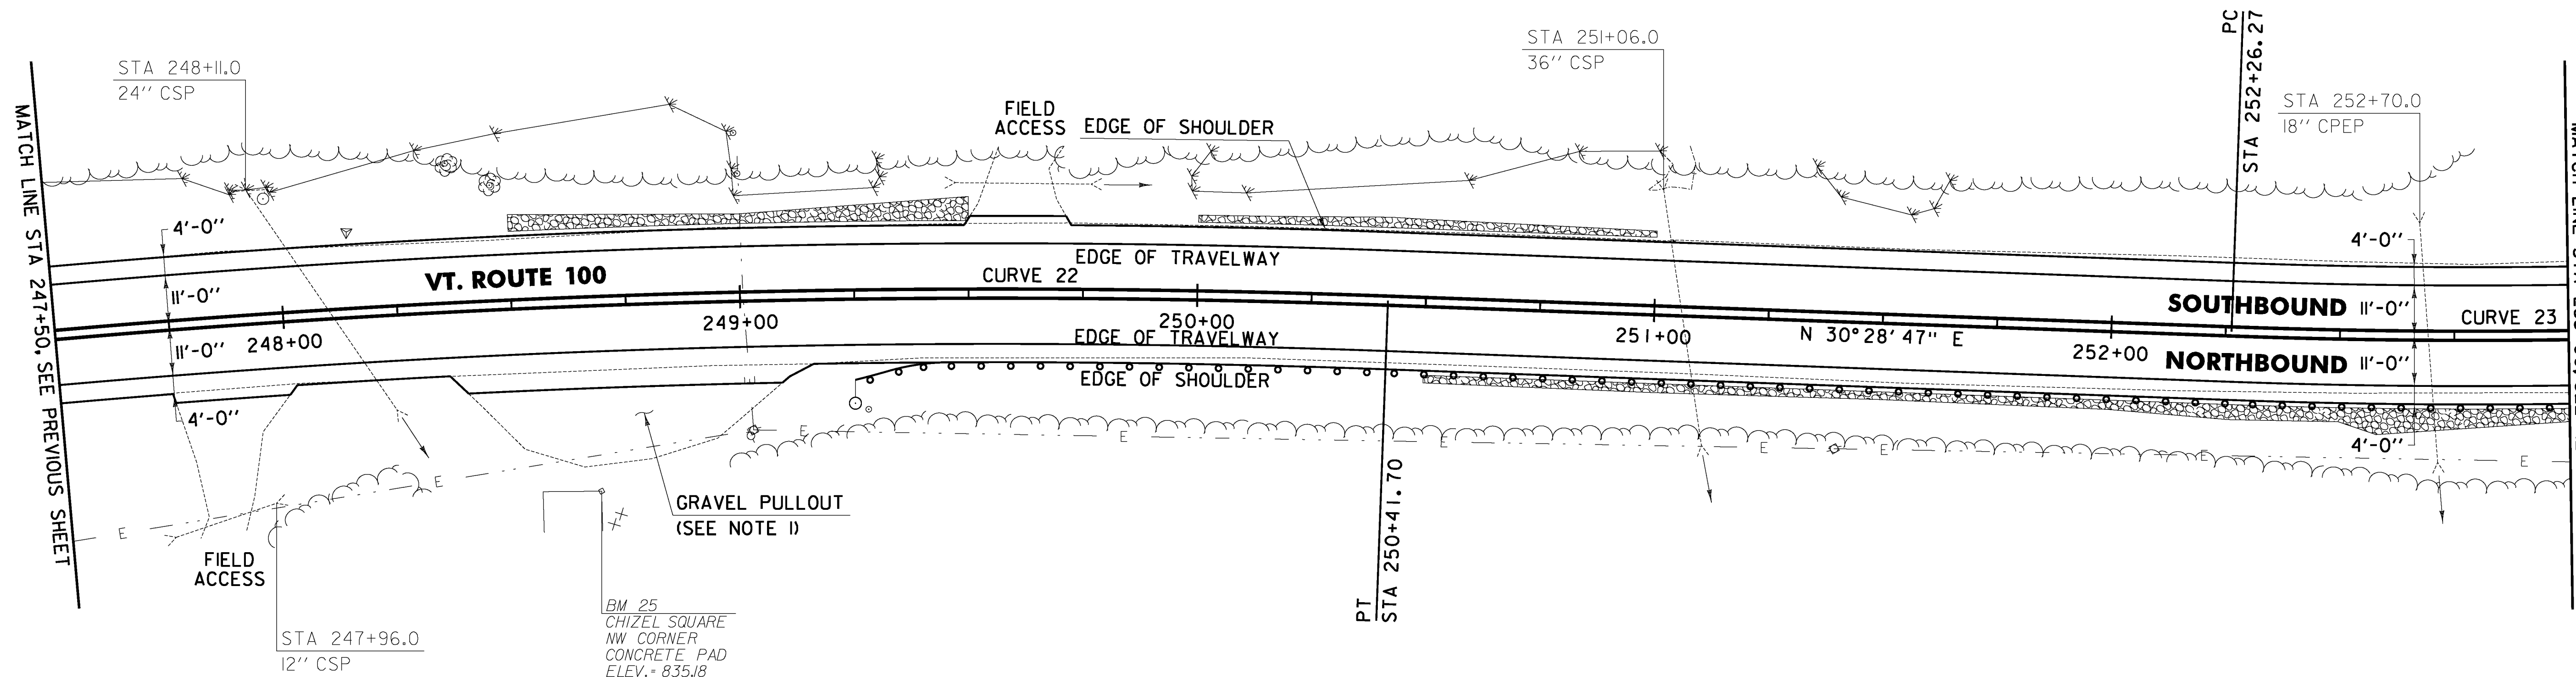


646.402 DURABLE 4 INCH WHITE LINE, THERMOPLASTIC OR  
 646.403 DURABLE 4 INCH WHITE LINE, EPOXY PAINT OR  
 646.404 DURABLE 4 INCH WHITE LINE, POLYUREA  
 (ALL LINES WILL INCLUDE EDGE LINE BREAKS AND  
 RADII FOR TOWN HIGHWAYS)  
 WARREN:  
 STA 247+50.00 - STA 253+00.00 LT & RT

646.412 DURABLE 4 INCH YELLOW LINE, THERMOPLASTIC OR  
 646.413 DURABLE 4 INCH YELLOW LINE, EPOXY PAINT OR  
 646.414 DURABLE 4 INCH YELLOW LINE, POLYUREA  
 (ALL LINES WILL INCLUDE C/L BREAKS FOR  
 TOWN HIGHWAYS) S=SOLID, D=DASHED  
 WARREN:  
 STA 247+50.00 - STA 253+00.00 LT C RT  
 S - S

646.602 TEMPORARY 4 INCH WHITE LINE, PAINT  
 (ALL LINES WILL INCLUDE EDGE LINE BREAKS AND  
 RADII FOR TOWN HIGHWAYS)  
 WARREN:  
 STA 247+50.00 - STA 253+00.00 LT & RT

646.612 TEMPORARY 4 INCH YELLOW LINE, PAINT  
 (ALL LINES WILL INCLUDE C/L BREAKS FOR  
 TOWN HIGHWAYS) S=SOLID, D=DASHED  
 WARREN:  
 STA 247+50.00 - STA 253+00.00 LT C RT  
 S - S

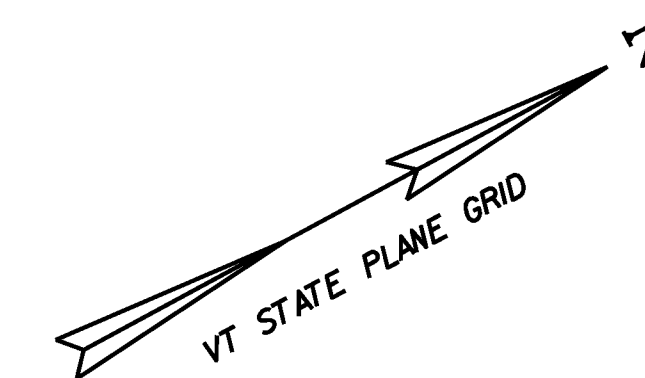

NOTE:

- PROVIDE A 4 FT WIDE, 1/2" TYPE IVS APRON FOR THE EXISTING GRAVEL PULLOUT AREA. ANY REQUIRED EXCAVATION SHALL BE PERFORMED AS DIRECTED BY THE ENGINEER AND PAID FOR UNDER ITEM 608.25 ALL PURPOSE EXCAVATOR RENTAL, TYPE I.

613.10 STONE FILL, TYPE I

WARREN:  
 STA 248+50.0 - STA 249+50.0 LT (5.0 CY)  
 STA 250+00.0 - STA 251+00.0 LT (8.9 CY)  
 STA 250+50.0 - STA 253+00.0 RT (28.0 CY)

621.80 REMOVAL AND DISPOSAL OF GUARDRAIL

WARREN:  
 STA 249+40.0 - STA 253+00.0 RT (360.0 LF)

651.40 GRUBBING MATERIAL

WARREN:  
 STA 248+50.0 - STA 249+50.0 LT (40.6 SY)  
 STA 250+00.0 - STA 251+00.0 LT (25.3 SY)  
 STA 250+50.0 - STA 253+00.0 RT (80.4 SY)

653.20 TEMPORARY EROSION MATTING

WARREN:  
 STA 248+50.0 - STA 249+50.0 LT (40.6 SY)  
 STA 250+00.0 - STA 251+00.0 LT (25.3 SY)  
 STA 250+50.0 - STA 253+00.0 RT (80.4 SY)

676.10 DELINEATOR WITH STEEL POST

WARREN:  
 STA 249+25.0 RT

649.31 GEOTEXTILE UNDER STONE FILL

WARREN:  
 STA 248+50.0 - STA 249+50.0 LT (62.8 SY)  
 STA 250+00.0 - STA 251+00.0 LT (47.5 SY)  
 STA 250+50.0 - STA 253+00.0 RT (136.0 SY)

900.640 SPECIAL PROVISION (BOX BEAM GUARDRAIL W/7 FEET POSTS)

WARREN:  
 STA 249+25.0 - STA 253+00.0 RT (375.0 LF)

CURVE 22

$\Delta = 15^\circ 12' 29''$   
 $D = 2^\circ 26' 17''$   
 $R = 2350.00'$   
 $T = 313.73'$   
 $L = 623.76'$   
 $E = 20.85'$   
 $e = 0.046 \text{ FT/FT}$

CURVE 23

$\Delta = 14^\circ 07' 25''$   
 $D = 3^\circ 57' 05''$   
 $R = 1450.00'$   
 $T = 179.63'$   
 $L = 357.43'$   
 $E = 11.08'$   
 $e = 0.063 \text{ FT/FT}$

SIGN LEGEND

R = REMOVE  
 S = SALVAGE  
 N = NEW  
 RET = RETAIN  
 B-B = BACK TO BACK  
 EXISTING = -----  
 NEW = -----  
 ⊙ = RETURN TO THE TOWN OF WARREN

LEGEND

- ITEM 613.10 STONE FILL, TYPE I
- ITEM 653.20 TEMPORARY EROSION MATTING



PROJECT LAYOUT SHEET #38

PROJECT NAME: WARREN - WAITSFIELD

PROJECT NUMBER: STP 2506(1)

FILE NAME: p05b048.dgn

PROJECT LEADER: D.E.G.

DESIGNED BY: M.J.M.

IPARM FILE: p05b048i38.i

PLOT DATE: 12/20/2012

DRAWN BY: W.G.P.

CHECKED BY: D.E.G.

SHEET 64 OF 310