

646.402 DURABLE 4 INCH WHITE LINE, THERMOPLASTIC OR
 646.403 DURABLE 4 INCH WHITE LINE, EPOXY PAINT OR
 646.404 DURABLE 4 INCH WHITE LINE, POLYUREA
 (ALL LINES WILL INCLUDE EDGE LINE BREAKS AND
 RADII FOR TOWN HIGHWAYS)
 WARREN:
 STA 316+68.00 - STA 319+00.00 LT & RT



646.412 DURABLE 4 INCH YELLOW LINE, THERMOPLASTIC OR
 646.413 DURABLE 4 INCH YELLOW LINE, EPOXY PAINT OR
 646.414 DURABLE 4 INCH YELLOW LINE, POLYUREA
 (ALL LINES WILL INCLUDE C/L BREAKS FOR
 TOWN HIGHWAYS) S=SOLID, D=DASHED
 WARREN:
 STA 316+68.00 - STA 319+00.00 LT CL RT
 S - S

646.602 TEMPORARY 4 INCH WHITE LINE, PAINT
 (ALL LINES WILL INCLUDE EDGE LINE BREAKS AND
 RADII FOR TOWN HIGHWAYS)
 WARREN:
 STA 316+68.00 - STA 319+00.00 LT & RT

646.612 TEMPORARY 4 INCH YELLOW LINE, PAINT
 (ALL LINES WILL INCLUDE C/L BREAKS FOR
 TOWN HIGHWAYS) S=SOLID, D=DASHED
 WARREN:
 STA 316+68.00 - STA 319+00.00 LT CL RT
 S - S


675.50 REMOVING SIGNS
 AS SHOWN - 1

675.60 ERECTING SALVAGED SIGNS
 AS SHOWN - 2

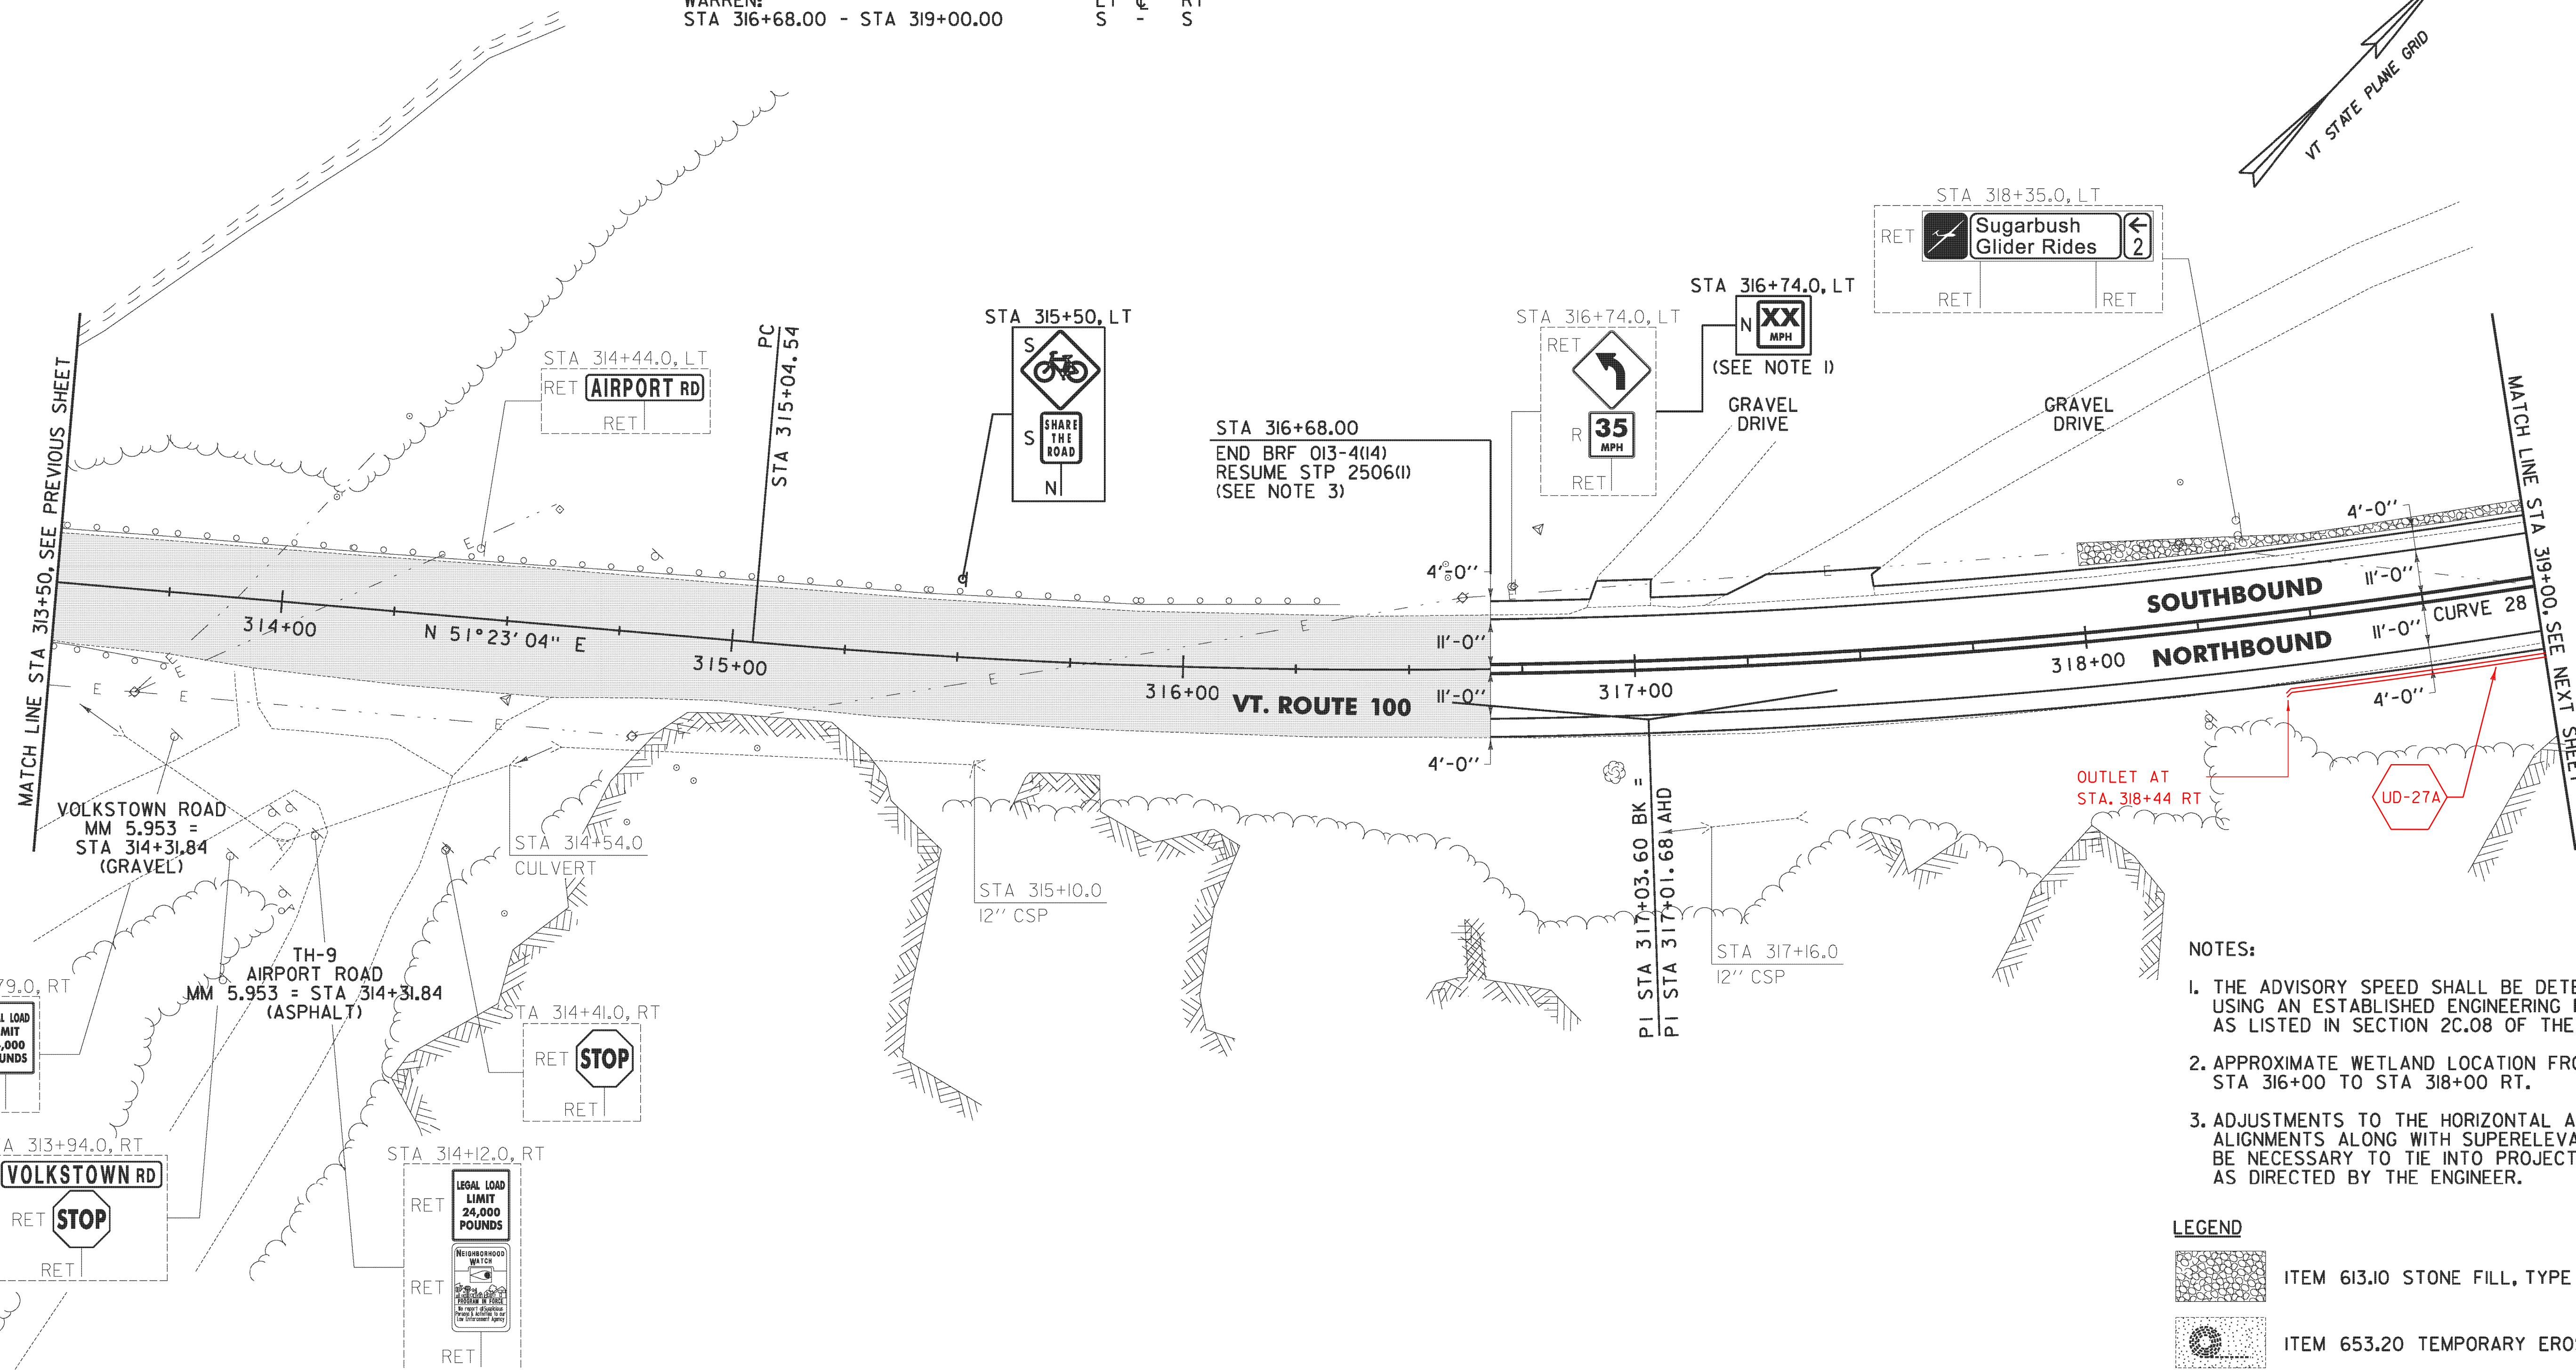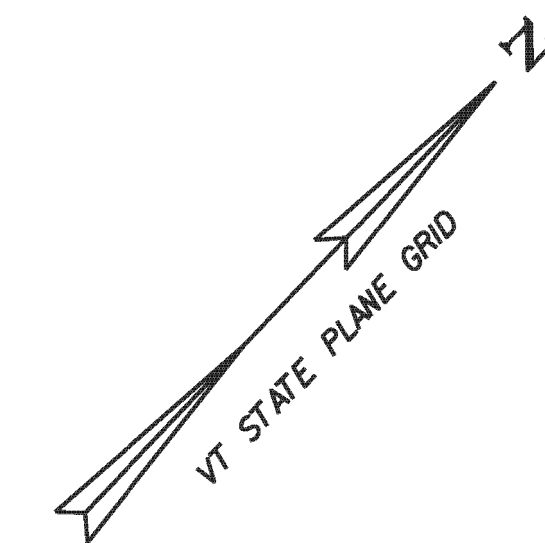

- NOTES:
1. THE ADVISORY SPEED SHALL BE DETERMINED USING AN ESTABLISHED ENGINEERING PRACTICE AS LISTED IN SECTION 2C.08 OF THE MUTCD.
 2. APPROXIMATE WETLAND LOCATION FROM STA 316+00 TO STA 318+00 RT.
 3. ADJUSTMENTS TO THE HORIZONTAL AND VERTICAL ALIGNMENTS ALONG WITH SUPERELEVATION MAY BE NECESSARY TO TIE INTO PROJECT BRF 013-4(14) AS DIRECTED BY THE ENGINEER.

- LEGEND
- ITEM 613.10 STONE FILL, TYPE I
 - ITEM 653.20 TEMPORARY EROSION MATTING
 - NO PAVING WORK TO BE PERFORMED IN THIS AREA UNDER STP 2506(1)

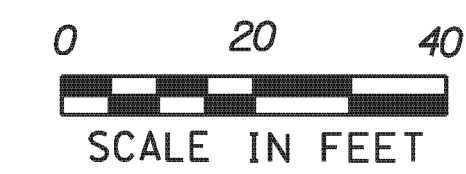

613.10 STONE FILL, TYPE I
 WARREN:
 STA 318+00.0 - STA 319+00.0 LT (4.8 CY)

651.40 GRUBBING MATERIAL
 WARREN:
 STA 318+00.0 - STA 319+00.0 LT (43.0 SY)

653.20 TEMPORARY EROSION MATTING
 WARREN:
 STA 318+00.0 - STA 319+00.0 LT (43.0 SY)

649.31 GEOTEXTILE UNDER STONE FILL
 WARREN:
 STA 318+00.0 - STA 319+00.0 LT (65.2 SY)

CURVE 28
 $\Delta = 13^\circ 45' 28''$
 $D = 3^\circ 28' 21''$
 $R = 1650.00'$
 $T = 199.06'$
 $L = 396.20'$
 $E = 11.96'$
 $e = 0.058 \text{ FT/FT}$

SIGN LEGEND
 R = REMOVE
 S = SALVAGE
 N = NEW
 RET = RETAIN
 B-B = BACK TO BACK
 EXISTING = _____
 NEW = _____
 ⊙ = RETURN TO THE TOWN OF WARREN

PROJECT LAYOUT SHEET #50	PROJECT NAME: WARREN - WAITSFIELD	PLOT DATE: 12/20/2012
	PROJECT NUMBER: STP 2506(1)	DRAWN BY: W.G.P.
	FILE NAME: p05b048.dgn PROJECT LEADER: D.E.G. DESIGNED BY: M.J.M. IPARM FILE: p05b048i50.1	CHECKED BY: D.E.G. SHEET 76 OF 310

FILE NAME = I:\17762\CADD\MSTN\STP_2506\p05b048_Contract_Plan.dgn
DATE/TIME = 12/20/2012
USER = 4066