


646.402 DURABLE 4 INCH WHITE LINE, THERMOPLASTIC OR
 646.403 DURABLE 4 INCH WHITE LINE, EPOXY PAINT OR
 646.404 DURABLE 4 INCH WHITE LINE, POLYUREA
 (ALL LINES WILL INCLUDE EDGE LINE BREAKS AND
 RADII FOR TOWN HIGHWAYS)
 WARREN:
 STA 330+00.00 - STA 335+17.05 LT & RT
 WAITSFIELD:
 STA 0+00.00 - STA 0+50.00 LT & RT


646.412 DURABLE 4 INCH YELLOW LINE, THERMOPLASTIC OR
 646.413 DURABLE 4 INCH YELLOW LINE, EPOXY PAINT OR
 646.414 DURABLE 4 INCH YELLOW LINE, POLYUREA
 (ALL LINES WILL INCLUDE C/L BREAKS FOR
 TOWN HIGHWAYS) S=SOLID, D=DASHED
 WARREN:
 STA 330+00.00 - STA 331+60.00 S - D
 STA 331+60.00 - STA 335+17.05 S - S
 WAITSFIELD:
 STA 0+00.00 - STA 0+50.00 S - S

646.602 TEMPORARY 4 INCH WHITE LINE, PAINT
 (ALL LINES WILL INCLUDE EDGE LINE BREAKS AND
 RADII FOR TOWN HIGHWAYS)
 WARREN:
 STA 330+00.00 - STA 335+17.05 LT & RT
 WAITSFIELD:
 STA 0+00.00 - STA 0+50.00 LT & RT

646.612 TEMPORARY 4 INCH YELLOW LINE, PAINT
 (ALL LINES WILL INCLUDE C/L BREAKS FOR
 TOWN HIGHWAYS) S=SOLID, D=DASHED
 WARREN:
 STA 330+00.00 - STA 331+60.00 LT S RT D
 STA 331+60.00 - STA 335+17.05 S S
 WAITSFIELD:
 STA 0+00.00 - STA 0+50.00 S S

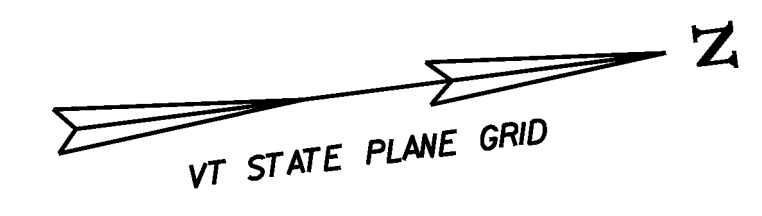

WARREN
 MM 6.348 = STA 335+17.05 =
 WAITSFIELD
 MM 0.000 = STA 0+00.00

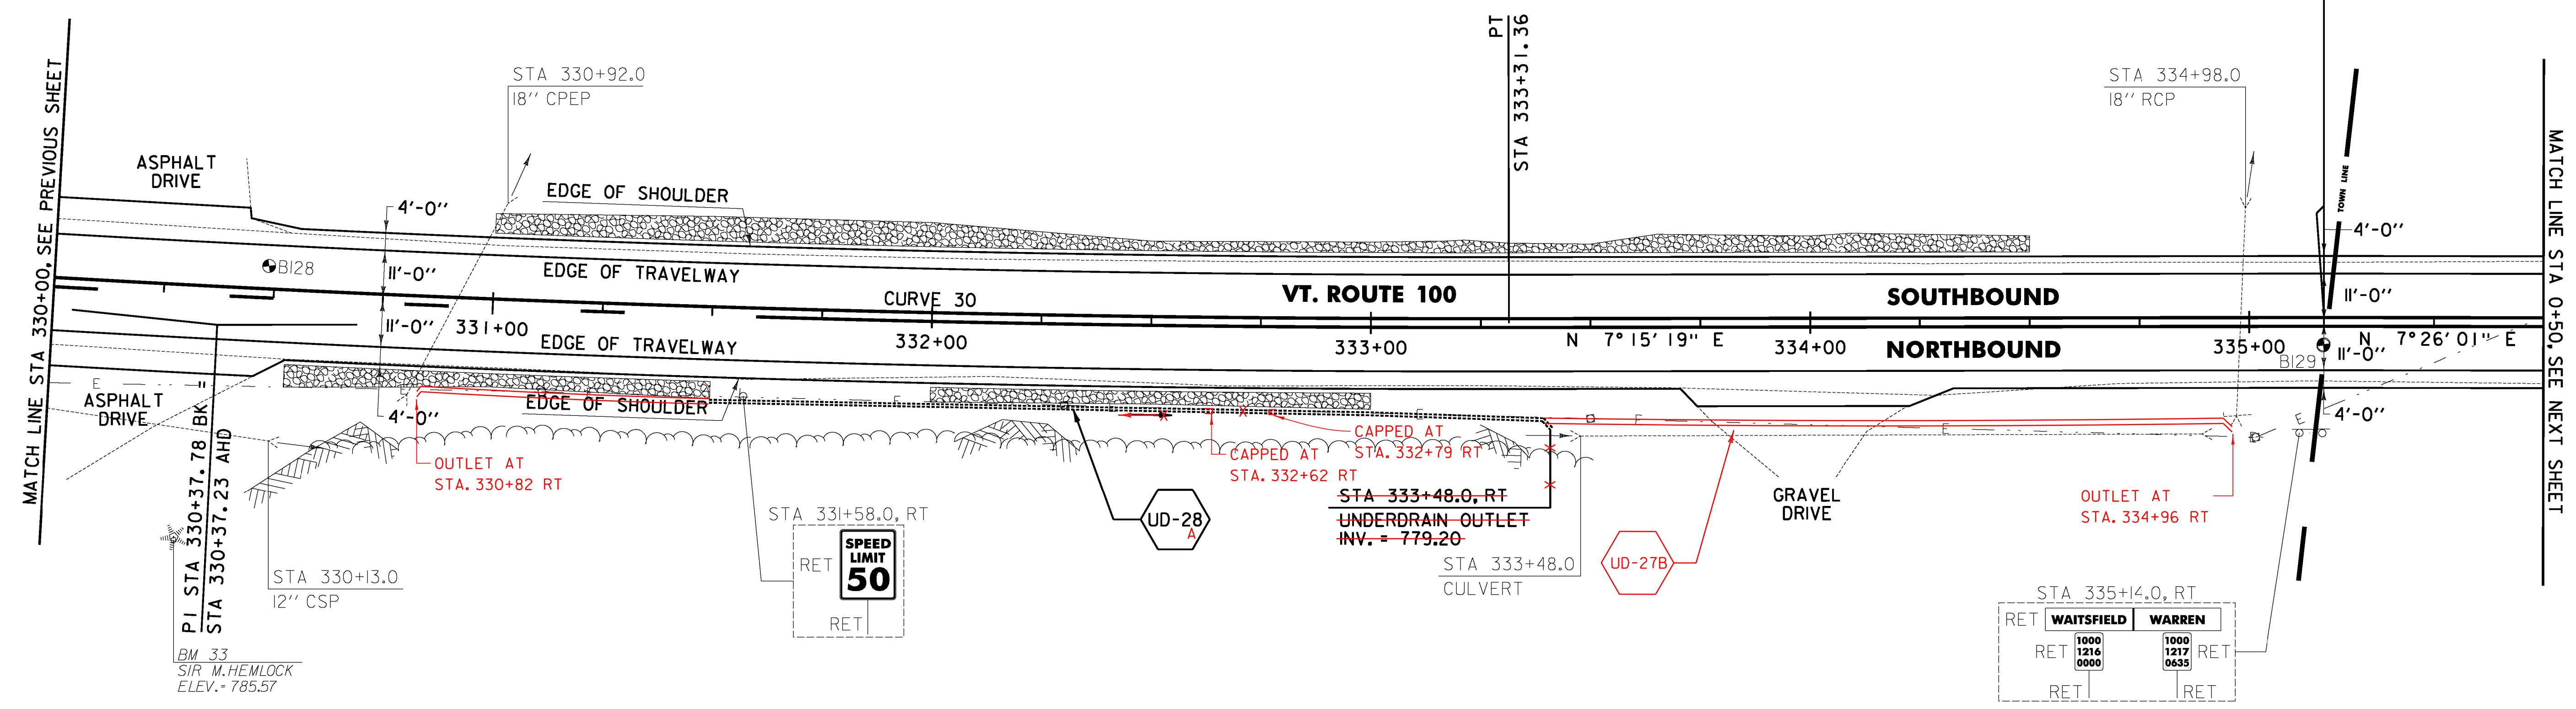

613.10 STONE FILL, TYPE I
 WARREN:
 STA 330+53.0 - STA 331+50.0 RT (6.9 CY)
 STA 331+00.0 - STA 334+50.0 LT (59.0 CY)
 STA 332+00.0 - STA 333+00.0 RT (15.2 CY)

651.40 GRUBBING MATERIAL
 WARREN:
 STA 330+53.0 - STA 331+50.0 RT (20.0 SY)
 STA 331+00.0 - STA 334+50.0 LT (172.0 SY)
 STA 332+00.0 - STA 333+00.0 RT (44.1 SY)

653.20 TEMPORARY EROSION MATTING
 WARREN:
 STA 330+53.0 - STA 331+50.0 RT (20.0 SY)
 STA 331+00.0 - STA 334+50.0 LT (172.0 SY)
 STA 332+00.0 - STA 333+00.0 RT (44.1 SY)


649.31 GEOTEXTILE UNDER STONE FILL
 WARREN:
 STA 330+53.0 - STA 331+50.0 RT (69.5 SY)
 STA 331+00.0 - STA 334+50.0 LT (249.8 SY)
 STA 332+00.0 - STA 333+00.0 RT (66.3 SY)

SOIL BORING DATA			
BORING #	DEPTH (FT.)	PCC	COMMENTS
BI28	5.0	NO	
BI29	5.0	NO	

CURVE 30
 $\Delta = 6^{\circ}02'31''$
 $D = 1^{\circ}01'41''$
 $R = 5573.25'$
 $T = 294.13'$
 $L = 587.71'$
 $E = 7.76'$
 $e = 0.022 \text{ FT/FT}$

SIGN LEGEND
 R = REMOVE
 S = SALVAGE
 N = NEW
 RET = RETAIN
 B-B = BACK TO BACK
 EXISTING = _____
 NEW = _____
 ⊙ = RETURN TO THE TOWN OF WARREN

LEGEND
 ITEM 613.10 STONE FILL, TYPE I
 ITEM 653.20 TEMPORARY EROSION MATTING

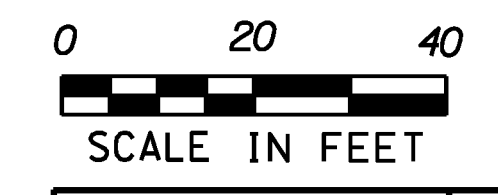

PROJECT LAYOUT SHEET #53	PROJECT NAME: WARREN - WAITSFIELD	PLOT DATE: 12/20/2012
	PROJECT NUMBER: STP 2506(1)	DRAWN BY: W.G.P.
	FILE NAME: p05b048.dgn PROJECT LEADER: D.E.G. DESIGNED BY: M.J.M. IPARM FILE: p05b048i53.i	CHECKED BY: D.E.G. SHEET 79 OF 310

FILE NAME = I:\17762\CADD\MSTN\STP 2506\p05b048.Centrect Plans.dgn
 DATE/TIME = 12/20/2012
 USER = 4866