

646.402 DURABLE 4 INCH WHITE LINE, THERMOPLASTIC OR
 646.403 DURABLE 4 INCH WHITE LINE, EPOXY PAINT OR
 646.404 DURABLE 4 INCH WHITE LINE, POLYUREA
 (ALL LINES WILL INCLUDE EDGE LINE BREAKS AND
 RADII FOR TOWN HIGHWAYS)
 WAITSFIELD:
 STA 17+00.00 - STA 22+50.00 LT & RT

646.412 DURABLE 4 INCH YELLOW LINE, THERMOPLASTIC OR
 646.413 DURABLE 4 INCH YELLOW LINE, EPOXY PAINT OR
 646.414 DURABLE 4 INCH YELLOW LINE, POLYUREA
 (ALL LINES WILL INCLUDE C/L BREAKS FOR
 TOWN HIGHWAYS) S=SOLID, D=DASHED
 WAITSFIELD:
 STA 17+00.00 - STA 22+50.00 LT & RT
 STA 17+79.36 DOUBLE SOLID LT, TH-29
 STA 21+17.28 DOUBLE SOLID RT, TH-32

646.602 TEMPORARY 4 INCH WHITE LINE, PAINT
 (ALL LINES WILL INCLUDE EDGE LINE BREAKS AND
 RADII FOR TOWN HIGHWAYS)
 WAITSFIELD:
 STA 17+00.00 - STA 22+50.00 LT & RT

646.612 TEMPORARY 4 INCH YELLOW LINE, PAINT
 (ALL LINES WILL INCLUDE C/L BREAKS FOR
 TOWN HIGHWAYS) S=SOLID, D=DASHED
 WAITSFIELD:
 STA 17+00.00 - STA 22+50.00 LT & RT
 STA 17+79.36 DOUBLE SOLID LT, TH-29
 STA 21+17.28 DOUBLE SOLID RT, TH-32

646.482 DURABLE 24 INCH STOP BAR, THERMOPLASTIC OR
 646.483 DURABLE 24 INCH STOP BAR, EPOXY PAINT OR
 646.484 DURABLE 24 INCH STOP BAR, POLYUREA
 WAITSFIELD:
 STA 17+79.36 LT, TH-29
 STA 21+17.28 RT, TH-32



646.492 DURABLE LETTER OR SYMBOL, THERMOPLASTIC OR
 646.493 DURABLE LETTER OR SYMBOL, EPOXY PAINT OR
 646.494 DURABLE LETTER OR SYMBOL, POLYUREA
 WAITSFIELD:
 STA 17+79.36 LT, TH-29, "S,T,O,P" (4 EA)
 STA 21+17.28 RT, TH-32, "S,T,O,P" (4 EA)

646.682 TEMPORARY 24 INCH STOP BAR, PAINT
 WAITSFIELD:
 STA 17+79.36 LT, TH-29
 STA 21+17.28 RT, TH-32

646.692 TEMPORARY LETTER OR SYMBOL, PAINT
 WAITSFIELD:
 STA 17+79.36 LT, TH-29, "S,T,O,P" (8 EA)
 STA 21+17.28 RT, TH-32, "S,T,O,P" (8 EA)

675.50 REMOVING SIGNS
 AS SHOWN - 4

675.60 ERECTING SALVAGED SIGNS
 AS SHOWN - 2

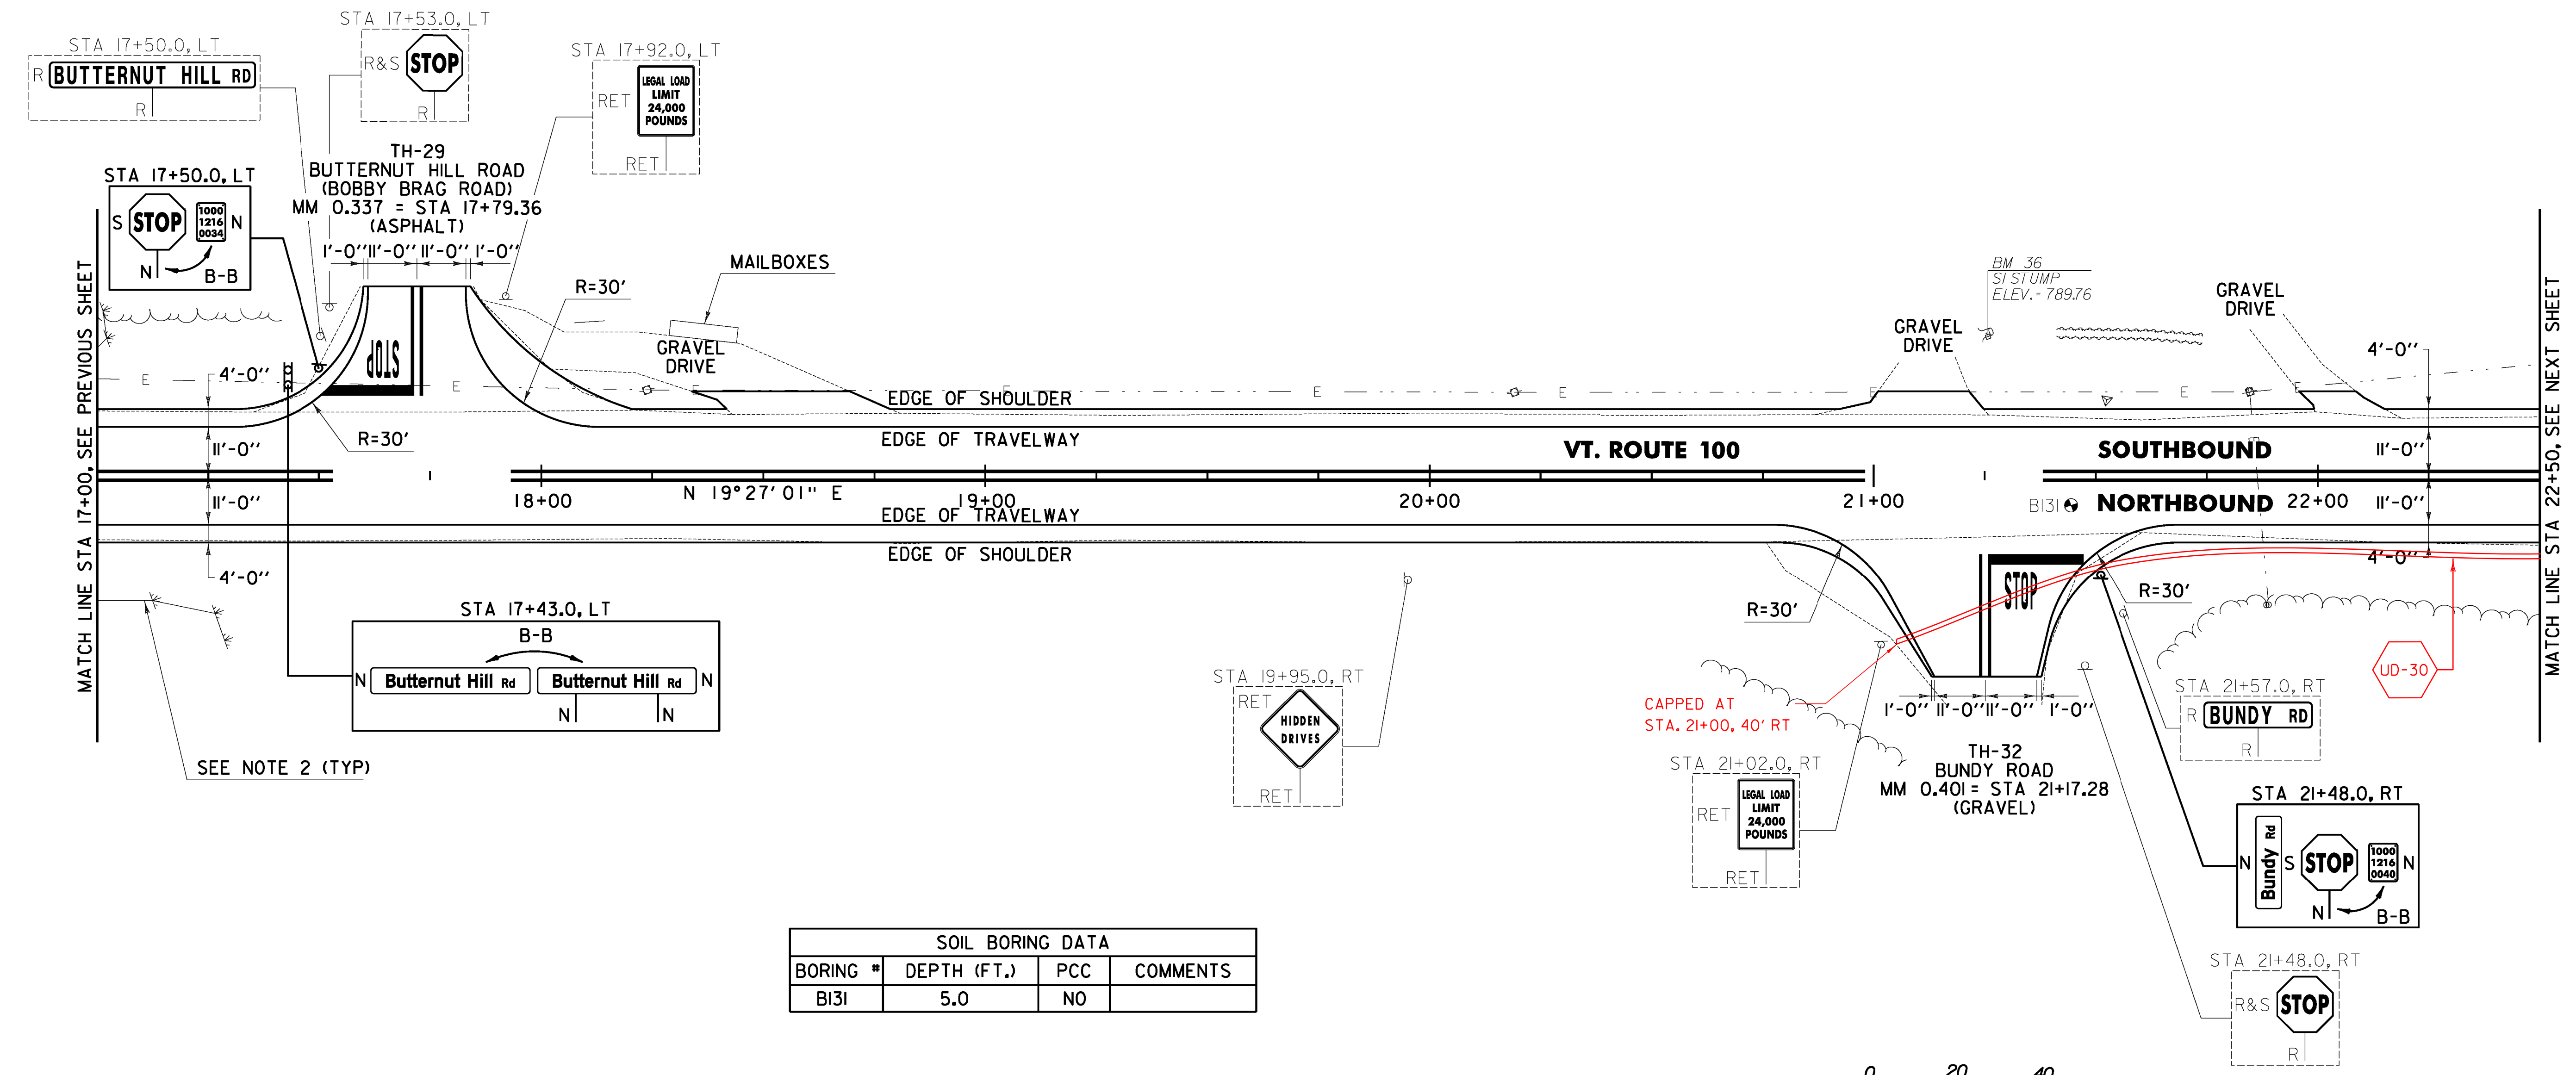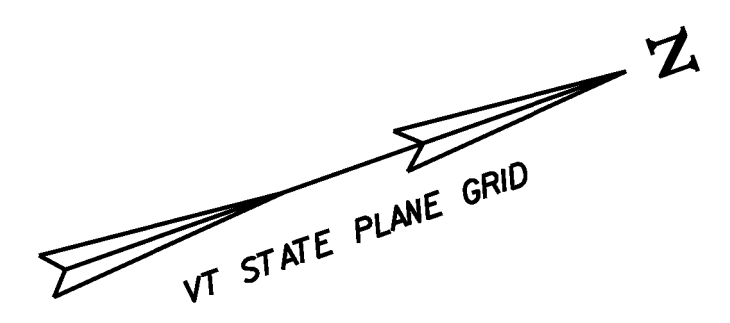

SOIL BORING DATA			
BORING #	DEPTH (FT.)	PCC	COMMENTS
BI31	5.0	NO	

NOTES:

- PAVING LIMIT ON ALL TOWN HIGHWAYS SHALL BE MEASURED 25 FT BACK FROM VT. ROUTE 100 EDGE OF SHOULDER UNLESS DENOTED OTHERWISE ON THE PLANS OR AS DIRECTED BY THE ENGINEER.
- APPROXIMATE WETLAND LOCATION FROM STA 17+00 TO STA 18+50 RT.

SIGN LEGEND

R = REMOVE
 S = SALVAGE
 N = NEW
 RET = RETAIN
 B-B = BACK TO BACK
 EXISTING = _____
 NEW = _____
 ⊕ = RETURN TO THE TOWN OF WAITSFIELD

0 20 40
 SCALE IN FEET

PROJECT LAYOUT SHEET #57	PROJECT NAME: WARREN - WAITSFIELD	PLOT DATE: 12/20/2012
	PROJECT NUMBER: STP 2506(1)	DRAWN BY: W.G.P.
	FILE NAME: p05b048.dgn	CHECKED BY: D.E.G.
	PROJECT LEADER: D.E.G.	SHEET 83 OF 310

FILE NAME = I:\1762\CADD\MSTN\STP 2506\p05b048.Centrect Plans.dgn
 DATE/TIME = 12/20/2012
 USER = 4866