
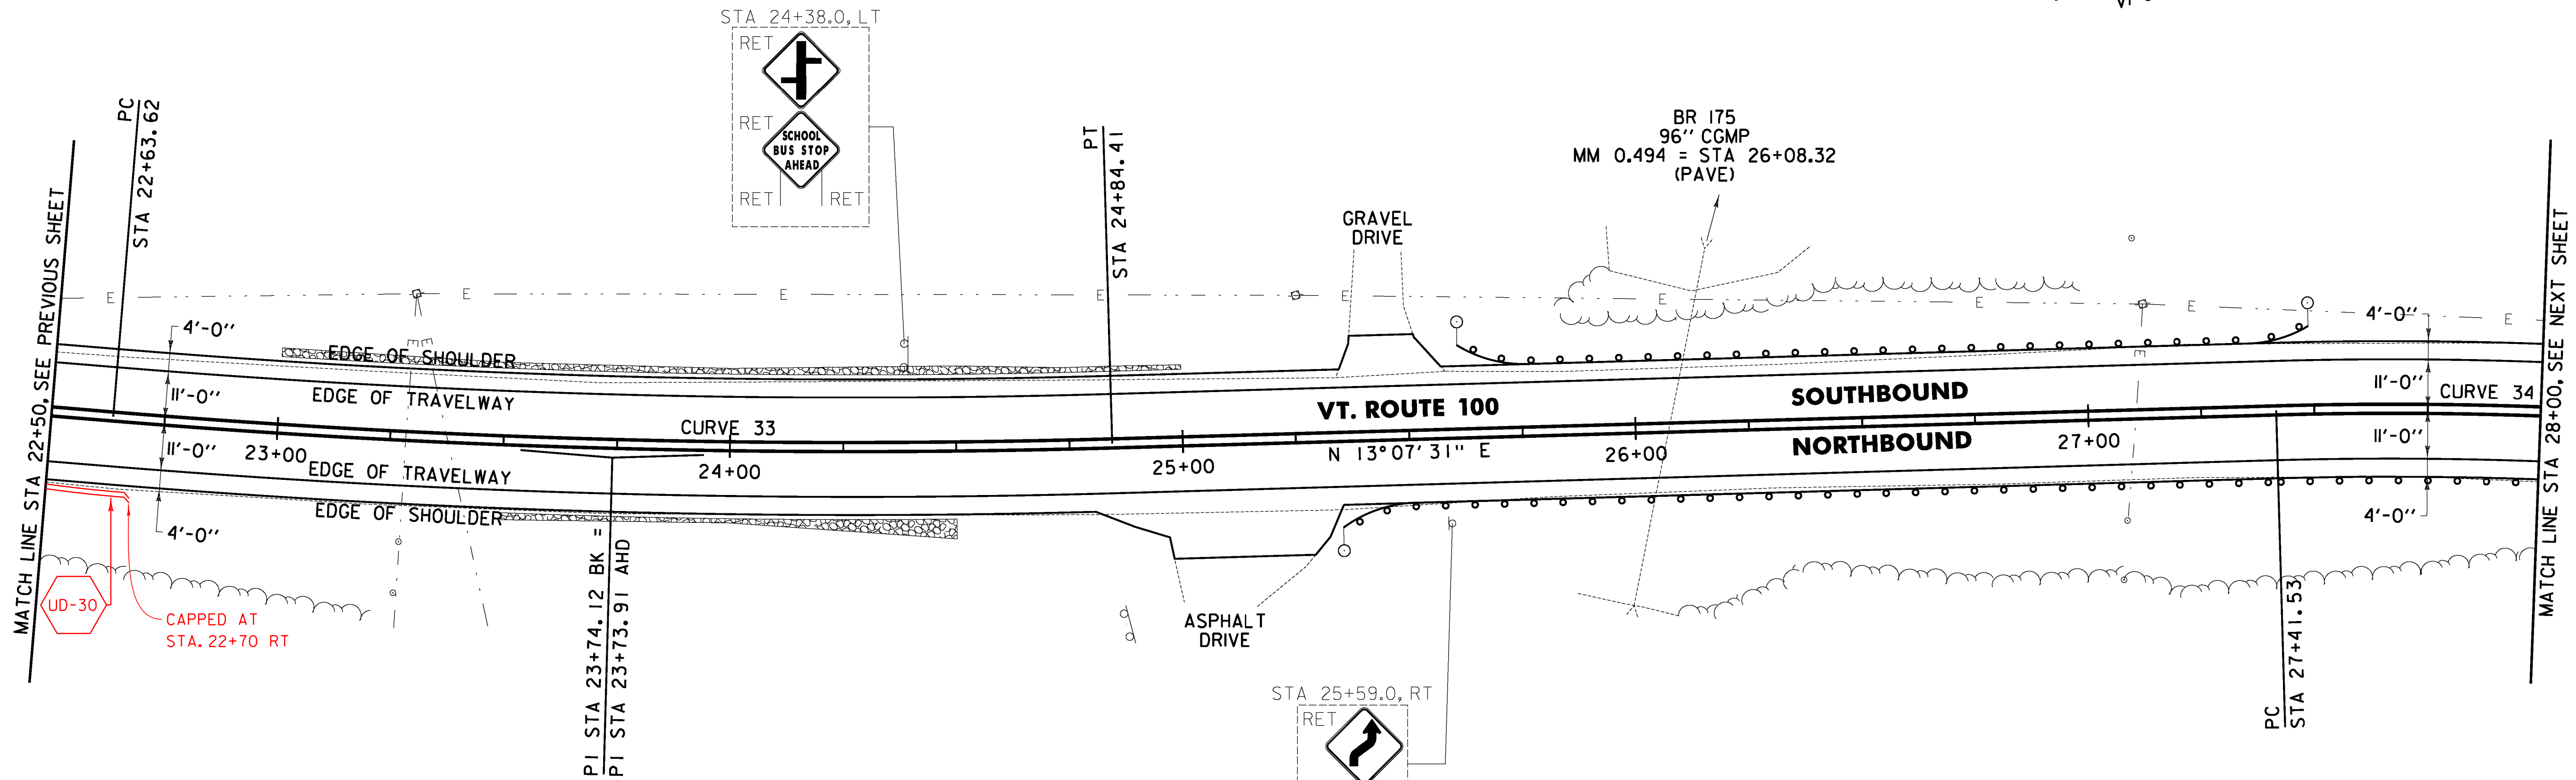


646.402 DURABLE 4 INCH WHITE LINE, THERMOPLASTIC OR
 646.403 DURABLE 4 INCH WHITE LINE, EPOXY PAINT OR
 646.404 DURABLE 4 INCH WHITE LINE, POLYUREA
 (ALL LINES WILL INCLUDE EDGE LINE BREAKS AND
 RADII FOR TOWN HIGHWAYS)
 WAITSFIELD:
 STA 22+50.00 - STA 28+00.00 LT & RT

646.412 DURABLE 4 INCH YELLOW LINE, THERMOPLASTIC OR
 646.413 DURABLE 4 INCH YELLOW LINE, EPOXY PAINT OR
 646.414 DURABLE 4 INCH YELLOW LINE, POLYUREA
 (ALL LINES WILL INCLUDE C/L BREAKS FOR
 TOWN HIGHWAYS) S=SOLID, D=DASHED
 WAITSFIELD:
 STA 22+50.00 - STA 28+00.00 LT C RT
 S - S

646.602 TEMPORARY 4 INCH WHITE LINE, PAINT
 (ALL LINES WILL INCLUDE EDGE LINE BREAKS AND
 RADII FOR TOWN HIGHWAYS)
 WAITSFIELD:
 STA 22+50.00 - STA 28+00.00 LT & RT

646.612 TEMPORARY 4 INCH YELLOW LINE, PAINT
 (ALL LINES WILL INCLUDE C/L BREAKS FOR
 TOWN HIGHWAYS) S=SOLID, D=DASHED
 WAITSFIELD:
 STA 22+50.00 - STA 28+00.00 LT C RT
 S - S

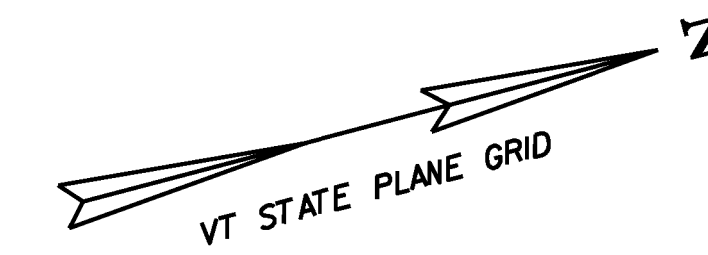

649.31 GEOTEXTILE UNDER STONE FILL
 WARREN:
 STA 23+00.0 - STA 25+00.0 LT (87.0 SY)
 STA 23+50.0 - STA 24+50.0 RT (49.4 SY)

613.10 STONE FILL, TYPE I
 WAITSFIELD:
 STA 23+00.0 - STA 25+00.0 LT (15.1 CY)
 STA 23+50.0 - STA 24+50.0 RT (9.5 CY)

651.40 GRUBBING MATERIAL
 WAITSFIELD:
 STA 23+00.0 - STA 25+00.0 LT (42.6 SY)
 STA 23+50.0 - STA 24+50.0 RT (27.2 SY)

653.20 TEMPORARY EROSION MATTING
 WAITSFIELD:
 STA 23+00.0 - STA 25+00.0 LT (42.6 SY)
 STA 23+50.0 - STA 24+50.0 RT (27.2 SY)

621.80 REMOVAL AND DISPOSAL OF GUARDRAIL
 WAITSFIELD:
 STA 25+49.0 - STA 26+35.0 RT (86.0 LF)
 STA 25+61.0 - STA 27+22.0 LT (161.0 LF)

676.10 DELINEATOR WITH STEEL POST
 WAITSFIELD:
 STA 25+35.0 RT
 STA 25+59.0 LT
 STA 27+49.0 LT


900.640 SPECIAL PROVISION (BOX BEAM GUARDRAIL W/7 FEET POSTS)
 WAITSFIELD:
 STA 25+35.0 - STA 28+00.0 RT (265.0 LF)
 STA 25+59.0 - STA 27+49.0 LT (190.0 LF)


CURVE 33
 $\Delta = 6^{\circ}19'30''$
 $D = 2^{\circ}51'53''$
 $R = 2000.00'$
 $T = 110.50'$
 $L = 220.79'$
 $E = 3.05'$
 $e = 0.051 \text{ FT/FT}$

CURVE 34
 $\Delta = 21^{\circ}42'31''$
 $D = 6^{\circ}21'58''$
 $R = 900.00'$
 $T = 172.57'$
 $L = 341.00'$
 $E = 16.39'$
 $e = 0.078 \text{ FT/FT}$

SIGN LEGEND
 R = REMOVE
 S = SALVAGE
 N = NEW
 RET = RETAIN
 B-B = BACK TO BACK
 EXISTING = -----
 NEW = _____
 ⊕ = RETURN TO THE TOWN OF WAITSFIELD

LEGEND

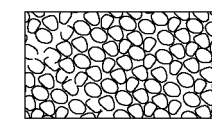 ITEM 613.10 STONE FILL, TYPE I

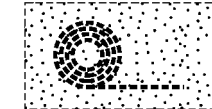 ITEM 653.20 TEMPORARY EROSION MATTING



PROJECT LAYOUT SHEET #58	PROJECT NAME: WARREN - WAITSFIELD	PLOT DATE: 12/20/2012
	PROJECT NUMBER: STP 2506(1)	DRAWN BY: W.G.P.
	FILE NAME: p05b048.dgn	CHECKED BY: D.E.G.
	DESIGNED BY: M.J.M.	SHEET 84 OF 310
	IPARM FILE: p05b048(1)58.1	