



646.402 DURABLE 4 INCH WHITE LINE, THERMOPLASTIC OR  
 646.403 DURABLE 4 INCH WHITE LINE, EPOXY PAINT OR  
 646.404 DURABLE 4 INCH WHITE LINE, POLYUREA  
 (ALL LINES WILL INCLUDE EDGE LINE BREAKS AND  
 RADII FOR TOWN HIGHWAYS)  
 WAITSFIELD:  
 STA 28+00.00 - STA 33+50.00 LT & RT

646.412 DURABLE 4 INCH YELLOW LINE, THERMOPLASTIC OR  
 646.413 DURABLE 4 INCH YELLOW LINE, EPOXY PAINT OR  
 646.414 DURABLE 4 INCH YELLOW LINE, POLYUREA  
 (ALL LINES WILL INCLUDE C/L BREAKS FOR  
 TOWN HIGHWAYS) S=SOLID, D=DASHED  
 WAITSFIELD:  
 STA 28+00.00 - STA 33+50.00 LT C RT  
 S - S

646.602 TEMPORARY 4 INCH WHITE LINE, PAINT  
 (ALL LINES WILL INCLUDE EDGE LINE BREAKS AND  
 RADII FOR TOWN HIGHWAYS)  
 WAITSFIELD:  
 STA 28+00.00 - STA 33+50.00 LT & RT

646.612 TEMPORARY 4 INCH YELLOW LINE, PAINT  
 (ALL LINES WILL INCLUDE C/L BREAKS FOR  
 TOWN HIGHWAYS) S=SOLID, D=DASHED  
 WAITSFIELD:  
 STA 28+00.00 - STA 33+50.00 LT C RT  
 S - S

675.50 REMOVING SIGNS  
 AS SHOWN - 1

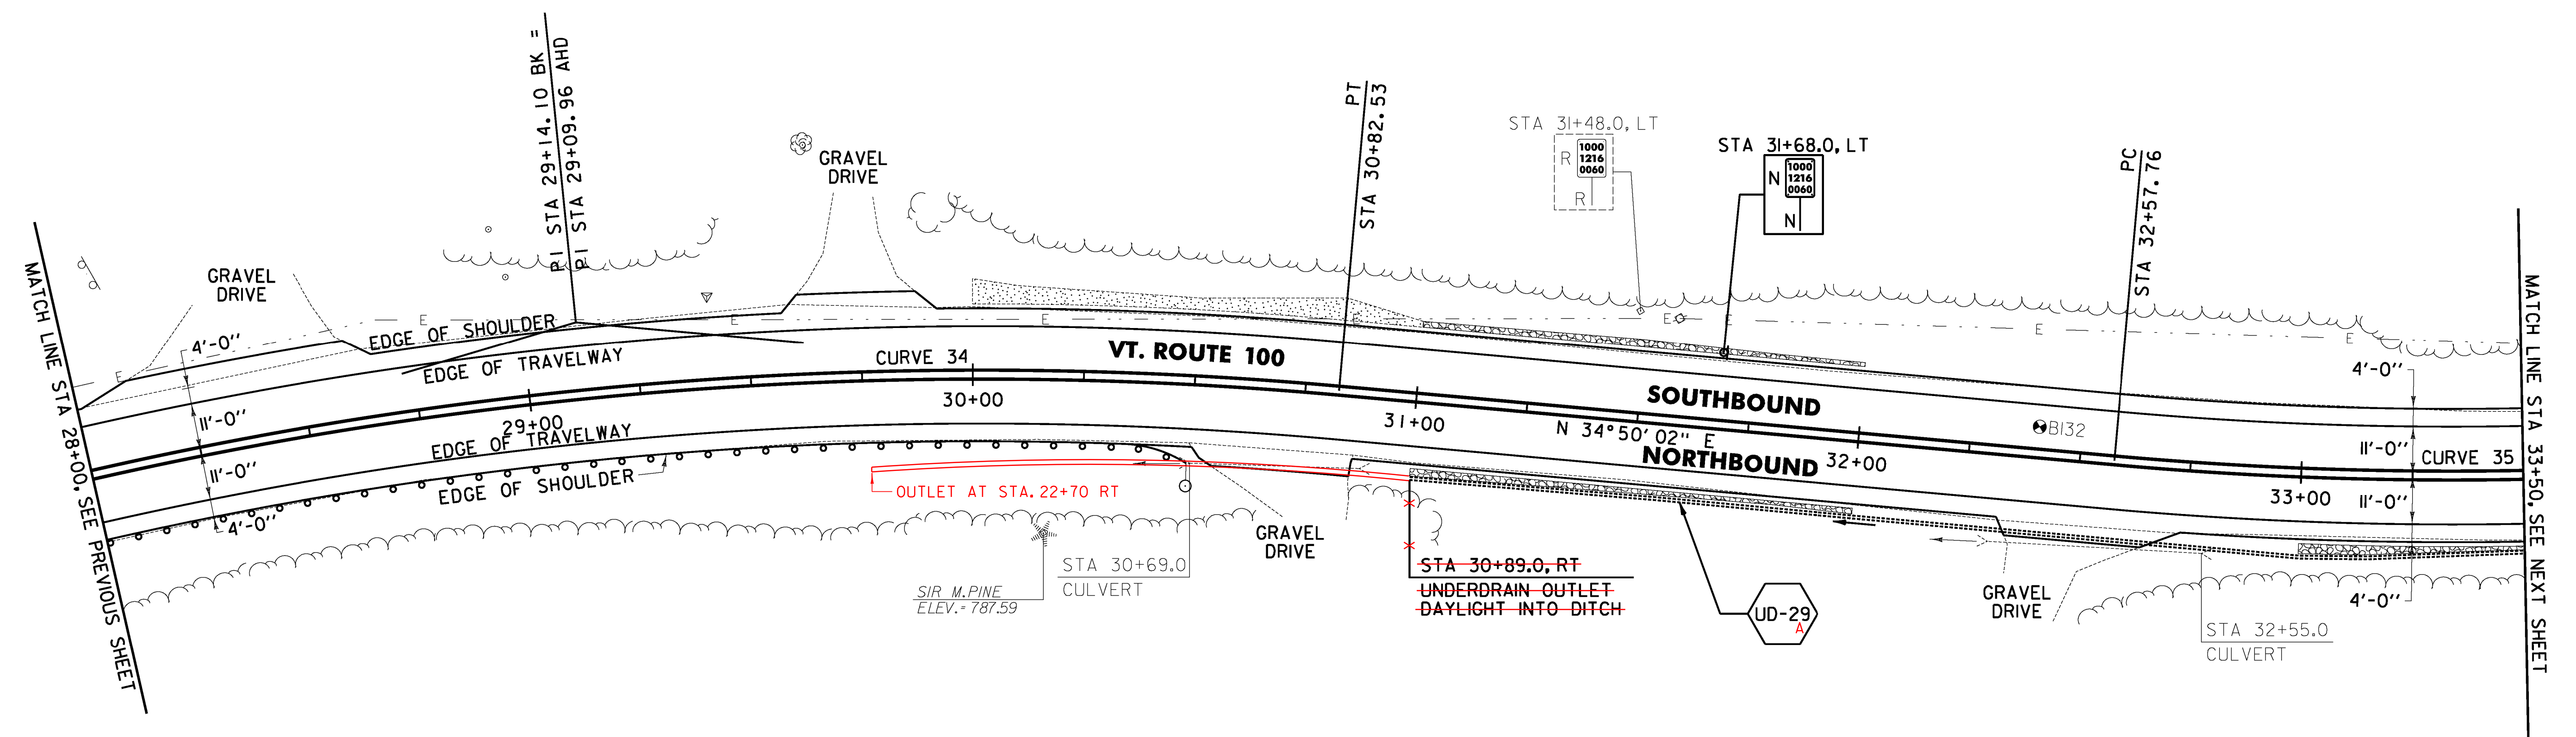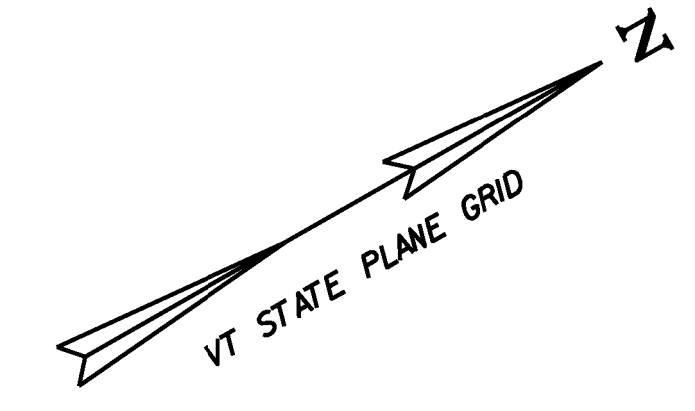

649.31 GEOTEXTILE UNDER STONE FILL  
 WARREN:  
 STA 31+00.0 - STA 32+00.0 LT (42.3 SY)  
 STA 31+00.0 - STA 32+00.0 RT (40.3 SY)  
 STA 33+00.0 - STA 33+50.0 RT (22.9 SY)

613.10 STONE FILL, TYPE I  
 WAITSFIELD:  
 STA 31+00.0 - STA 32+00.0 LT (7.2 CY)  
 STA 31+00.0 - STA 32+00.0 RT (6.5 CY)  
 STA 33+00.0 - STA 33+50.0 RT (4.2 CY)

651.40 GRUBBING MATERIAL  
 WAITSFIELD:  
 STA 30+00.0 - STA 31+00.0 LT (37.7 SY)  
 STA 31+00.0 - STA 32+00.0 LT (20.1 SY)  
 STA 31+00.0 - STA 32+00.0 RT (18.1 SY)  
 STA 33+00.0 - STA 33+50.0 RT (11.8 SY)

653.20 TEMPORARY EROSION MATTING  
 WAITSFIELD:  
 STA 30+00.0 - STA 31+00.0 LT (37.7 SY)  
 STA 31+00.0 - STA 32+00.0 LT (20.1 SY)  
 STA 31+00.0 - STA 32+00.0 RT (18.1 SY)  
 STA 33+00.0 - STA 33+50.0 RT (11.8 SY)

676.10 DELINEATOR WITH STEEL POST  
 WAITSFIELD:  
 STA 30+49.0 RT


900.640 SPECIAL PROVISION (BOX BEAM GUARDRAIL W/7 FEET POSTS)  
 WAITSFIELD:  
 STA 28+00.0 - STA 30+49.0 RT (249.0 LF)

SOIL BORING DATA			
BORING #	DEPTH (FT.)	PCC	COMMENTS
BI32	5.0	NO	

<b>CURVE 34</b>	<b>CURVE 35</b>
Δ = 21° 42' 31"	Δ = 19° 49' 01"
D = 6° 21' 58"	D = 6° 44' 26"
R = 900.00'	R = 850.00'
T = 172.57'	T = 148.48'
L = 341.00'	L = 293.99'
E = 16.39'	E = 12.87'
e = 0.078 FT/FT	e = 0.060 FT/FT

**SIGN LEGEND**

R = REMOVE  
 S = SALVAGE  
 N = NEW  
 RET = RETAIN  
 B-B = BACK TO BACK  
 EXISTING = -----  
 NEW = \_\_\_\_\_  
 ⊕ = RETURN TO THE TOWN OF WAITSFIELD

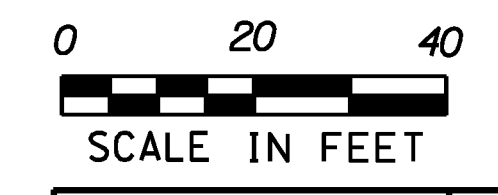

**LEGEND**

ITEM 613.10 STONE FILL, TYPE I

ITEM 653.20 TEMPORARY EROSION MATTING

<b>PROJECT LAYOUT SHEET #59</b>	PROJECT NAME: WARREN - WAITSFIELD
	PROJECT NUMBER: STP 2506(1)
	FILE NAME: p05b048.dgn PROJECT LEADER: D.E.G. DESIGNED BY: M.J.M. IPARM FILE: p05b048(1)59.1
	PLOT DATE: 12/20/2012 DRAWN BY: W.G.P. CHECKED BY: D.E.G. SHEET 85 OF 310

FILE NAME = I:\17762\CADD\MSTN\STP\_2506\p05b048.dgn  
 DATE/TIME = 12/20/2012 12:00:00  
 USER = 4866