
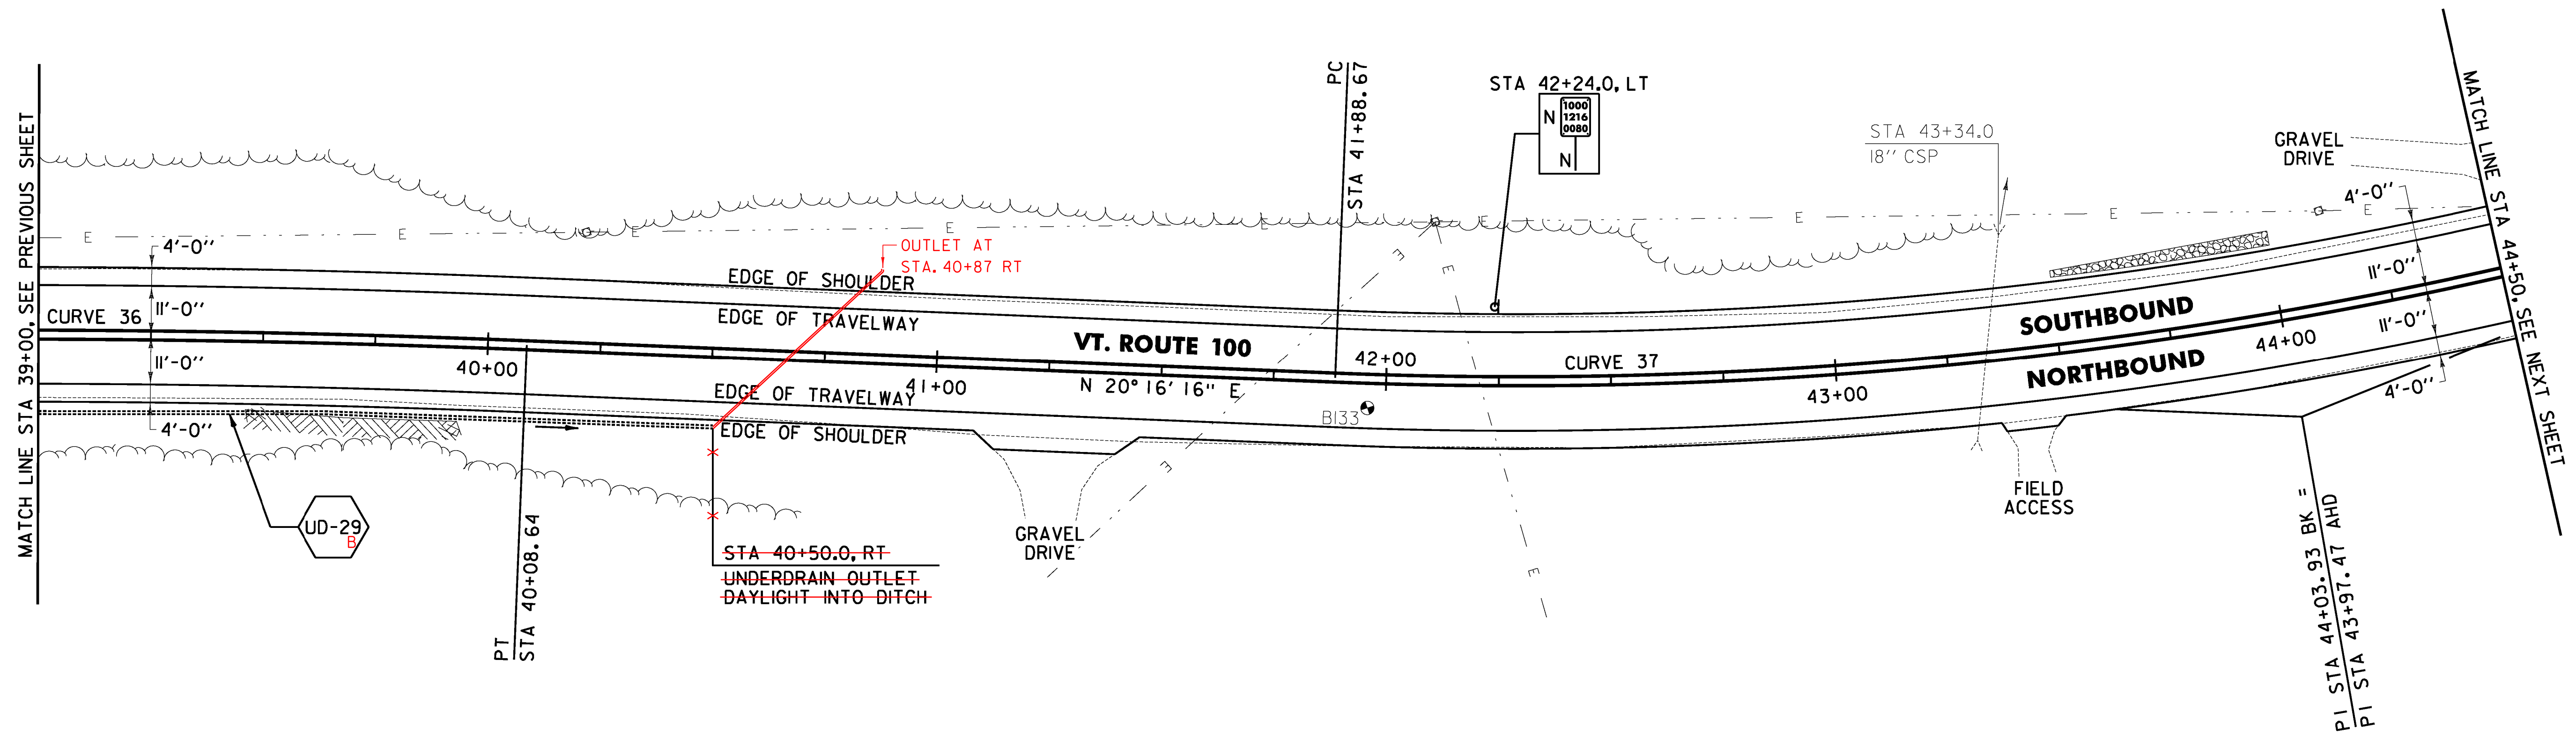


646.402 DURABLE 4 INCH WHITE LINE, THERMOPLASTIC OR
 646.403 DURABLE 4 INCH WHITE LINE, EPOXY PAINT OR
 646.404 DURABLE 4 INCH WHITE LINE, POLYUREA
 (ALL LINES WILL INCLUDE EDGE LINE BREAKS AND
 RADII FOR TOWN HIGHWAYS)
 WAITSFIELD:
 STA 39+00.00 - STA 44+50.00 LT & RT

646.412 DURABLE 4 INCH YELLOW LINE, THERMOPLASTIC OR
 646.413 DURABLE 4 INCH YELLOW LINE, EPOXY PAINT OR
 646.414 DURABLE 4 INCH YELLOW LINE, POLYUREA
 (ALL LINES WILL INCLUDE C/L BREAKS FOR
 TOWN HIGHWAYS) S=SOLID, D=DASHED
 WAITSFIELD:
 STA 39+00.00 - STA 44+50.00 LT C RT
 S - S

646.602 TEMPORARY 4 INCH WHITE LINE, PAINT
 (ALL LINES WILL INCLUDE EDGE LINE BREAKS AND
 RADII FOR TOWN HIGHWAYS)
 WAITSFIELD:
 STA 39+00.00 - STA 44+50.00 LT & RT

646.612 TEMPORARY 4 INCH YELLOW LINE, PAINT
 (ALL LINES WILL INCLUDE C/L BREAKS FOR
 TOWN HIGHWAYS) S=SOLID, D=DASHED
 WAITSFIELD:
 STA 39+00.00 - STA 44+50.00 LT C RT
 S - S

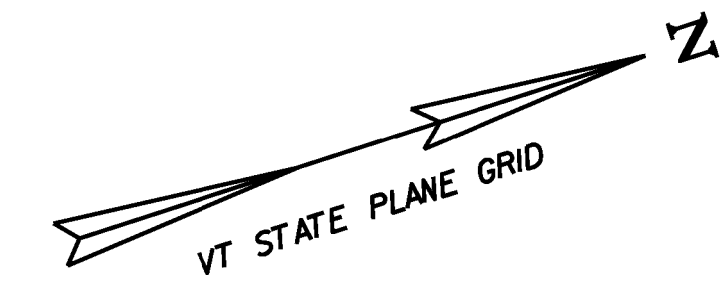

SOIL BORING DATA			
BORING #	DEPTH (FT.)	PCC	COMMENTS
BI33	5.0		

649.31 GEOTEXTILE UNDER STONE FILL
 WARREN:
 STA 43+50.0 - STA 44+00.0 LT (26.6 SY)

613.10 STONE FILL, TYPE I
 WAITSFIELD:
 STA 43+50.0 - STA 44+00.0 LT (5.4 CY)

651.40 GRUBBING MATERIAL
 WAITSFIELD:
 STA 43+50.0 - STA 44+00.0 LT (15.4 SY)



653.20 TEMPORARY EROSION MATTING
 WAITSFIELD:
 STA 43+50.0 - STA 44+00.0 LT (15.4 SY)

CURVE 36
 $\Delta = 5^\circ 15' 16''$
 $D = 1^\circ 58' 33''$
 $R = 2900.00'$
 $T = 133.07'$
 $L = 265.94'$
 $E = 3.05'$
 $e = 0.038 \text{ FT/FT}$

CURVE 37
 $\Delta = 24^\circ 17' 48''$
 $D = 5^\circ 43' 46''$
 $R = 1000.00'$
 $T = 215.26'$
 $L = 424.06'$
 $E = 22.91'$
 $e = 0.076 \text{ FT/FT}$

SIGN LEGEND
 R = REMOVE
 S = SALVAGE
 N = NEW
 RET = RETAIN
 B-B = BACK TO BACK
 EXISTING = -----
 NEW = _____
 ⊕ = RETURN TO THE TOWN OF WAITSFIELD

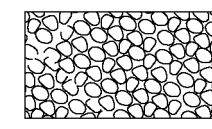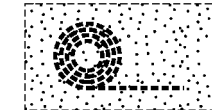

- LEGEND**
-  ITEM 613.10 STONE FILL, TYPE I
 -  ITEM 653.20 TEMPORARY EROSION MATTING

PROJECT LAYOUT SHEET #61	PROJECT NAME: WARREN - WAITSFIELD
	PROJECT NUMBER: STP 2506(1)
	FILE NAME: p05b048.dgn PROJECT LEADER: D.E.G. DESIGNED BY: M.J.M. IPARM FILE: p05b048i61.i
	PLOT DATE: 12/20/2012 DRAWN BY: W.G.P. CHECKED BY: D.E.G. SHEET 87 OF 310