

646.402 DURABLE 4 INCH WHITE LINE, THERMOPLASTIC OR  
 646.403 DURABLE 4 INCH WHITE LINE, EPOXY PAINT OR  
 646.404 DURABLE 4 INCH WHITE LINE, POLYUREA  
 (ALL LINES WILL INCLUDE EDGE LINE BREAKS AND  
 RADII FOR TOWN HIGHWAYS)  
 WAITSFIELD:  
 STA 66+50.00 - STA 72+00.00 LT & RT



646.412 DURABLE 4 INCH YELLOW LINE, THERMOPLASTIC OR  
 646.413 DURABLE 4 INCH YELLOW LINE, EPOXY PAINT OR  
 646.414 DURABLE 4 INCH YELLOW LINE, POLYUREA  
 (ALL LINES WILL INCLUDE C/L BREAKS FOR  
 TOWN HIGHWAYS) S=SOLID, D=DASHED  
 WAITSFIELD:  
 STA 66+50.00 - STA 72+00.00

LT C RT  
 S - S

646.602 TEMPORARY 4 INCH WHITE LINE, PAINT  
 (ALL LINES WILL INCLUDE EDGE LINE BREAKS AND  
 RADII FOR TOWN HIGHWAYS)  
 WAITSFIELD:  
 STA 66+50.00 - STA 72+00.00 LT & RT

646.612 TEMPORARY 4 INCH YELLOW LINE, PAINT  
 (ALL LINES WILL INCLUDE C/L BREAKS FOR  
 TOWN HIGHWAYS) S=SOLID, D=DASHED  
 WAITSFIELD:  
 STA 66+50.00 - STA 72+00.00

LT C RT  
 S - S

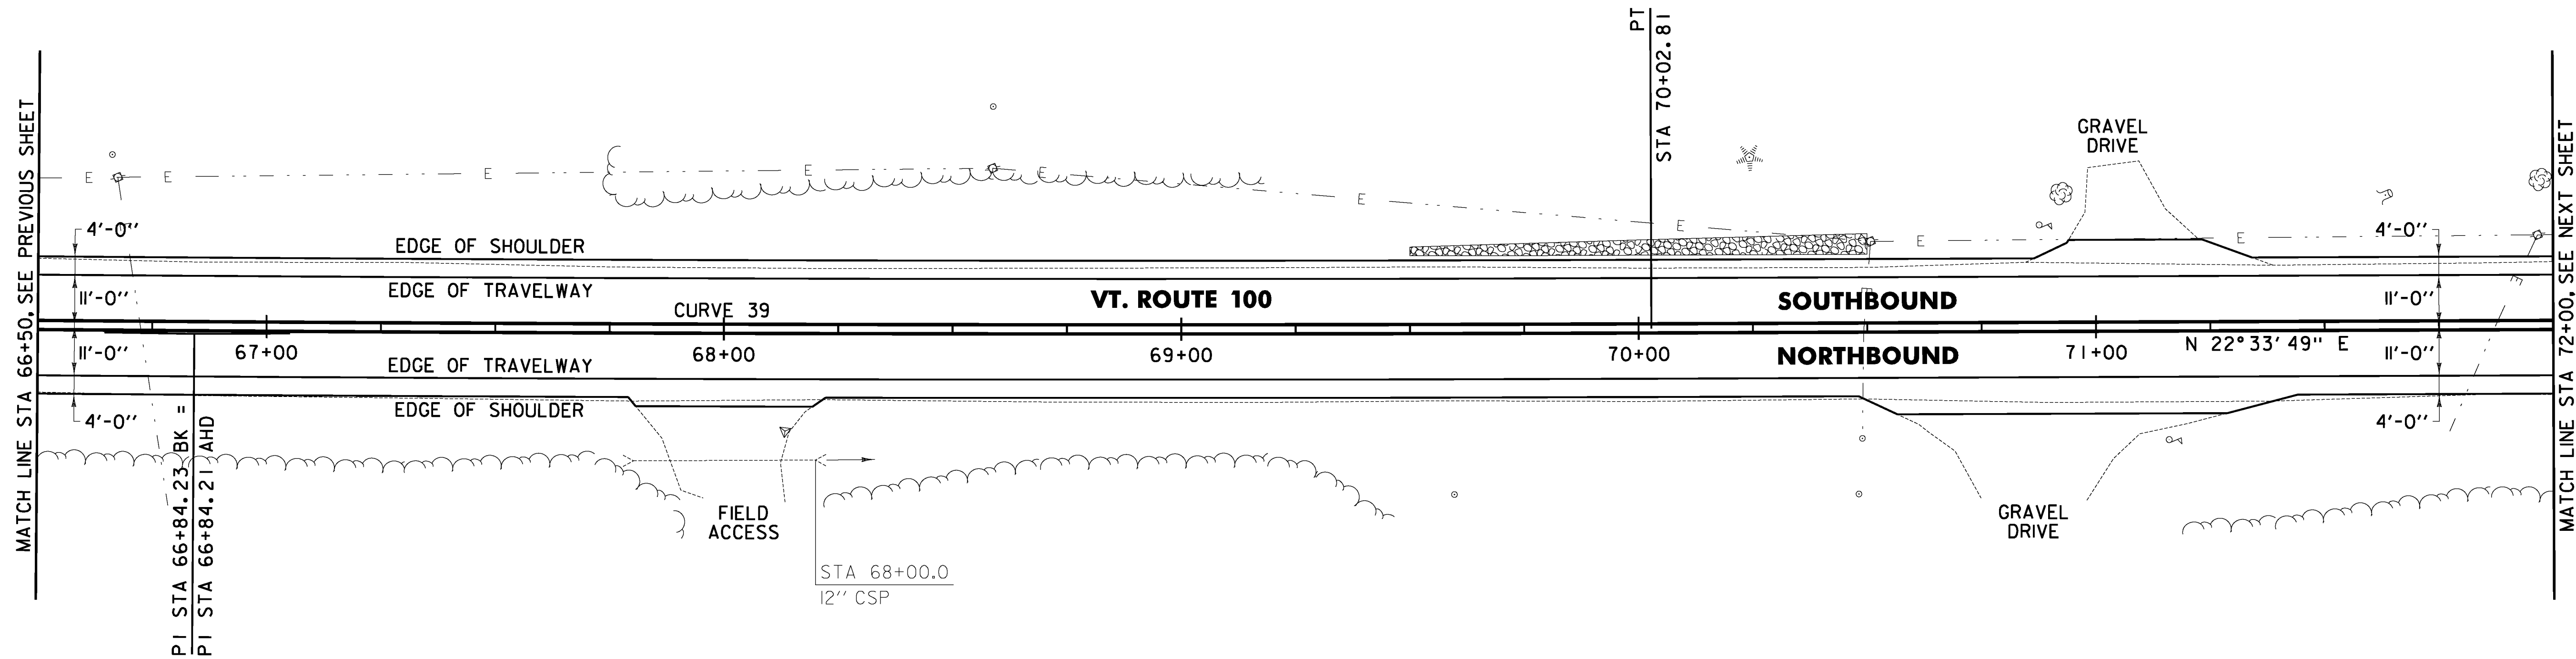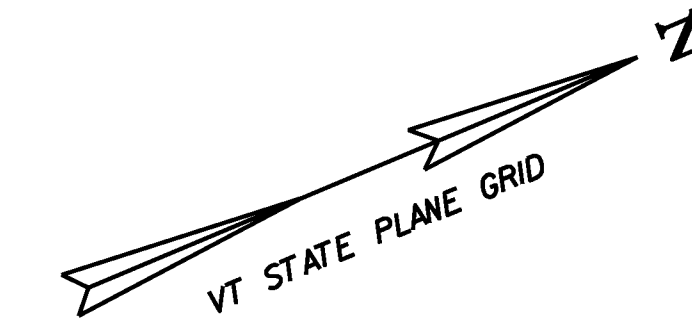

649.31 GEOTEXTILE UNDER STONE FILL  
 WARREN:  
 STA 69+50.0 - STA 70+50.0 LT (63.9 SY)

613.10 STONE FILL, TYPE I  
 WAITSFIELD:  
 STA 69+50.0 - STA 70+50.0 LT (7.7 CY)

651.40 GRUBBING MATERIAL  
 WAITSFIELD:  
 STA 69+50.0 - STA 70+50.0 LT (41.7 SY)



653.20 TEMPORARY EROSION MATTING  
 WAITSFIELD:  
 STA 69+50.0 - STA 70+50.0 LT (41.7 SY)

**CURVE 39**  
 $\Delta = 1^{\circ} 13' 01''$   
 $D = 0^{\circ} 11' 28''$   
 $R = 30000.00'$   
 $T = 318.60'$   
 $L = 637.18'$   
 $E = 1.69'$   
 $e = N. C.$

**SIGN LEGEND**  
 R = REMOVE  
 S = SALVAGE  
 N = NEW  
 RET = RETAIN  
 B-B = BACK TO BACK  
 NEW = -----  
 (O) = RETURN TO THE  
 TOWN OF WAITSFIELD



**LEGEND**

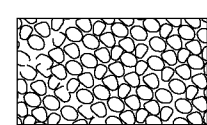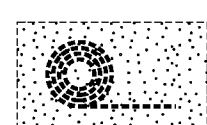-  ITEM 613.10 STONE FILL, TYPE I
-  ITEM 653.20 TEMPORARY EROSION MATTING

**PROJECT LAYOUT SHEET #66**

PROJECT NAME: WARREN - WAITSFIELD	PLOT DATE: 12/20/2012
PROJECT NUMBER: STP 2506(1)	DRAWN BY: W.G.P.
FILE NAME: p05b048.dgn	CHECKED BY: D.E.G.
DESIGNED BY: M.J.M.	SHEET 92 OF 310
IPARM FILE: p05b048i66.t	