

646.402 DURABLE 4 INCH WHITE LINE, THERMOPLASTIC OR
 646.403 DURABLE 4 INCH WHITE LINE, EPOXY PAINT OR
 646.404 DURABLE 4 INCH WHITE LINE, POLYUREA
 (ALL LINES WILL INCLUDE EDGE LINE BREAKS AND
 RADII FOR TOWN HIGHWAYS)
 WAITSFIELD:
 STA 88+50.00 - STA 94+00.00 LT & RT



646.412 DURABLE 4 INCH YELLOW LINE, THERMOPLASTIC OR
 646.413 DURABLE 4 INCH YELLOW LINE, EPOXY PAINT OR
 646.414 DURABLE 4 INCH YELLOW LINE, POLYUREA
 (ALL LINES WILL INCLUDE C/L BREAKS FOR
 TOWN HIGHWAYS) S=SOLID, D=DASHED
 WAITSFIELD:
 STA 88+50.00 - STA 94+00.00

LT C RT
 S - S

646.602 TEMPORARY 4 INCH WHITE LINE, PAINT
 (ALL LINES WILL INCLUDE EDGE LINE BREAKS AND
 RADII FOR TOWN HIGHWAYS)
 WAITSFIELD:
 STA 88+50.00 - STA 94+00.00 LT & RT

646.612 TEMPORARY 4 INCH YELLOW LINE, PAINT
 (ALL LINES WILL INCLUDE C/L BREAKS FOR
 TOWN HIGHWAYS) S=SOLID, D=DASHED

WAITSFIELD:
 STA 88+50.00 - STA 94+00.00 LT C RT
 S - S

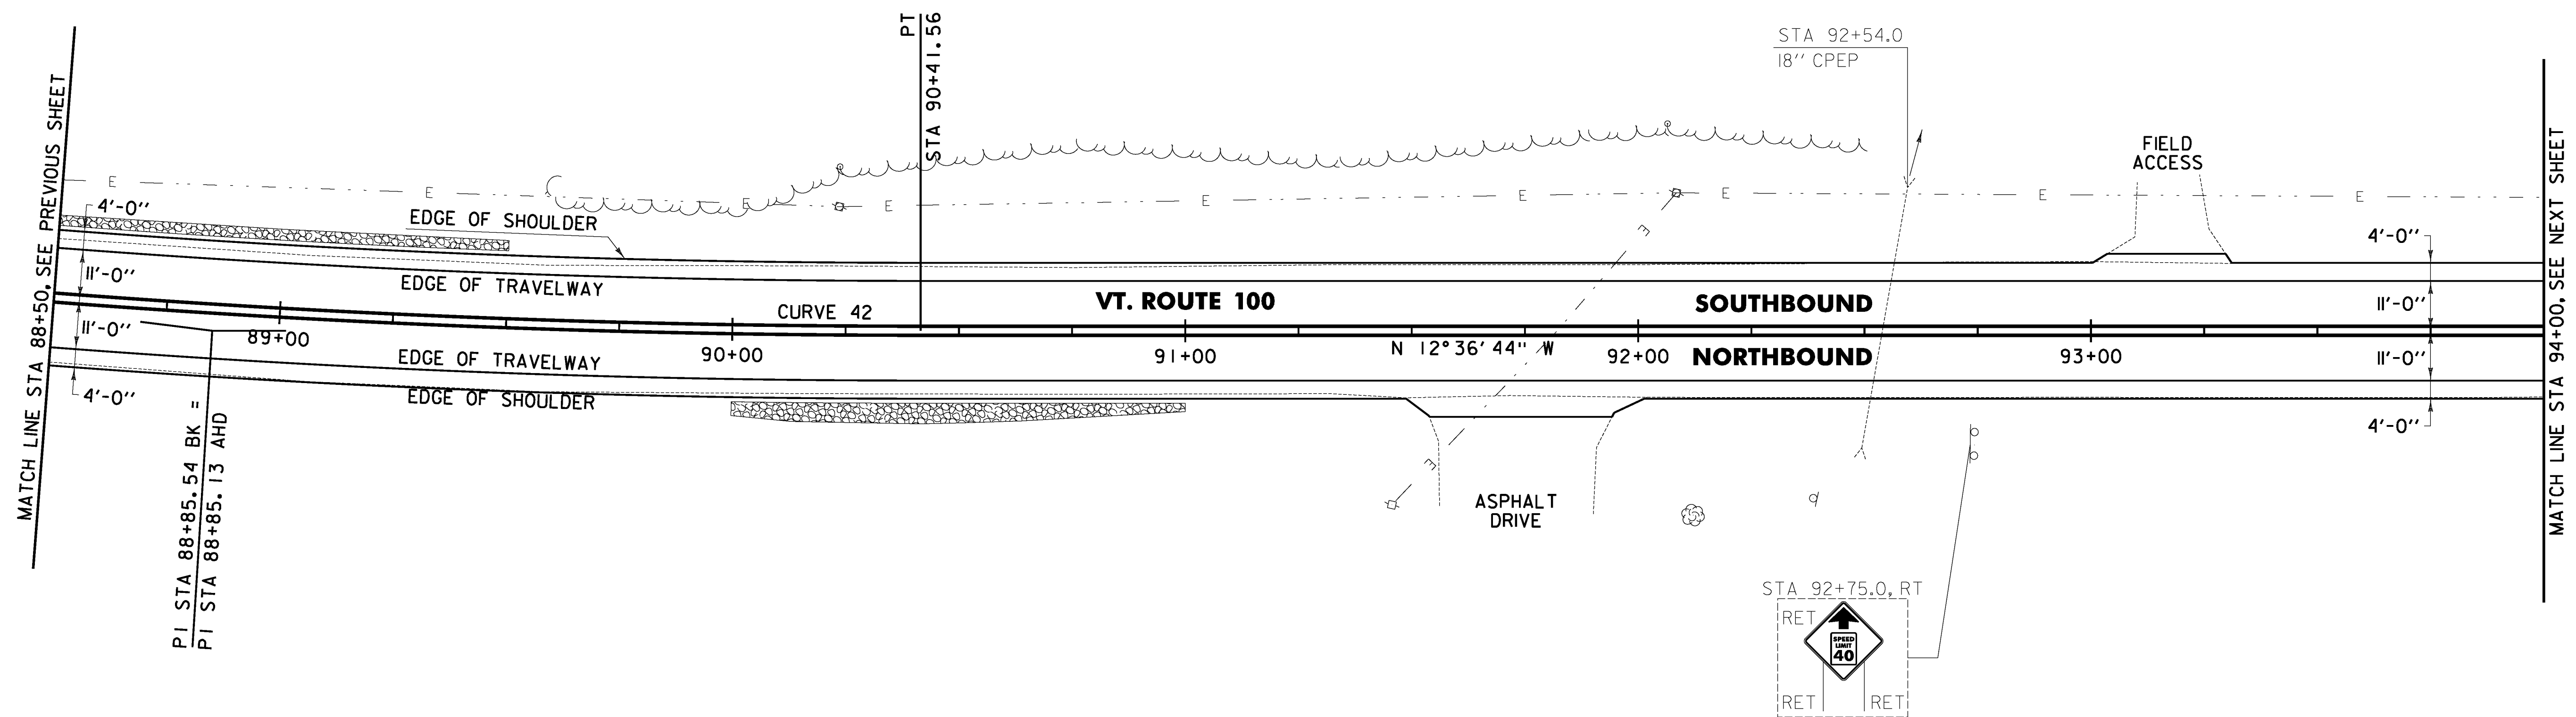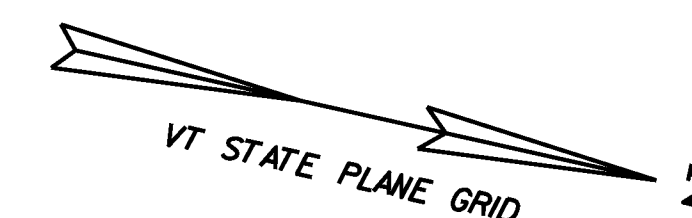

FILE NAME = U:\1762\CADD\NSTM\STP_2506\p05b048_Contract_Plan.dgn
 DATE/TIME = 12/20/2012 10:46:56
 USER = WGP

649.31 GEOTEXTILE UNDER STONE FILL
 WARREN:
 STA 88+50.0 - STA 89+50.0 LT (59.0 SY)
 STA 90+00.0 - STA 91+00.0 RT (67.8 SY)

613.10 STONE FILL, TYPE I
 WAITSFIELD:
 STA 88+50.0 - STA 89+50.0 LT (12.7 CY)
 STA 90+00.0 - STA 91+00.0 RT (15.7 CY)


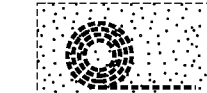
651.40 GRUBBING MATERIAL
 WAITSFIELD:
 STA 88+50.0 - STA 89+50.0 LT (36.8 SY)
 STA 90+00.0 - STA 91+00.0 RT (45.6 SY)

653.20 TEMPORARY EROSION MATTING
 WAITSFIELD:
 STA 88+50.0 - STA 89+50.0 LT (36.8 SY)
 STA 90+00.0 - STA 91+00.0 RT (45.6 SY)

CURVE 42
 $\Delta = 7^{\circ}09'39''$
 $D = 2^{\circ}17'31''$
 $R = 2500.00'$
 $T = 156.43'$
 $L = 312.45'$
 $E = 4.89'$
 $e = 0.043 \text{ FT/FT}$

SIGN LEGEND
 R = REMOVE
 S = SALVAGE
 N = NEW
 RET = RETAIN
 B-B = BACK TO BACK
 NEW = -----
 ⊙ = RETURN TO THE TOWN OF WAITSFIELD



LEGEND
 ITEM 613.10 STONE FILL, TYPE I
 ITEM 653.20 TEMPORARY EROSION MATTING

PROJECT LAYOUT SHEET #70

PROJECT NAME: WARREN - WAITSFIELD
 PROJECT NUMBER: STP 2506(1)
 FILE NAME: p05b048.dgn
 PROJECT LEADER: D.E.G.
 DESIGNED BY: M.J.M.
 IPARM FILE: p05b048170.i
 PLOT DATE: 12/20/2012
 DRAWN BY: W.G.P.
 CHECKED BY: D.E.G.
 SHEET 96 OF 310