




FILE NAME = U:\1762\CA00\MST\STP_2506\p05b048.Convect Plans.dgn
 DATE/TIME = 12/20/2012
 USER = 4866

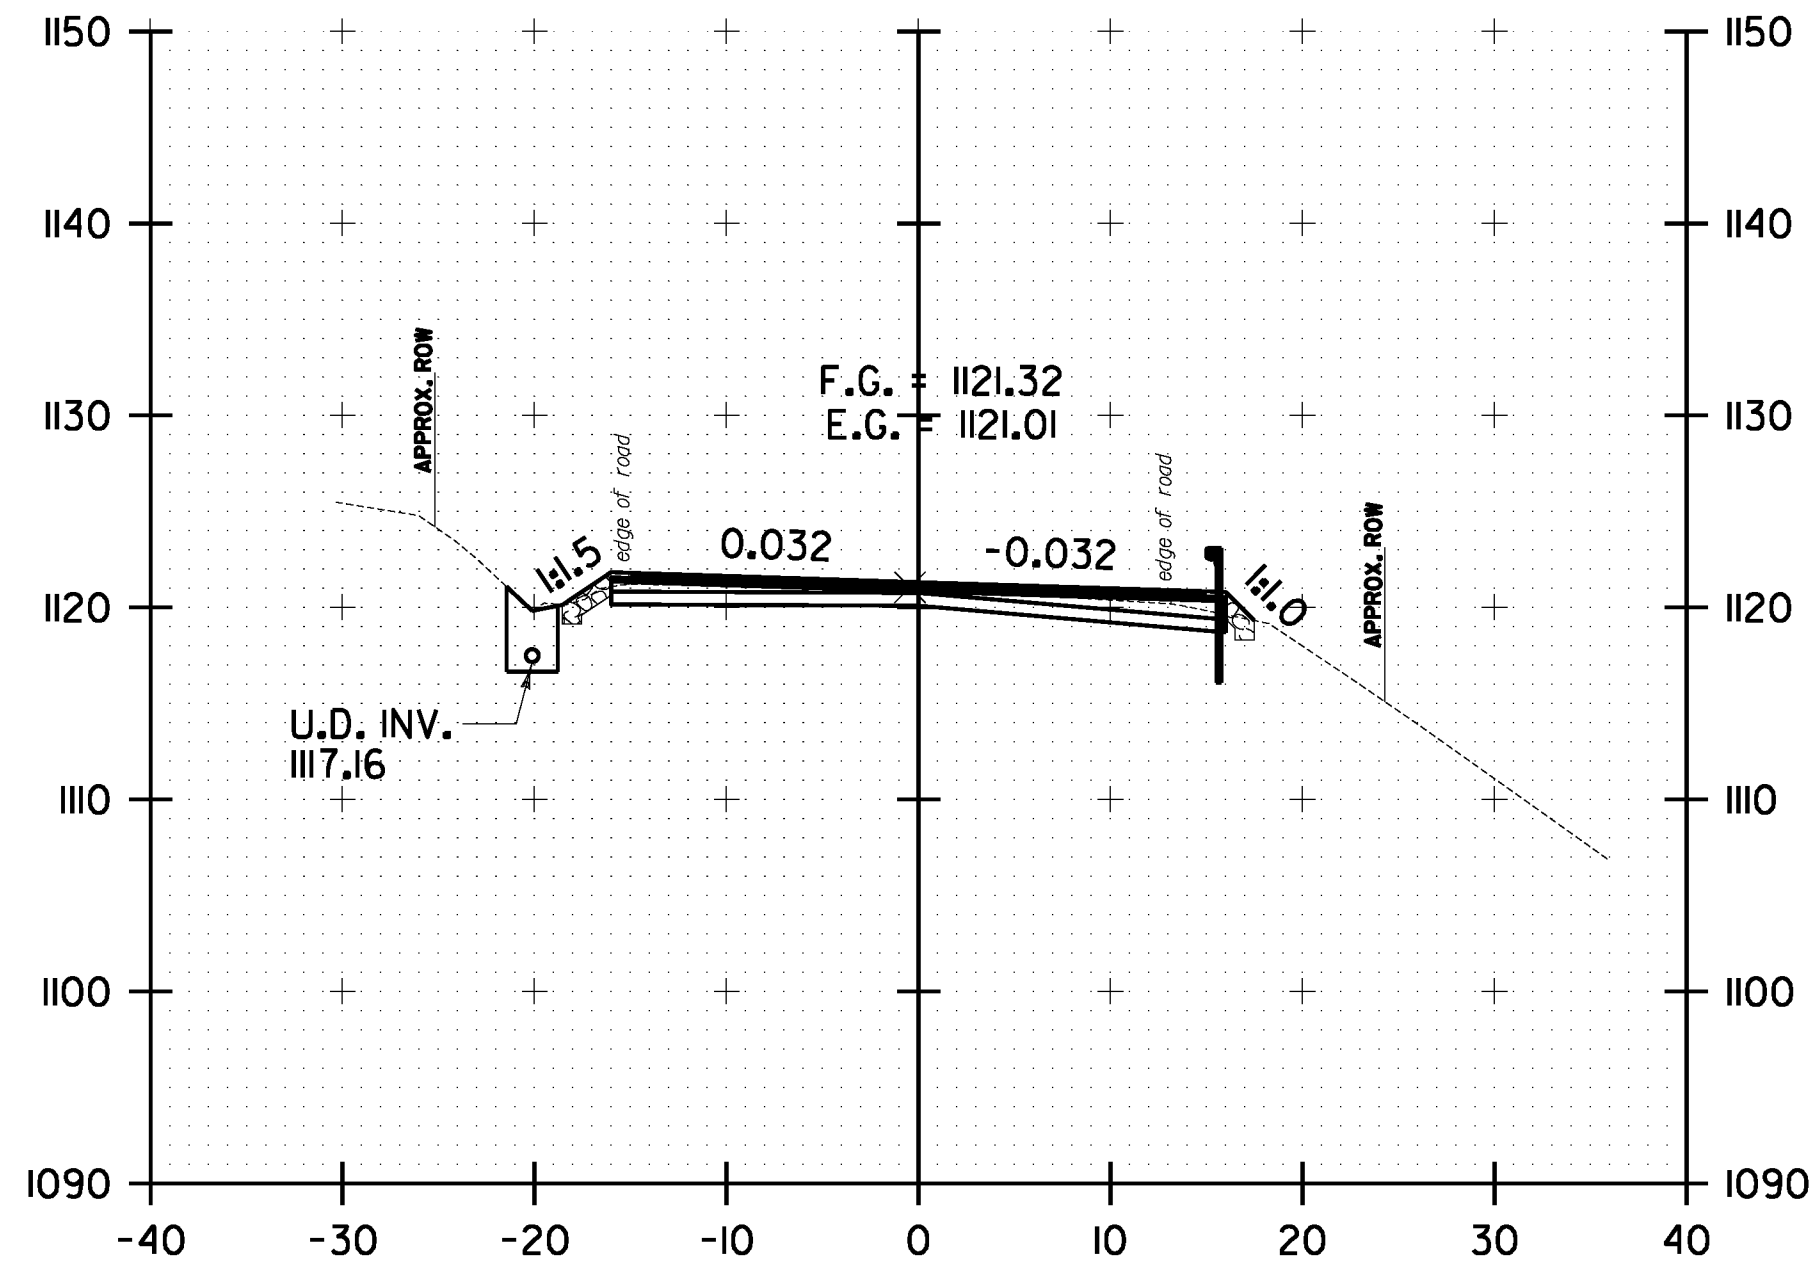


54+50.00

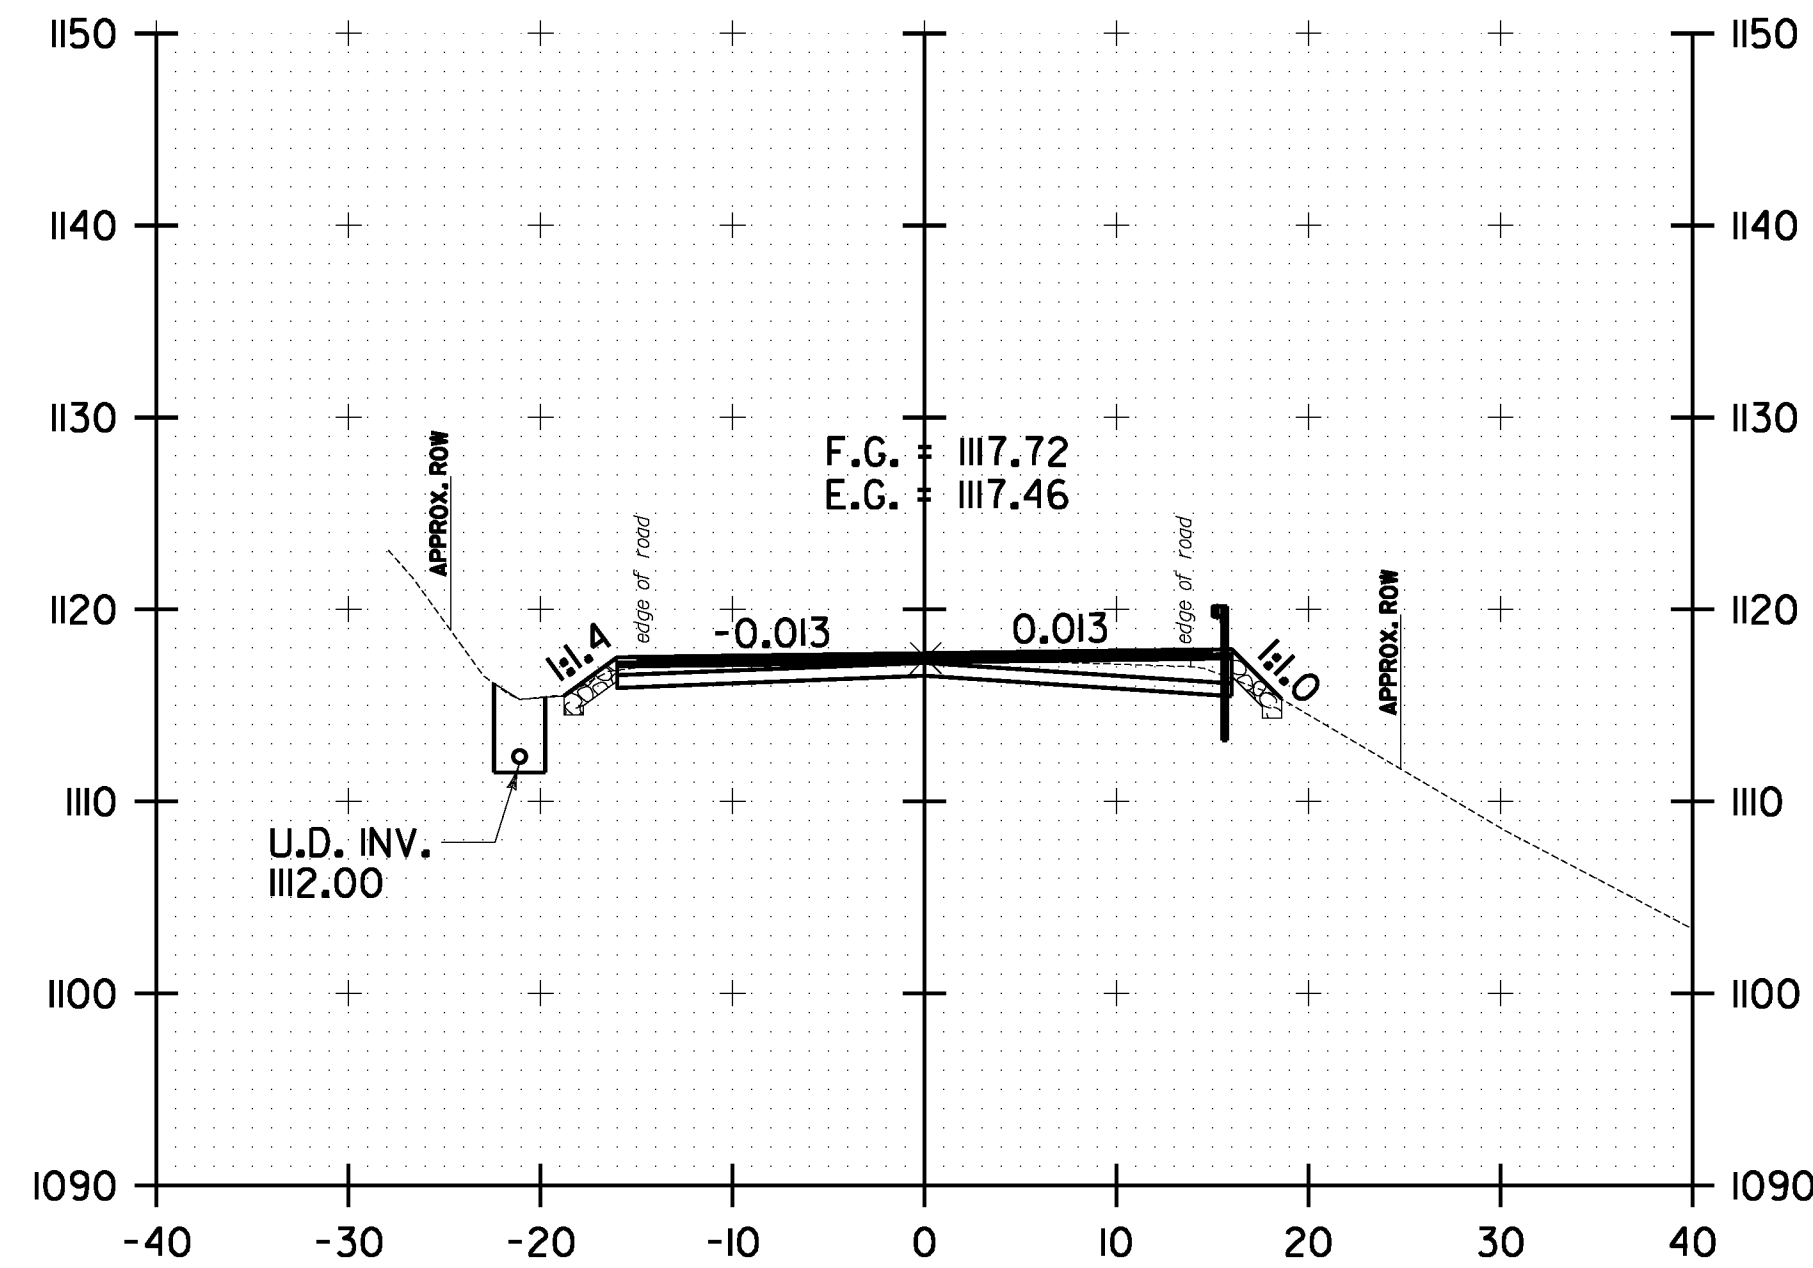


55+50.00

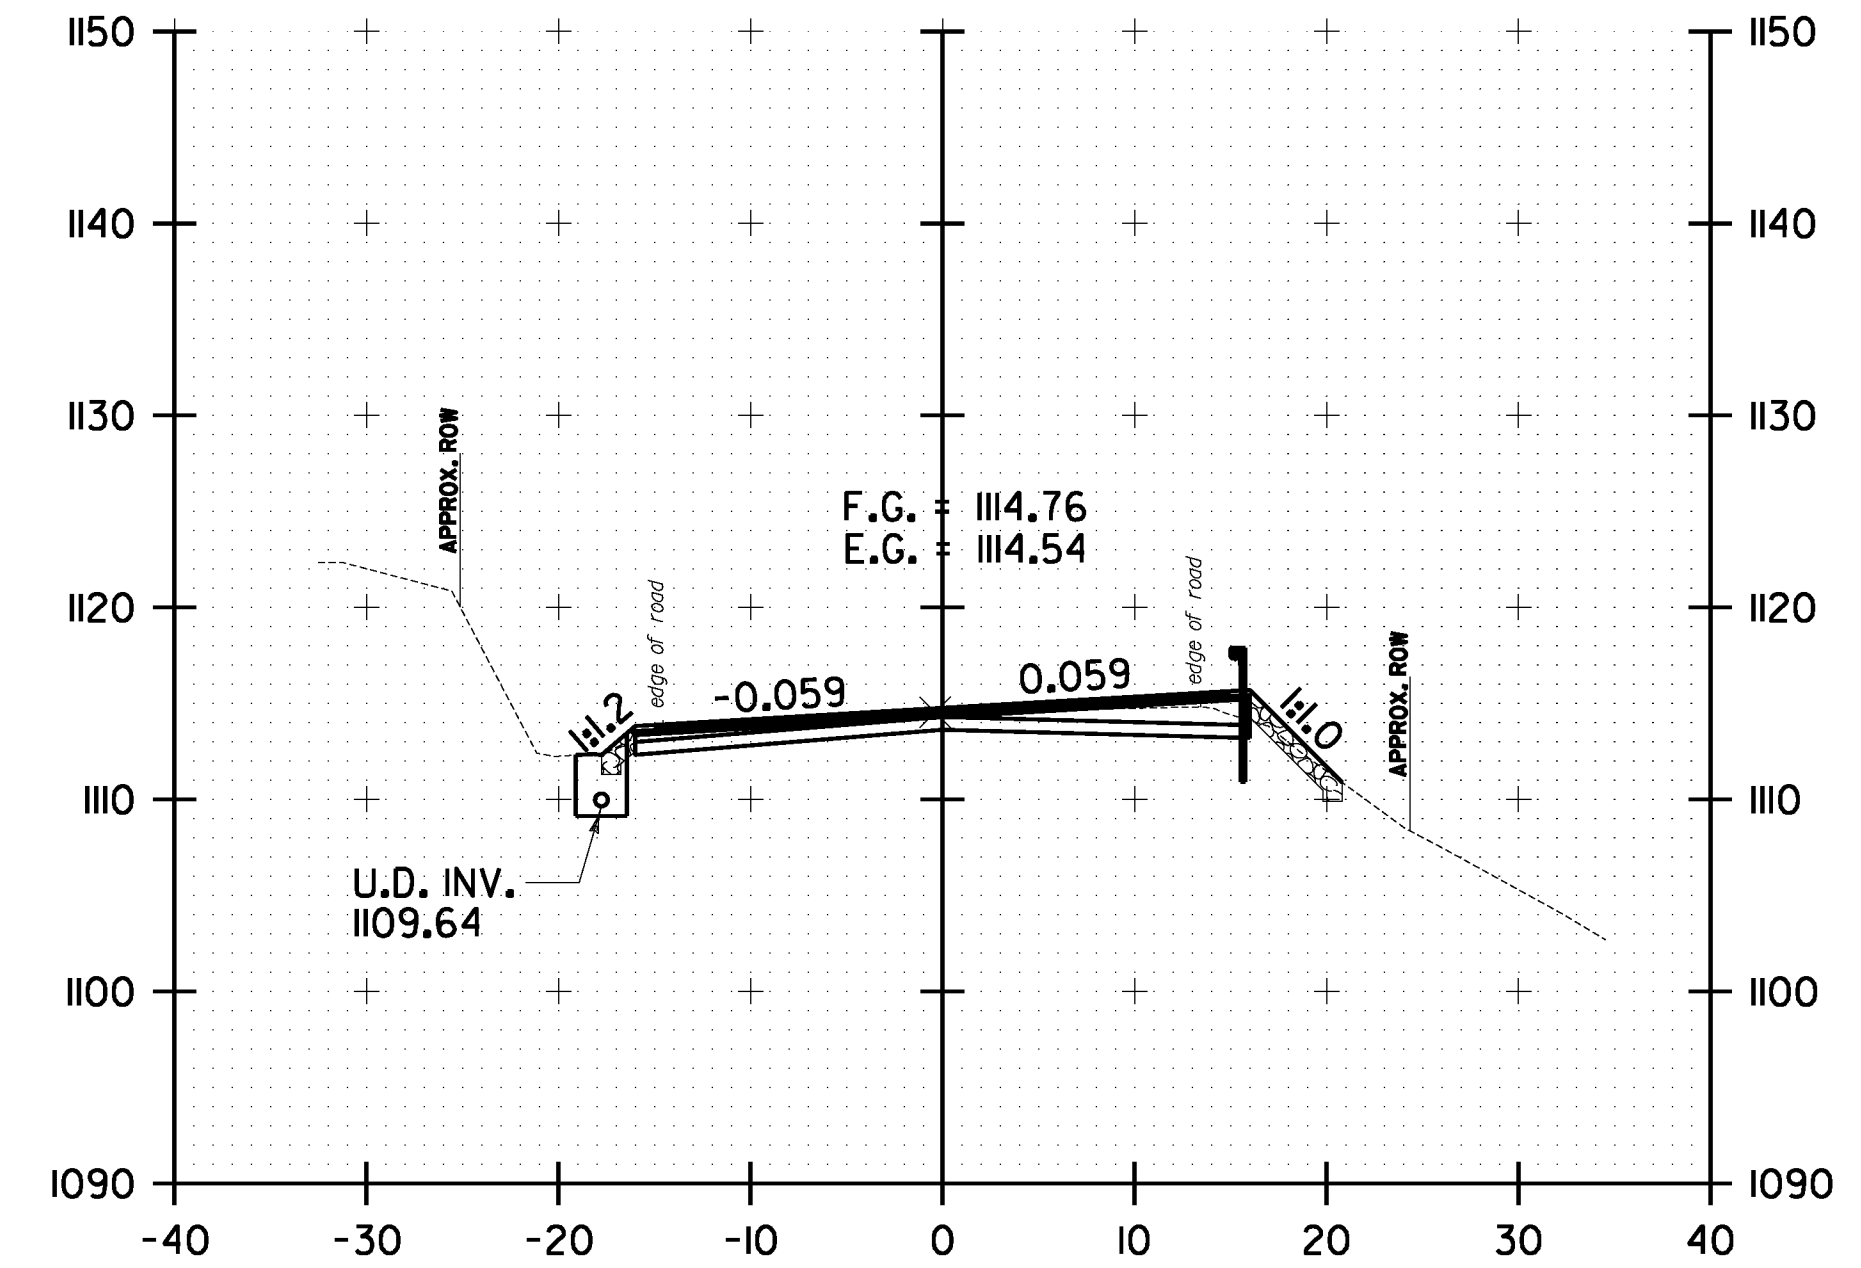


56+50.00

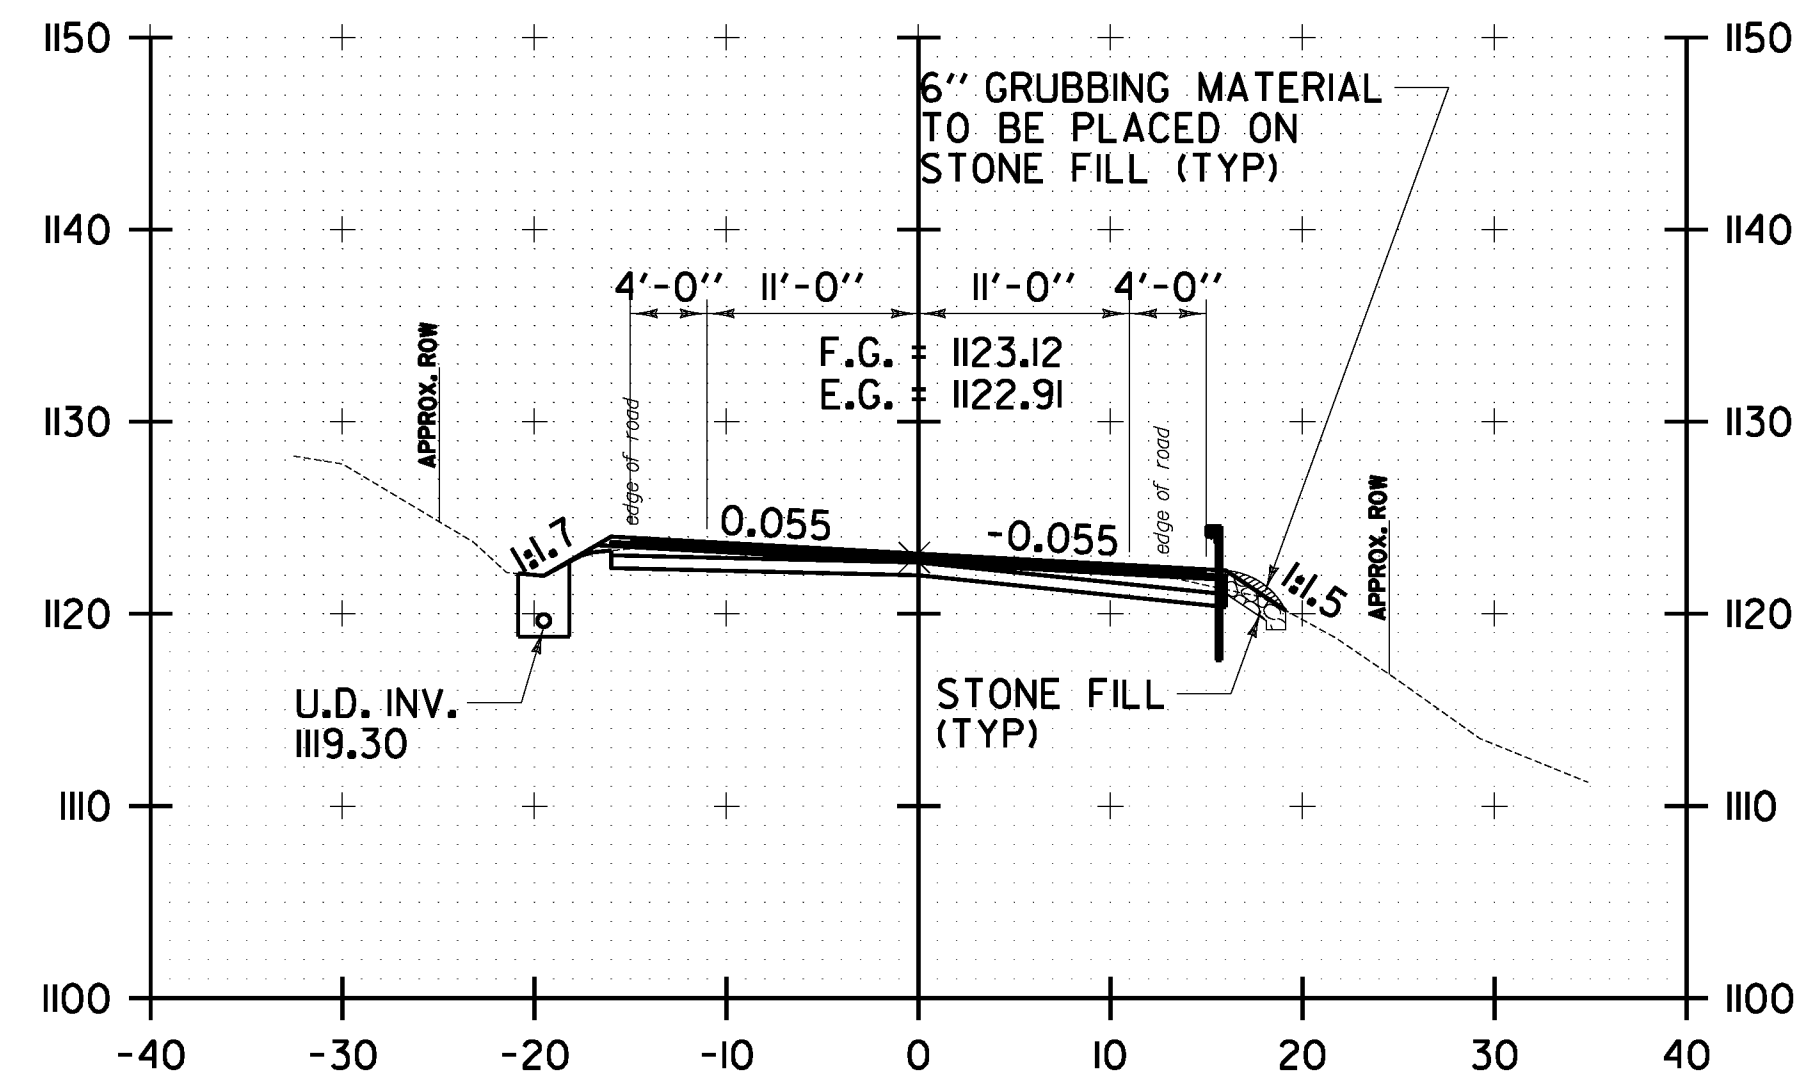

54+00.00

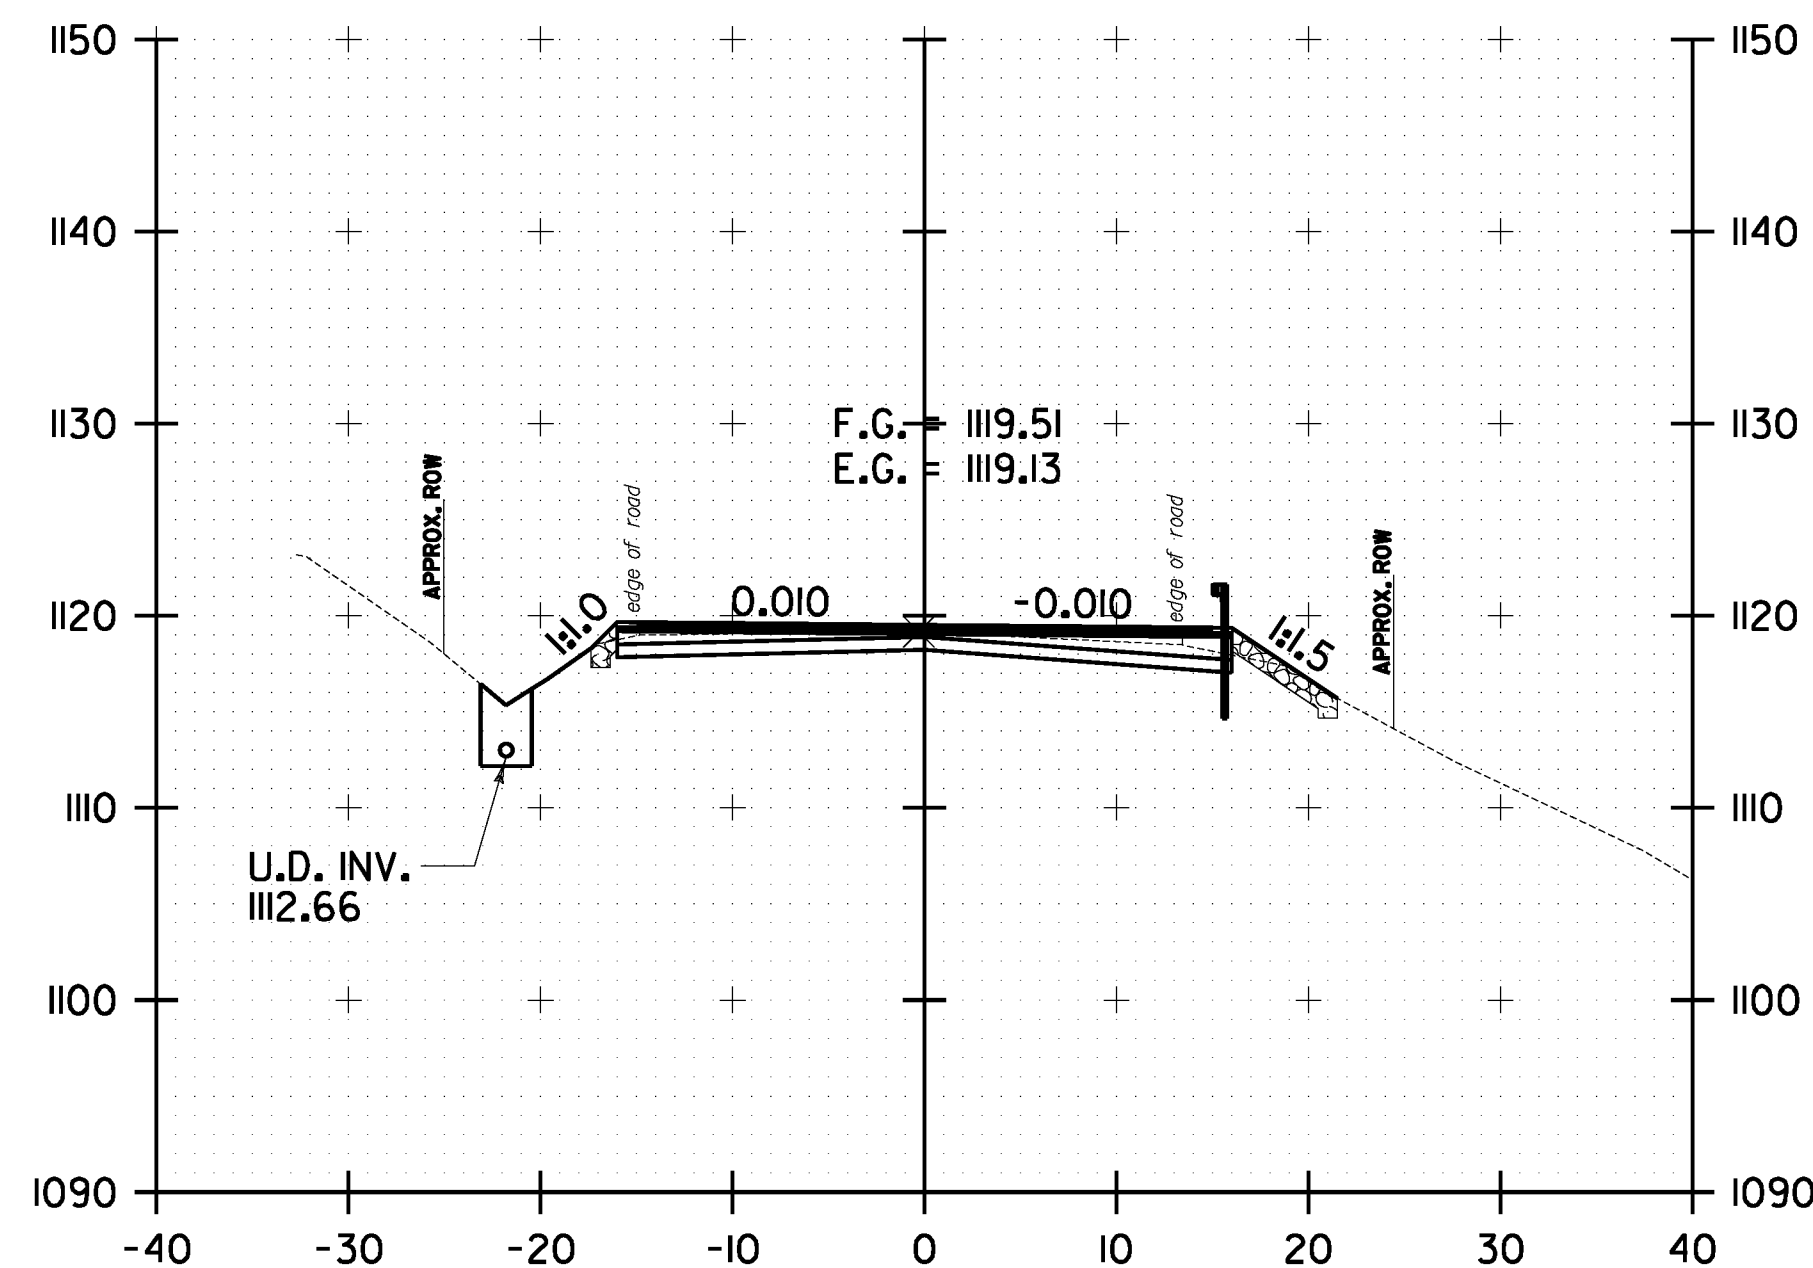

55+00.00

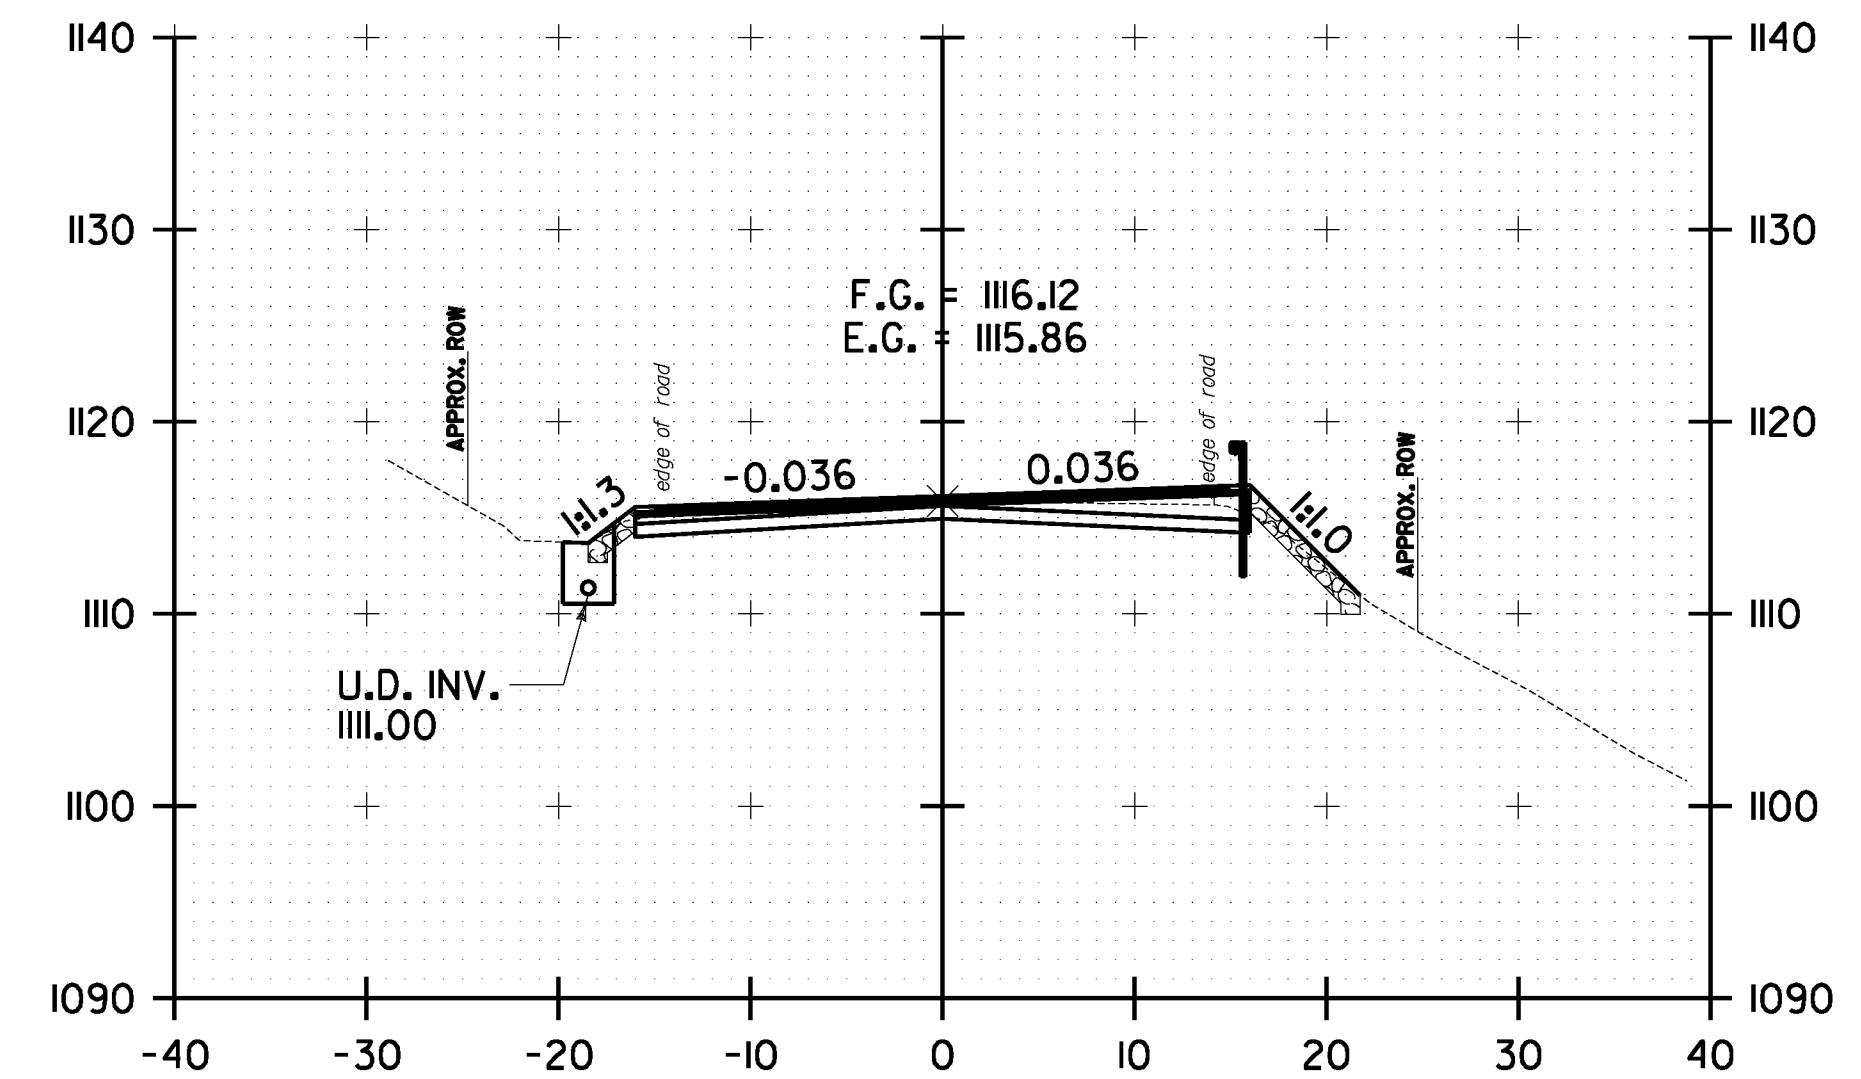

56+00.00



**WARREN
 CROSS SECTION
 SHEET #4**

PROJECT NAME: WARREN-WAITSFIELD

PROJECT NUMBER: STP 2506(1)

FILE NAME: p05b048.dgn

PROJECT LEADER: D.E.G.

DESIGNED BY: M.J.M.

IPARM FILE: p05b048xs4.I

PLOT DATE: 12/20/2012

DRAWN BY: W.G.P.

CHECKED BY: D.E.G.

SHEET 167 OF 310