
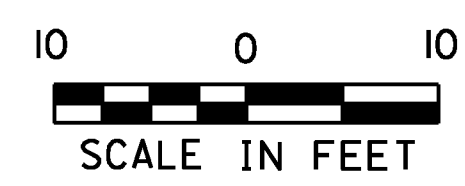
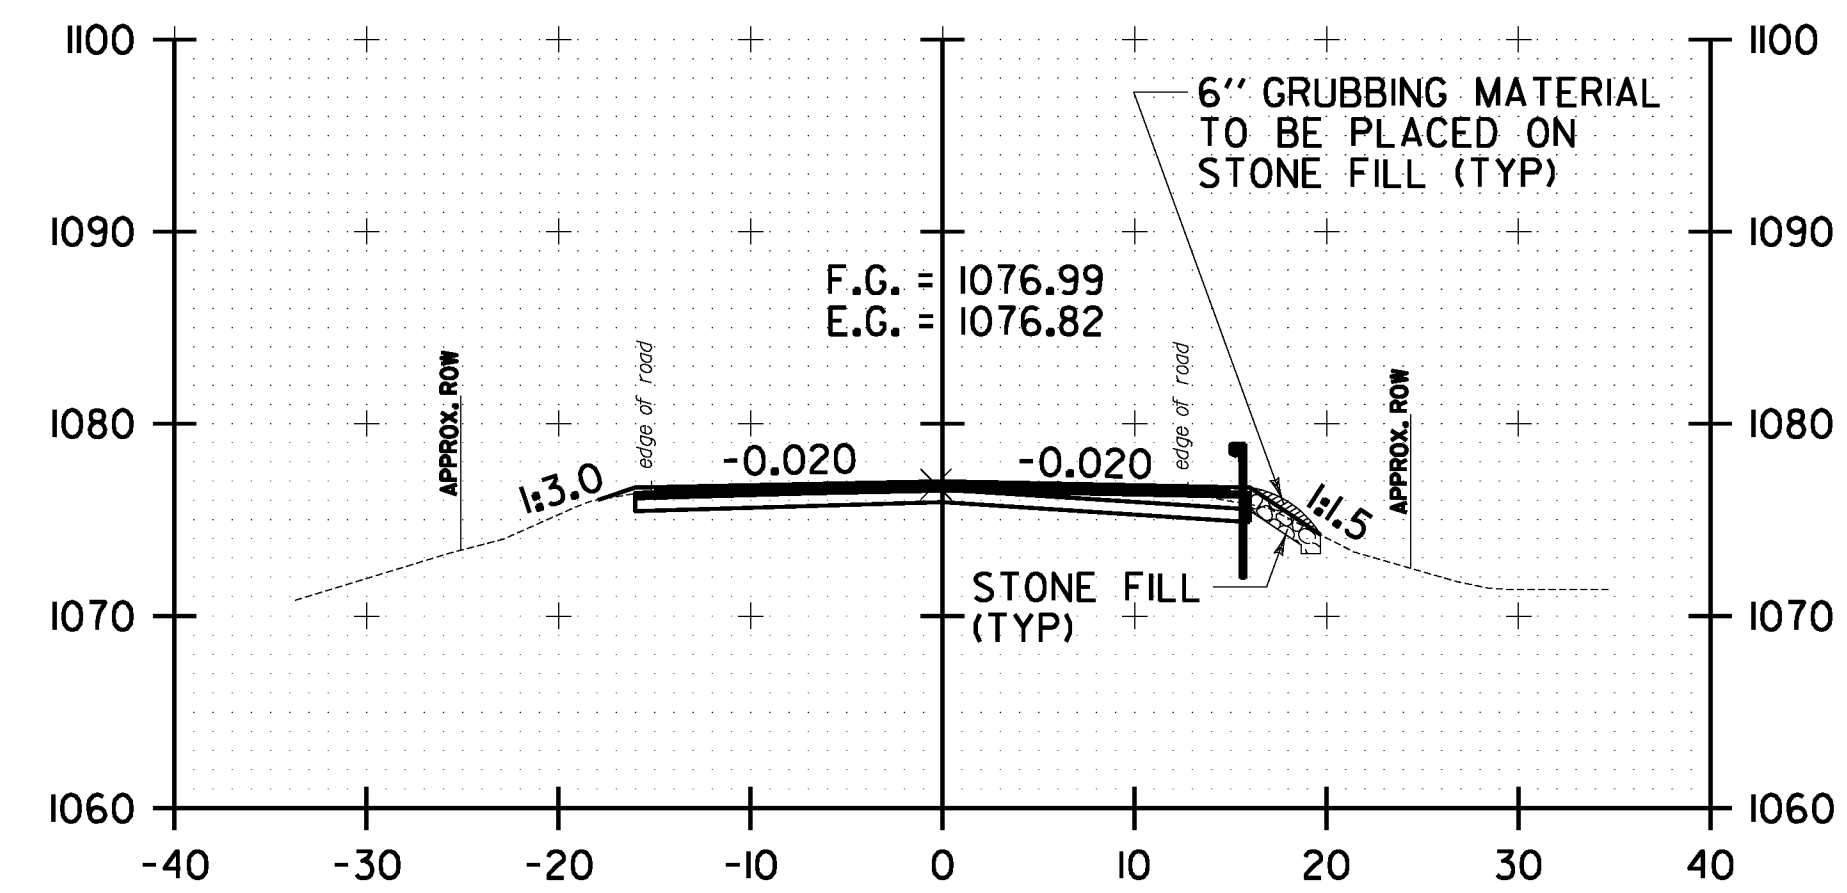
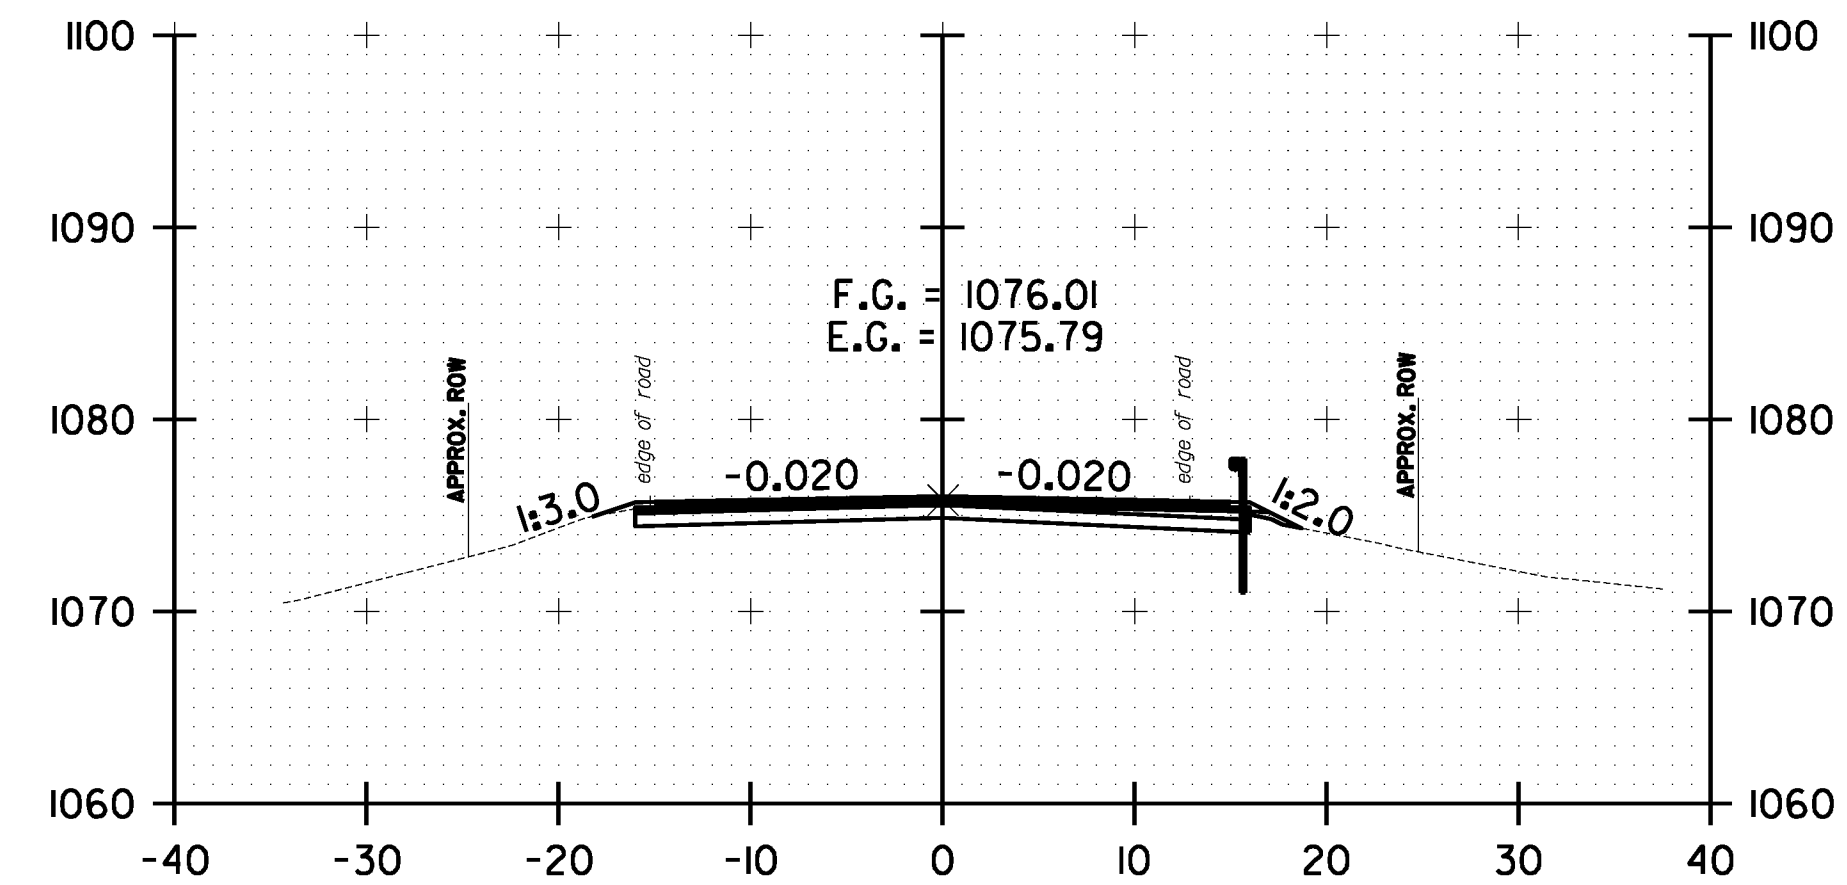
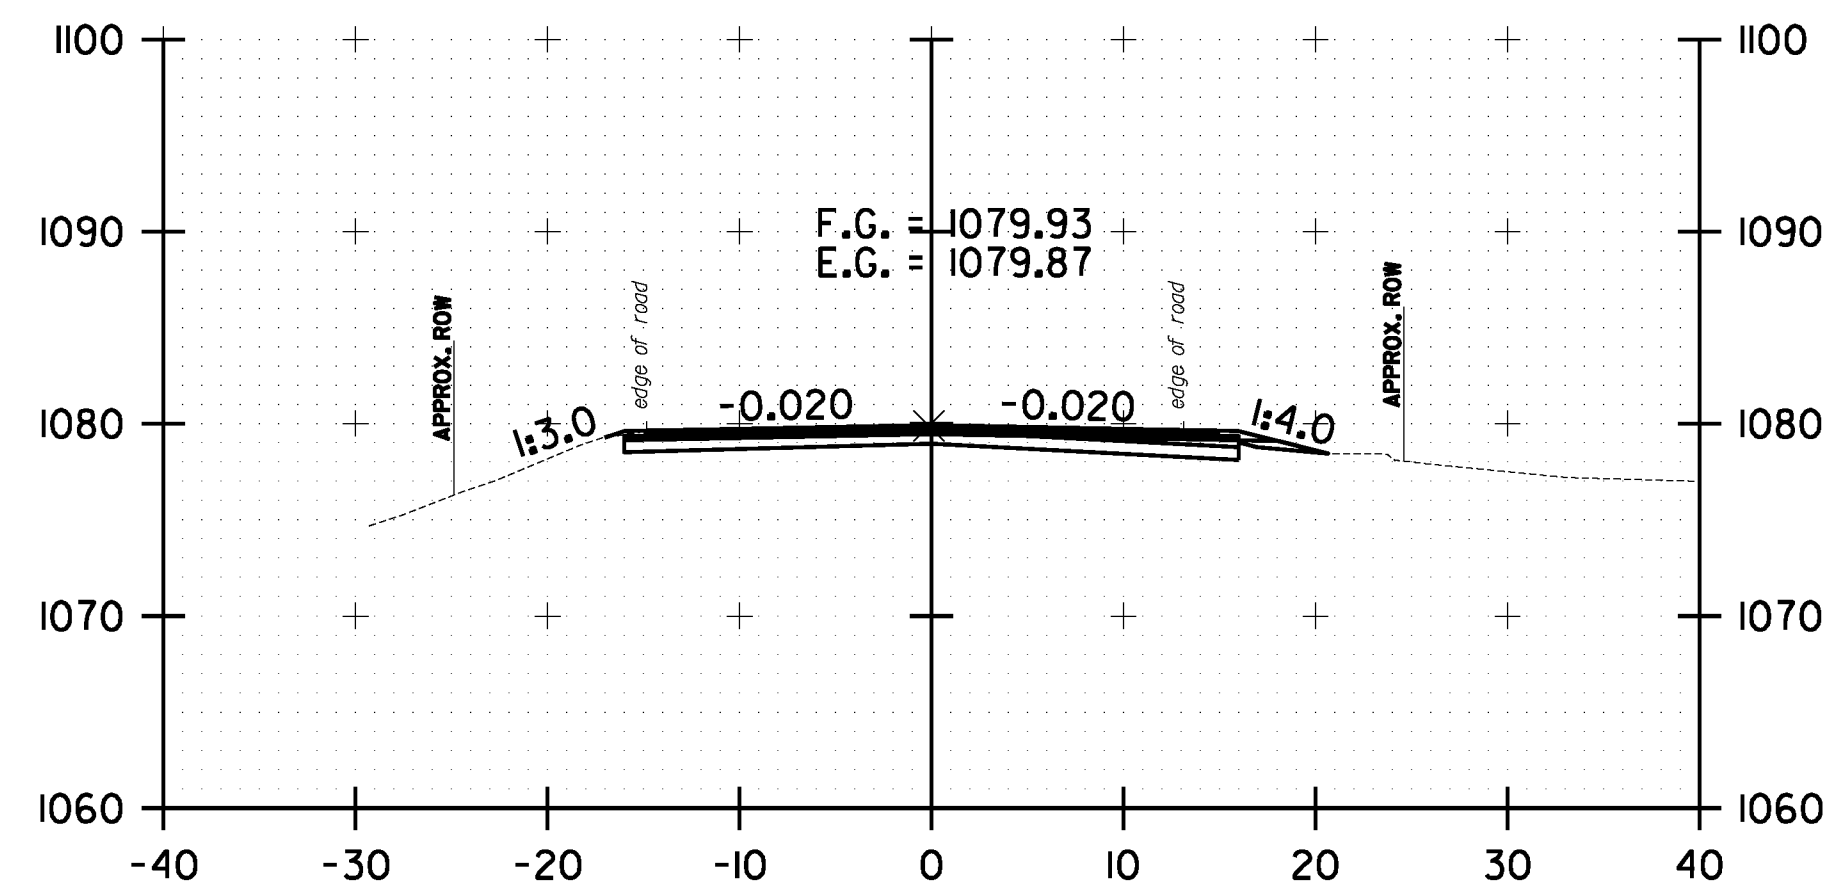
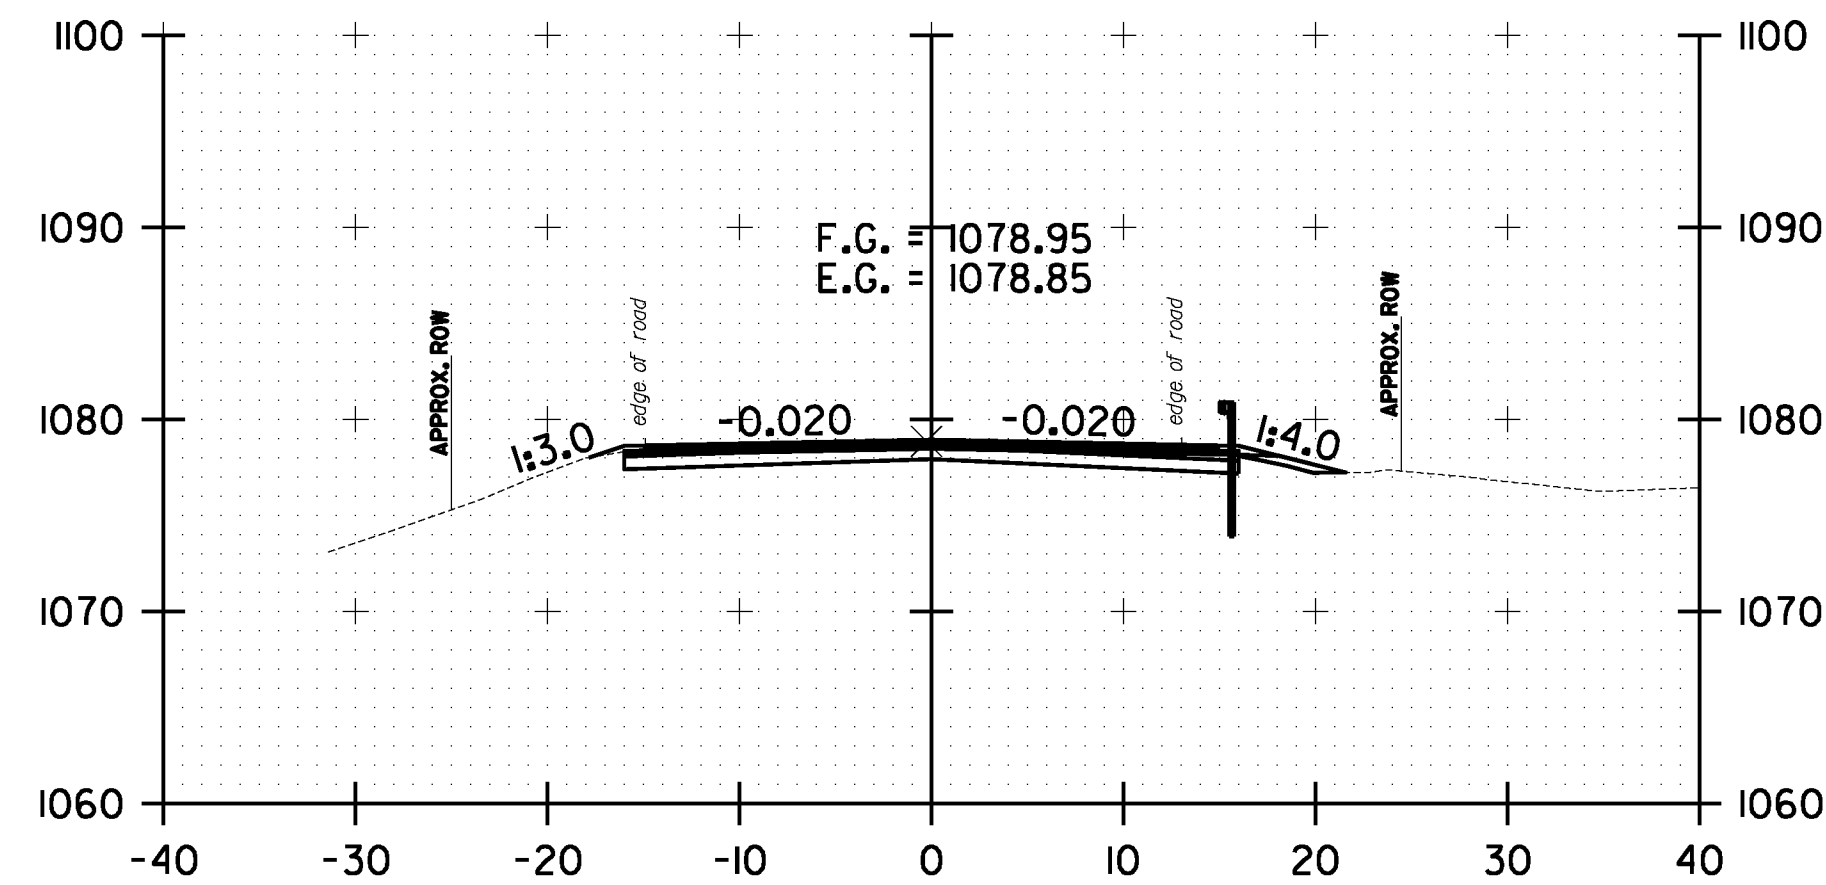
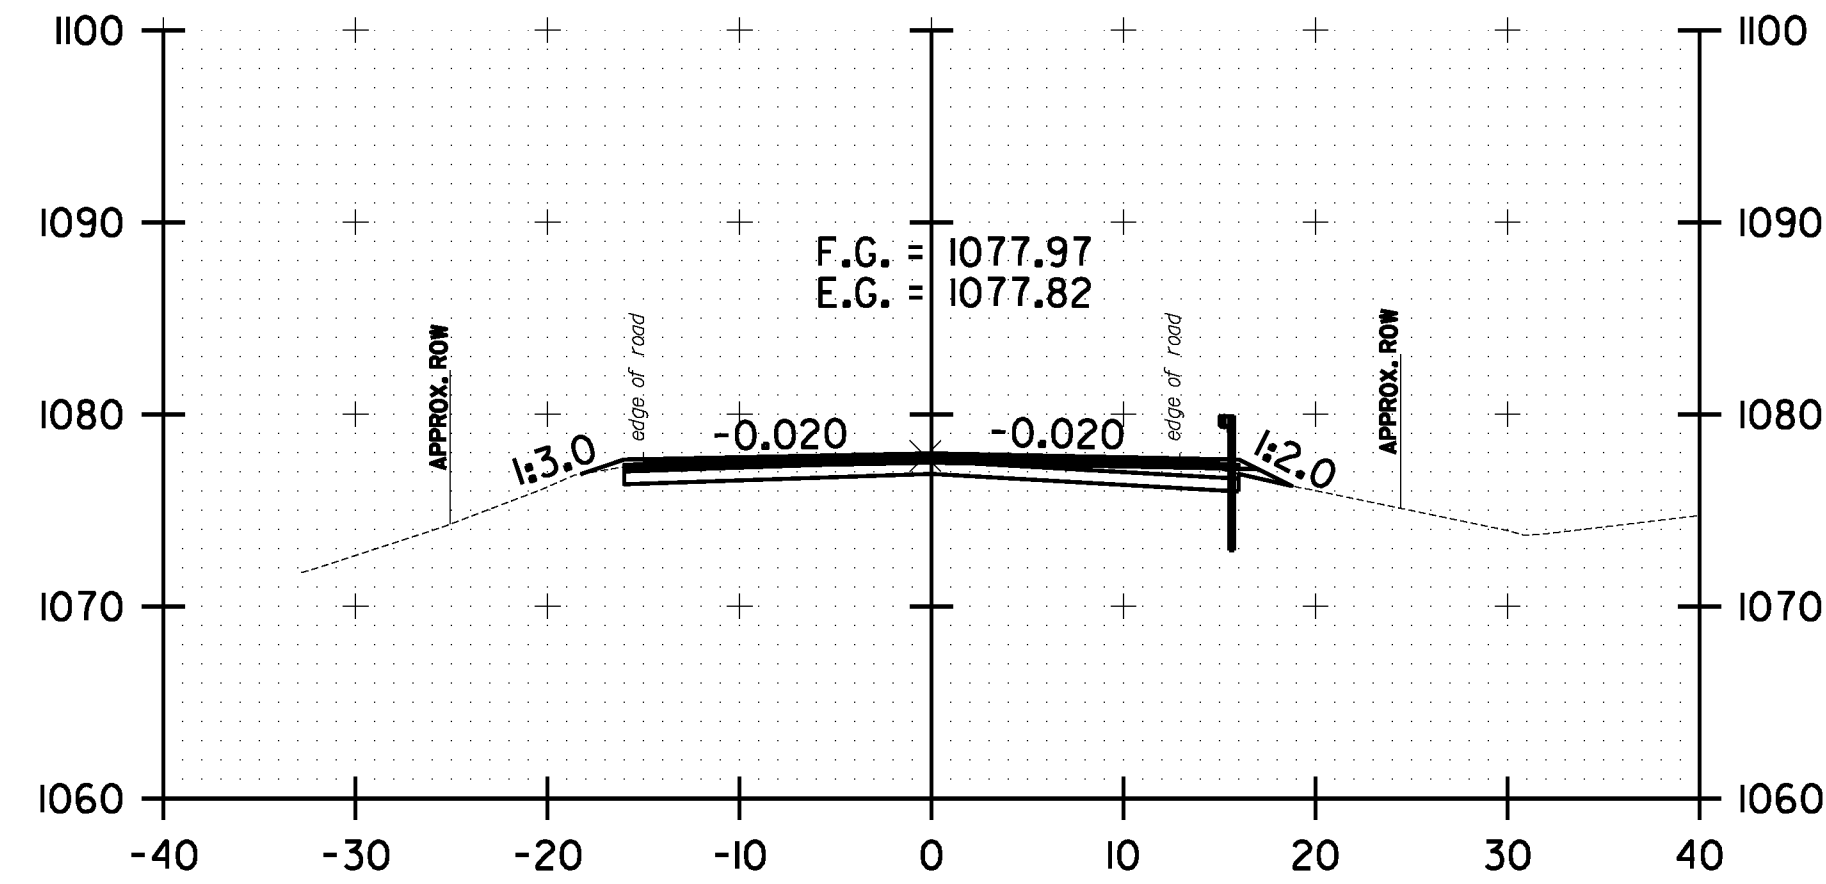
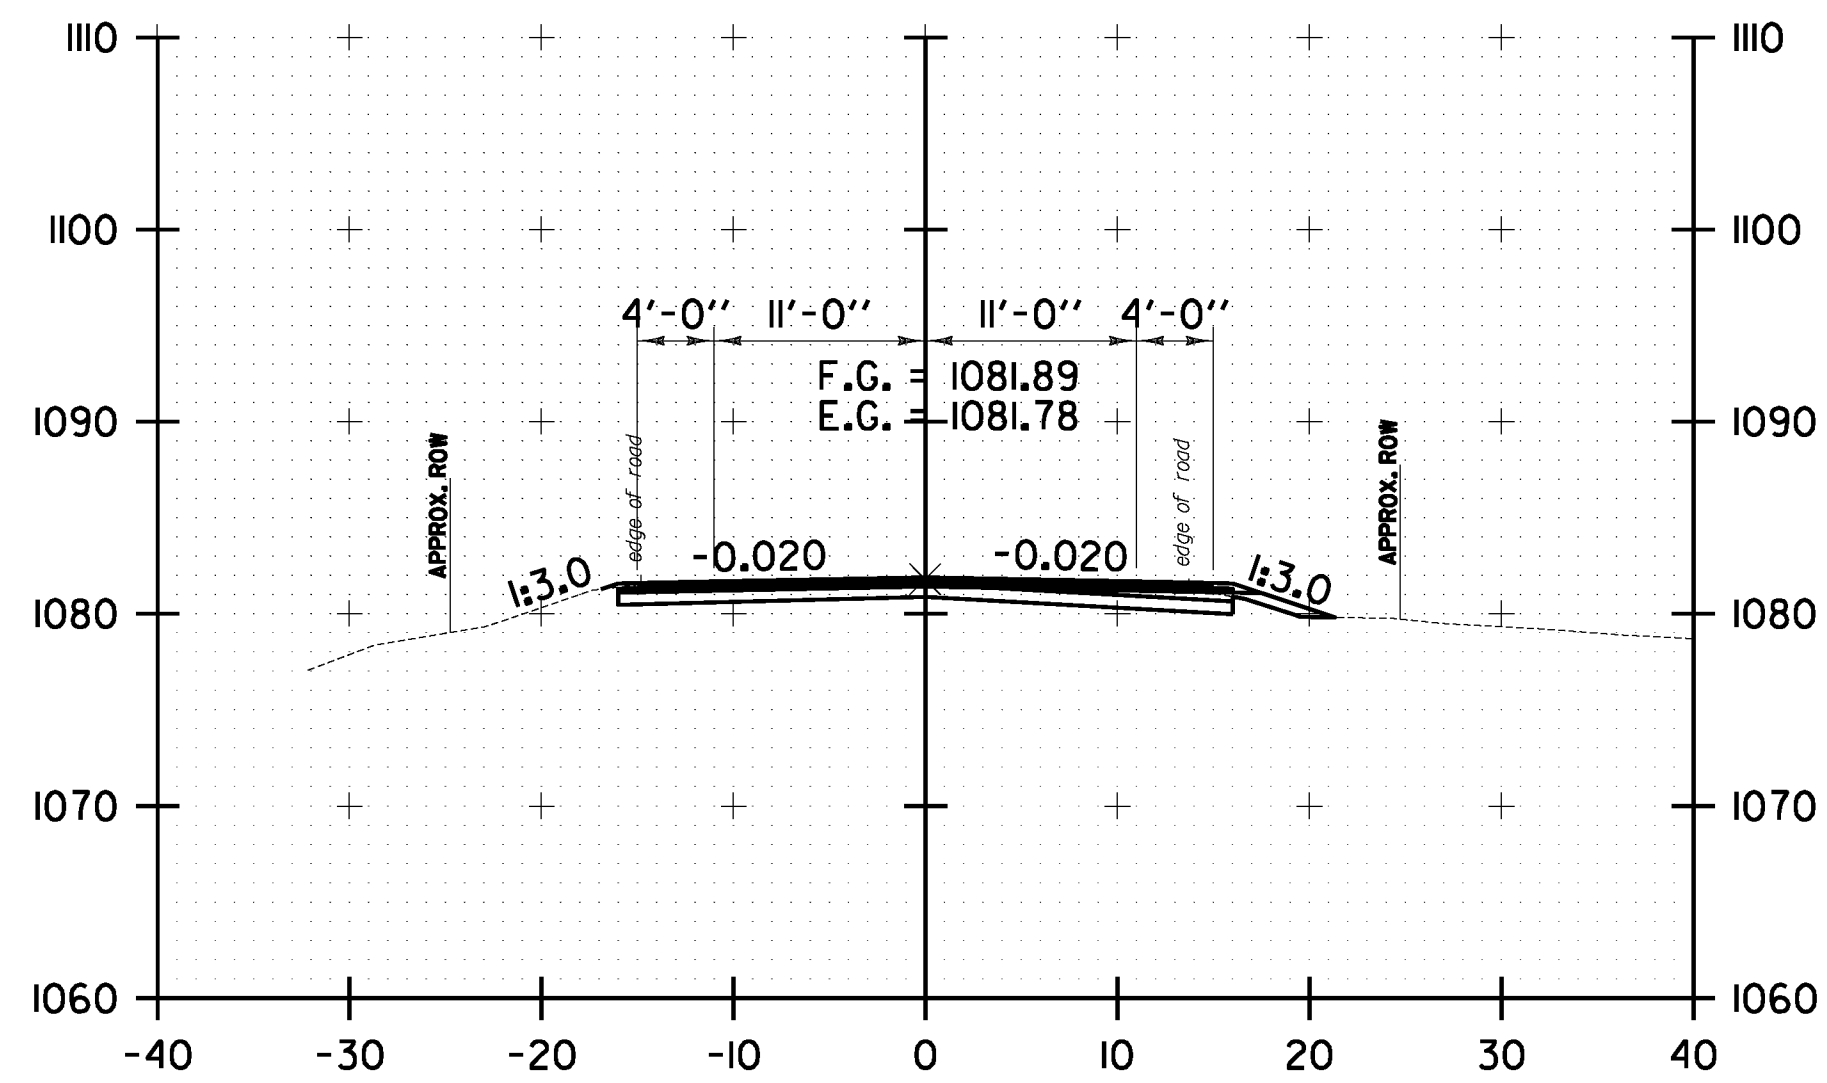


FILE NAME = U:\1762\CAOD\MSTN\STP\_2506\p05b048.Convect.Plan.dgn  
 DATE/TIME = 12/20/2012  
 USER = 4866

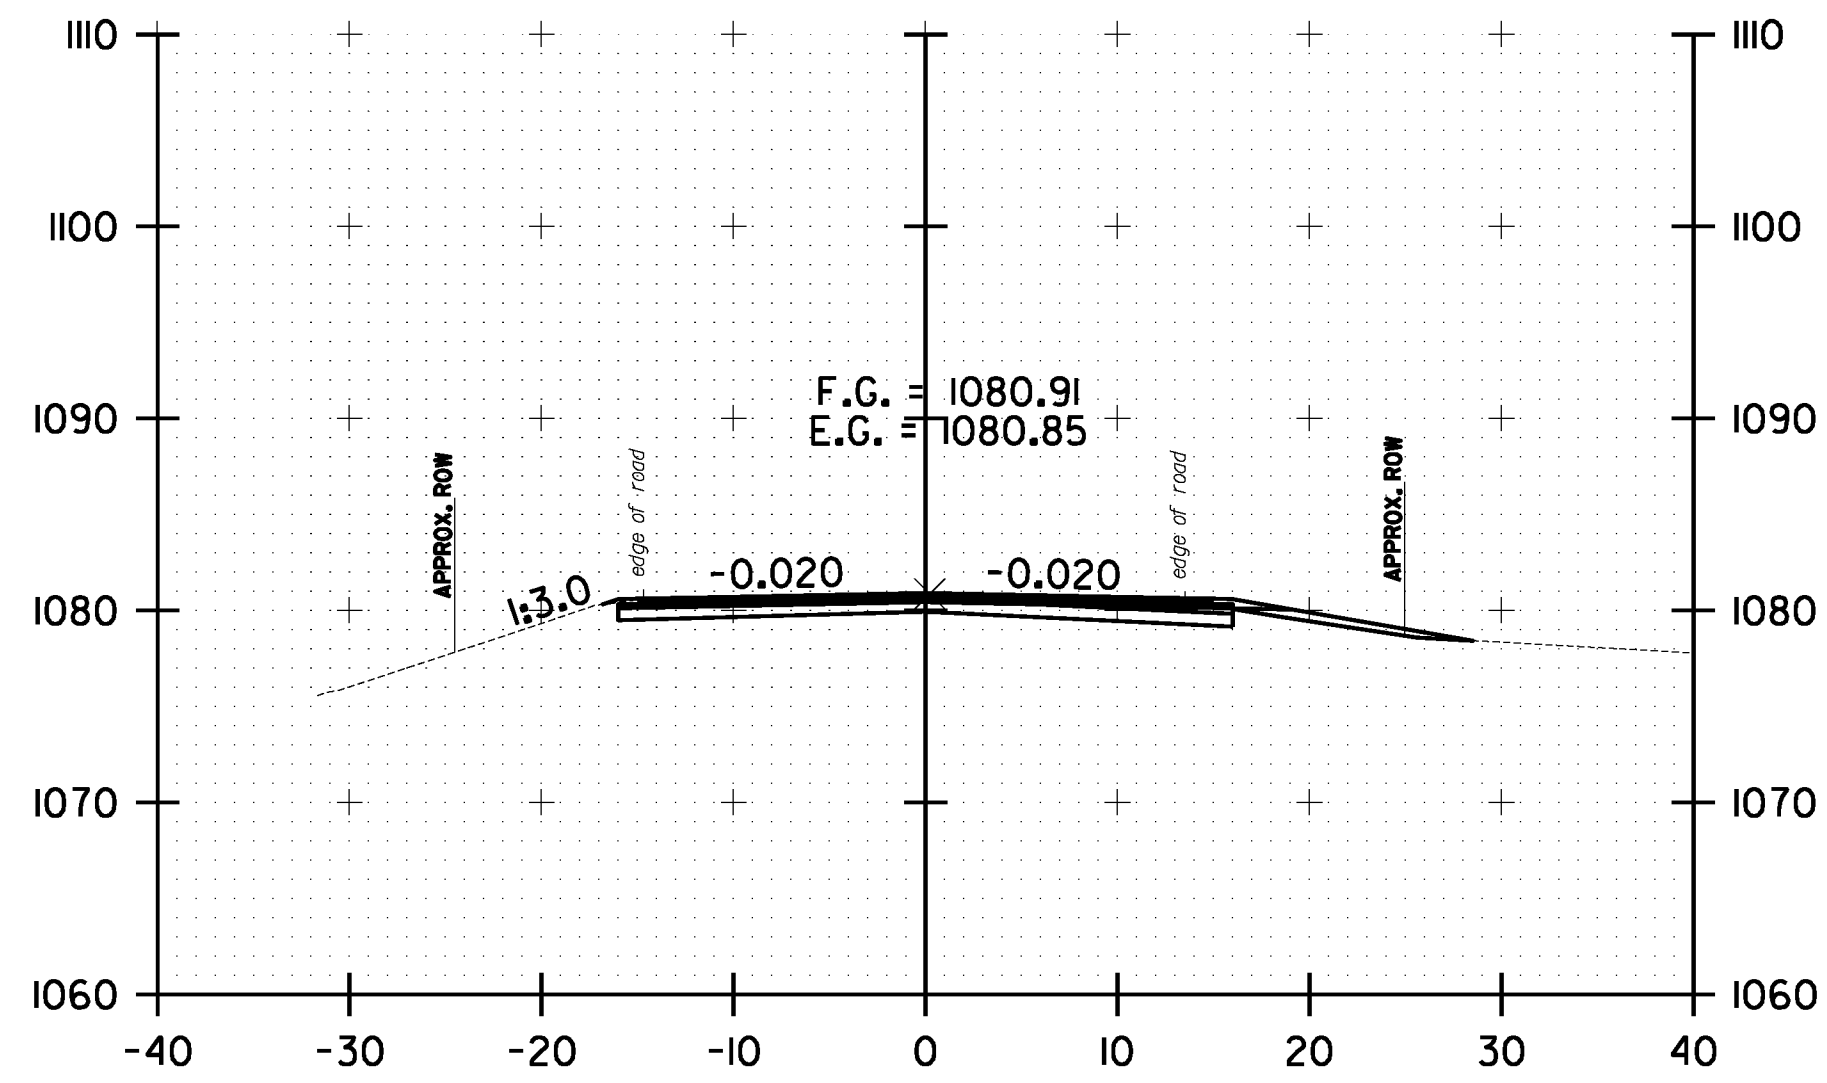

**WARREN  
 CROSS SECTION  
 SHEET #10**

PROJECT NAME: WARREN-WAITSFIELD

PROJECT NUMBER: STP 2506(1)

FILE NAME: p05b048.dgn

PROJECT LEADER: D.E.G.

DESIGNED BY: M.J.M.

IPARM FILE: p05b048xsl0.1

PLOT DATE: 12/20/2012

DRAWN BY: W.G.P.

CHECKED BY: D.E.G.

SHEET 173 OF 310