




FILE NAME: I:\1762\CA00\MST\STP\_2506\p05b048\_Conv.eas\_Plan.dgn  
 DATE/TIME: 12/20/2012  
 USER: 4866

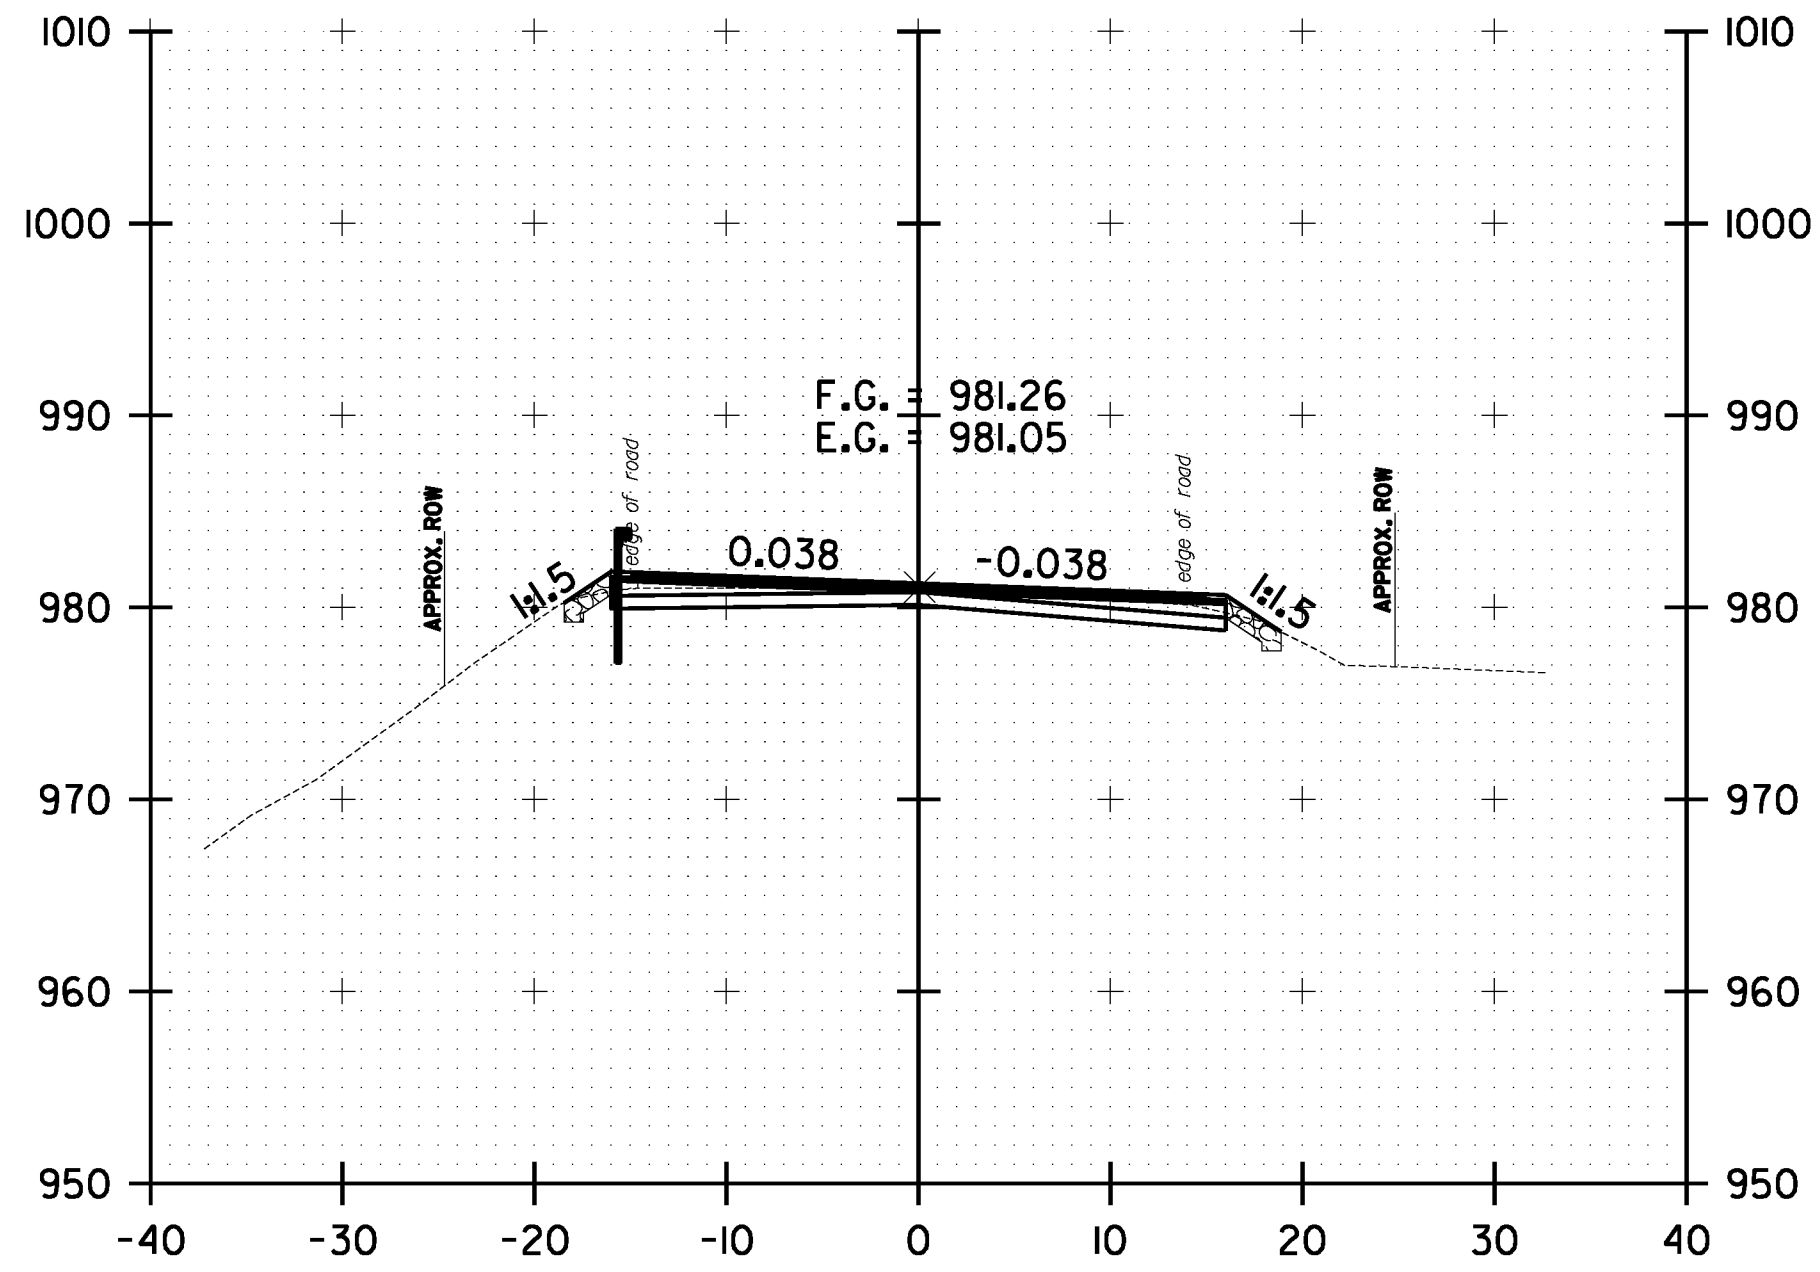


133+50.00

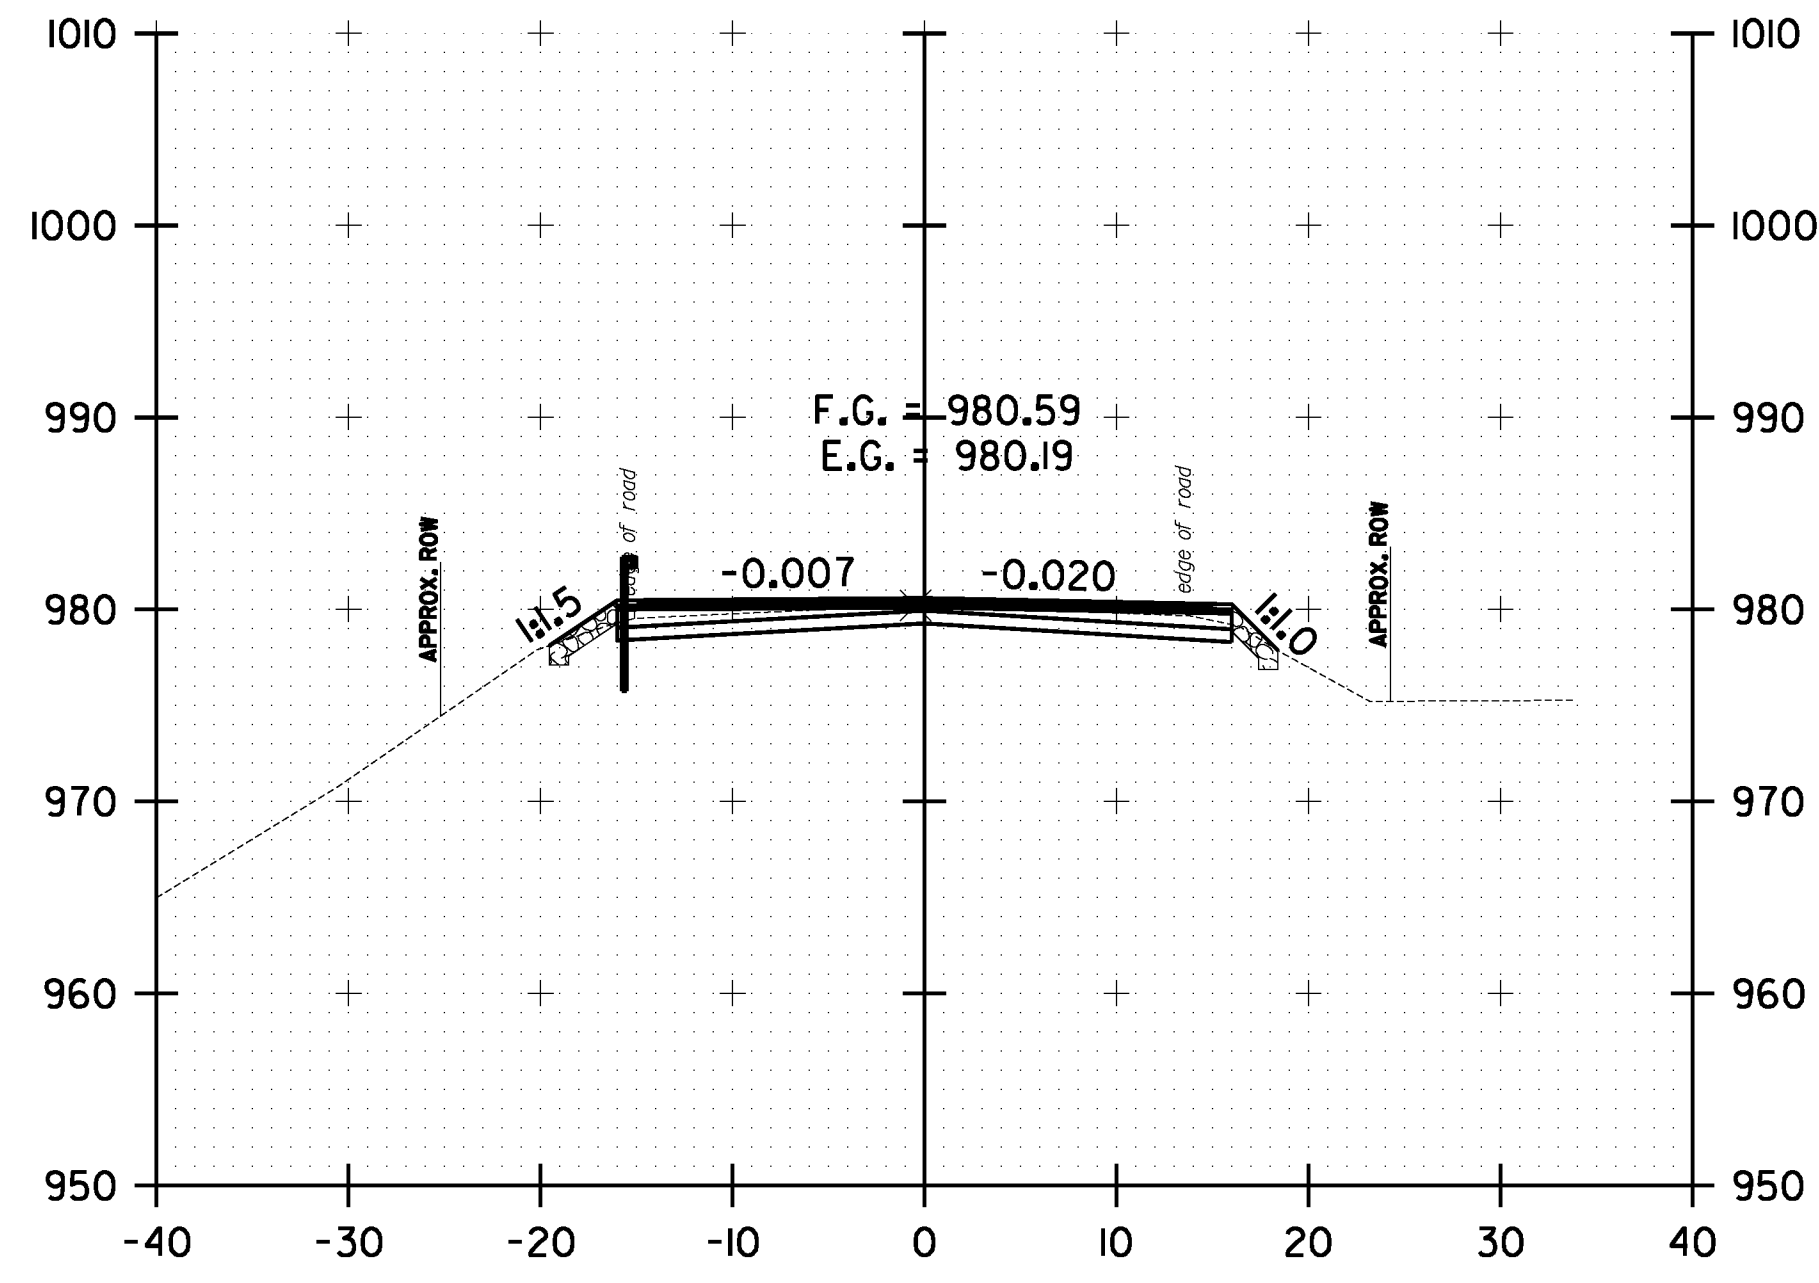


134+50.00

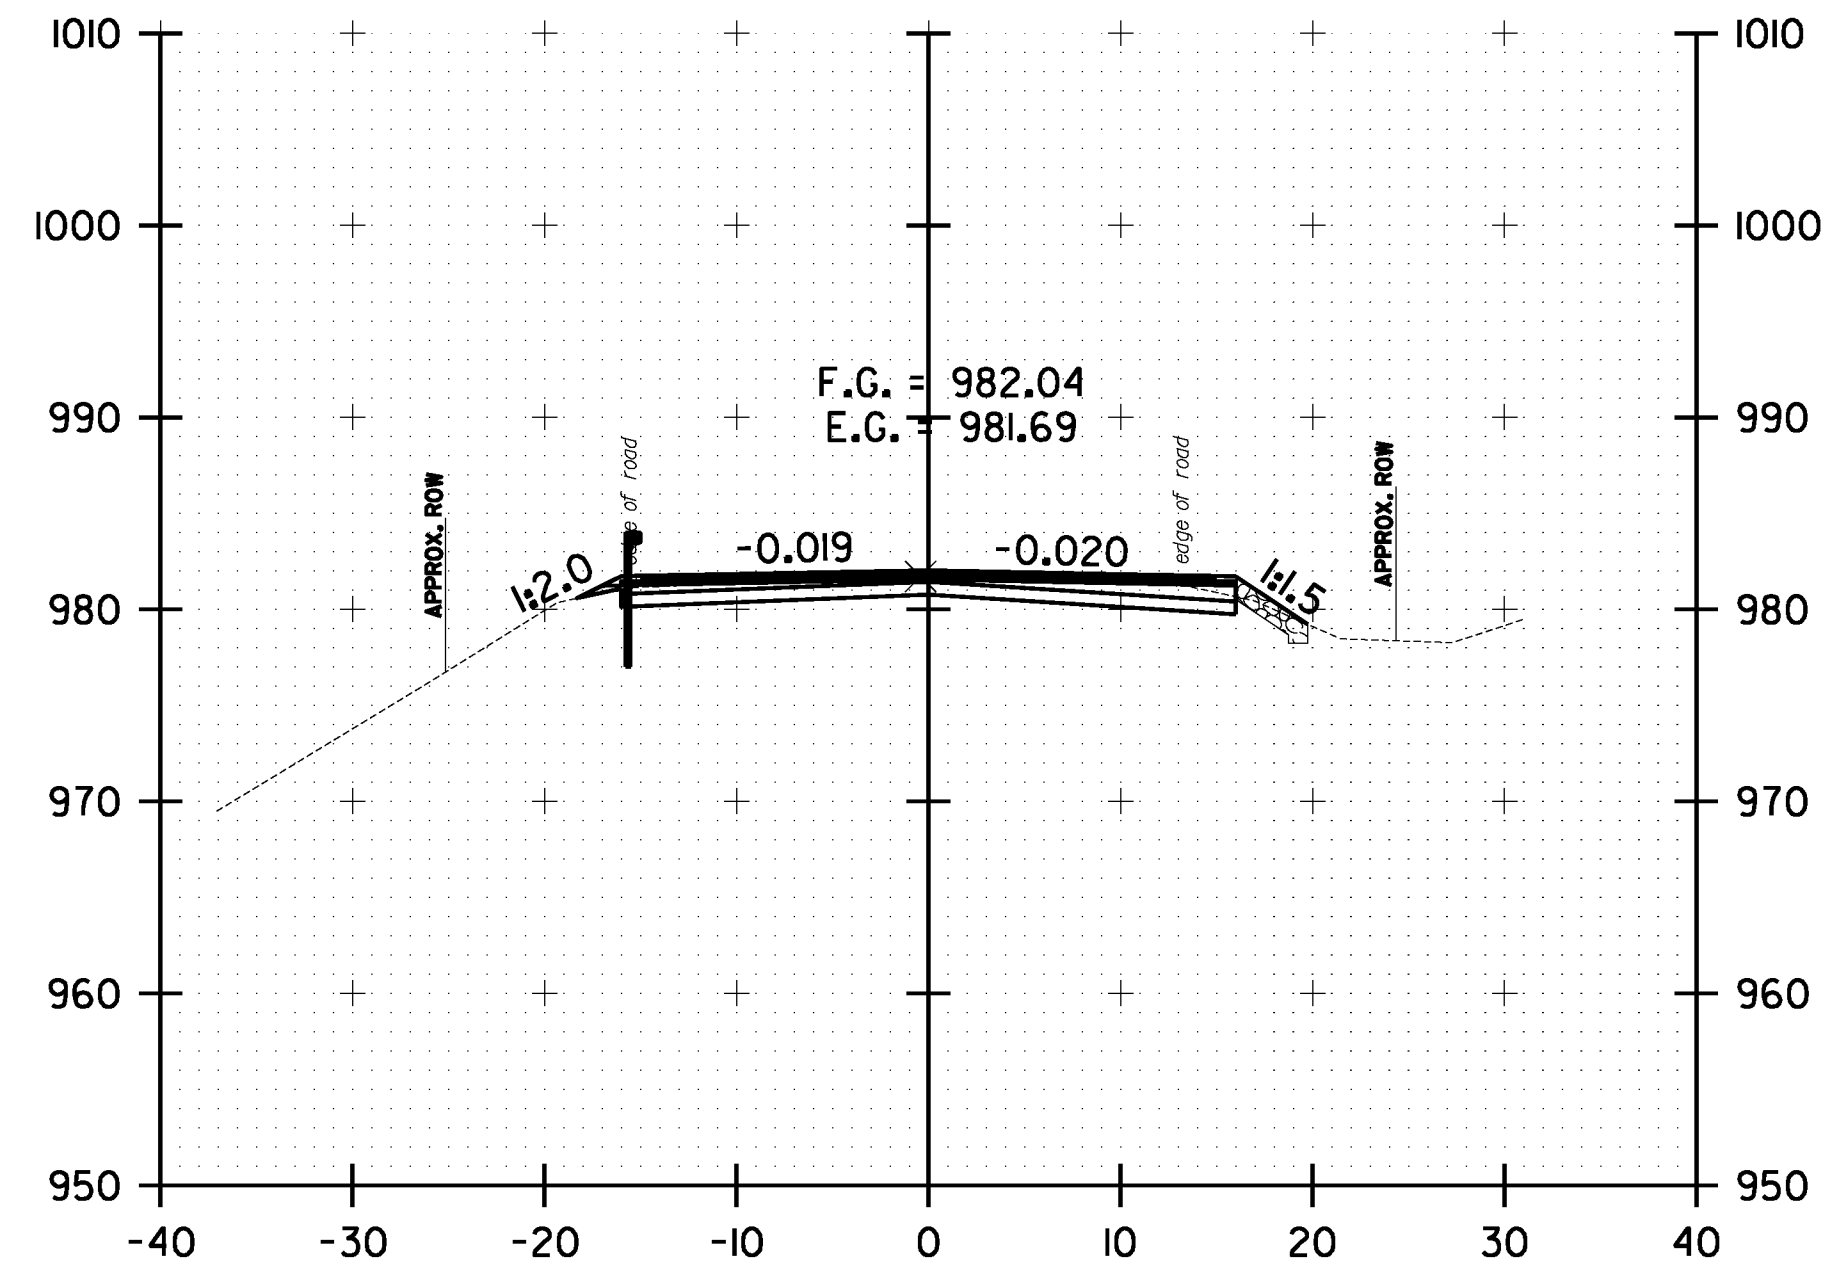


135+50.00

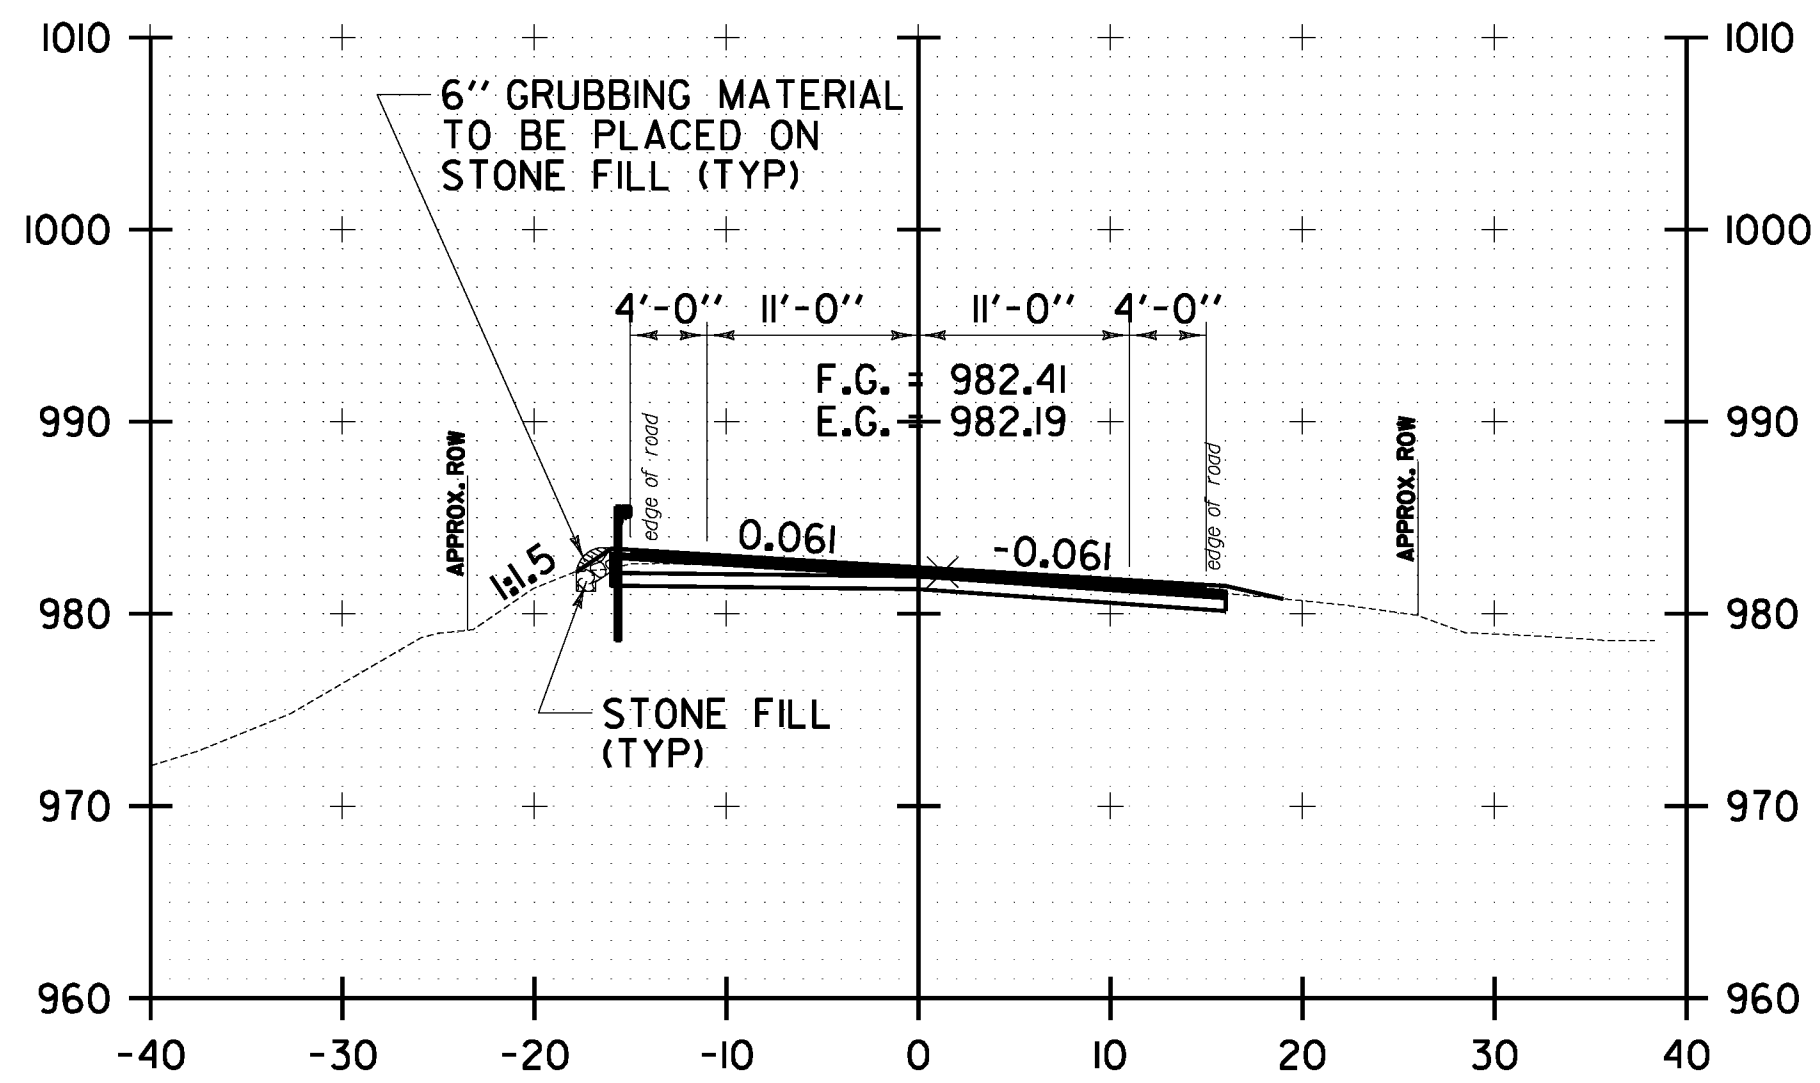

133+00.00

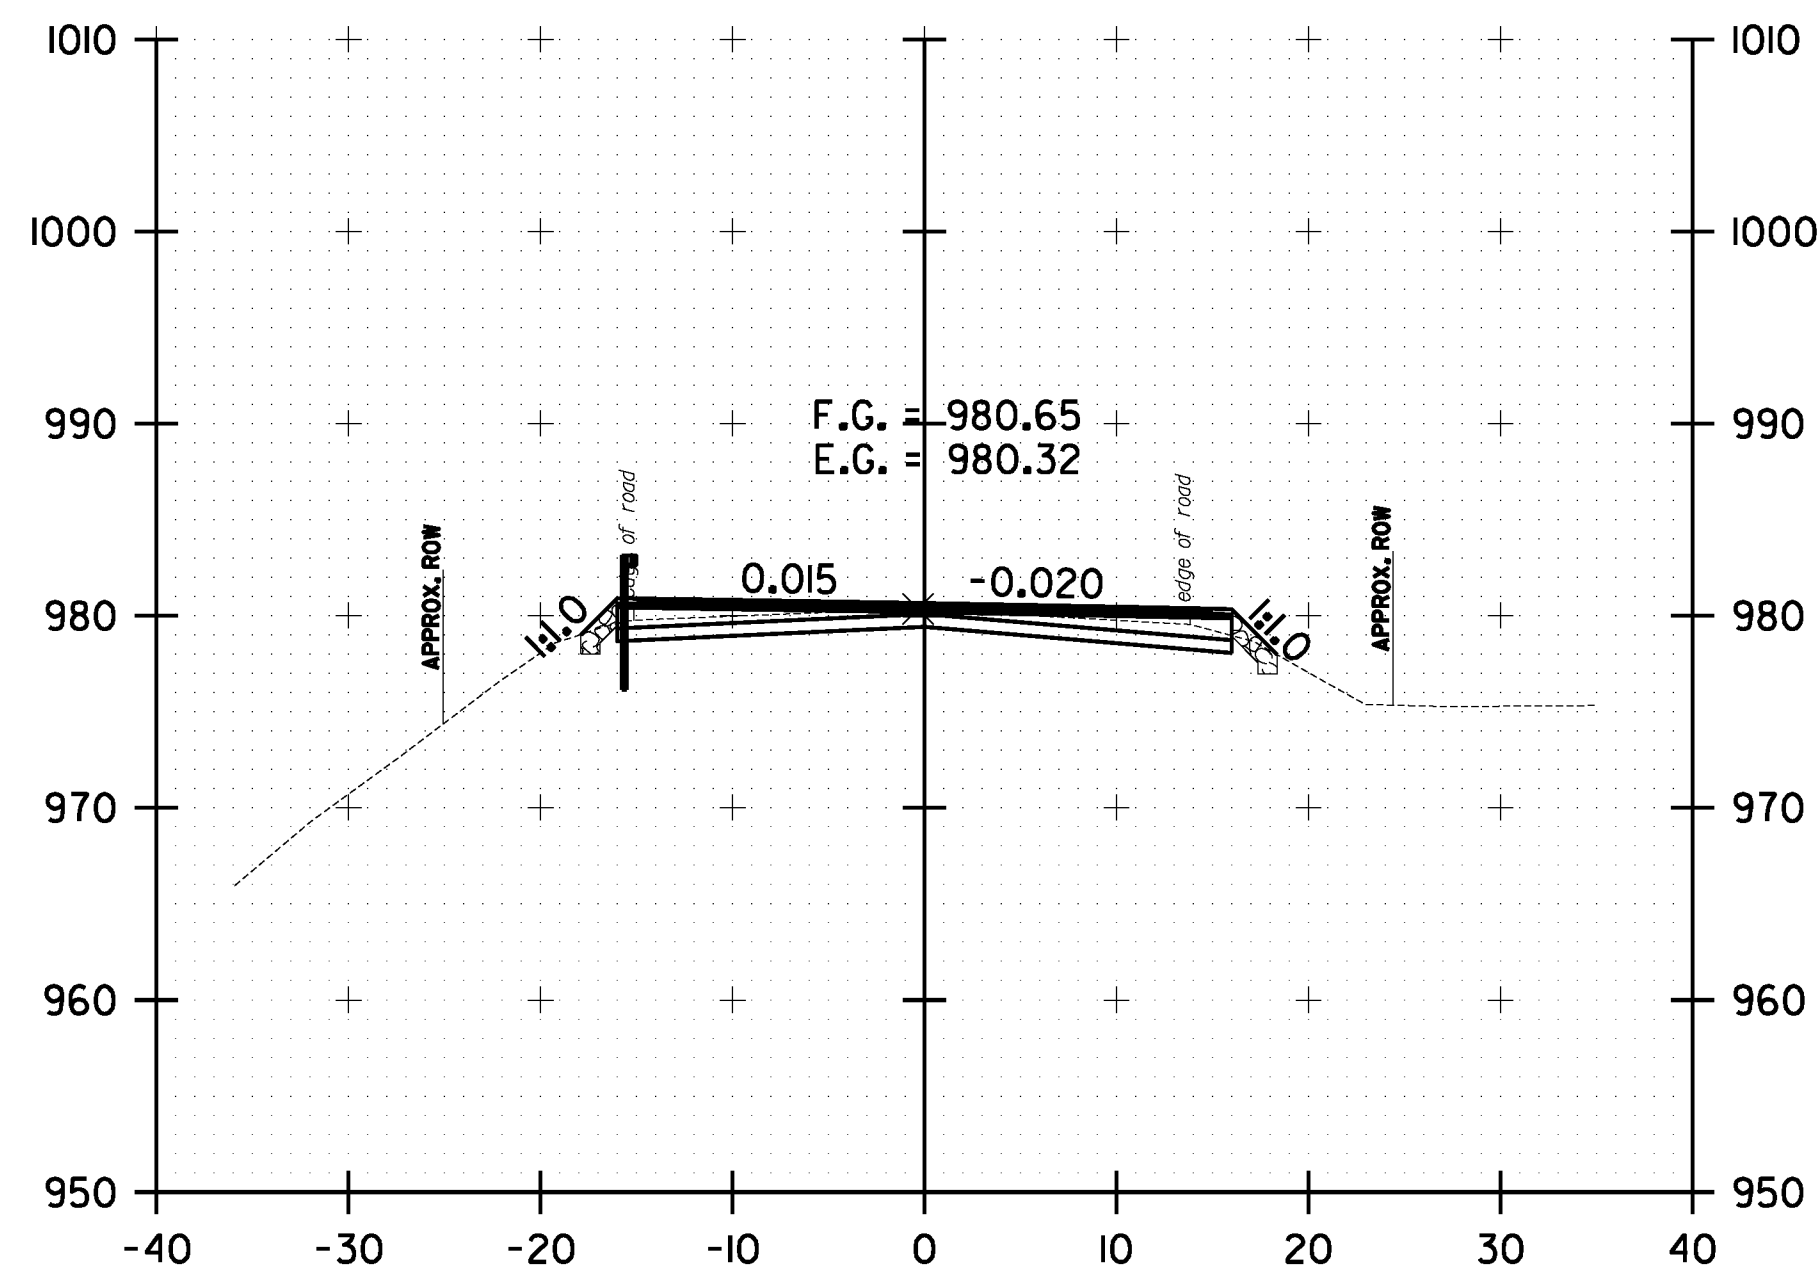

134+00.00

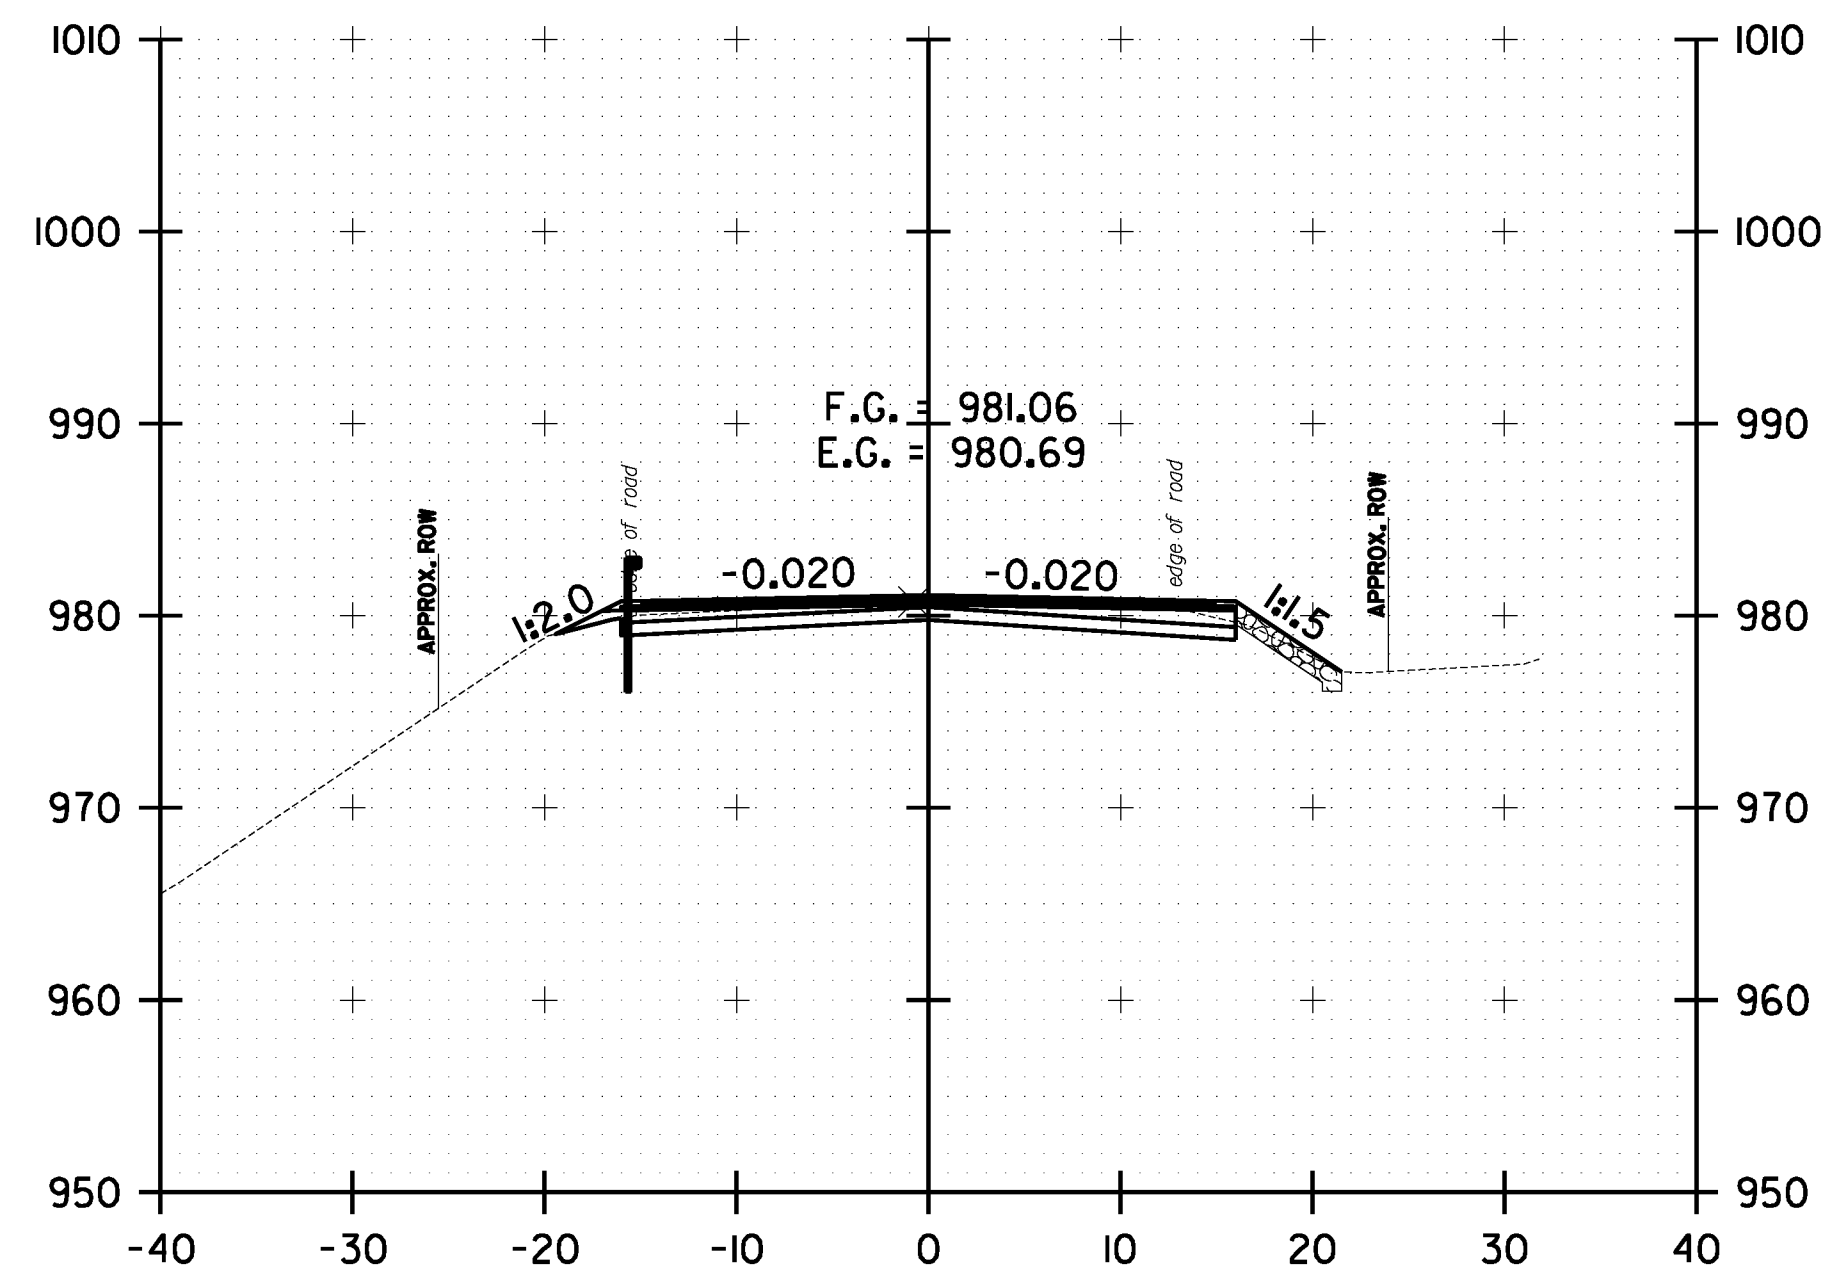

135+00.00



**WARREN  
 CROSS SECTION  
 SHEET #30**

PROJECT NAME: WARREN-WAITSFIELD

PROJECT NUMBER: STP 2506(1)

FILE NAME: p05b048.dgn

PROJECT LEADER: D.E.G.

DESIGNED BY: M.J.M.

IPARM FILE: p05b048xs30.j

PLOT DATE: 12/20/2012

DRAWN BY: W.G.P.

CHECKED BY: D.E.G.

SHEET 193 OF 310