




FILE NAME: U:\1762\CA00\MSTN\STP_2506\p05b048_Conv.eas_Plan.dgn
 DATE/TIME: 12/20/2012
 USER: 4866

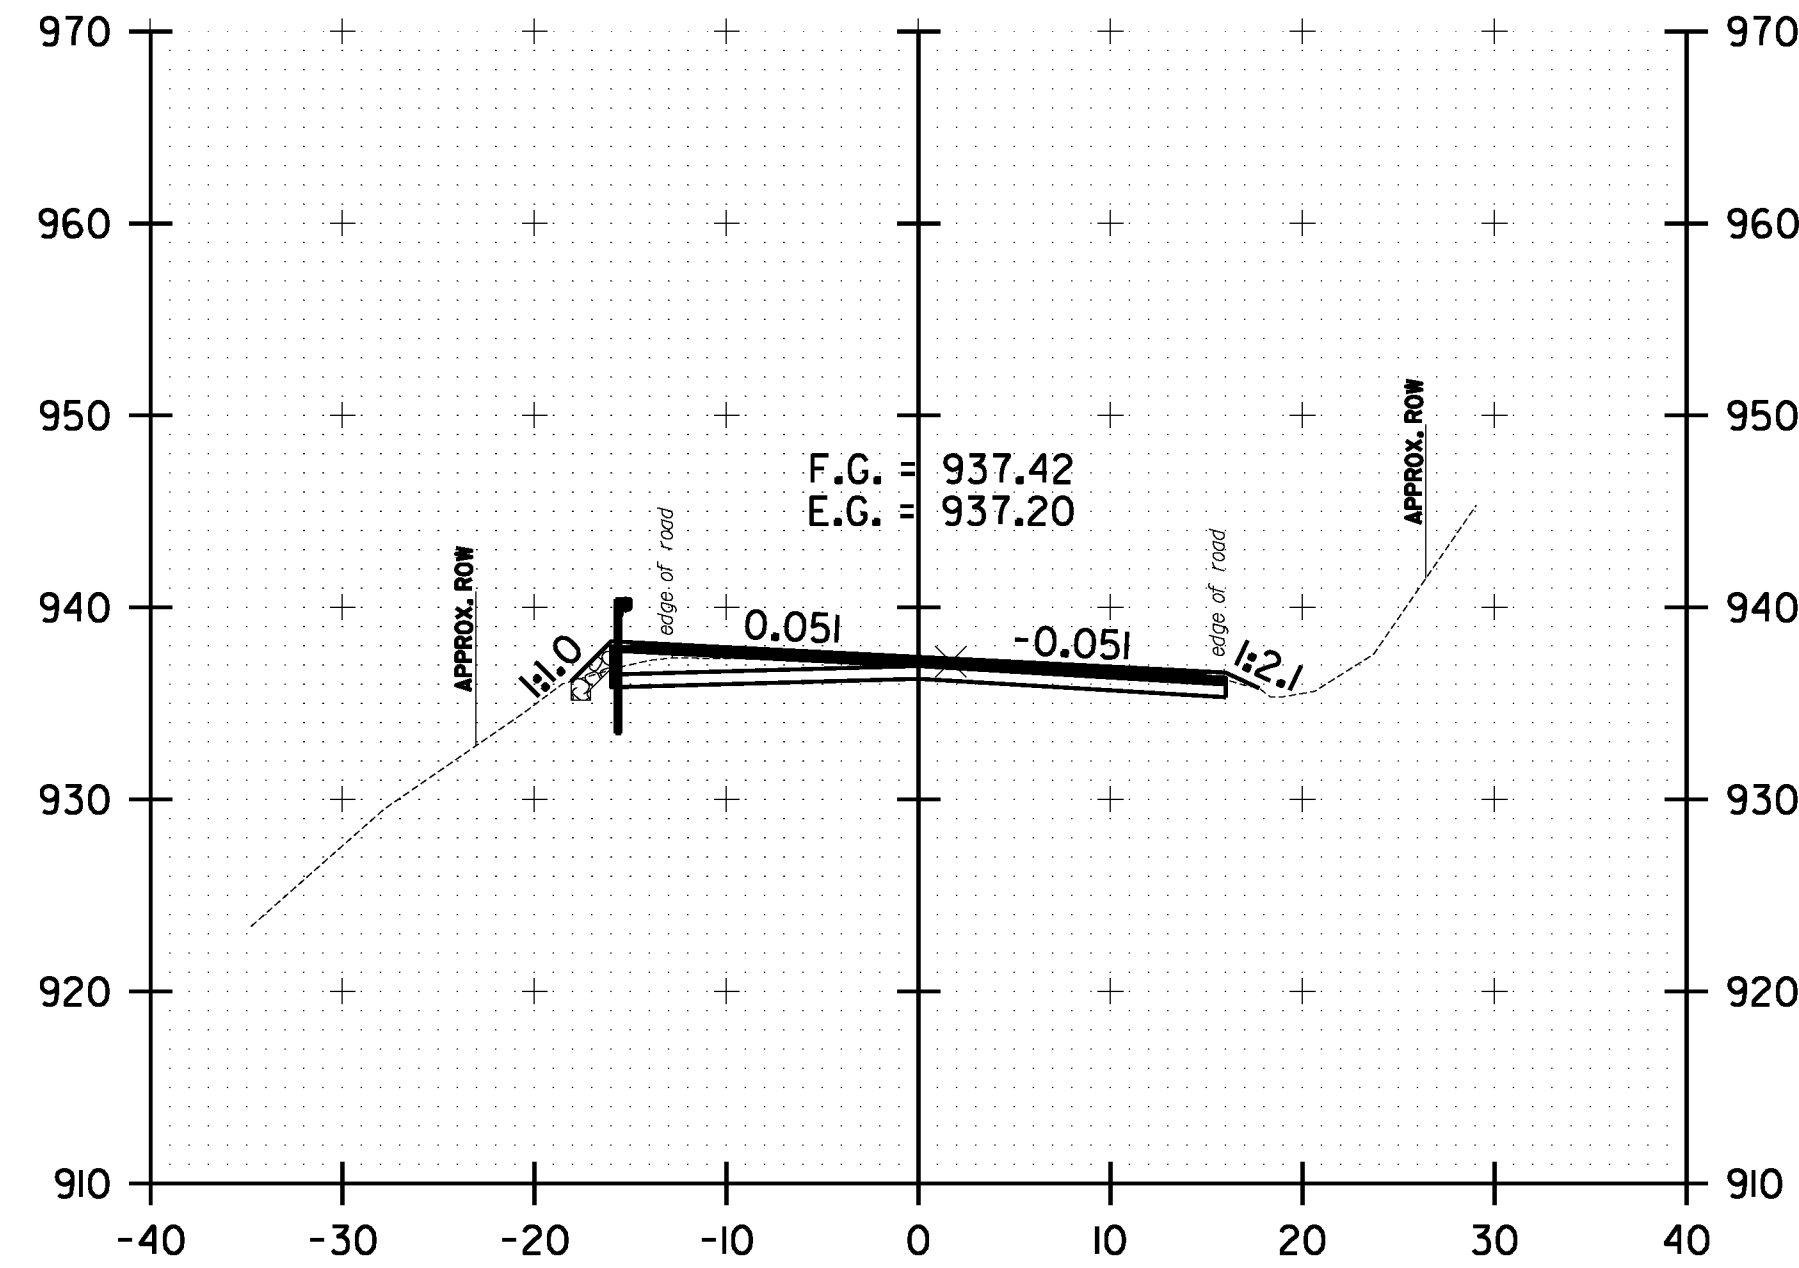


168+00.00

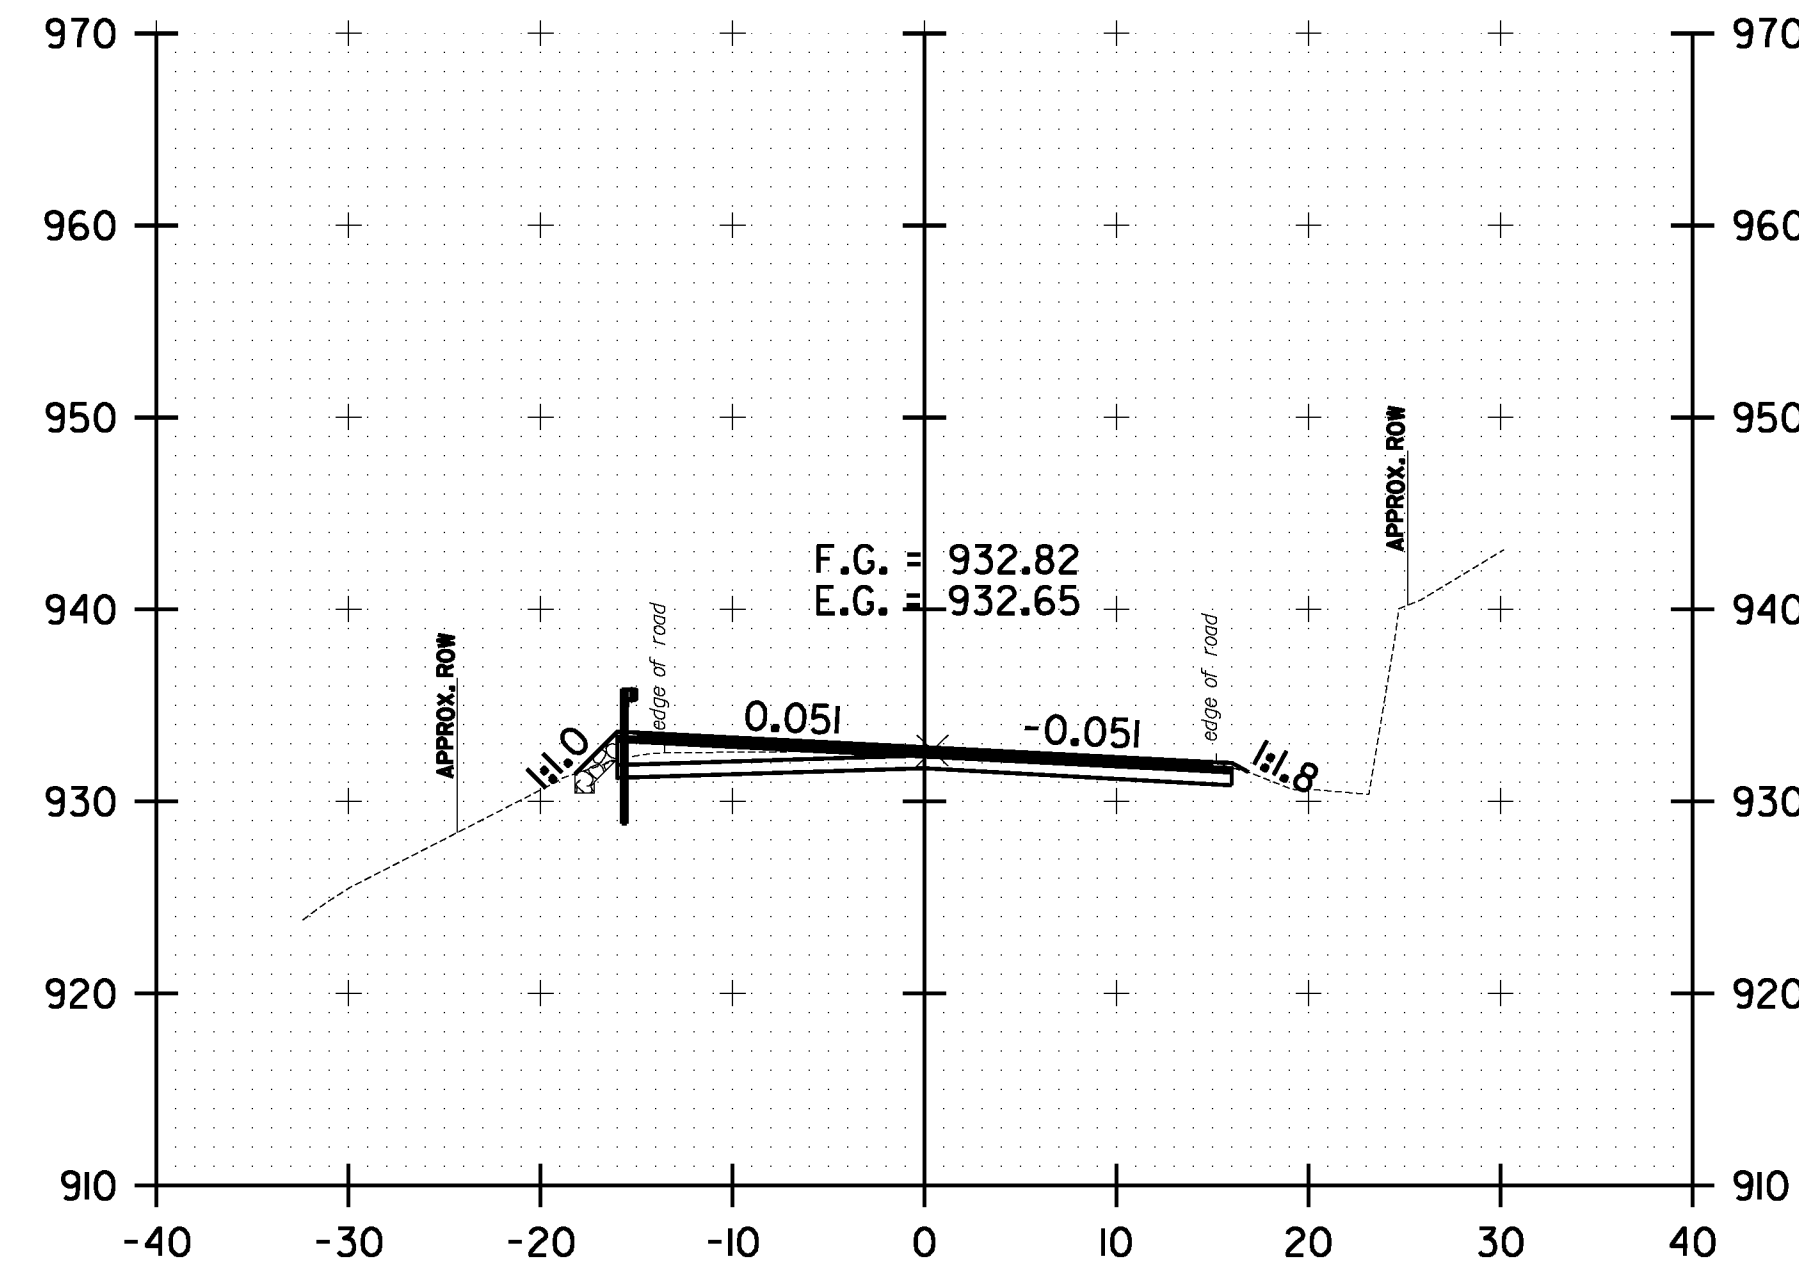


169+00.00

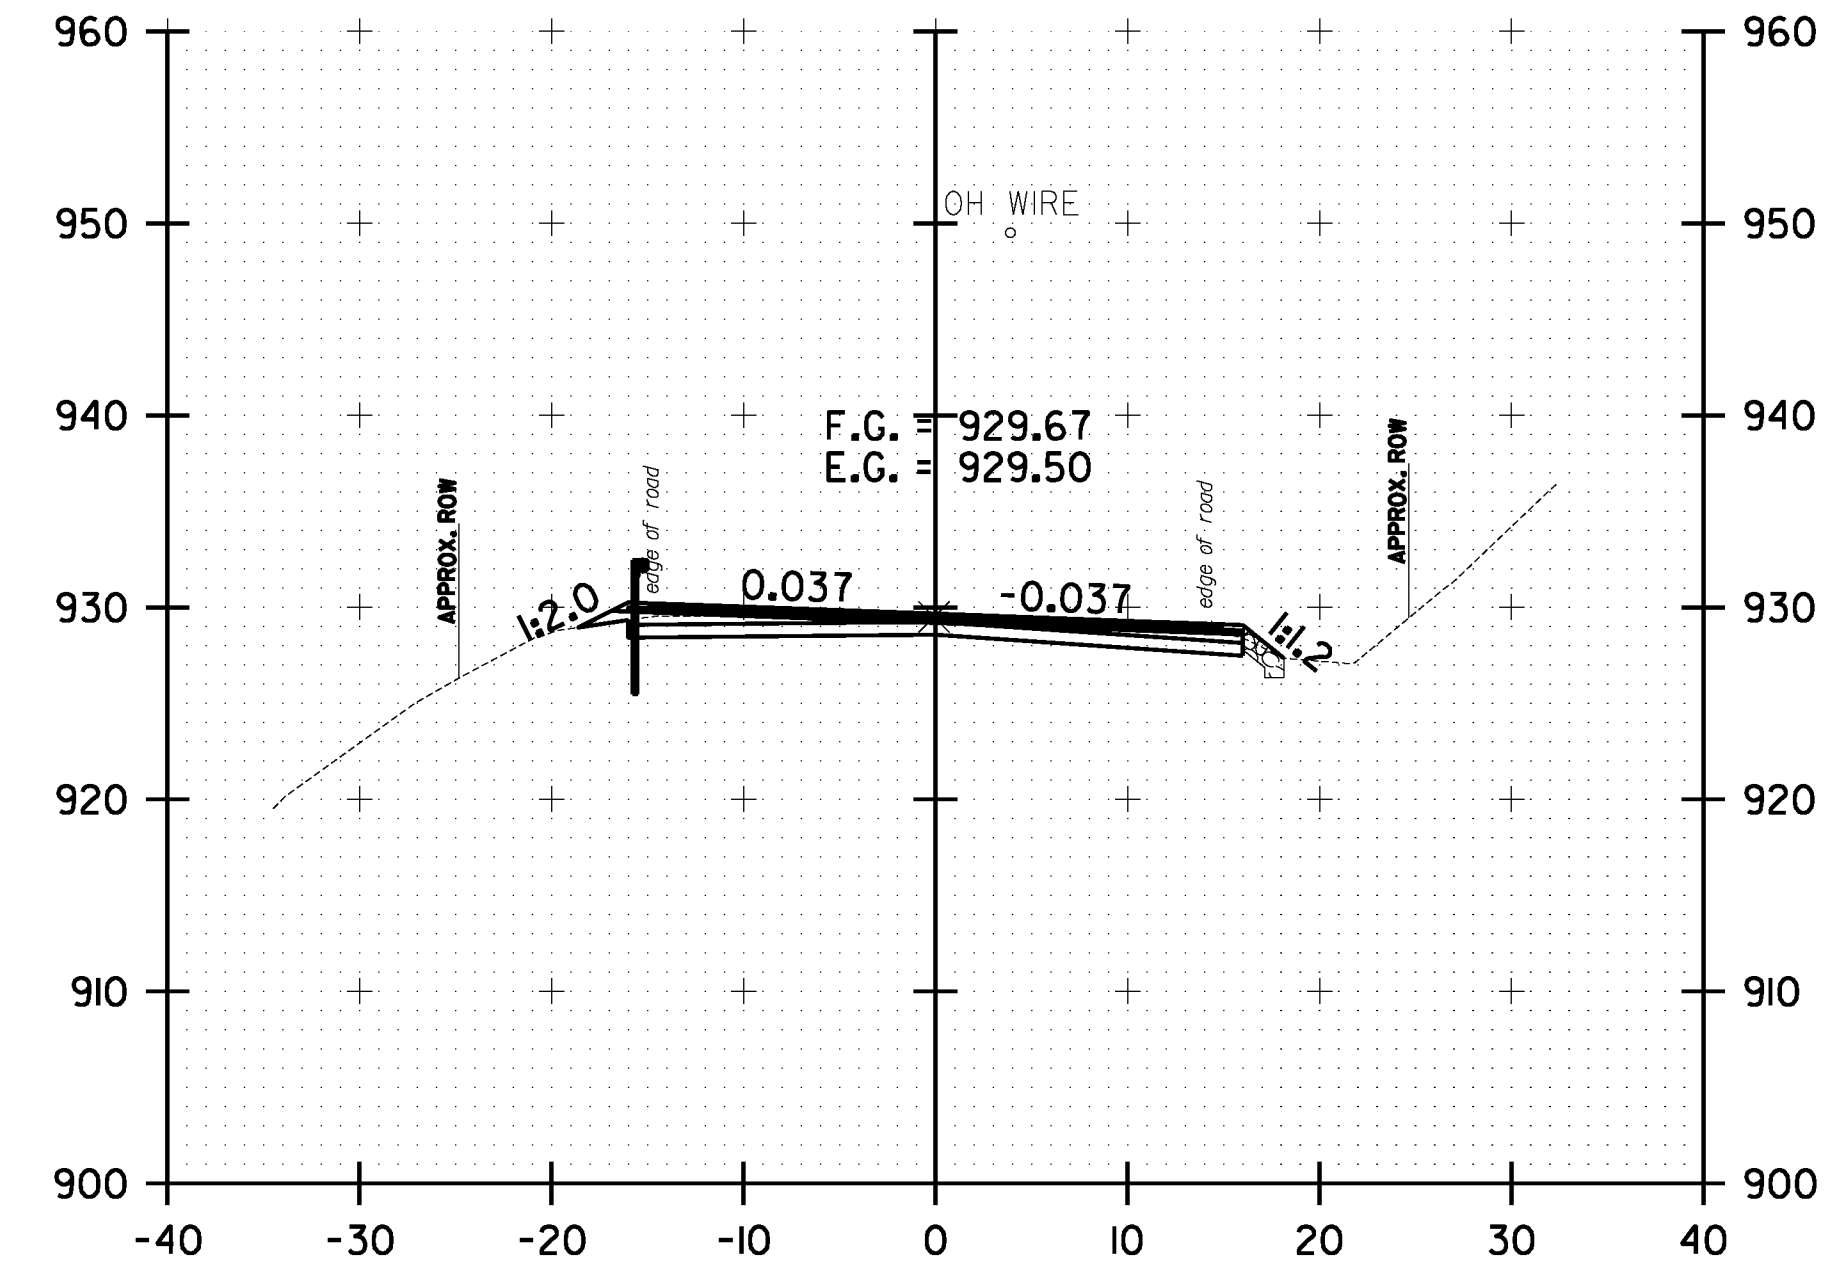


170+00.00

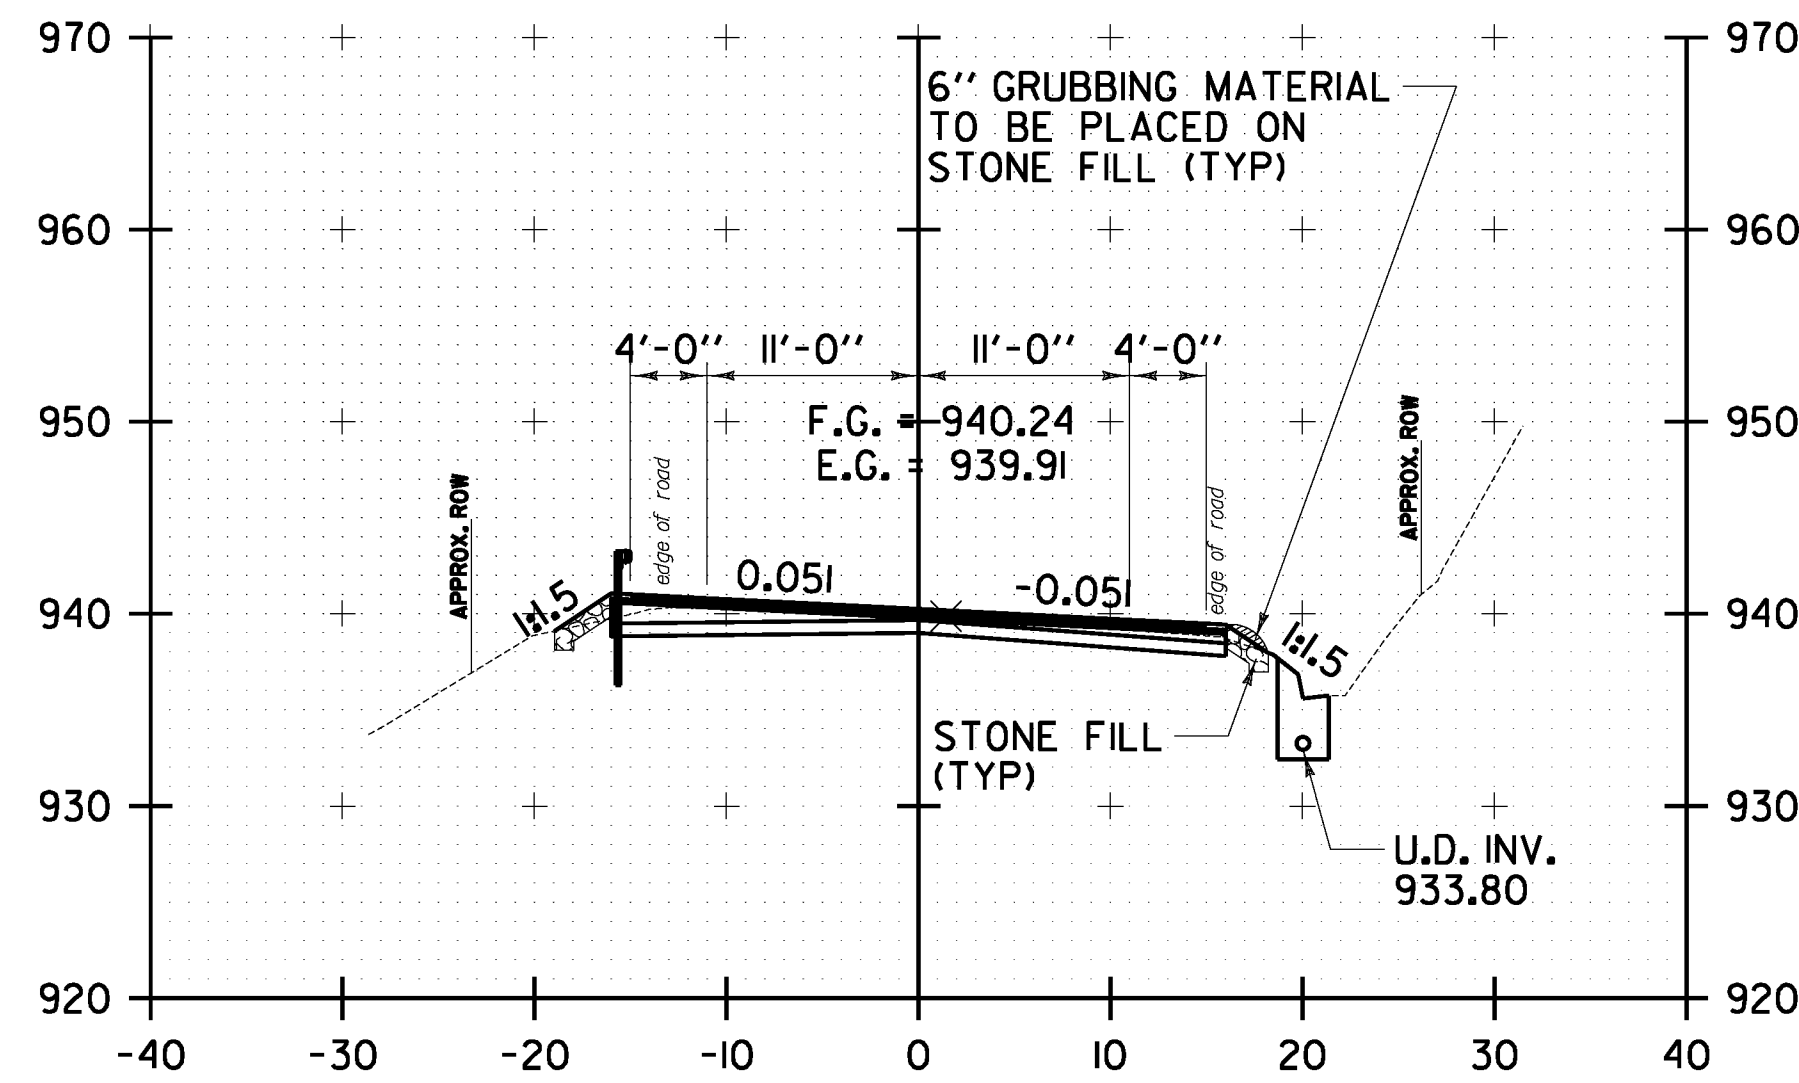


167+50.00

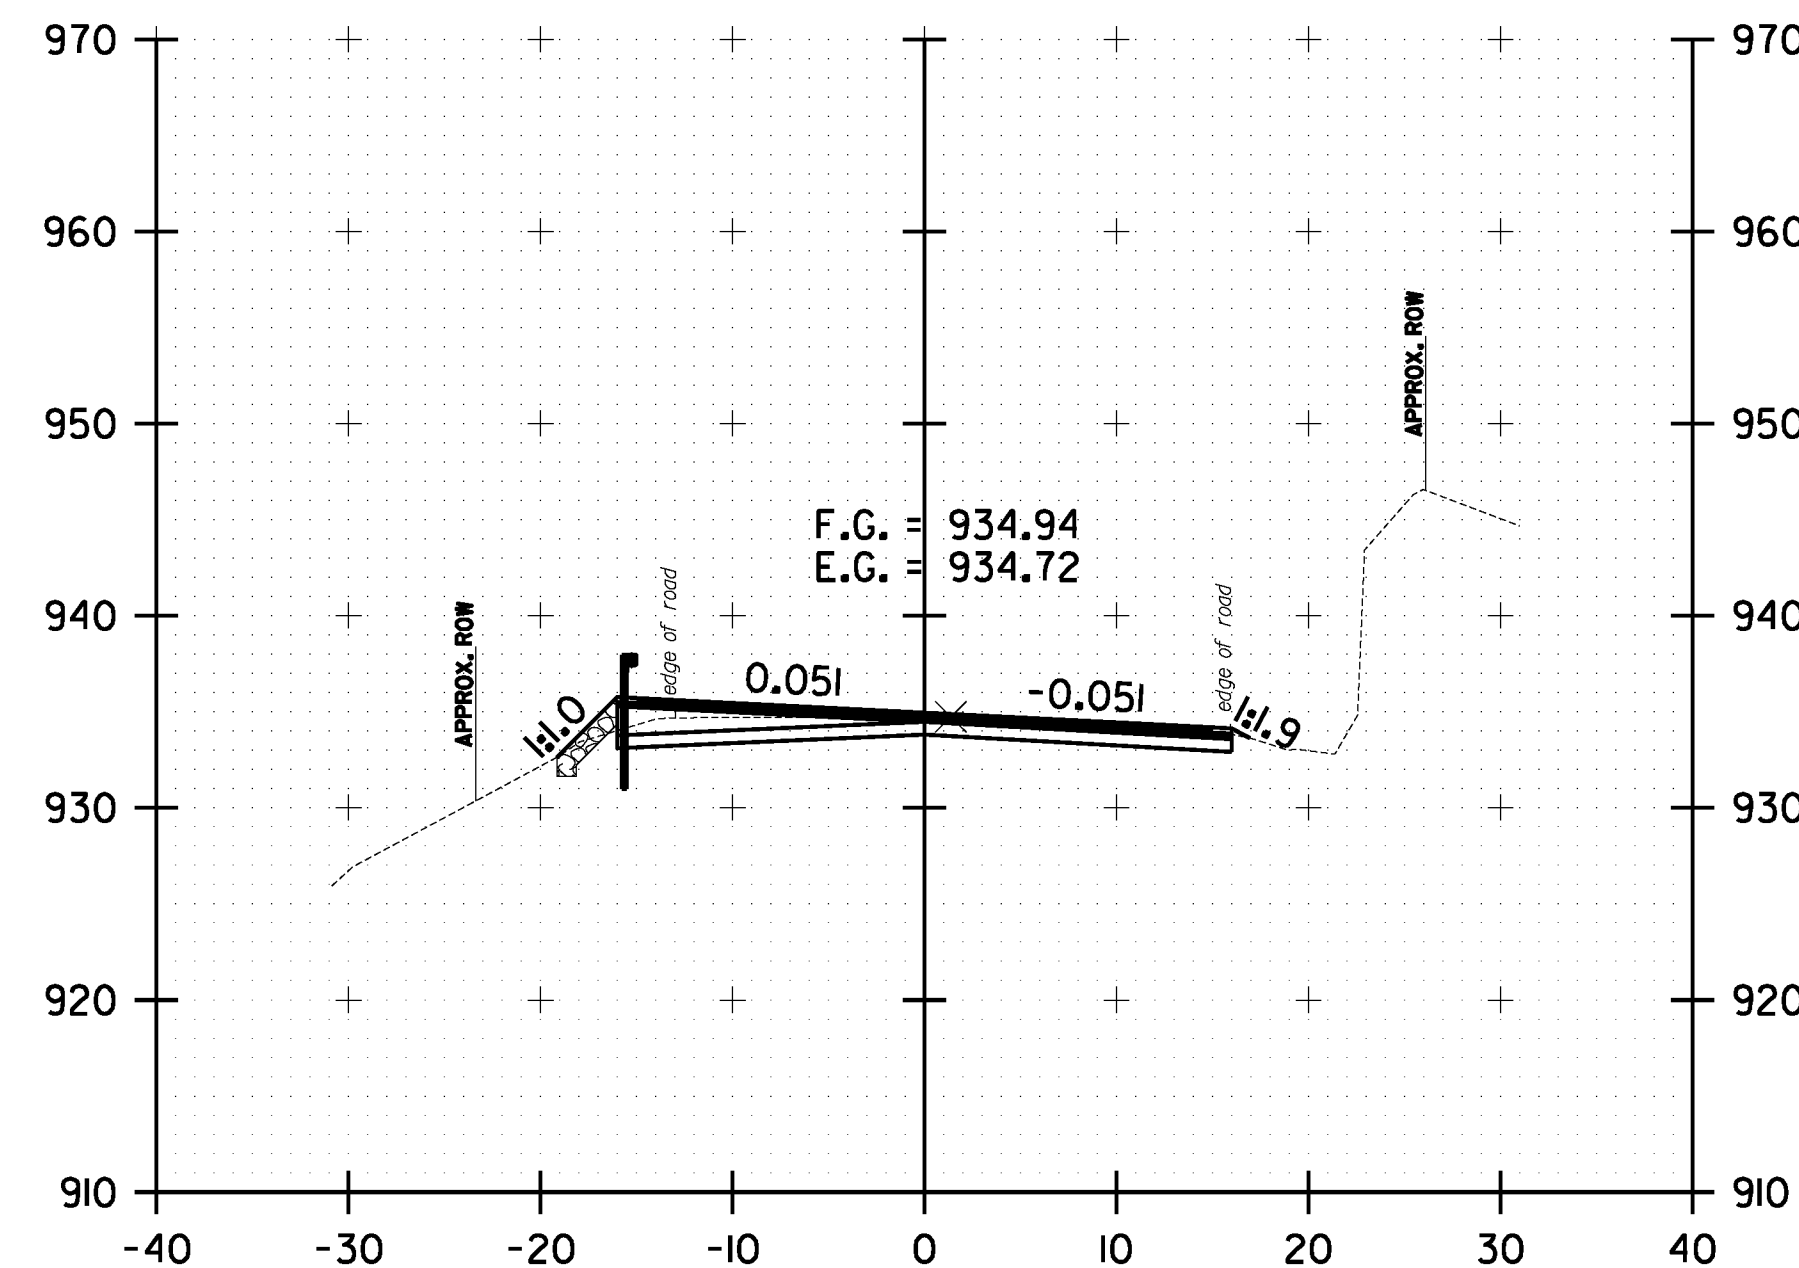

168+50.00

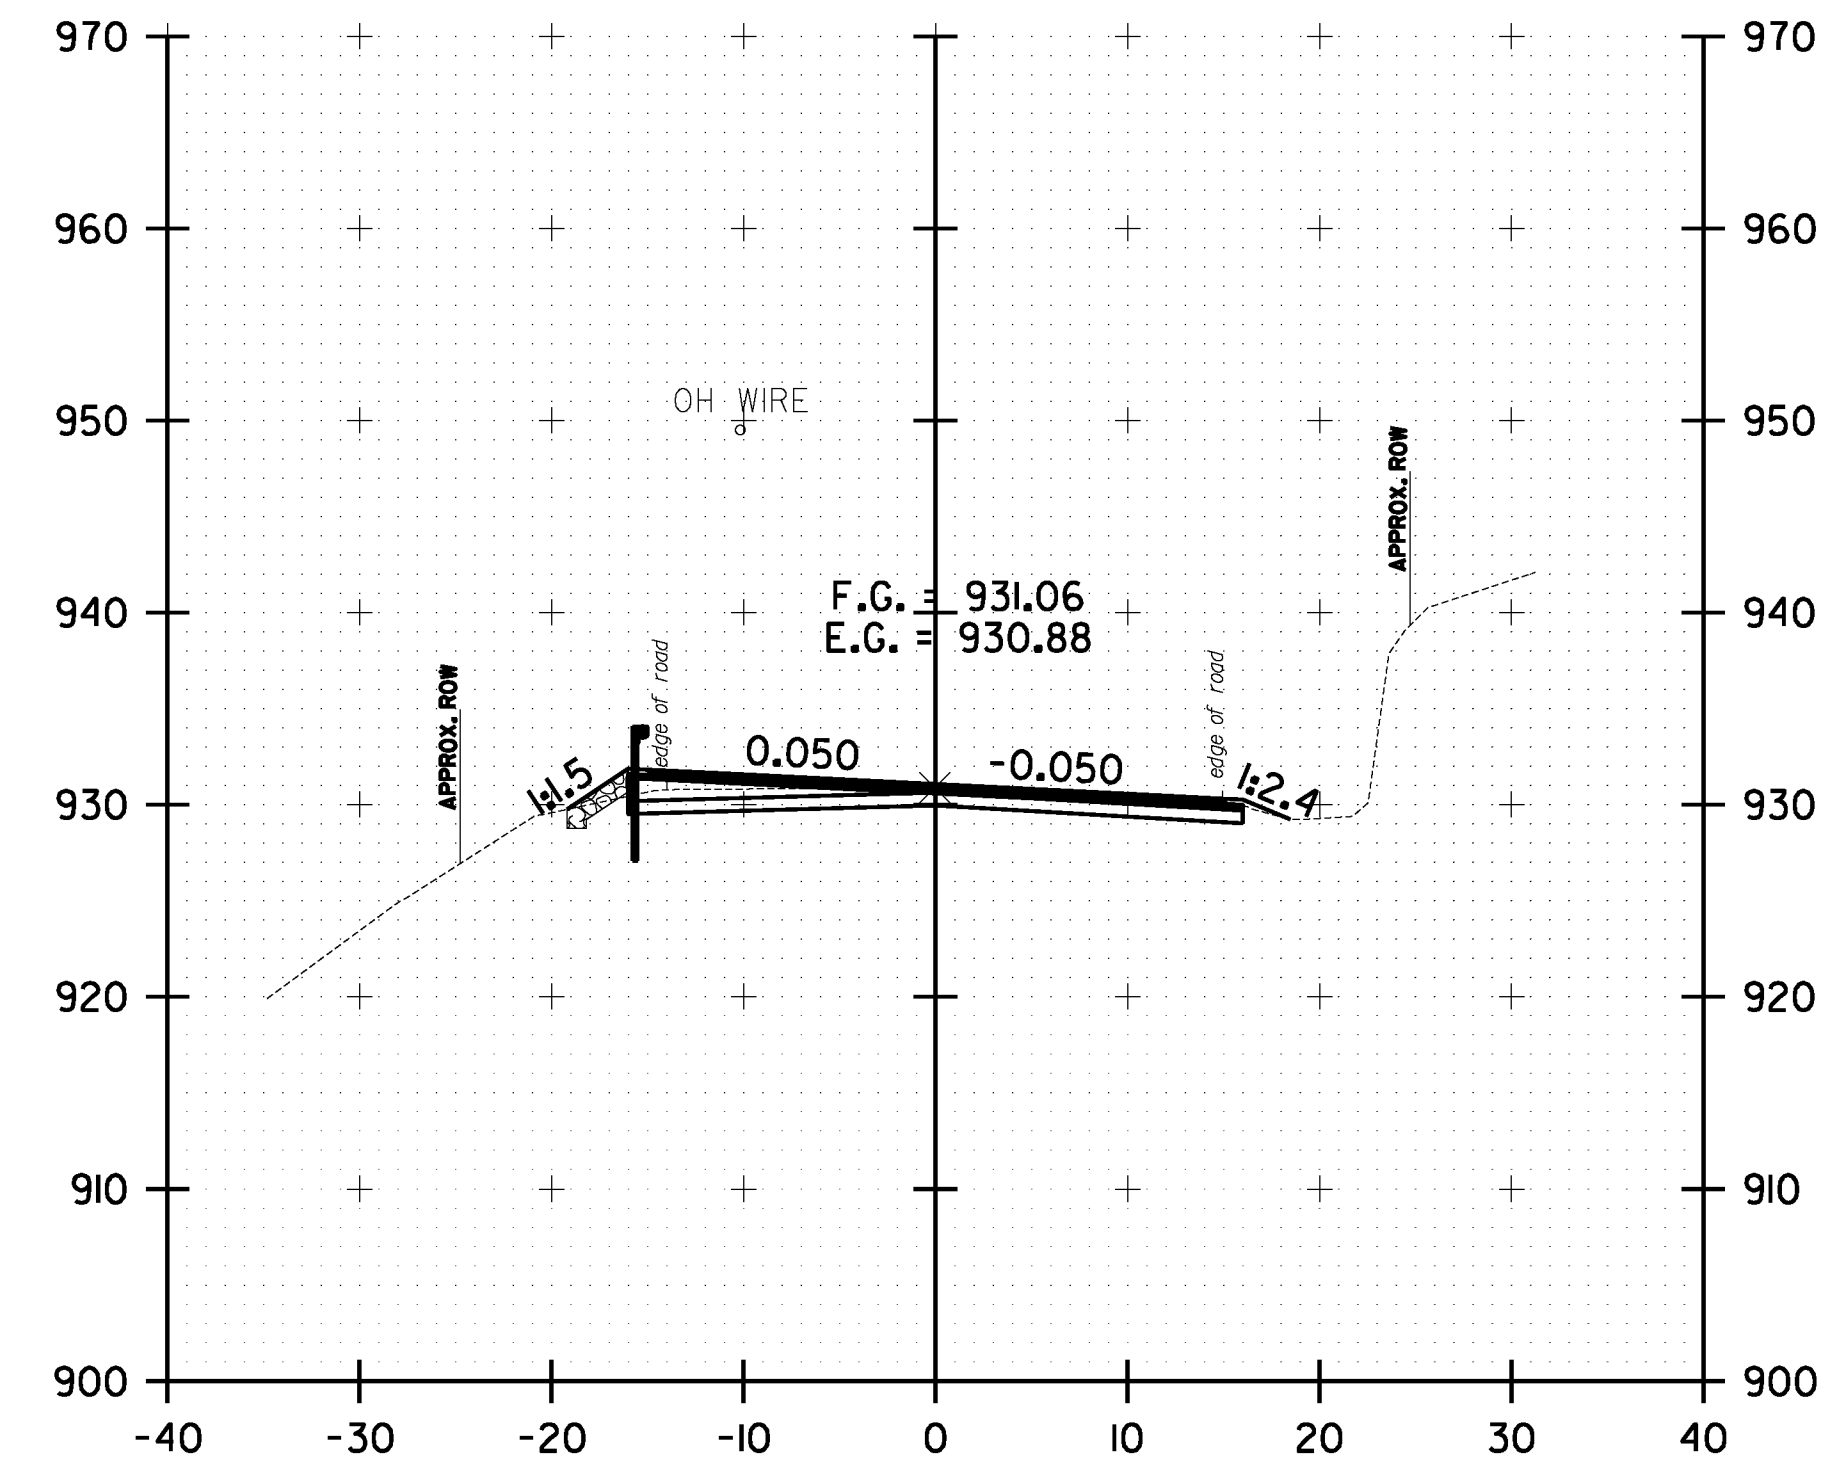

169+50.00

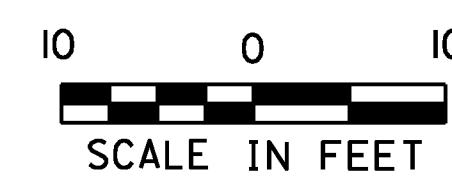

**WARREN
 CROSS SECTION
 SHEET #41**

PROJECT NAME: WARREN-WAITSFIELD

PROJECT NUMBER: STP 2506(1)

FILE NAME: p05b048.dgn

PROJECT LEADER: D.E.G.

DESIGNED BY: M.J.M.

IPARM FILE: p05b048xs41.i

PLOT DATE: 12/20/2012

DRAWN BY: W.G.P.

CHECKED BY: D.E.G.

SHEET 204 OF 310