




FILE NAME: U:\1762\CA00\MST\STP_2506\p05b048.Conv.eet Plans.dgn
 DATE/TIME: 12/20/2012
 USER: 4866

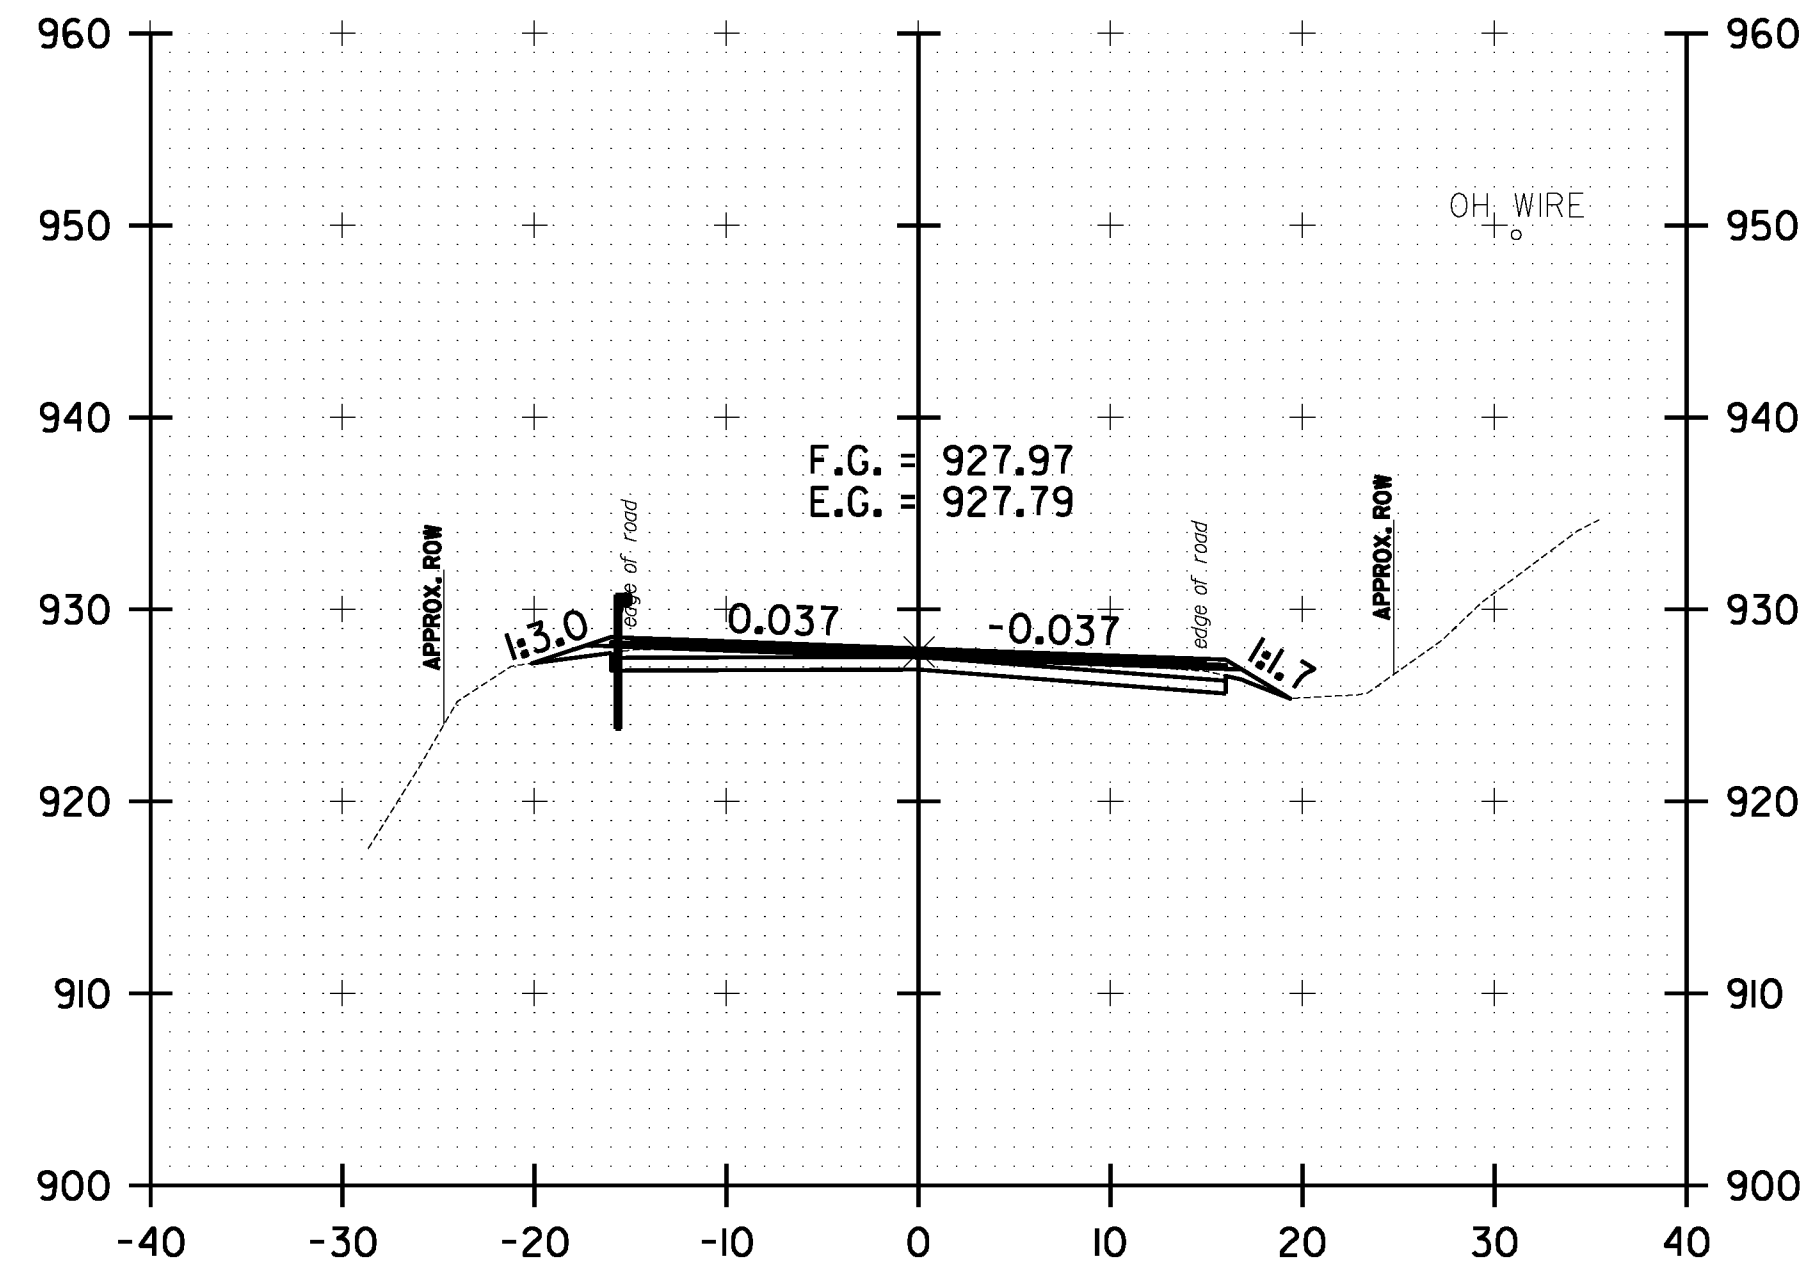


171+00.00

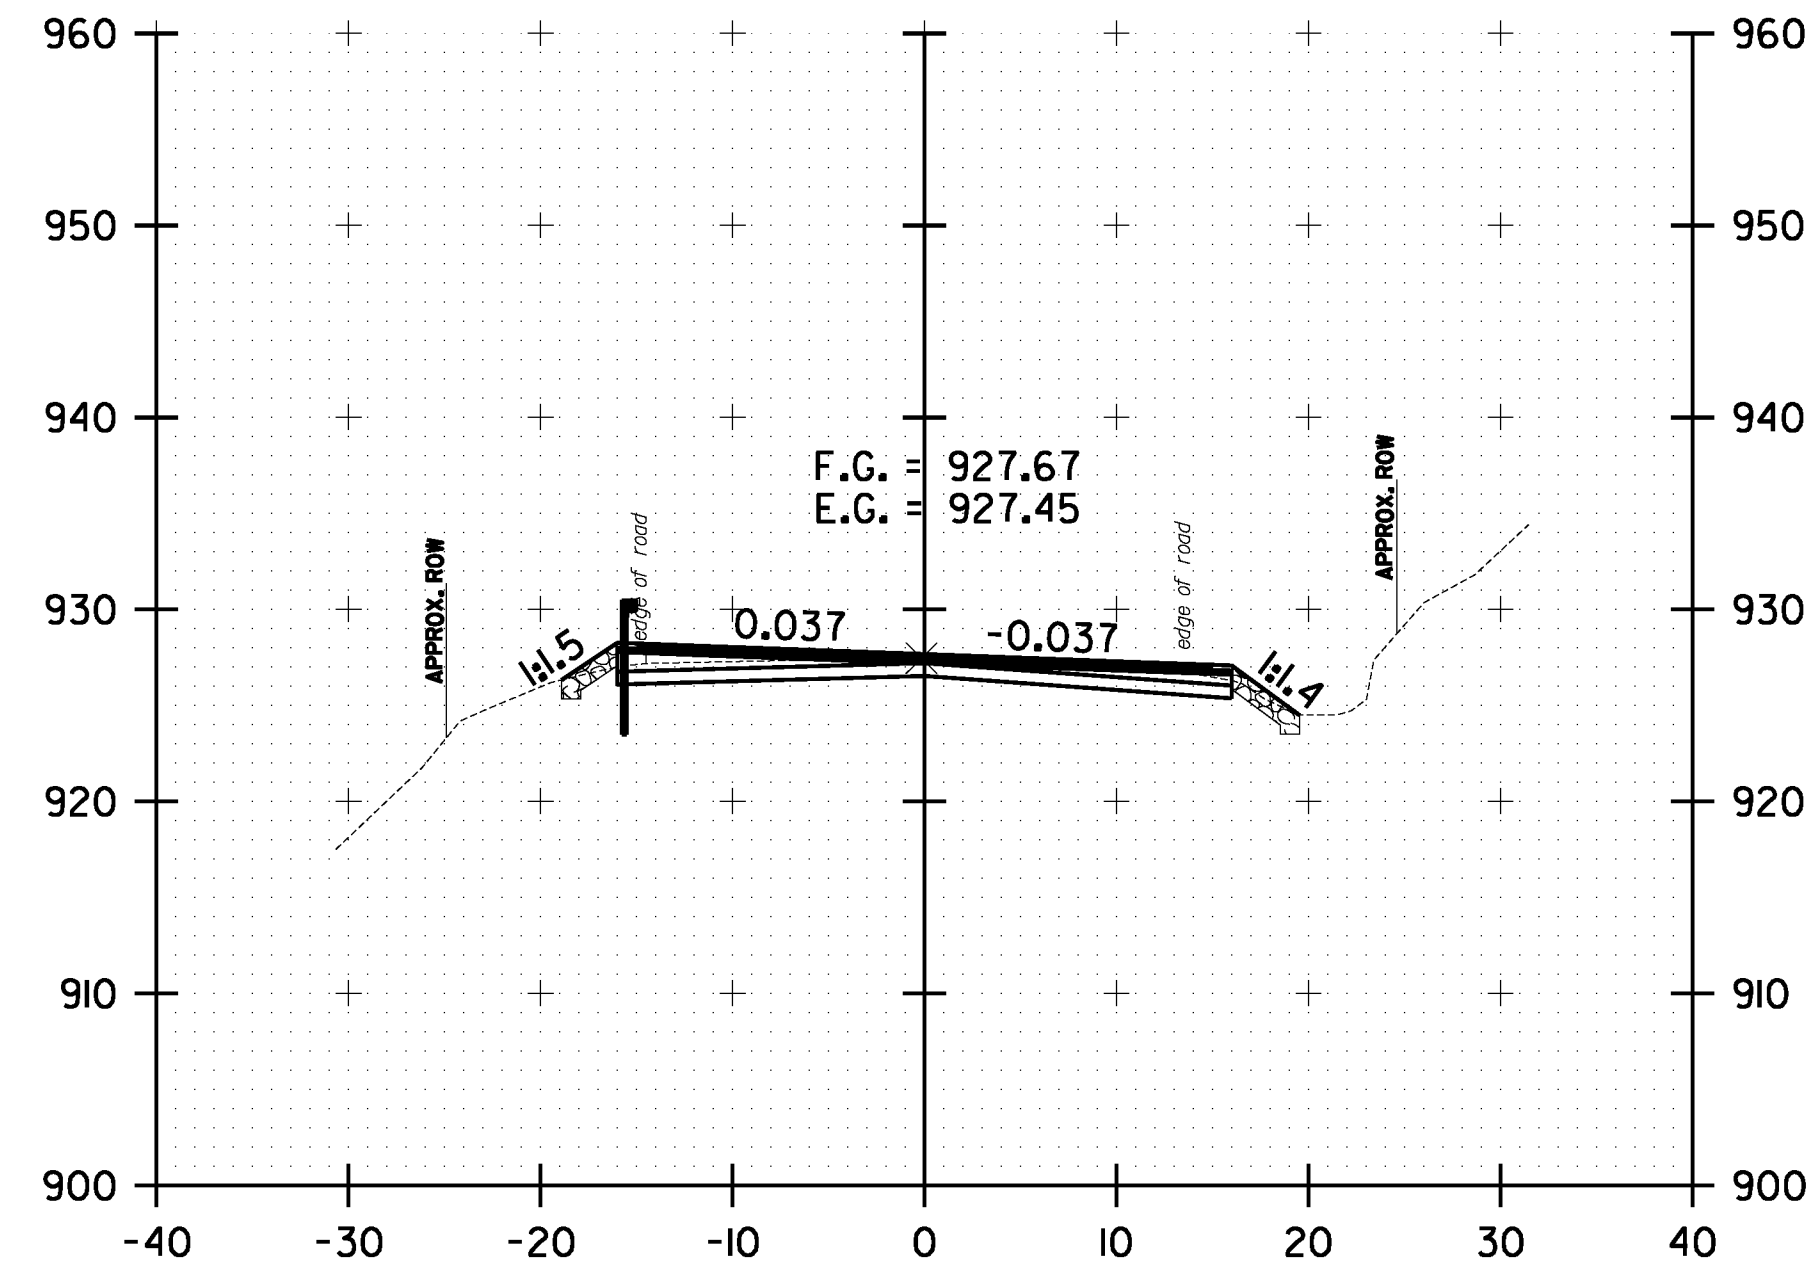


172+00.00

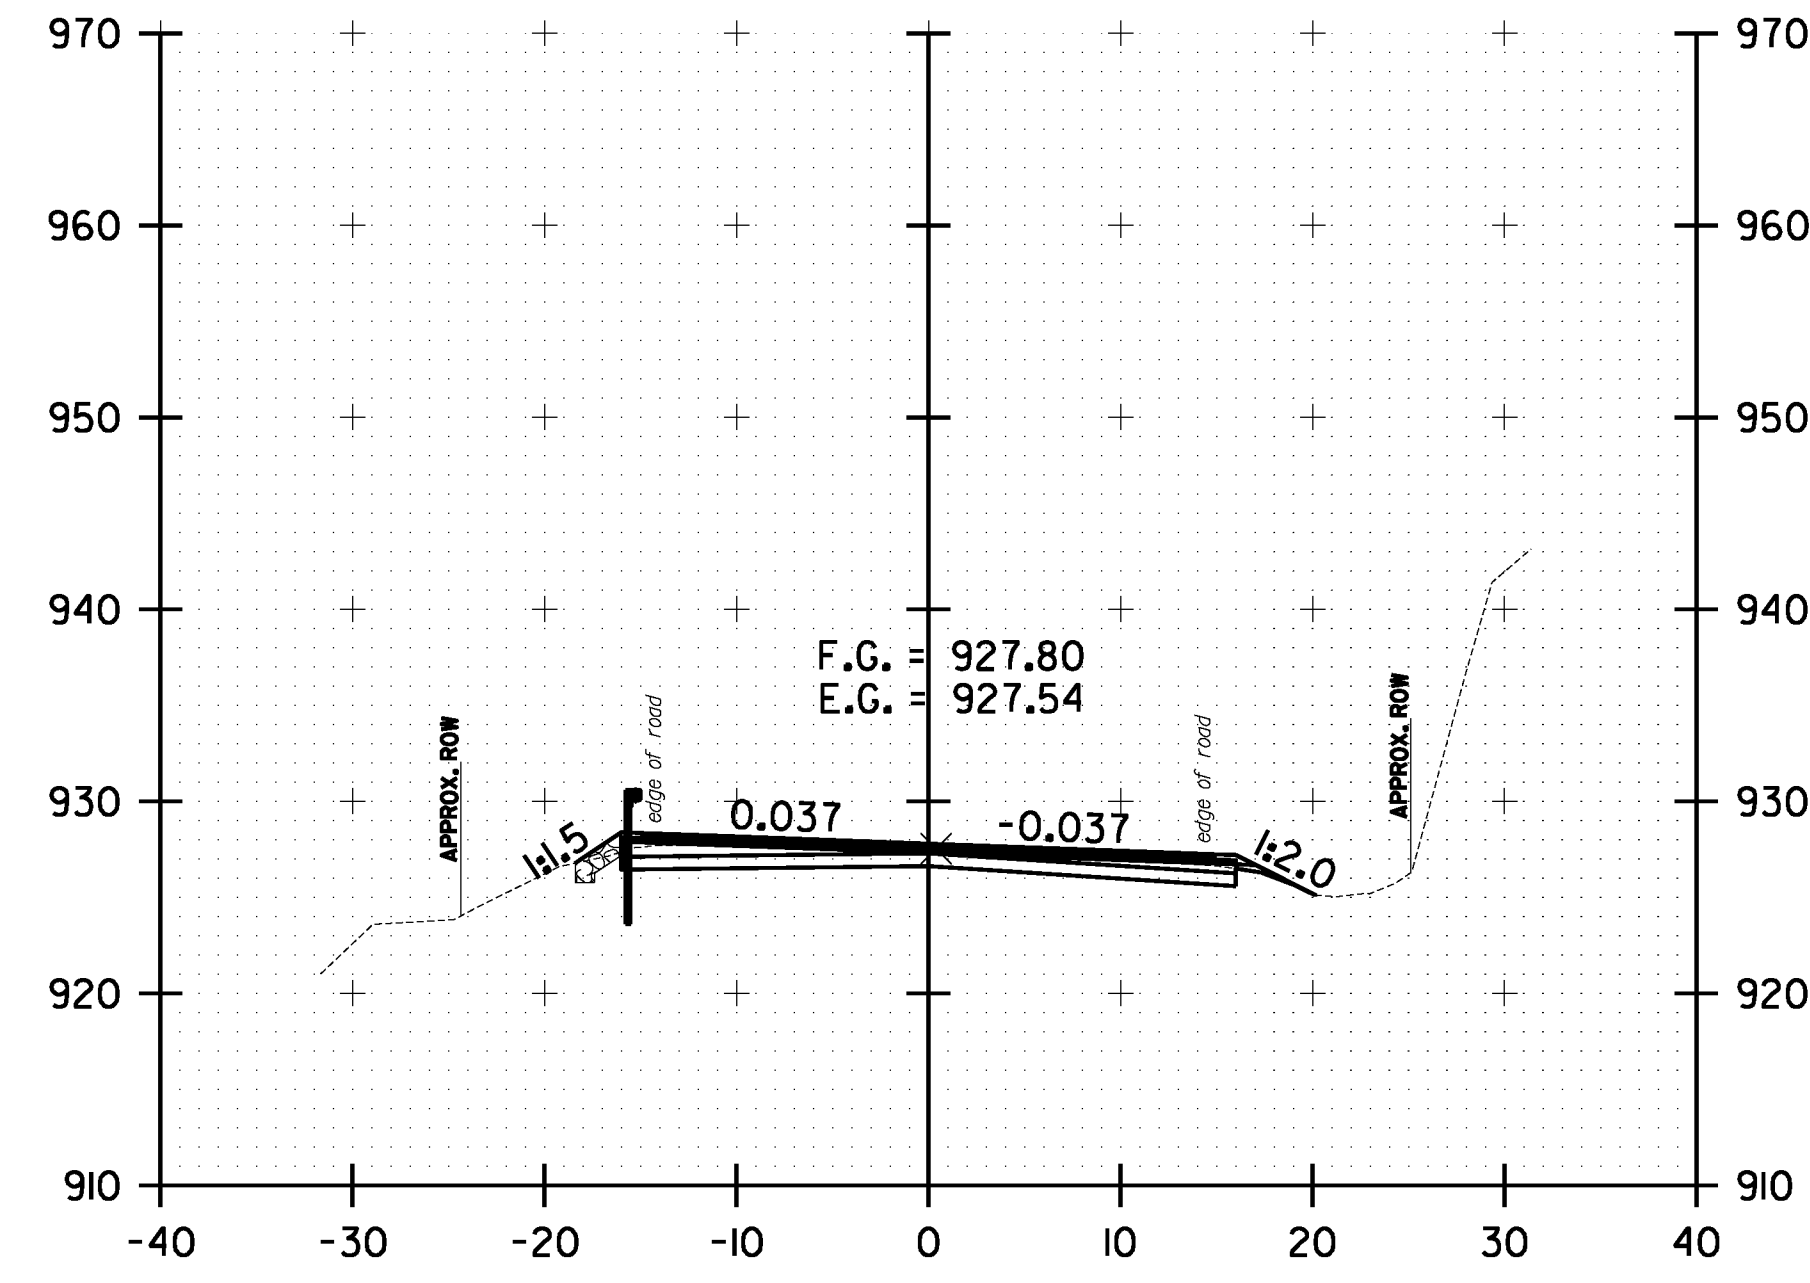


173+00.00

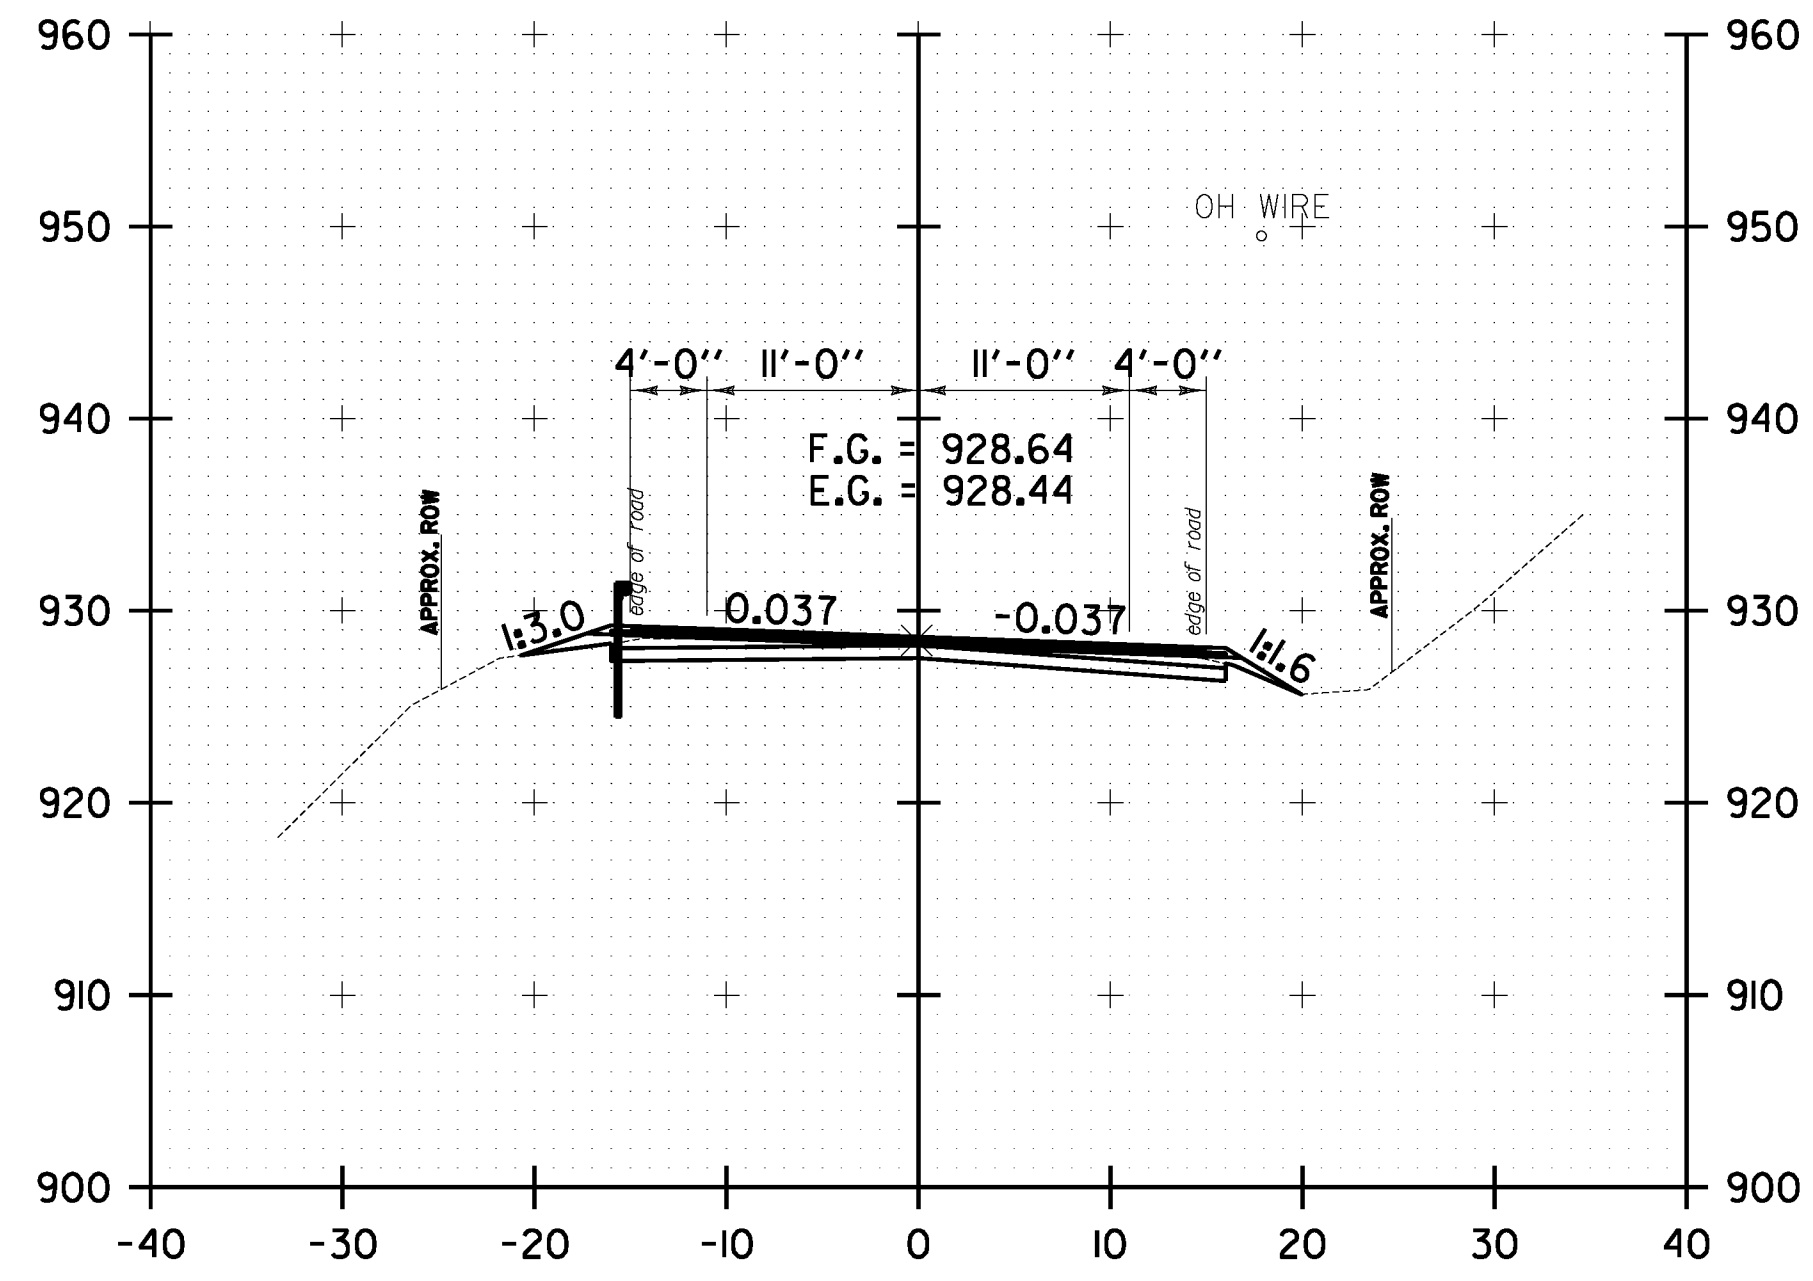

170+50.00

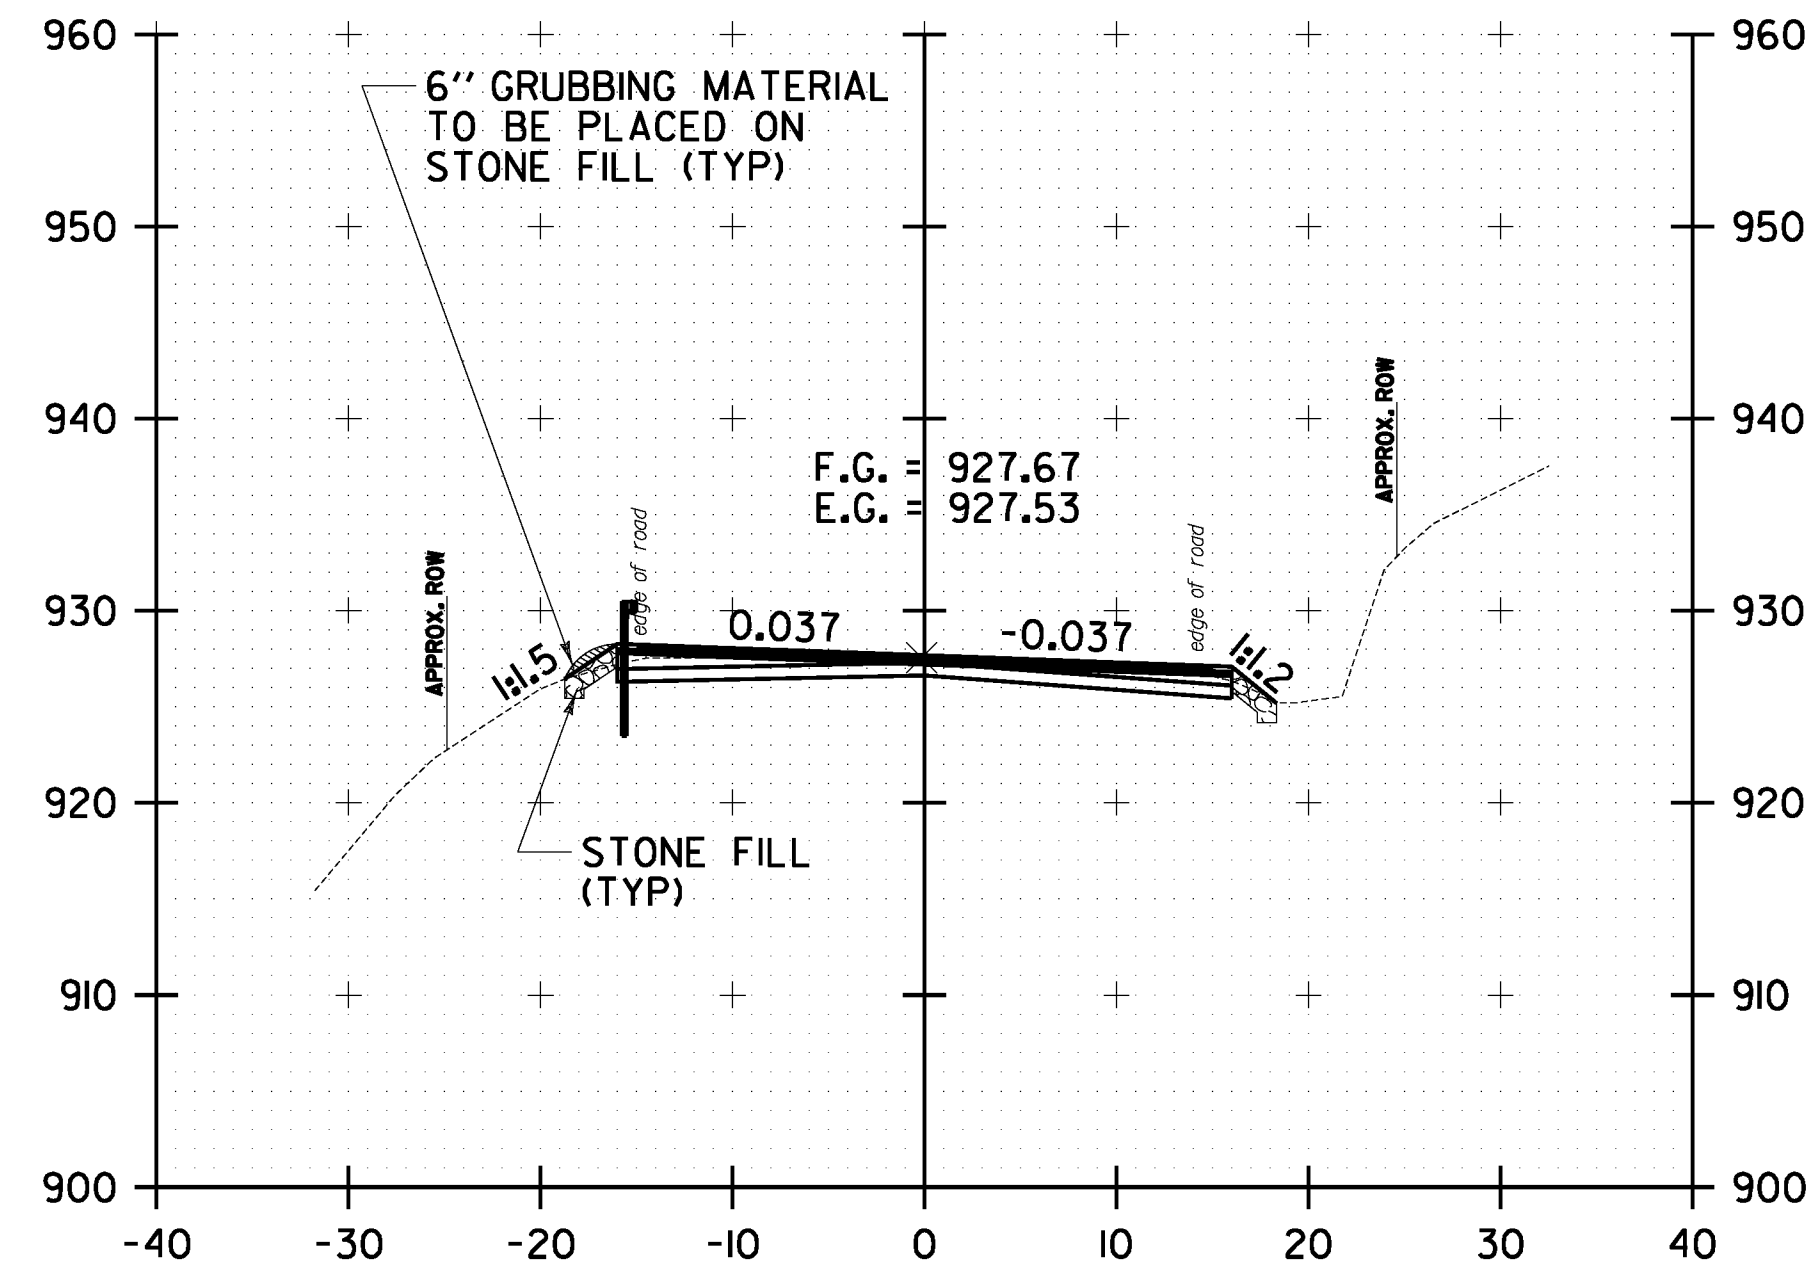

171+50.00

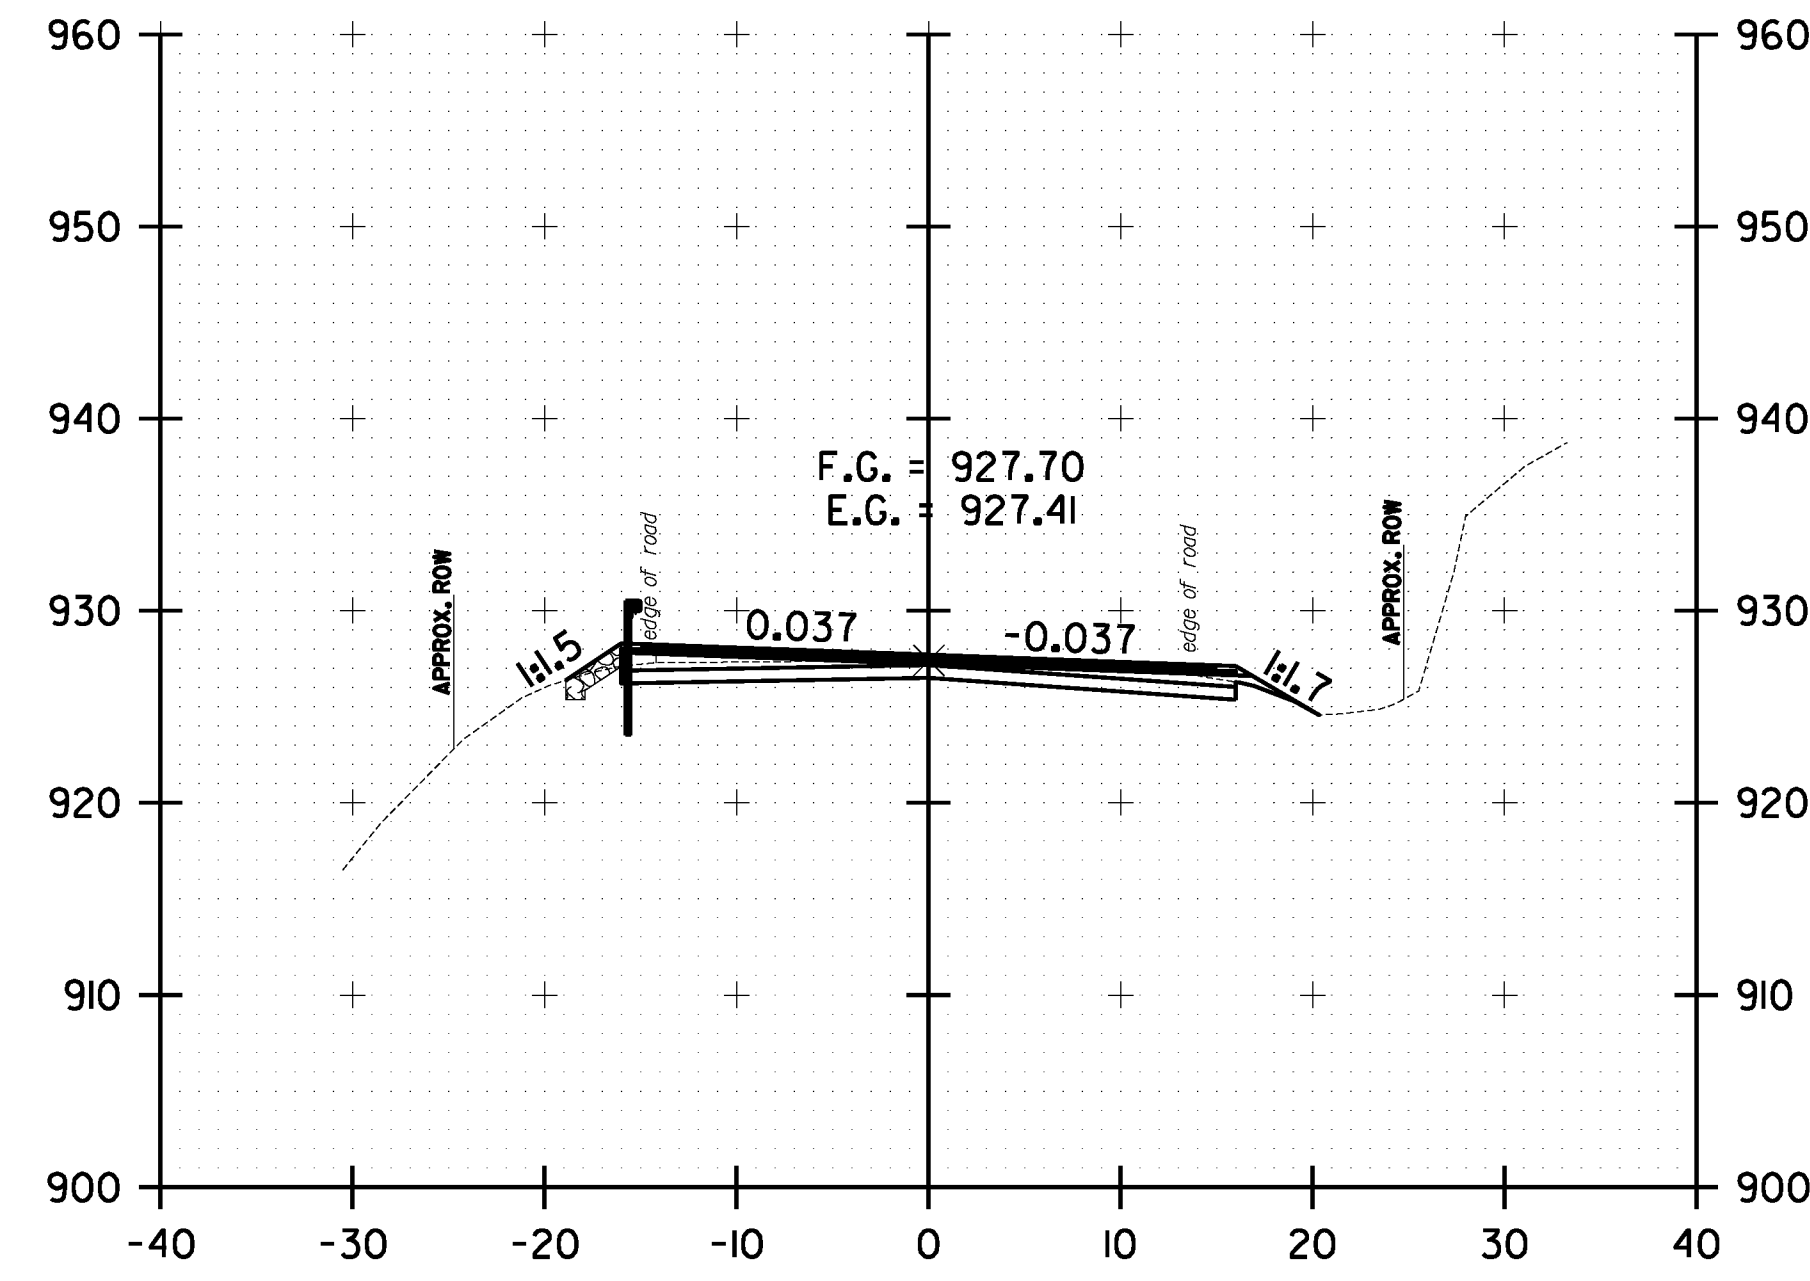

172+50.00



**WARREN
 CROSS SECTION
 SHEET #42**

PROJECT NAME: WARREN-WAITSFIELD	PLOT DATE: 12/20/2012
PROJECT NUMBER: STP 2506(1)	DRAWN BY: W.G.P.
FILE NAME: p05b048.dgn	CHECKED BY: D.E.G.
PROJECT LEADER: D.E.G.	SHEET 205 OF 310
DESIGNED BY: M.J.M.	
IPARM FILE: p05b048xs42.1	