




FILE NAME: U:\1762\CA00\MST\STP_2506\p05b048_Conv.eas_Plan.dgn
 DATE/TIME: 12/20/2012
 USER: 4866

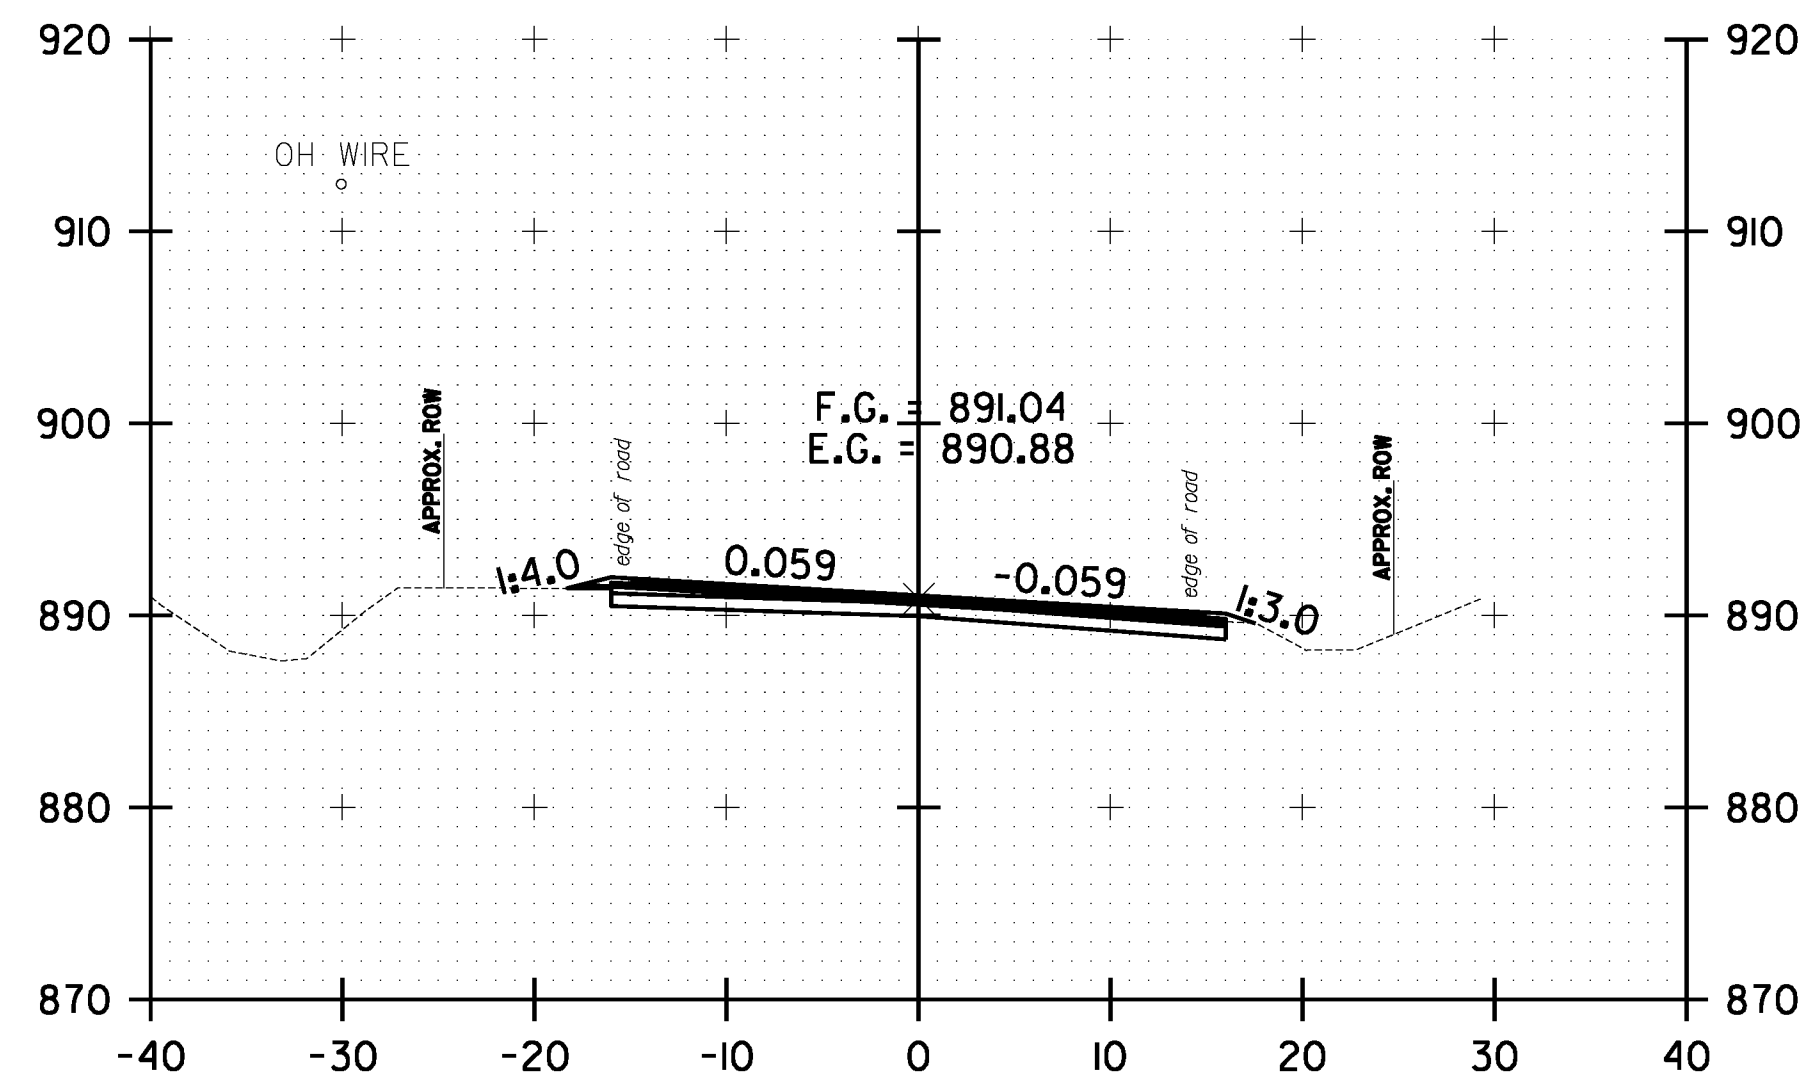


218+00.00

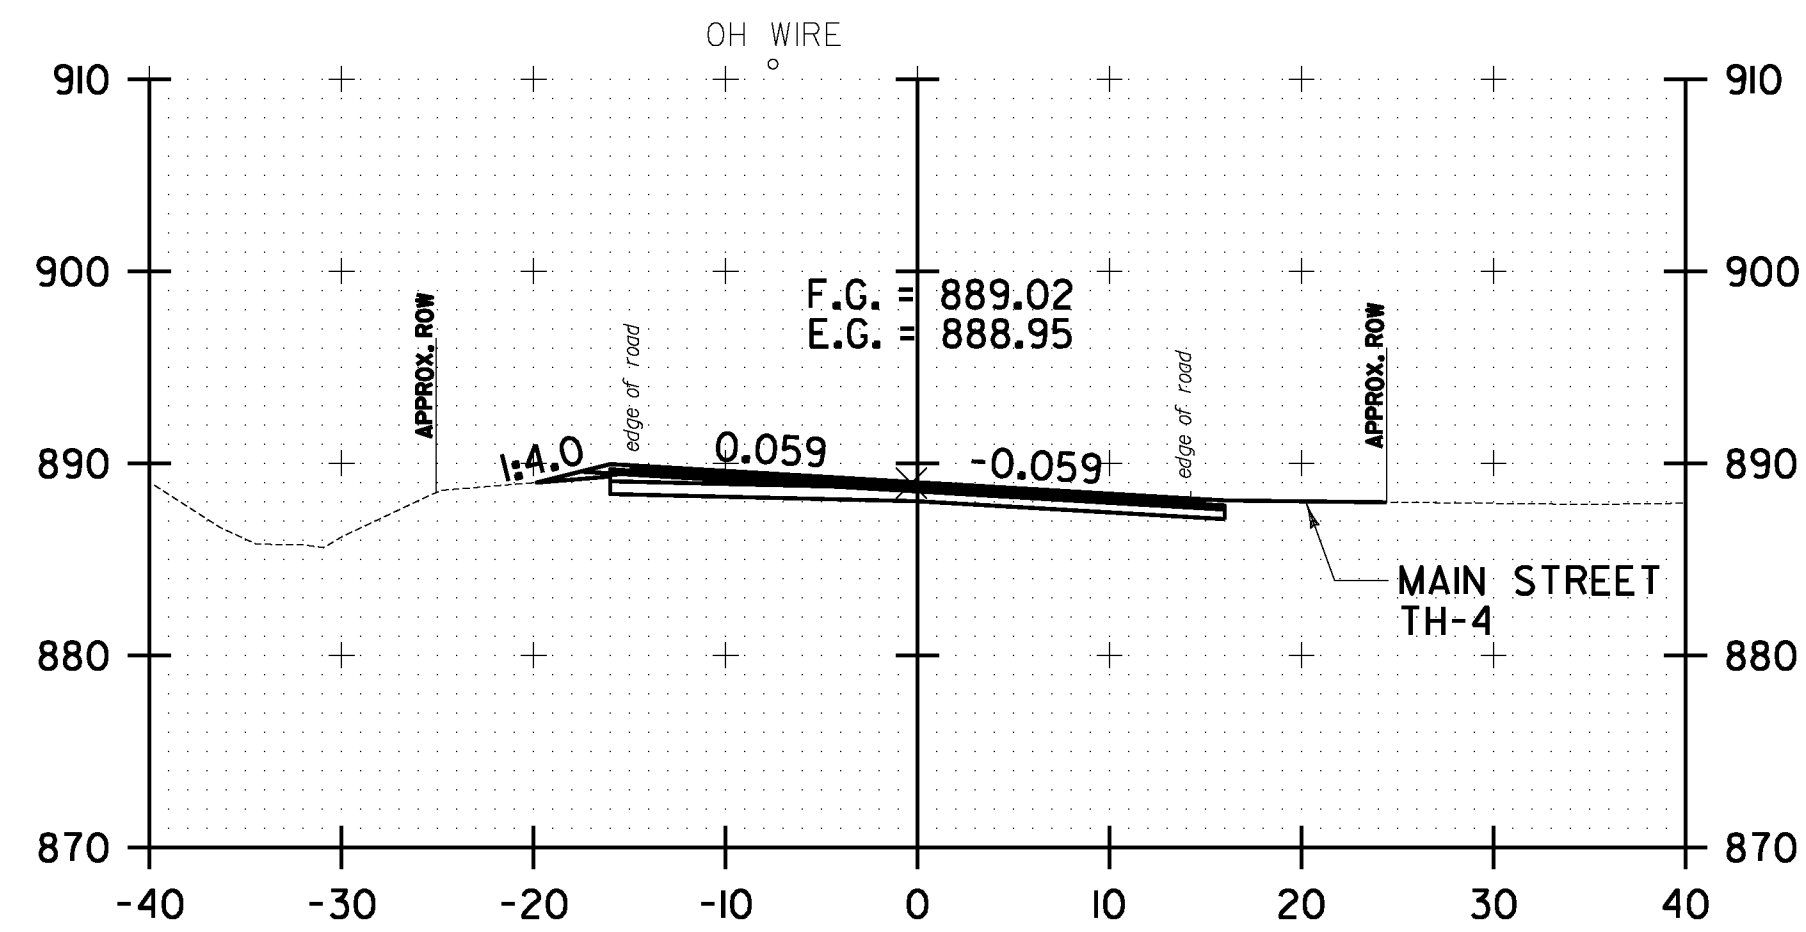


219+00.00

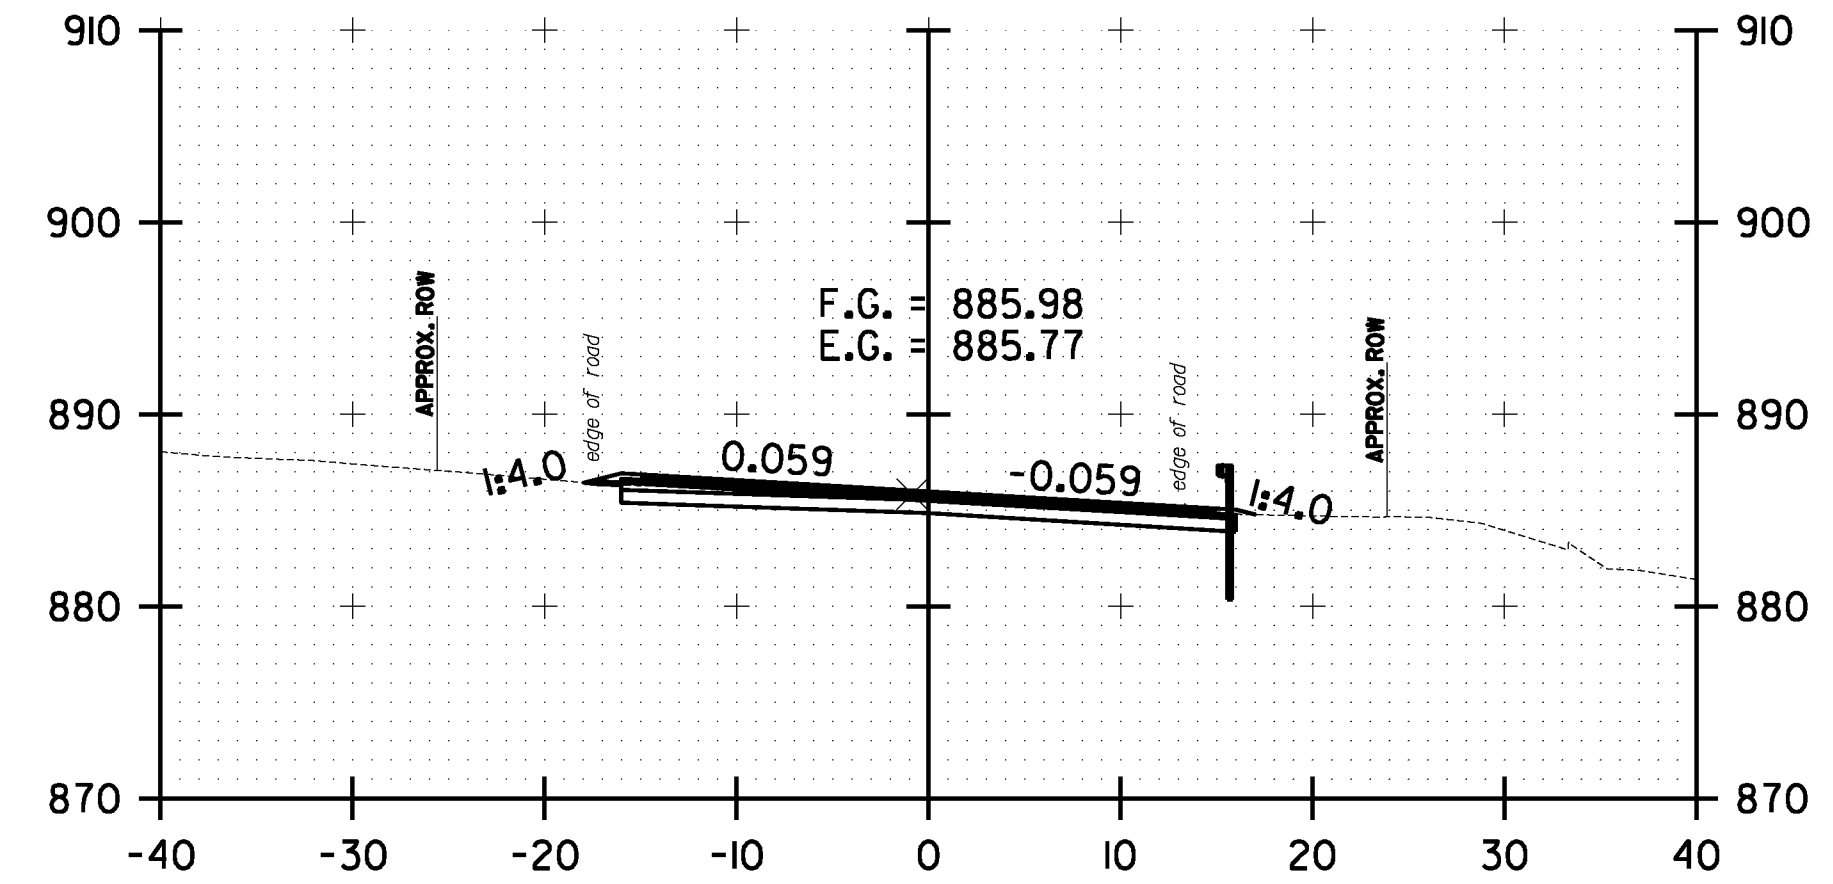


220+50.00

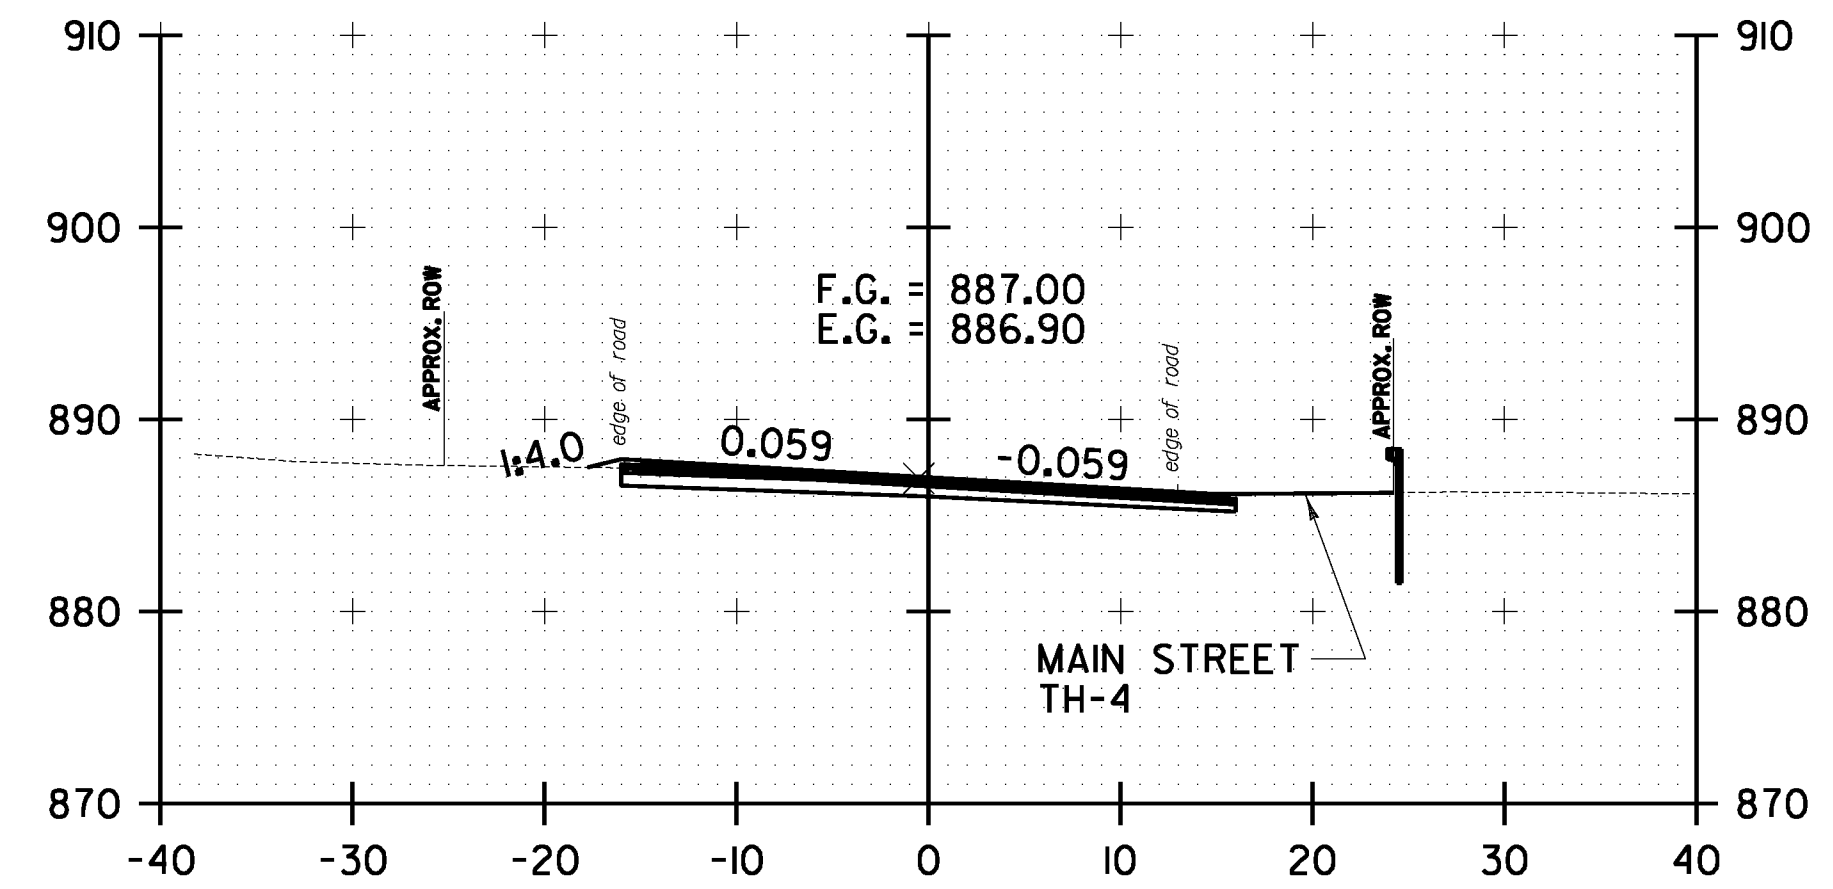


220+00.00

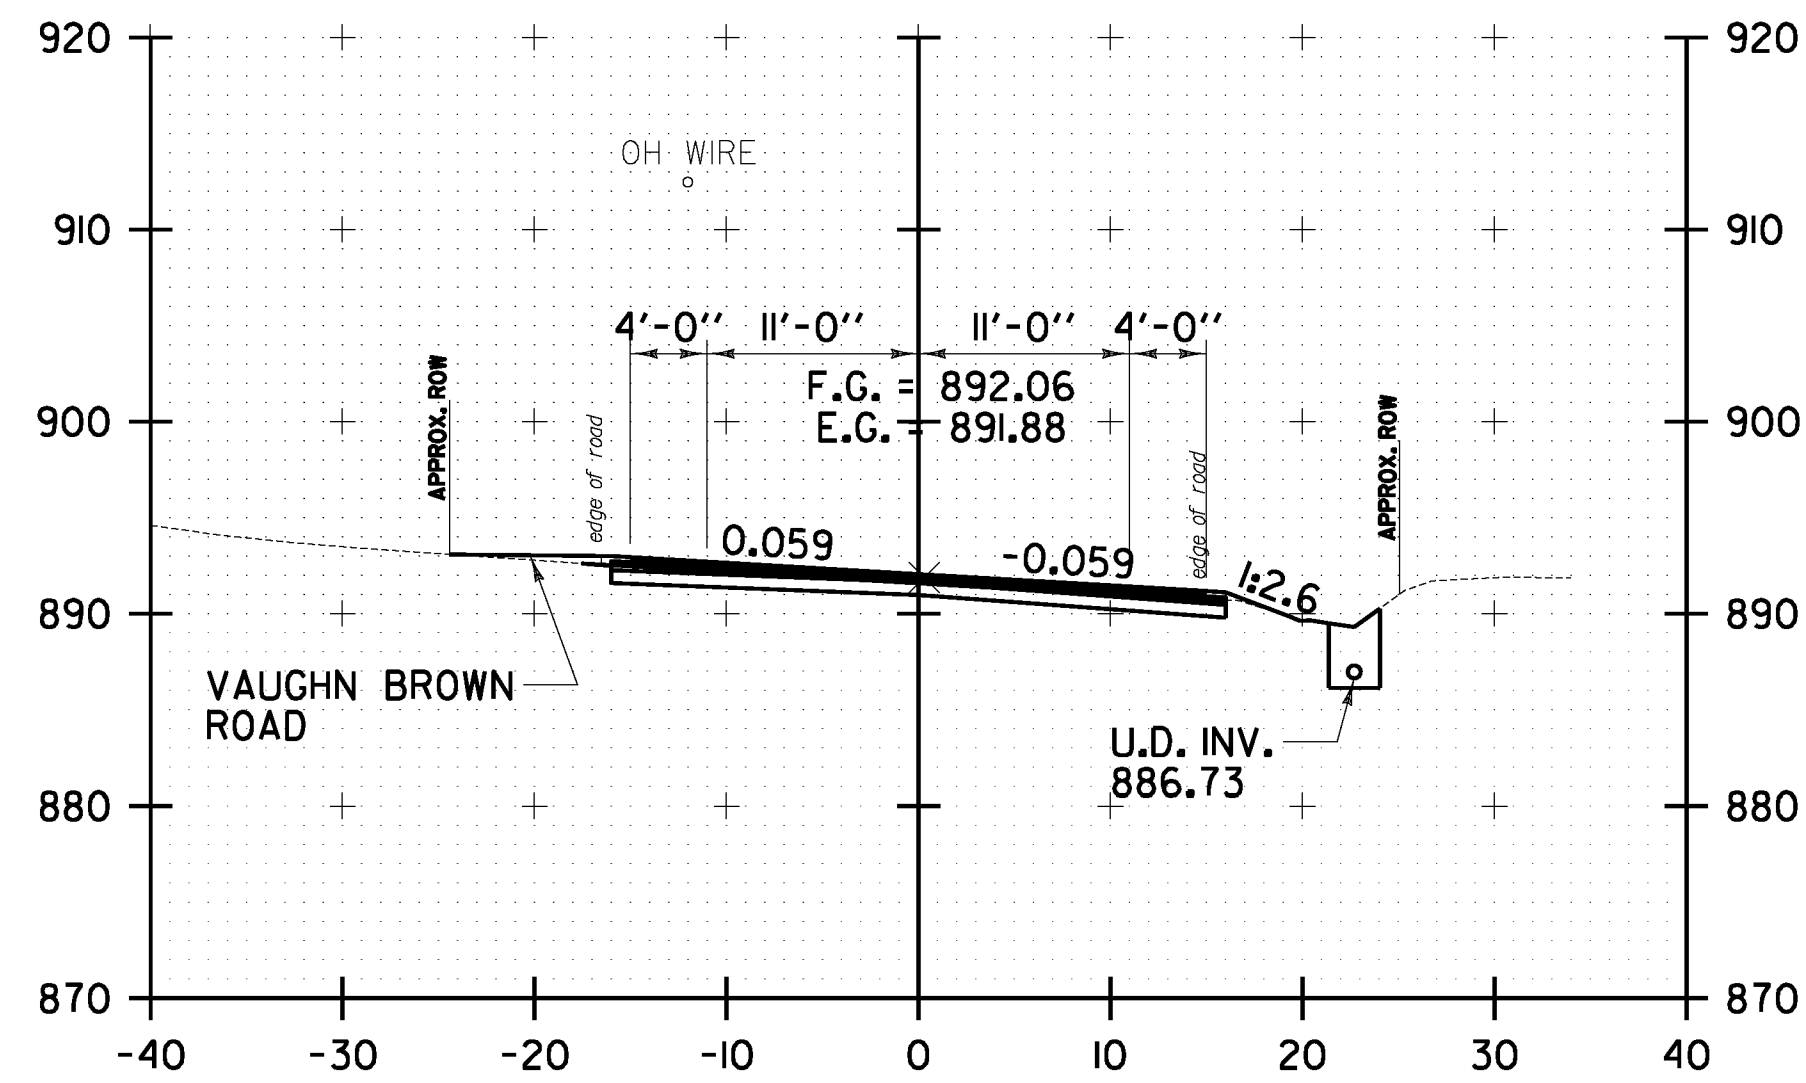


217+50.00

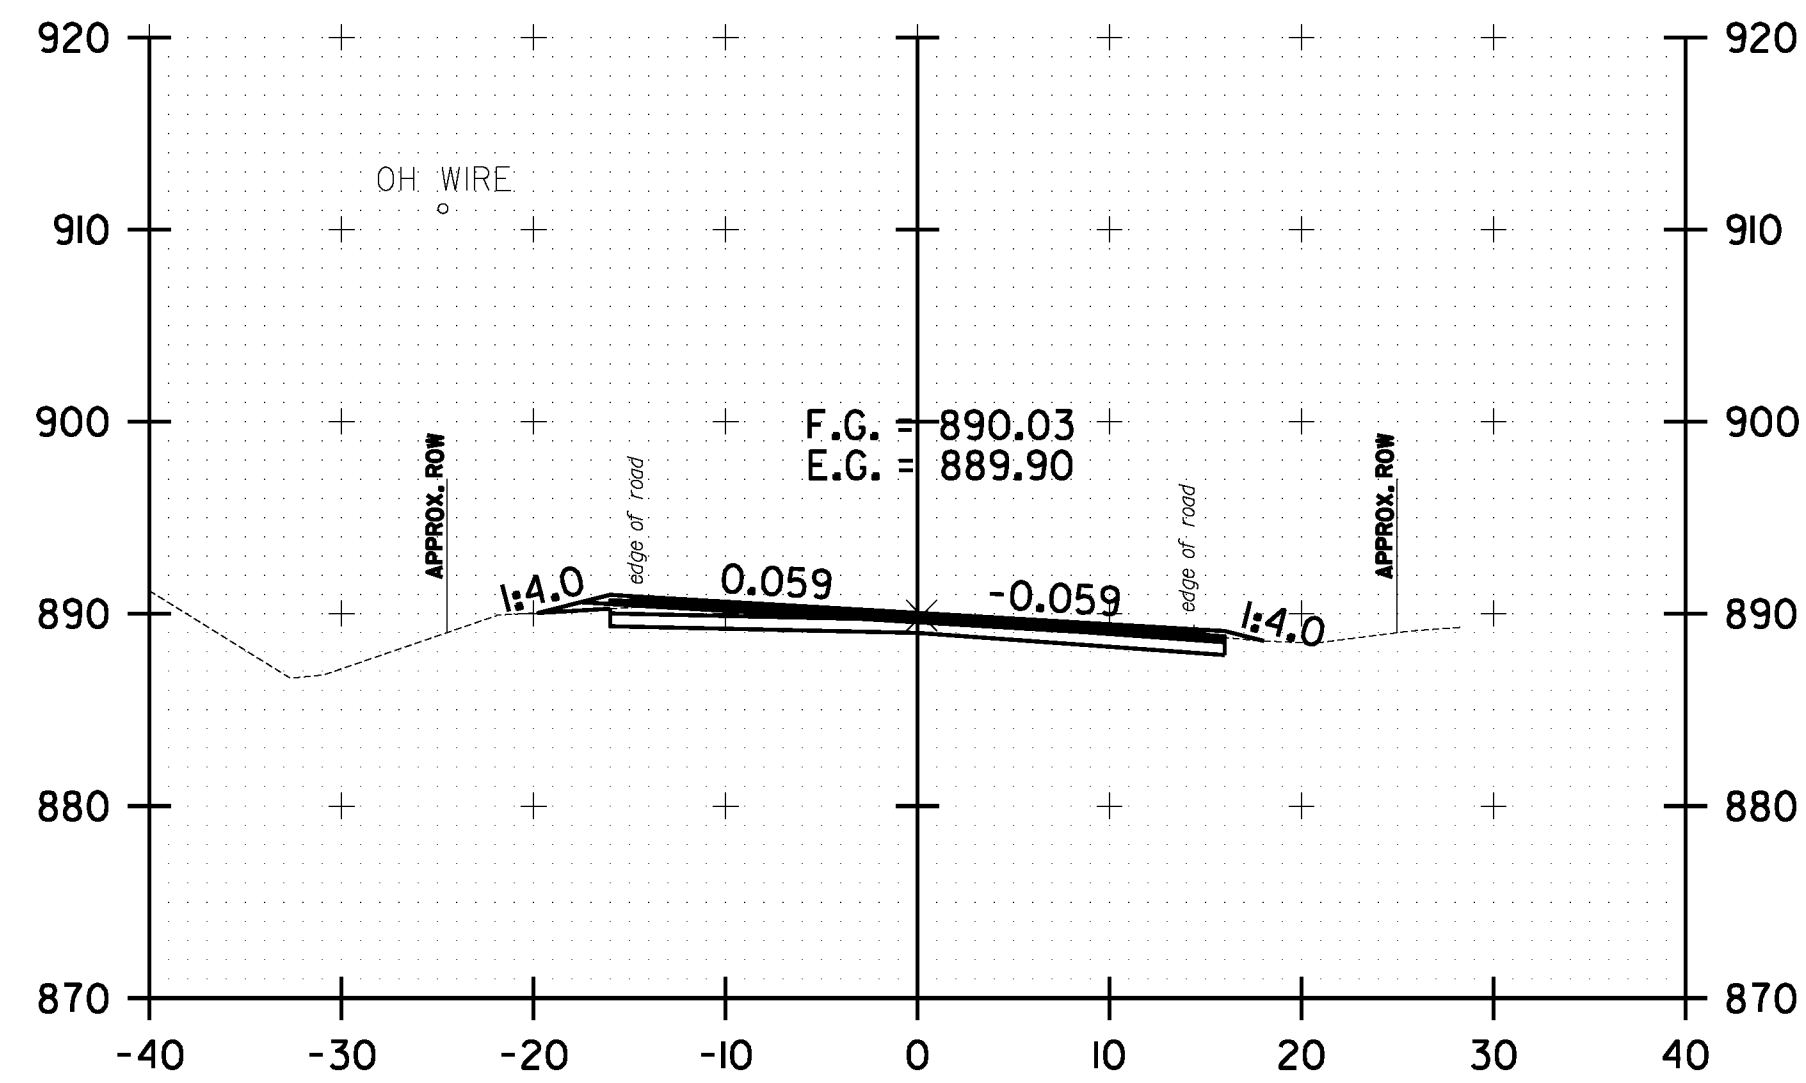

218+50.00

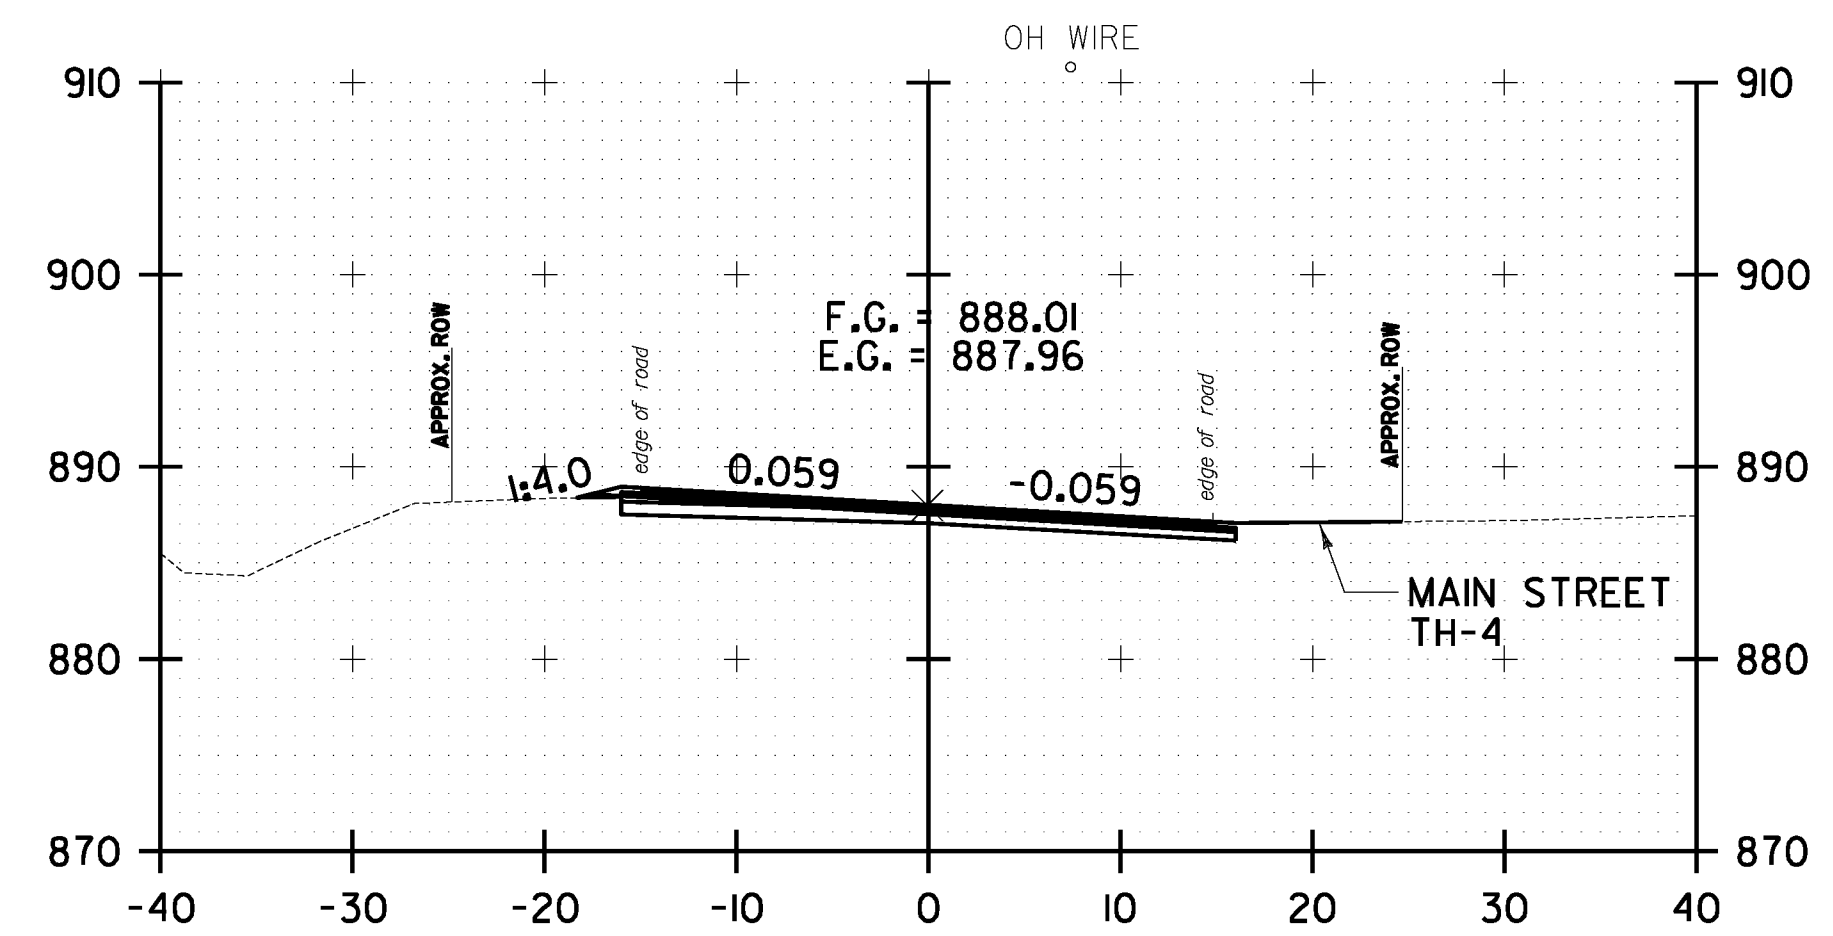

219+50.00

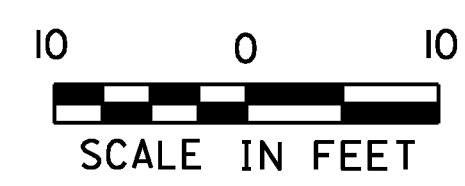

**WARREN
CROSS SECTION
SHEET #57**

PROJECT NAME: WARREN-WAITSFIELD

PROJECT NUMBER: STP 2506(1)

FILE NAME: p05b048.dgn

PROJECT LEADER: D.E.G.

DESIGNED BY: M.J.M.

IPARM FILE: p05b048xs57.1

PLOT DATE: 12/20/2012

DRAWN BY: W.G.P.

CHECKED BY: D.E.G.

SHEET 220 OF 310