




FILE NAME = I:\1762\CA00\MST\STP\_2506\p05b048\_Conv-eest\_Plan.dgn  
 DATE/TIME = 12/20/2012  
 USER = 4866

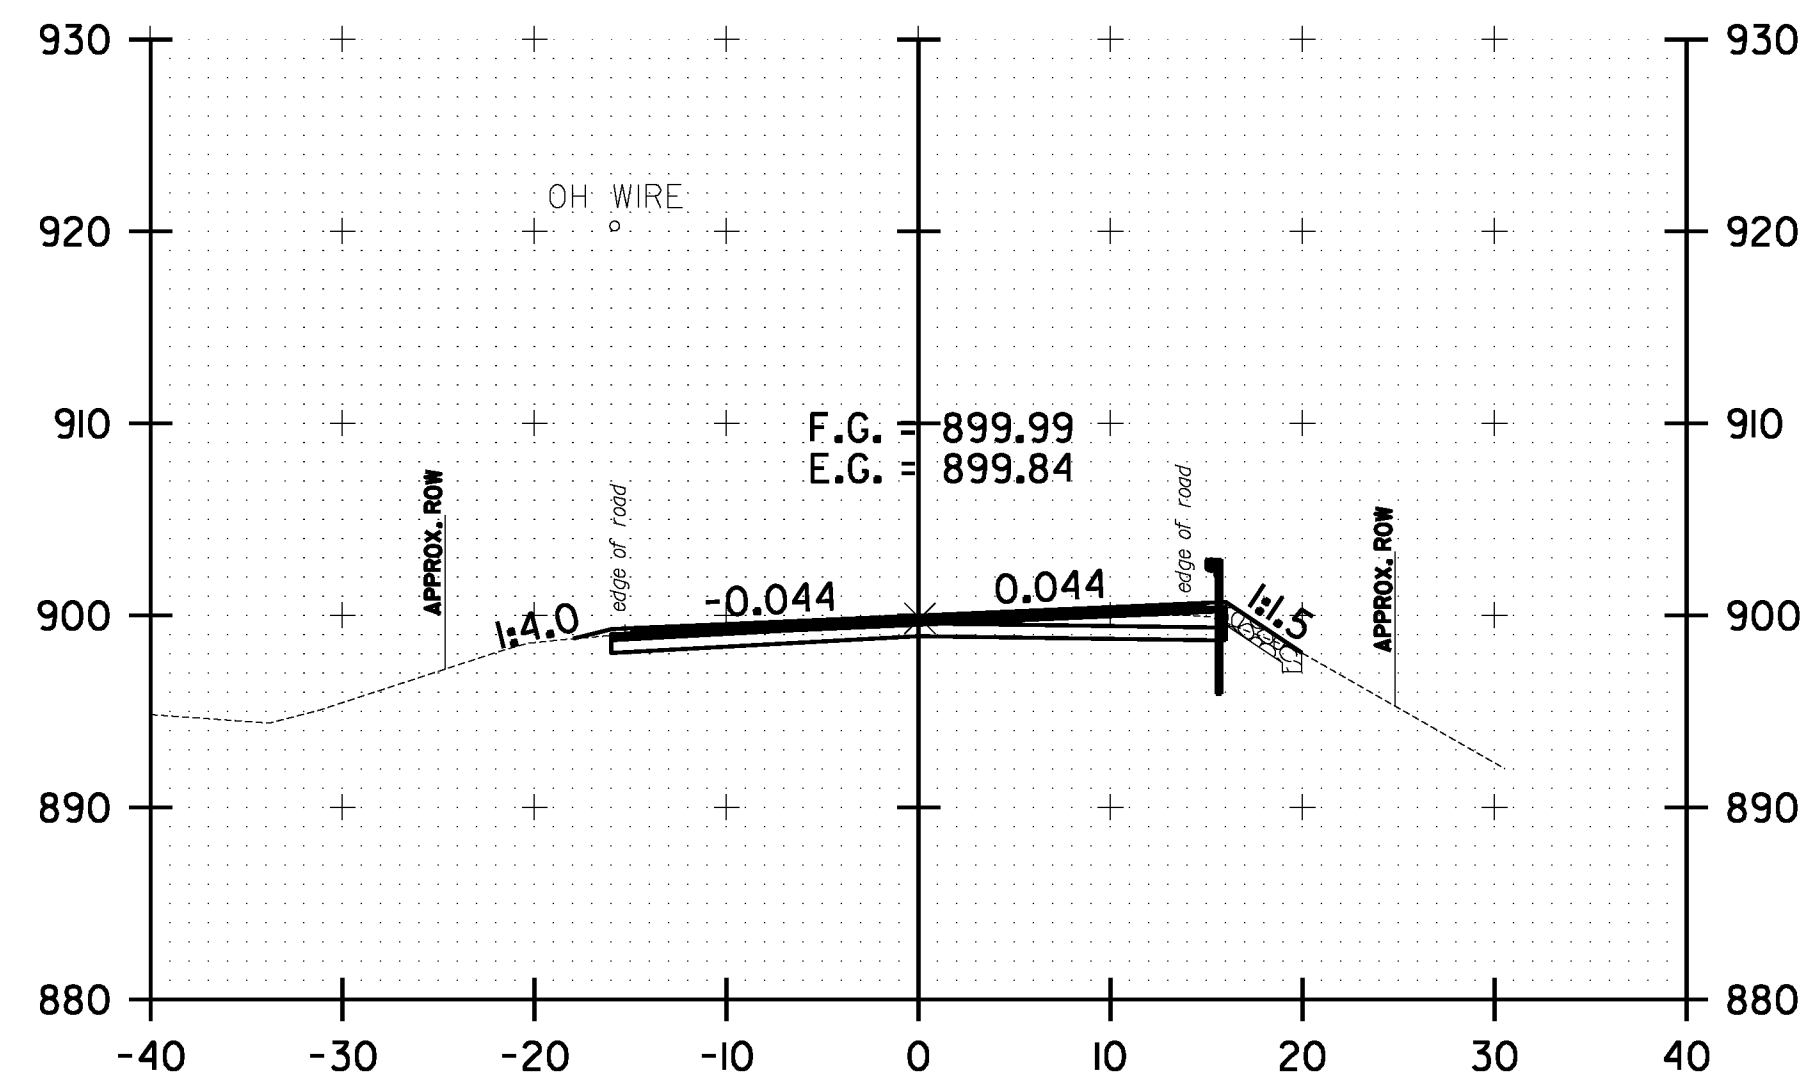


230+50.00

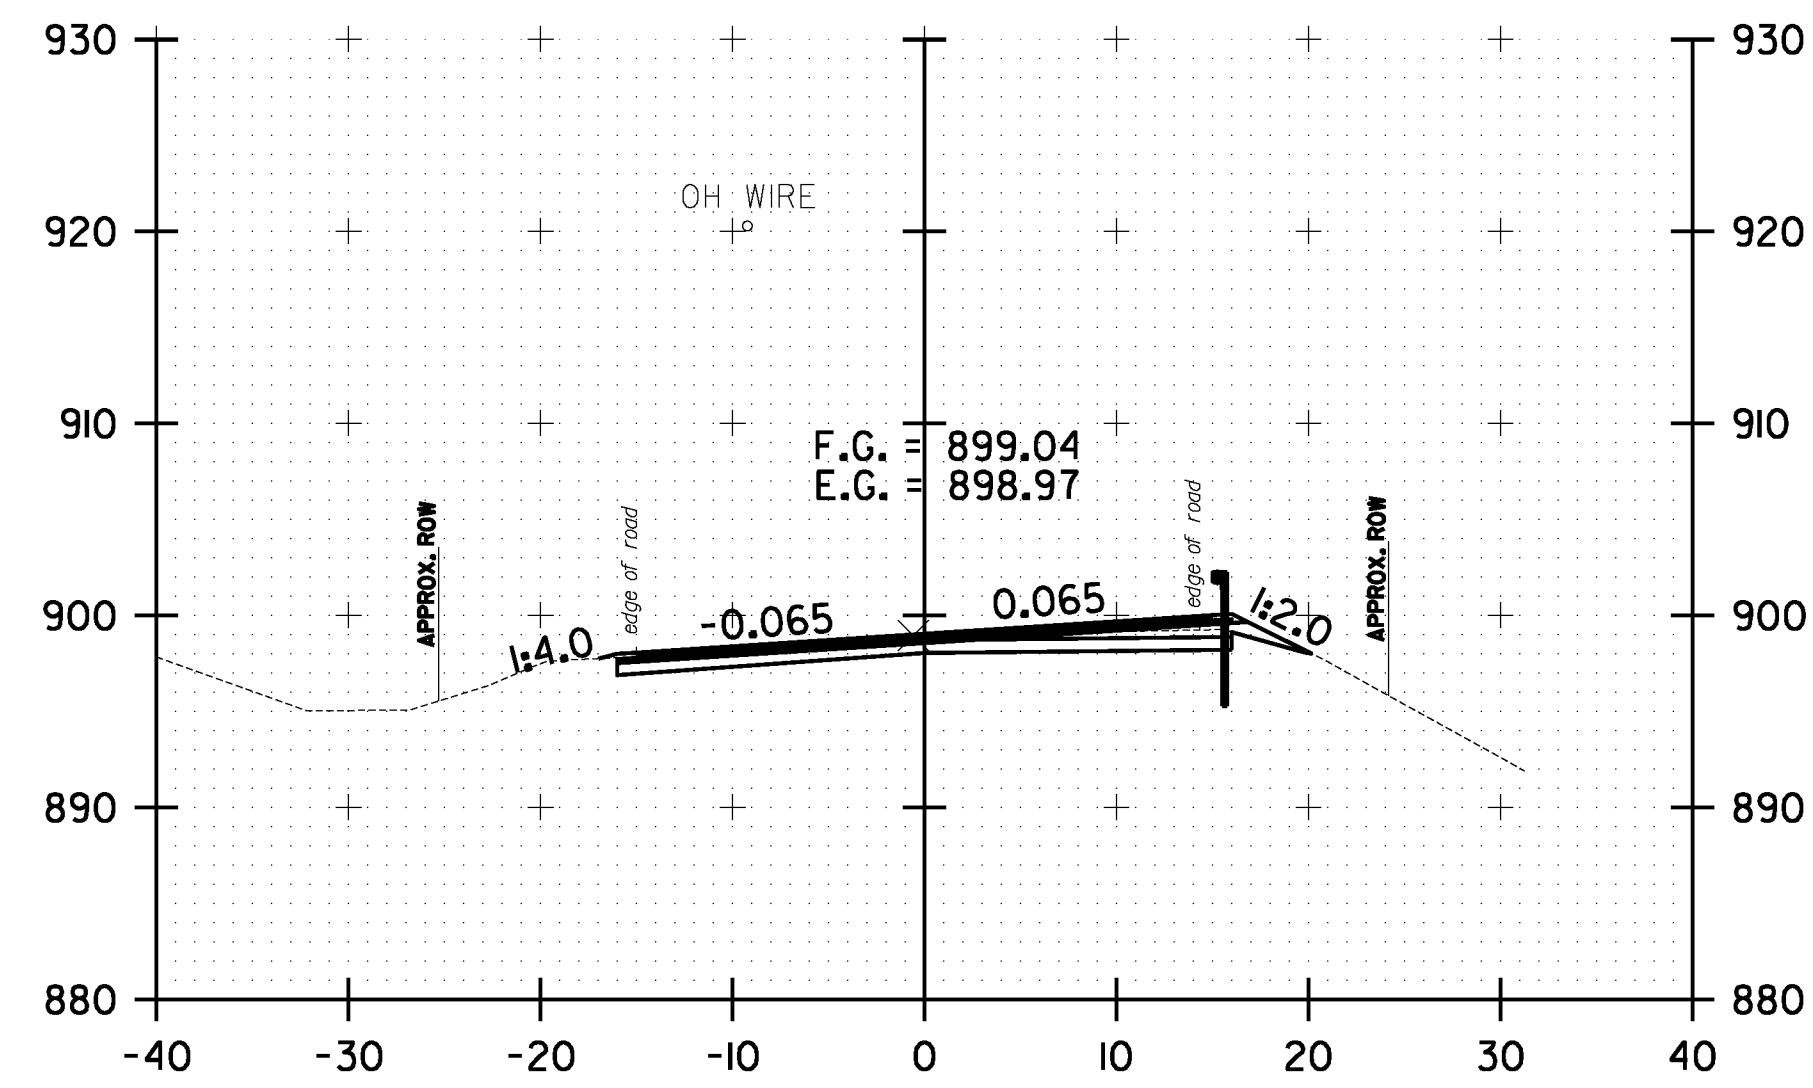


231+50.00

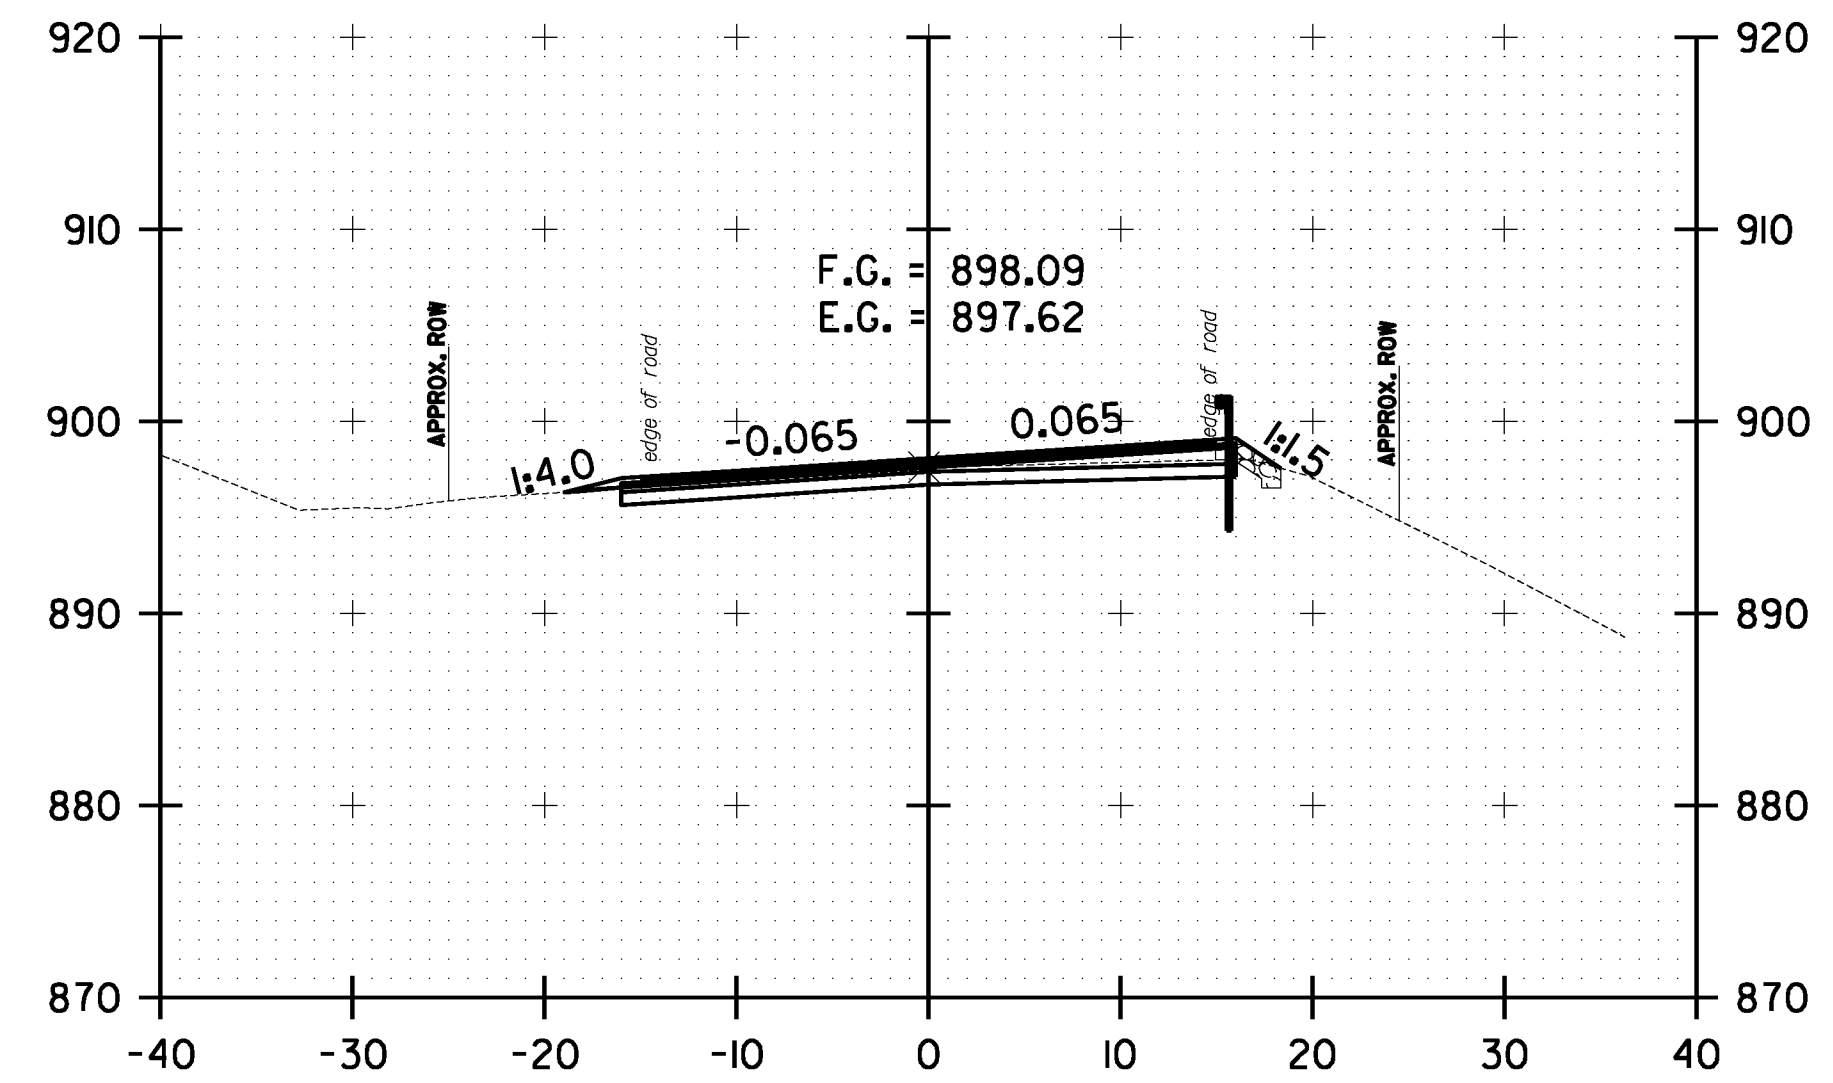


232+50.00

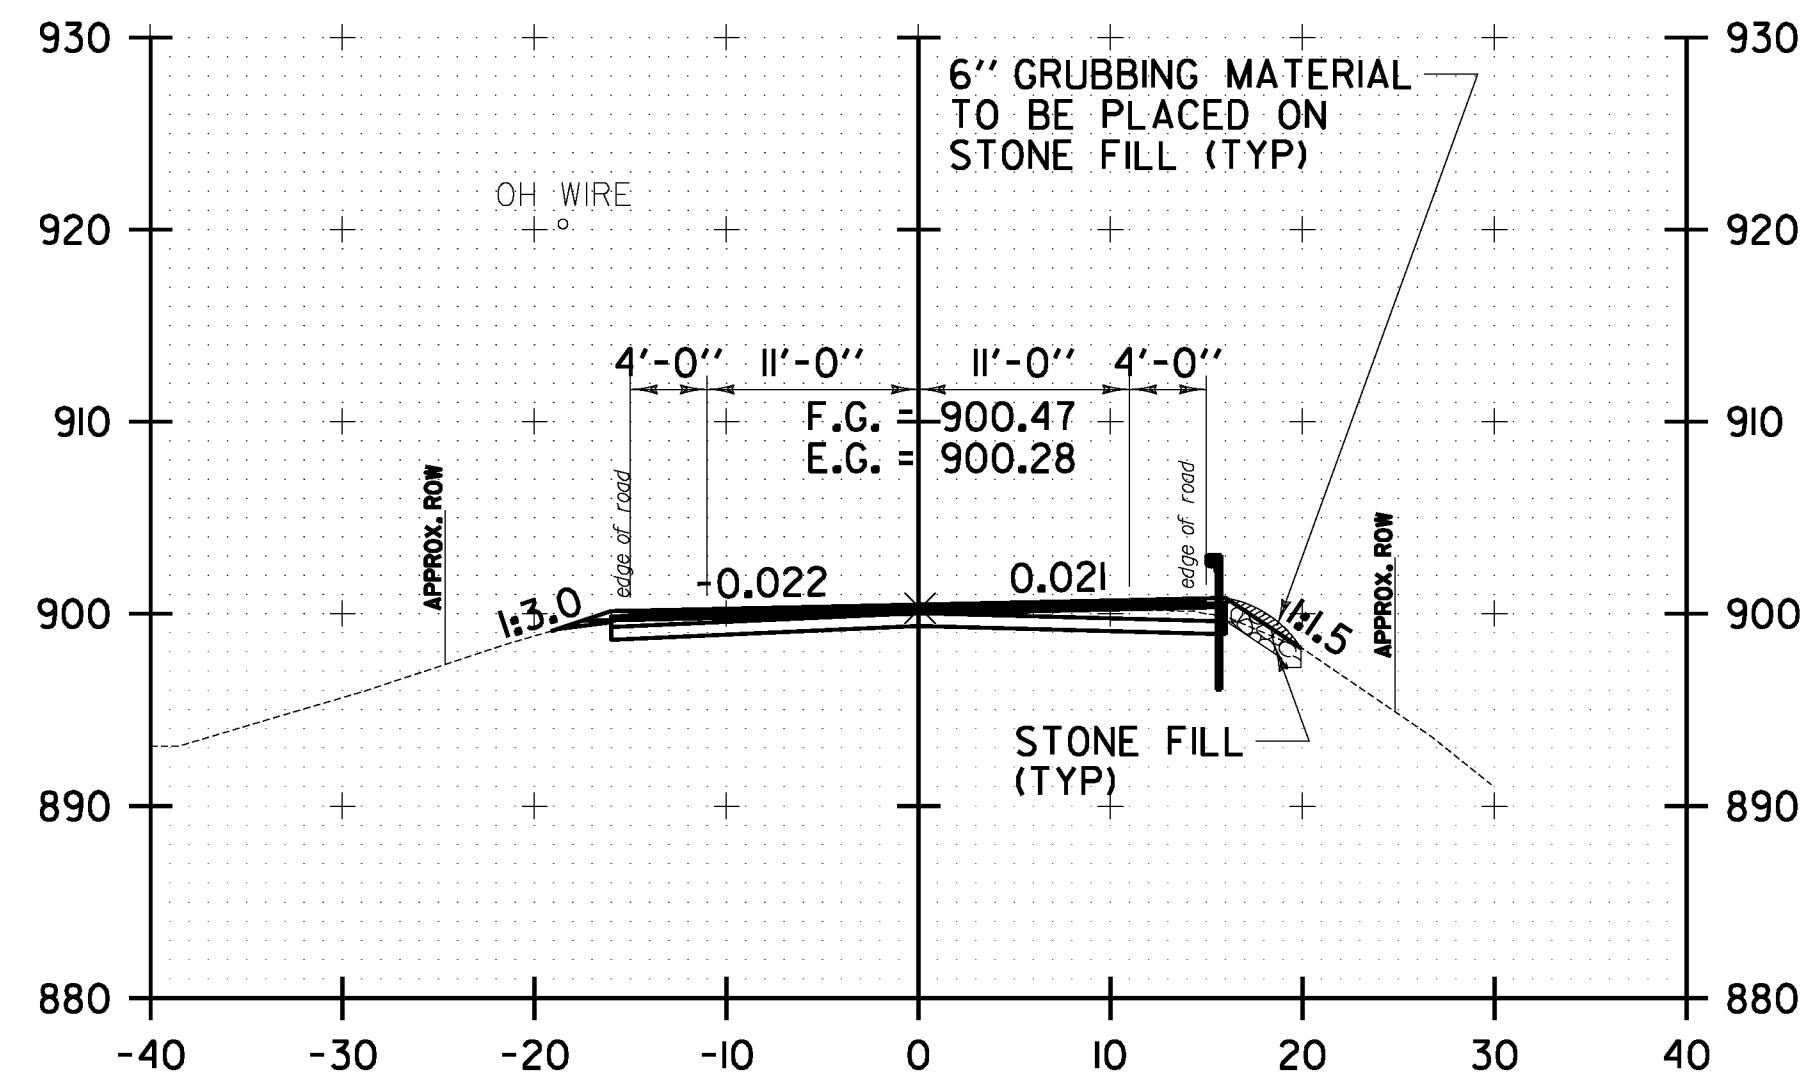

230+00.00

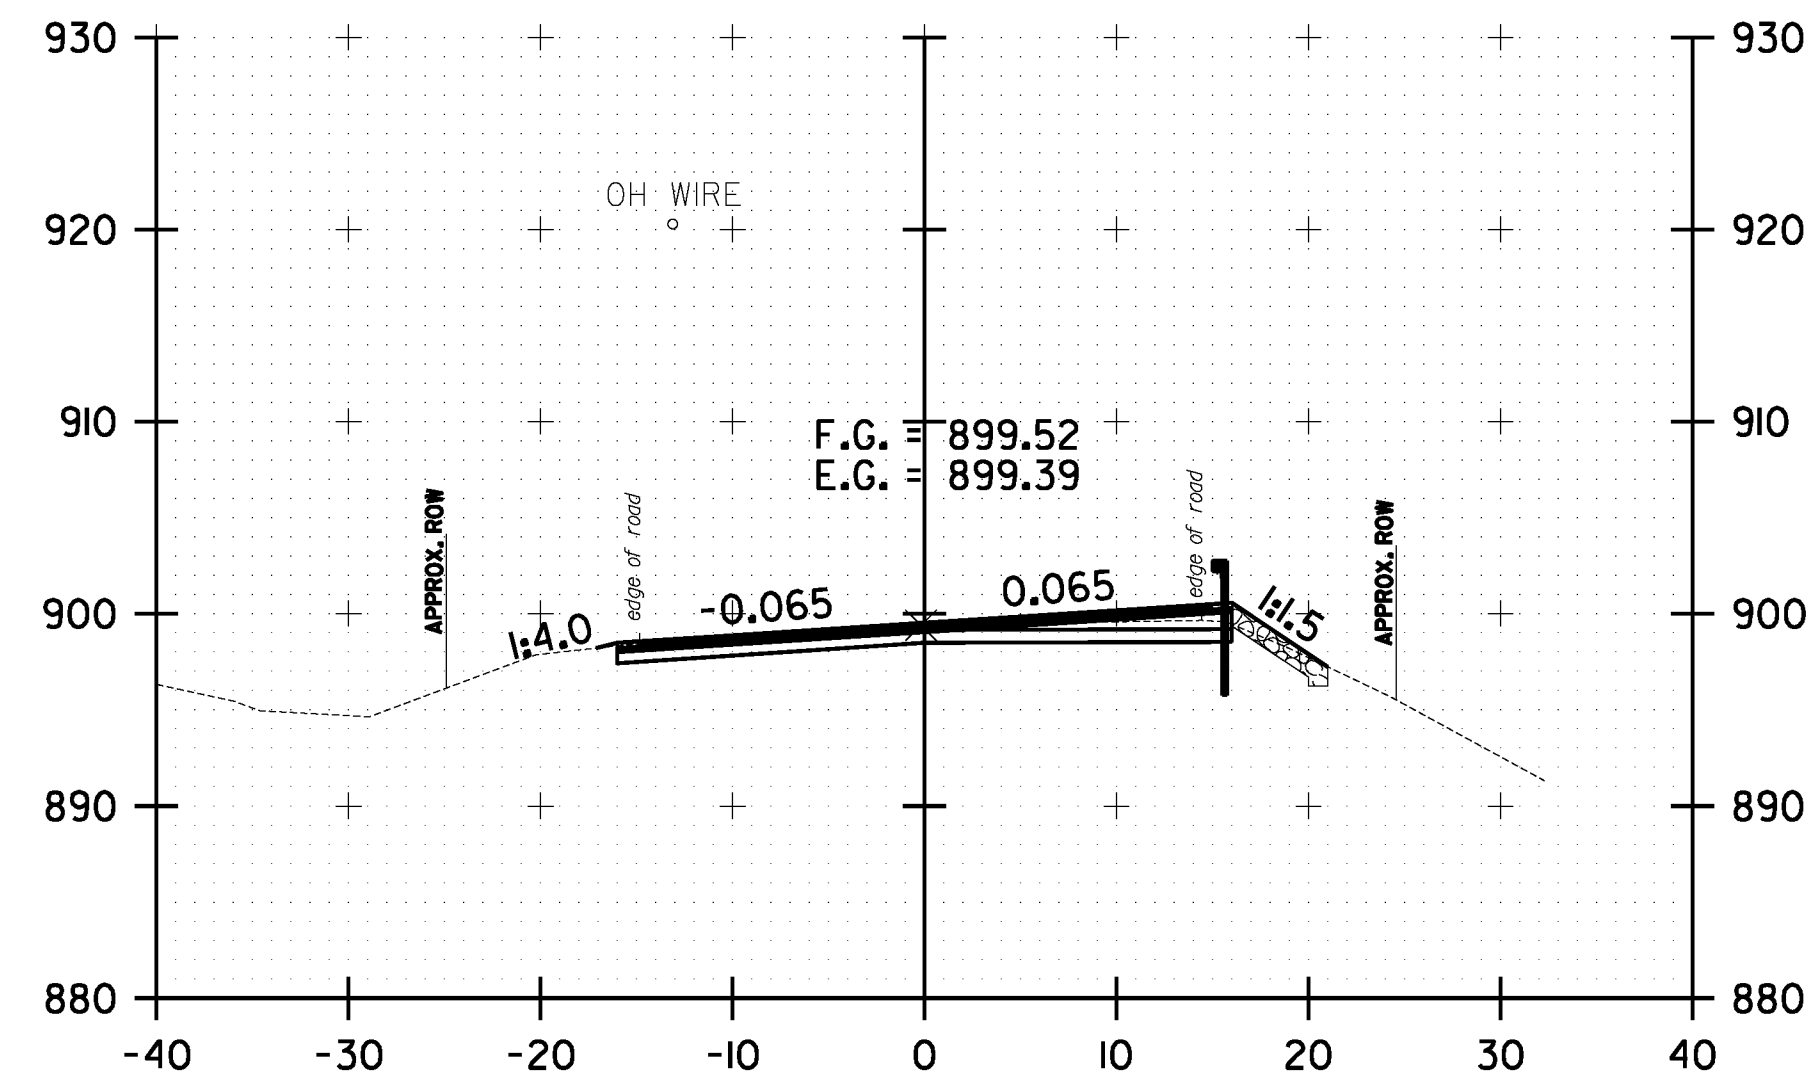

231+00.00

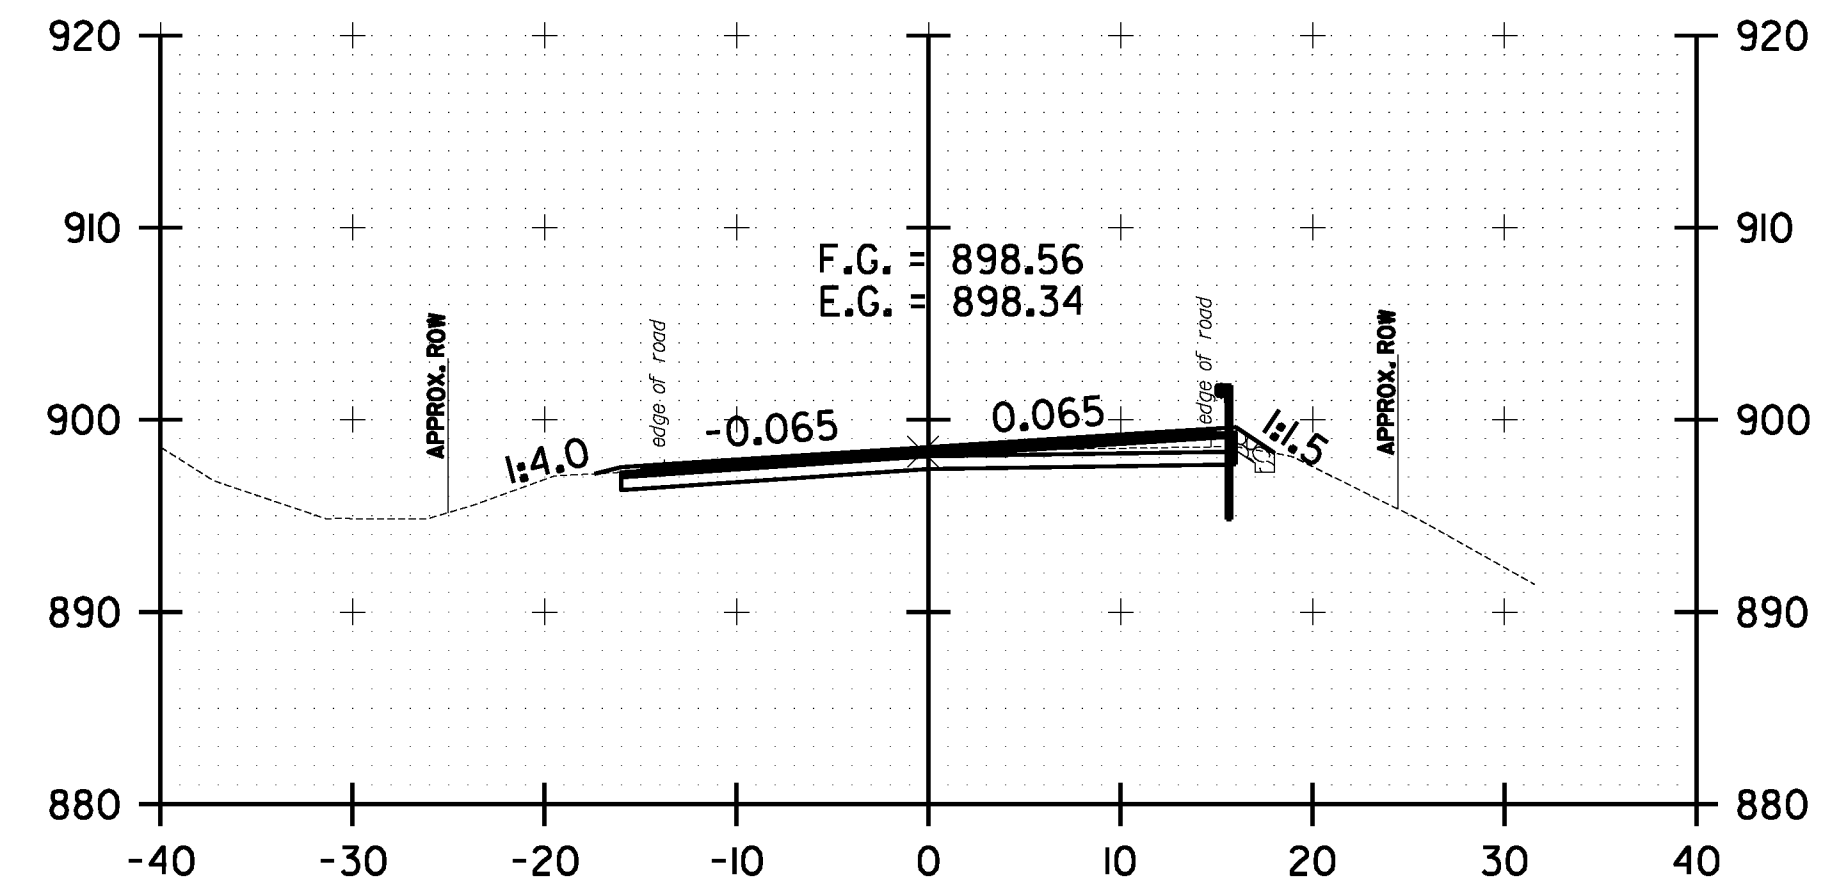

232+00.00



**WARREN  
 CROSS SECTION  
 SHEET #61**

PROJECT NAME: WARREN-WAITSFIELD

PROJECT NUMBER: STP 2506(1)

FILE NAME: p05b048.dgn

PROJECT LEADER: D.E.G.

DESIGNED BY: M.J.M.

IPARM FILE: p05b048xs61.i

PLOT DATE: 12/20/2012

DRAWN BY: W.G.P.

CHECKED BY: D.E.G.

SHEET 224 OF 310