
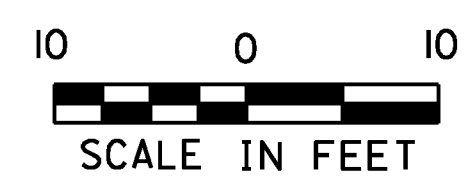
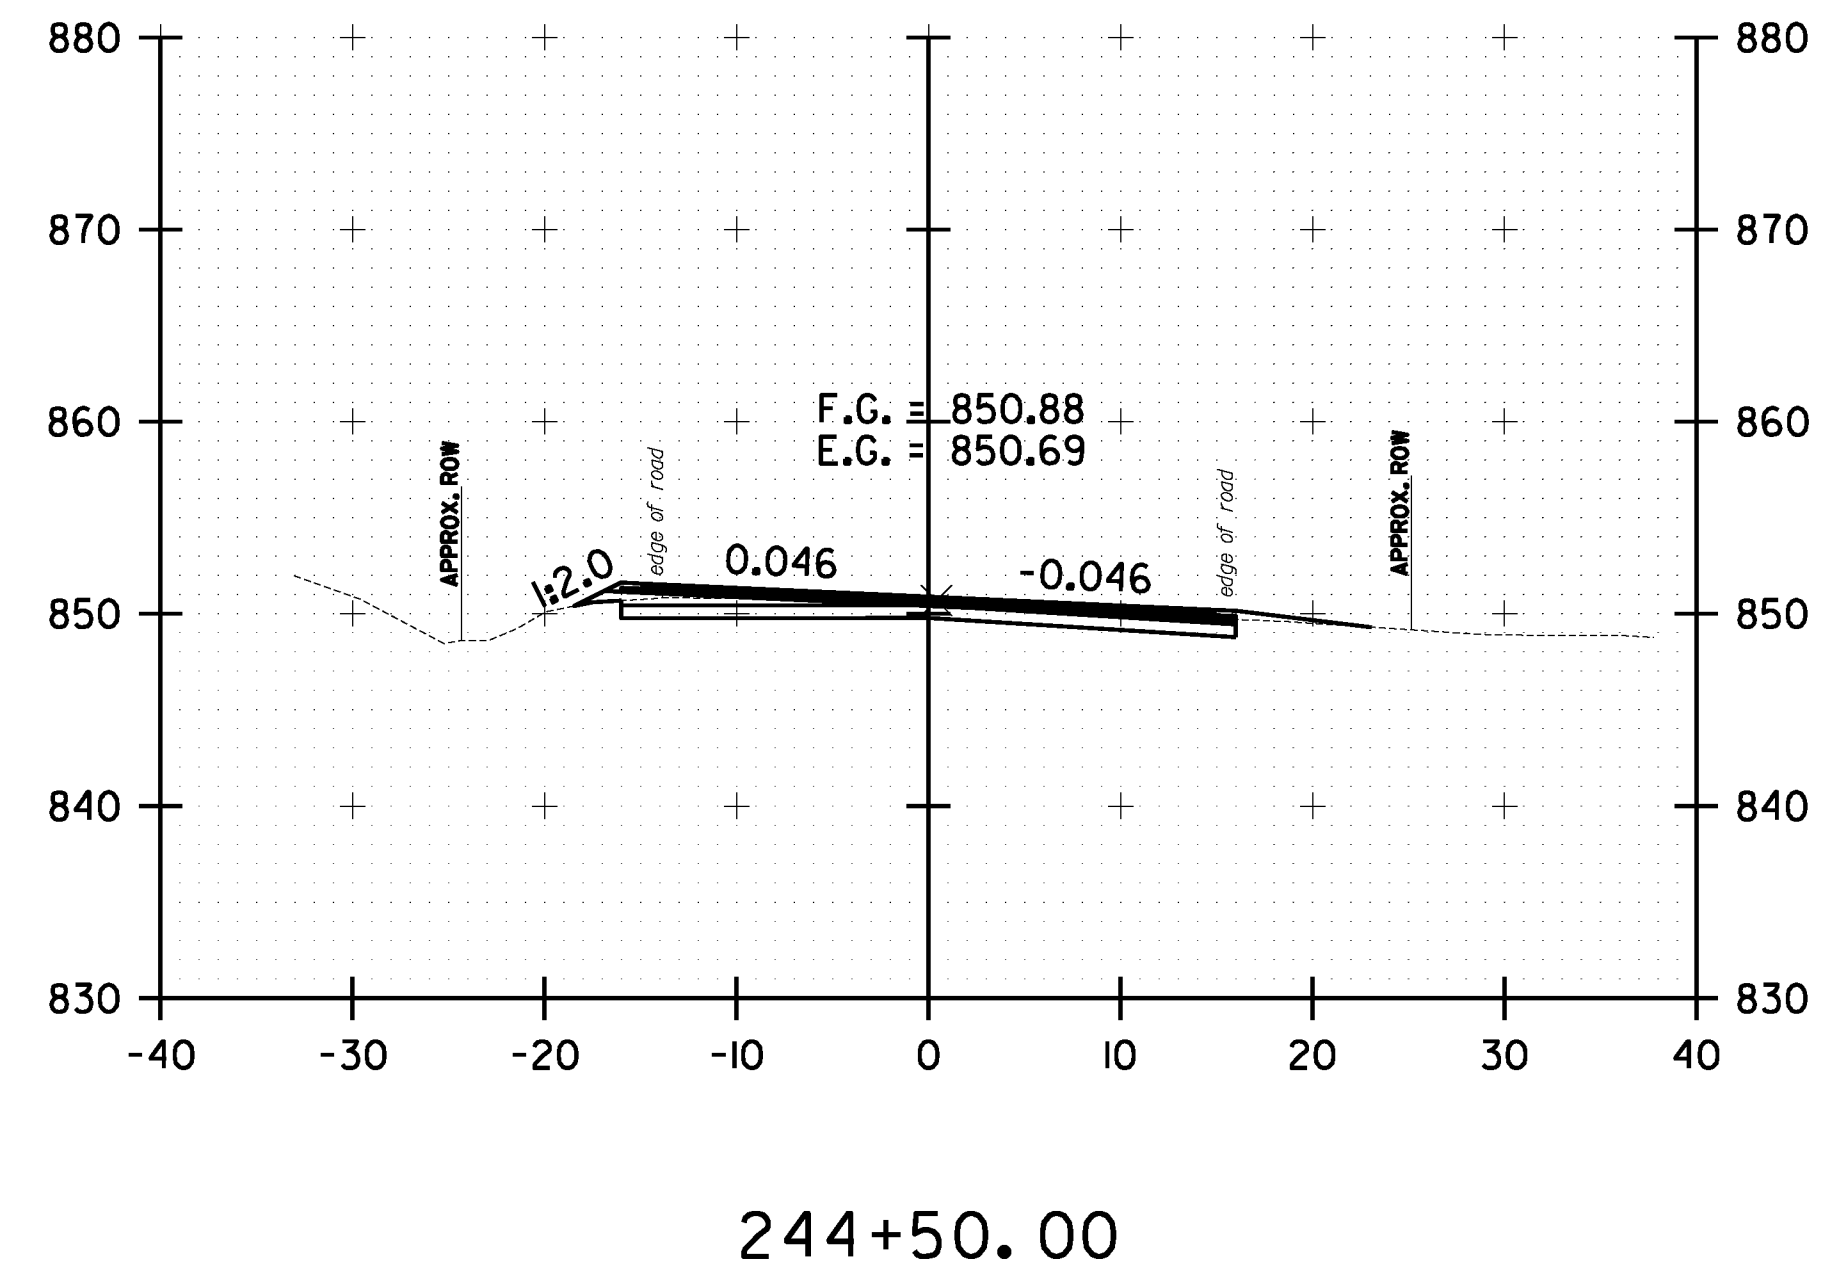
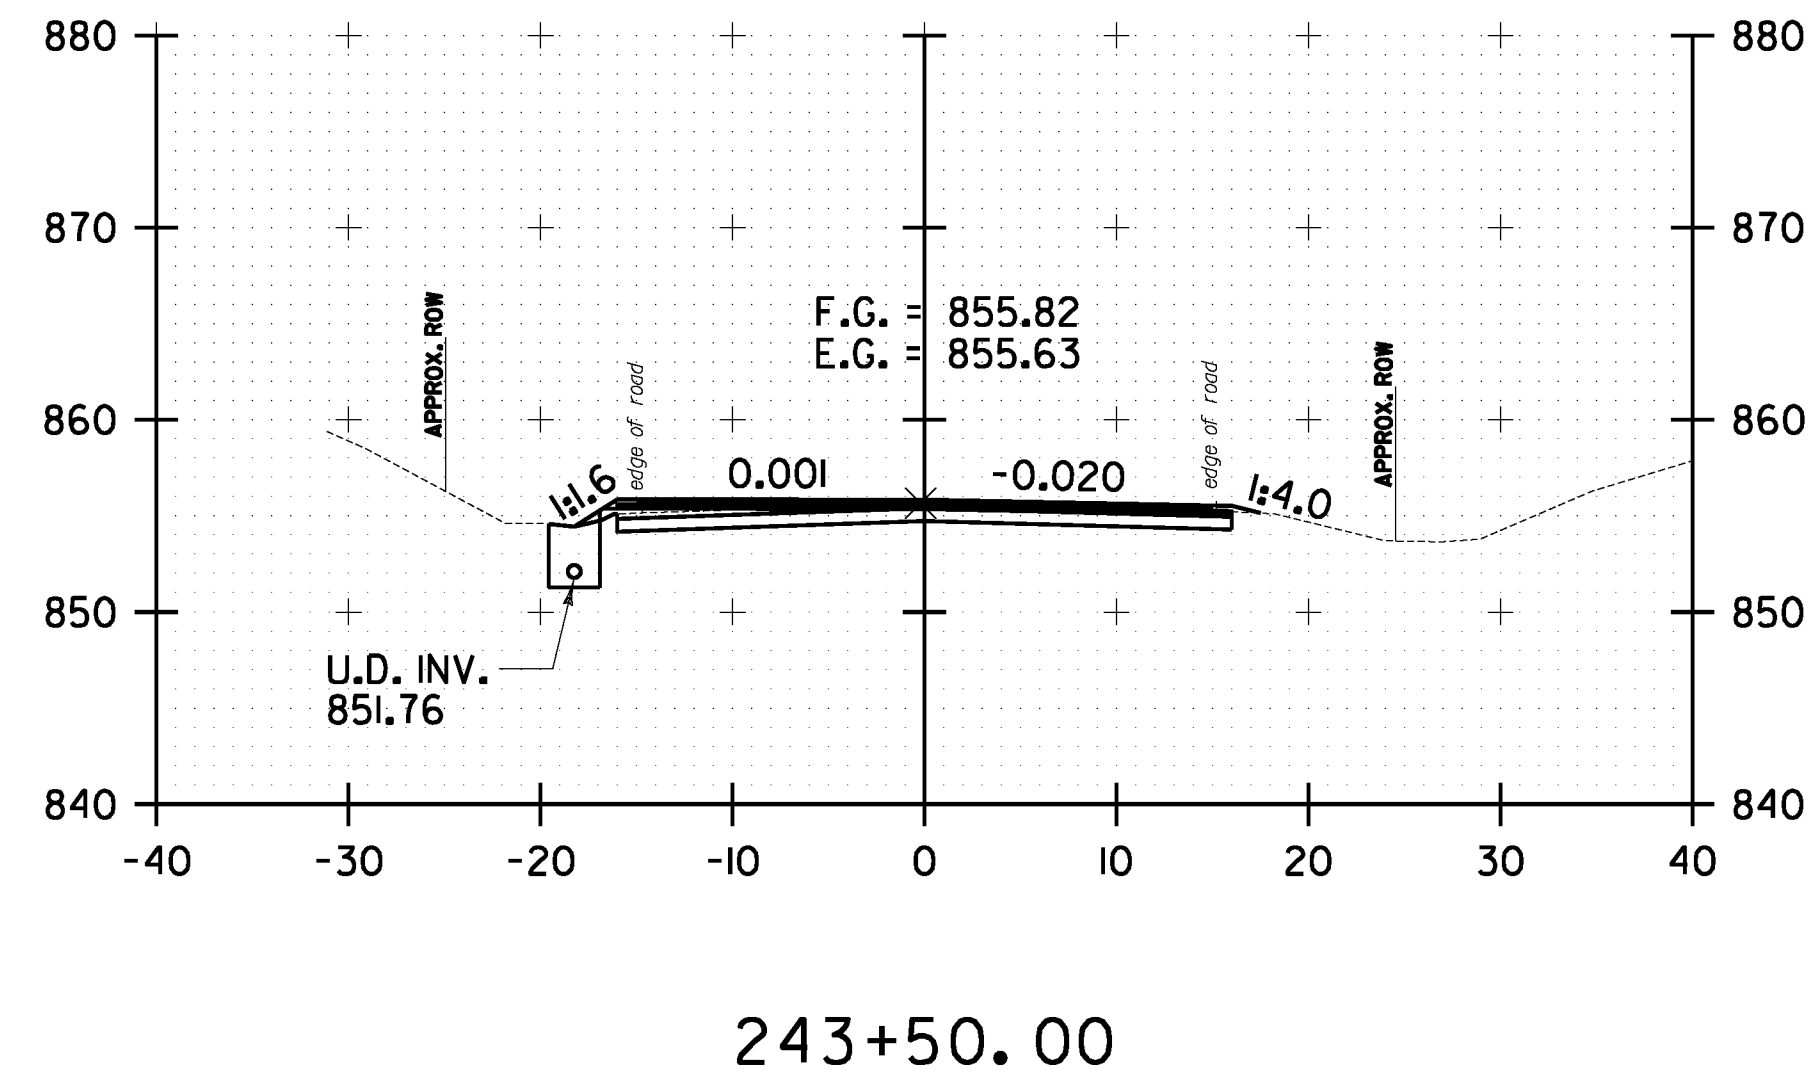
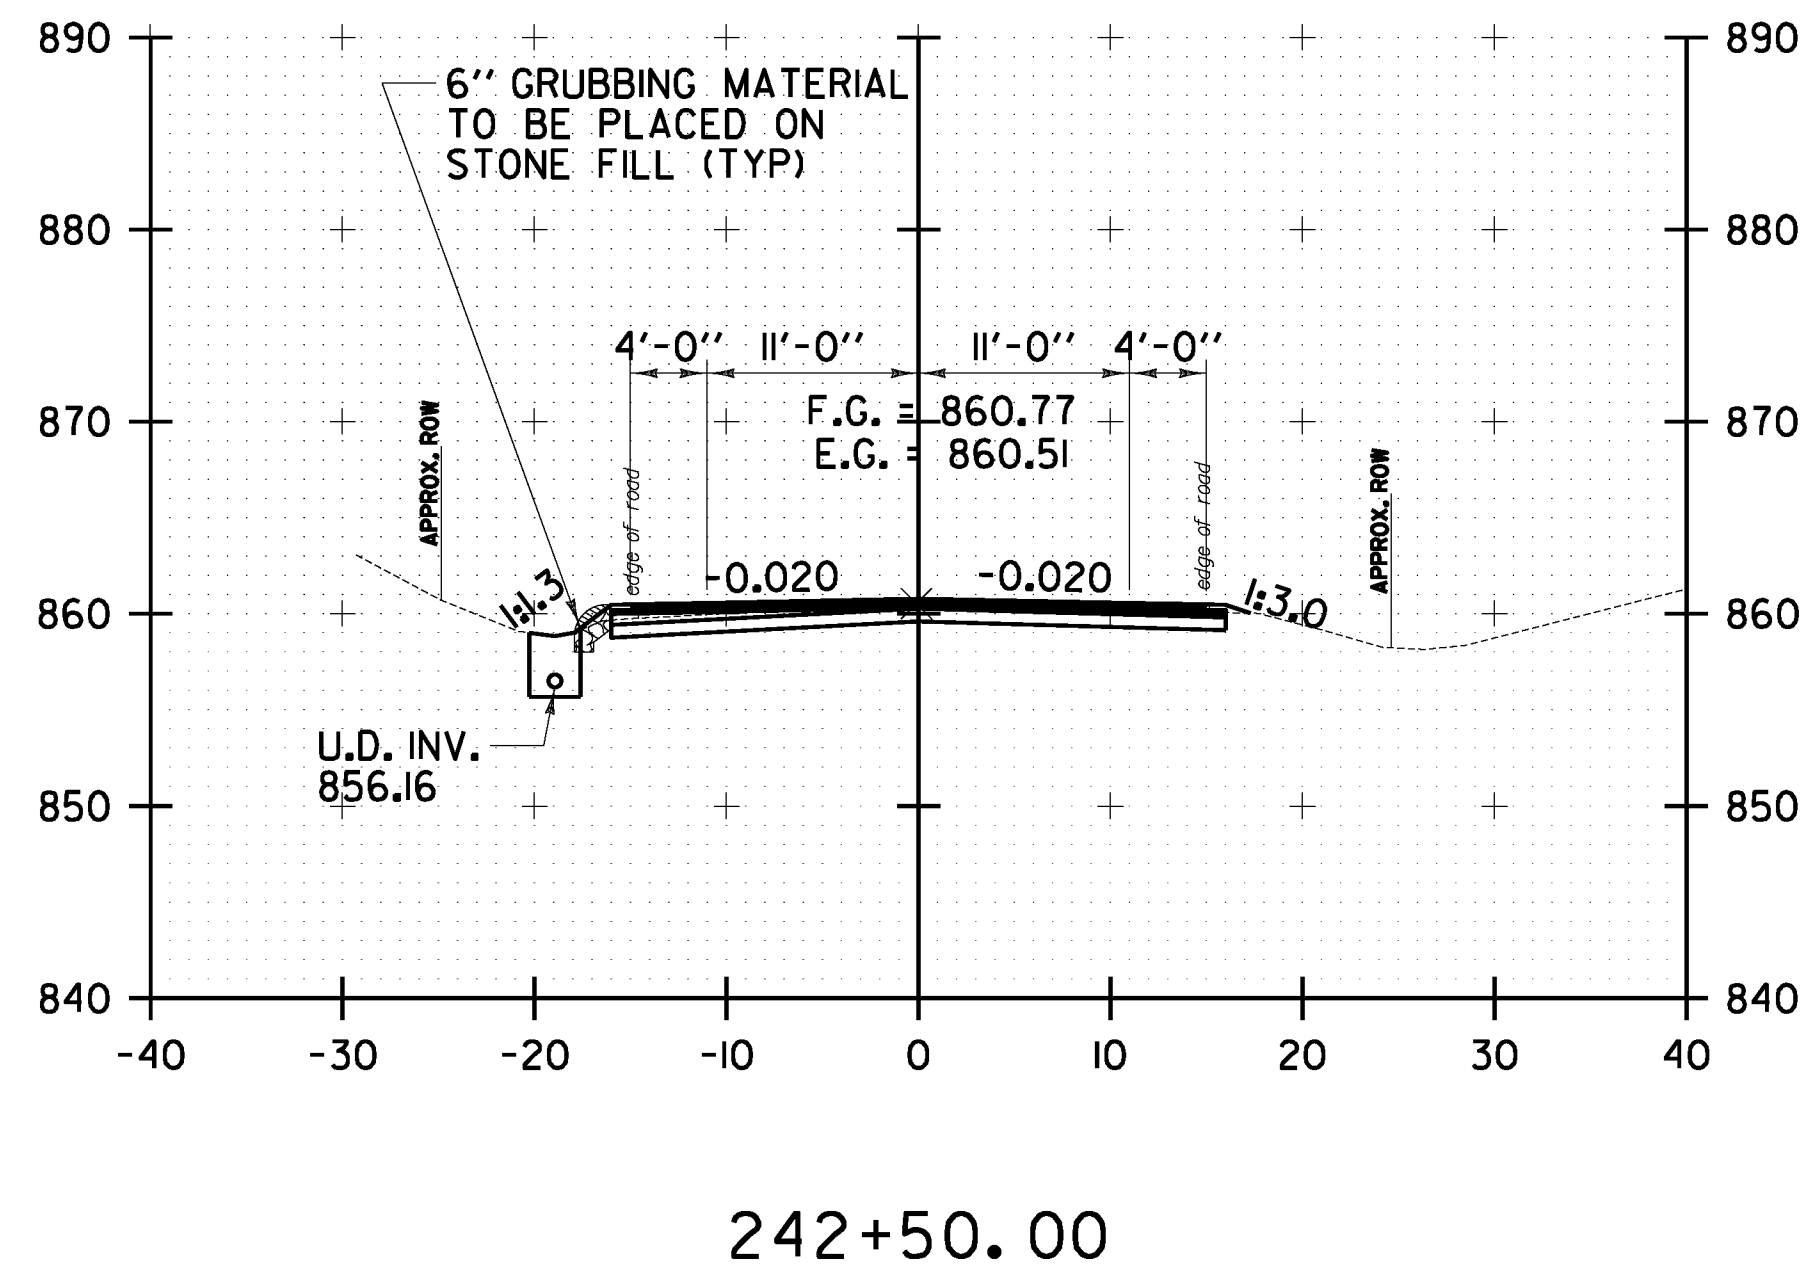
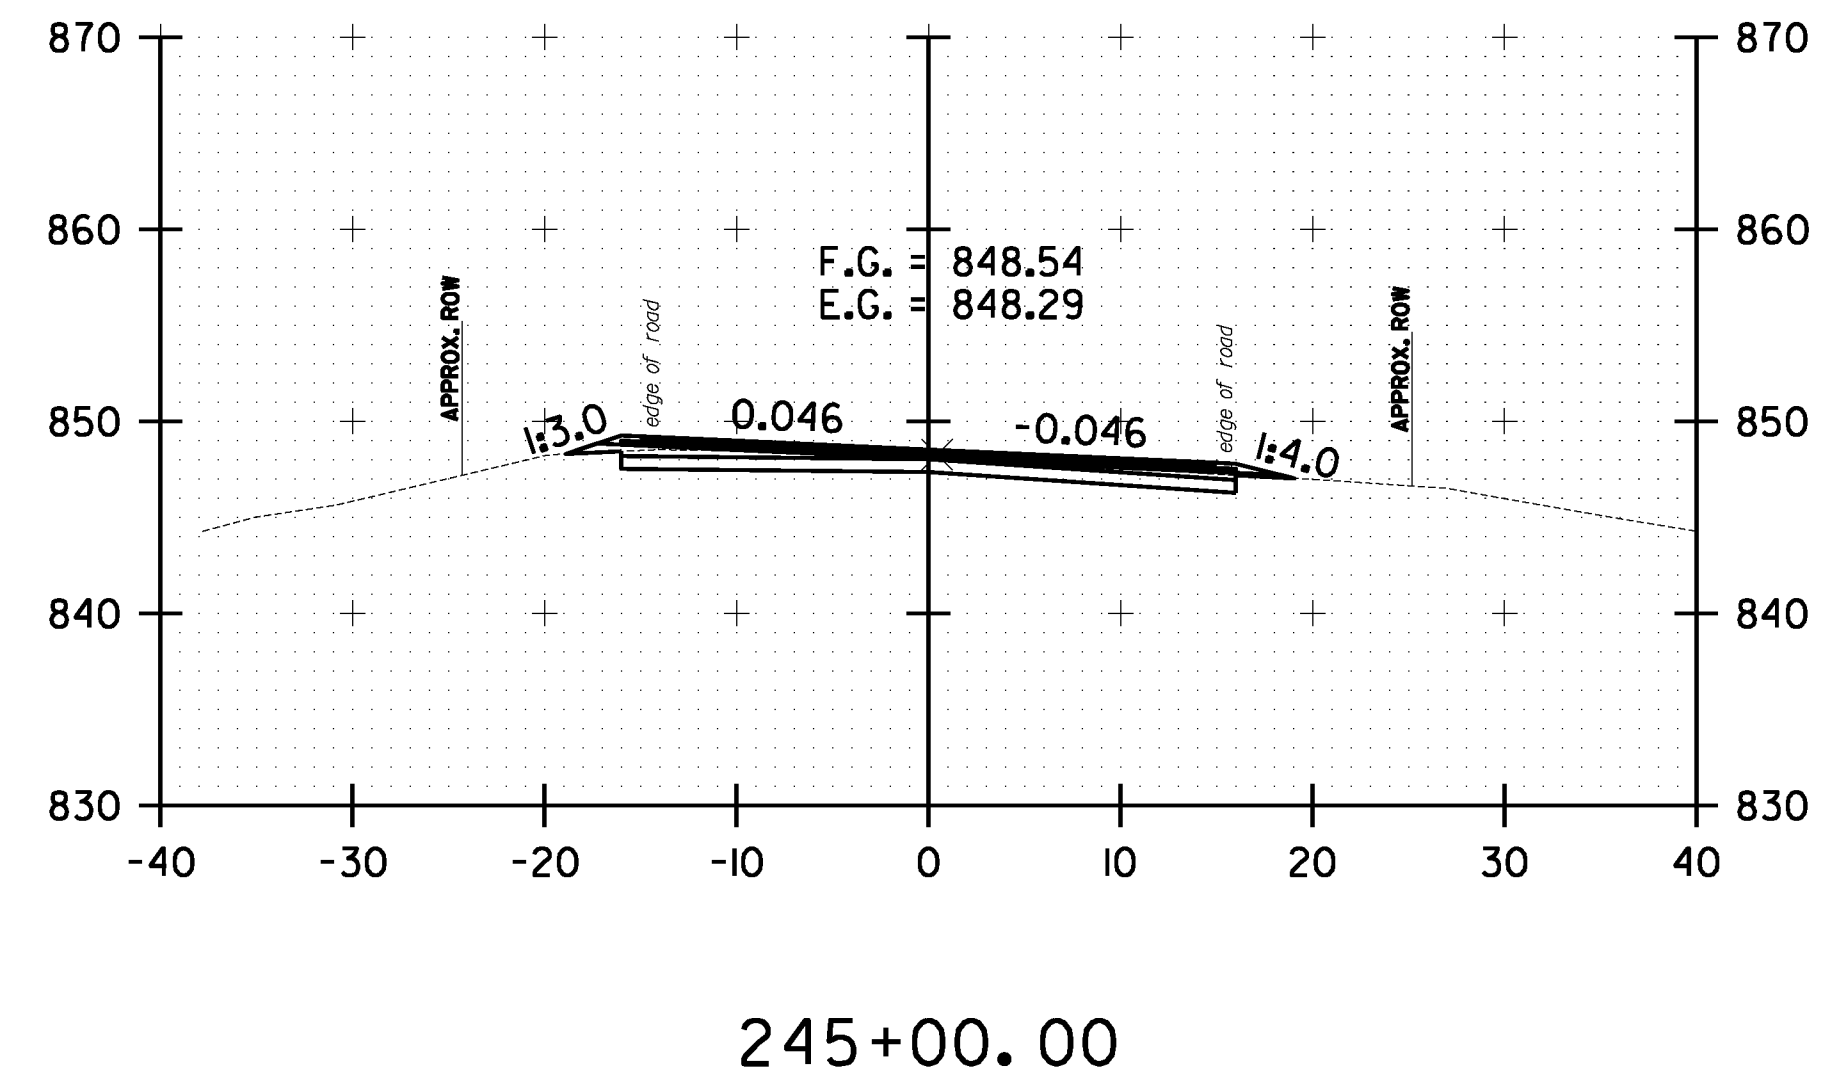
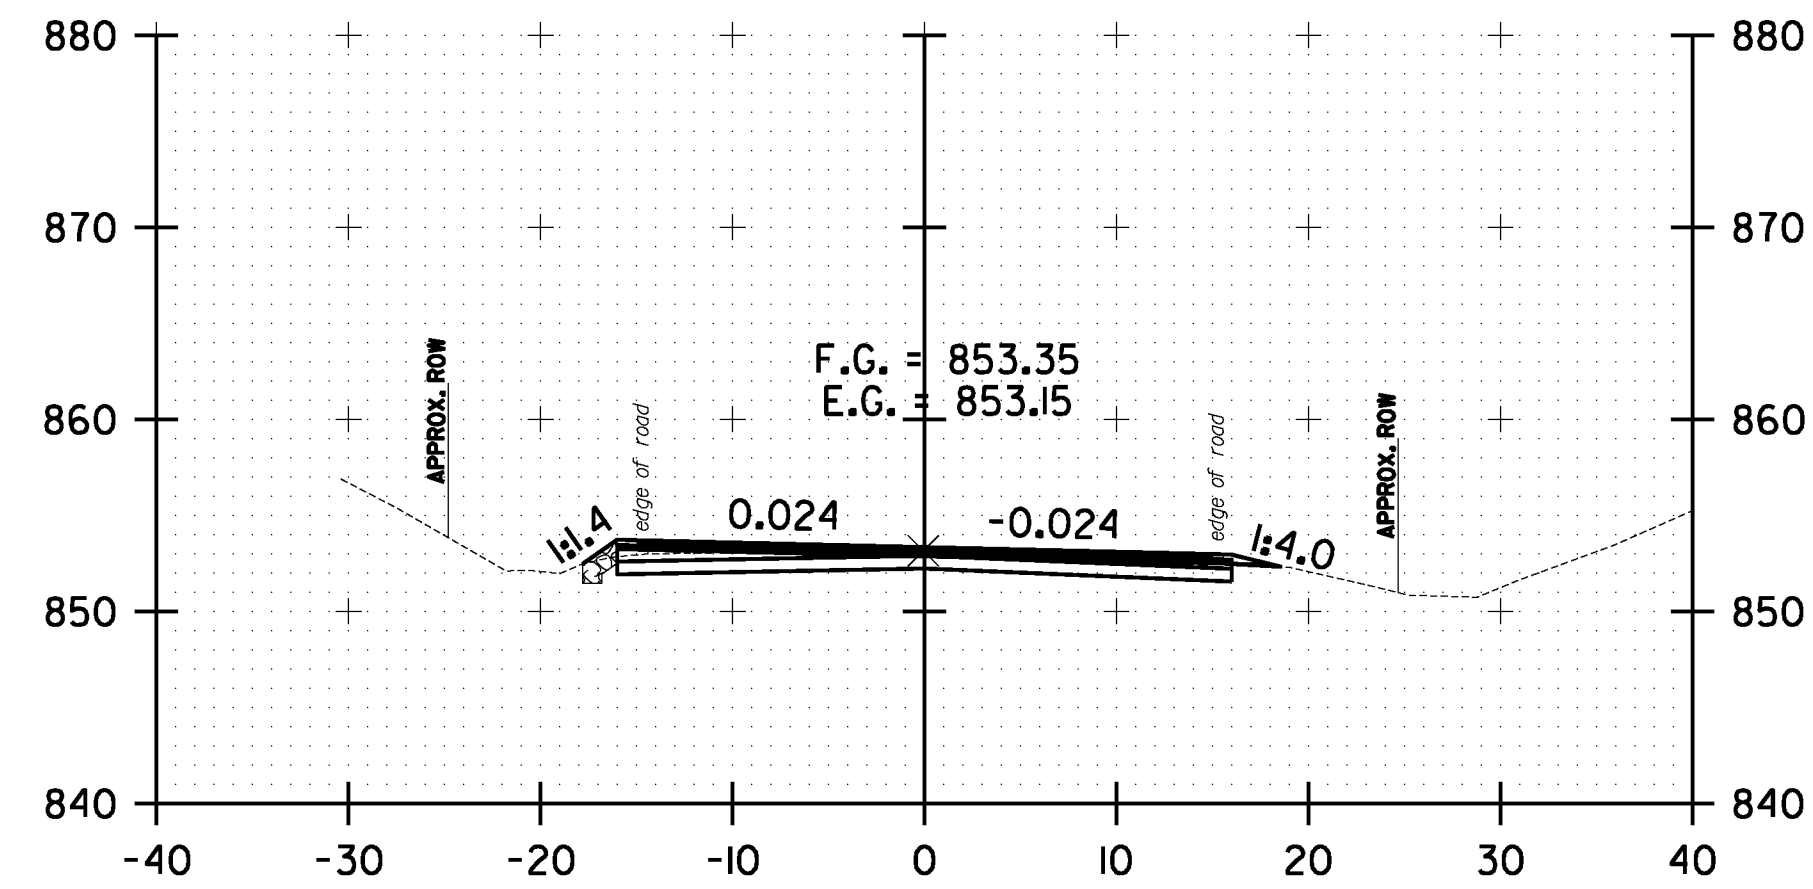


FILE NAME = I:\1762\CA00\MST\STP_2506\p05b048_Convsect_Plan.dgn
 DATE/TIME = 12/20/2012
 USER = 4966

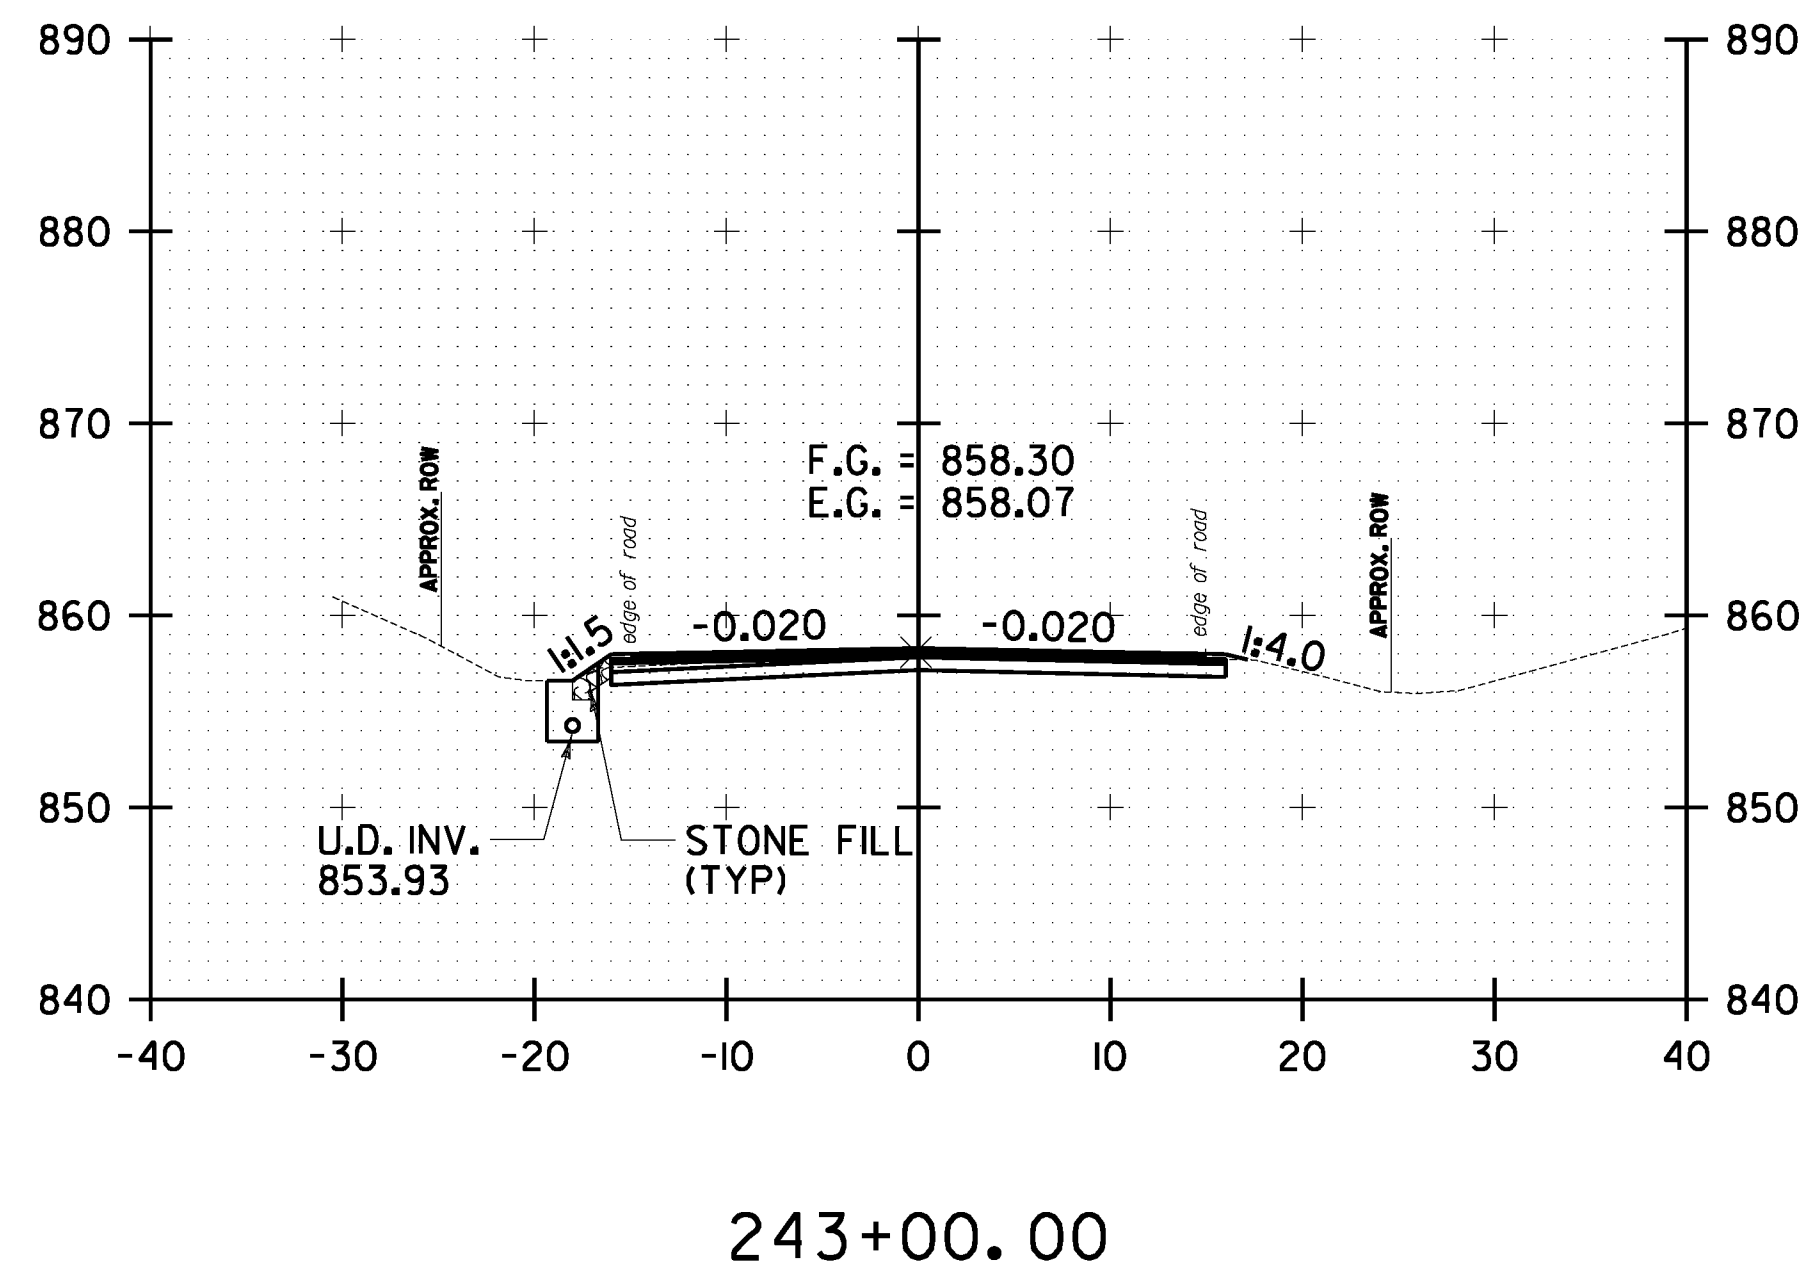

**WARREN
 CROSS SECTION
 SHEET #65**

PROJECT NAME: WARREN-WAITSFIELD	PLOT DATE: 12/20/2012
PROJECT NUMBER: STP 2506(1)	DRAWN BY: W.G.P.
FILE NAME: p05b048.dgn	CHECKED BY: D.E.G.
PROJECT LEADER: D.E.G.	SHEET 228 OF 310
DESIGNED BY: M.J.M.	
IPARM FILE: p05b048xs65.I	